



# Bryant Development and Review Committee Meeting

Boswell Municipal Complex - City Hall Conference Room

210 SW 3rd Street

**Date:** August 18, 2022 - **Time:** 9:00 AM

## Call to Order

## Old Business

## New Business

### 1. Springhill Tavern - 2224 Brandon Loop - New Addition

*Michael Bolin and Associates - Requesting Approval for New Addition*

- [0583-PLN-01.pdf](#)
- [0583-APP-01.pdf](#)

### 2. Olde Salem Township Ph 2 - Final Plat

*GarNat Engineering - Requesting Recommendation for Approval of Final Plat*

- [0584-PLN-01.pdf](#)

### 3. HE&L Subdivision - Replat - Lot 14

*Hope Consulting - Requesting Recommendation for Approval of Replat*

- [0585-PLN-01.pdf](#)

### 4. Lombard Heights Phase 1 - Final Plat

*Hope Consulting - Requesting Recommendation for Approval of Final Plat*

- [0578-PLN-02.pdf](#)

### 5. Creekside Subdivision - Phase 2

*GarNat Engineering - Requesting Recommendation for Approval of Preliminary Plat*

- [0586-DRN-01.pdf](#)
- [0586-PLN-02.pdf](#)
- [0586-PLN-01.pdf](#)
- [0586-APP-01.pdf](#)

### 6. Cornerstone Montessori Christian Academy - 4910 Springhill Road

*Hope Consulting - Requesting Discussion on Site Plan*

- [0545-PLN-02.pdf](#)

## **Staff Approved**

### **7. Ta Miya's Studio of Dance - 3411 Main Street - Sign Permit**

*L Graphics - Requesting Sign Permit Approval - APPROVED*

- [0580-APP-01.pdf](#)


### **8. Farmer's Bank and Trust - 3345 HWY 5 - Sign Permit**

*White Sign Company - Requesting Sign Permit Approval - APPROVED*

- [0582-APP-02.pdf](#)

## **Permit Report**

## **Adjournments**

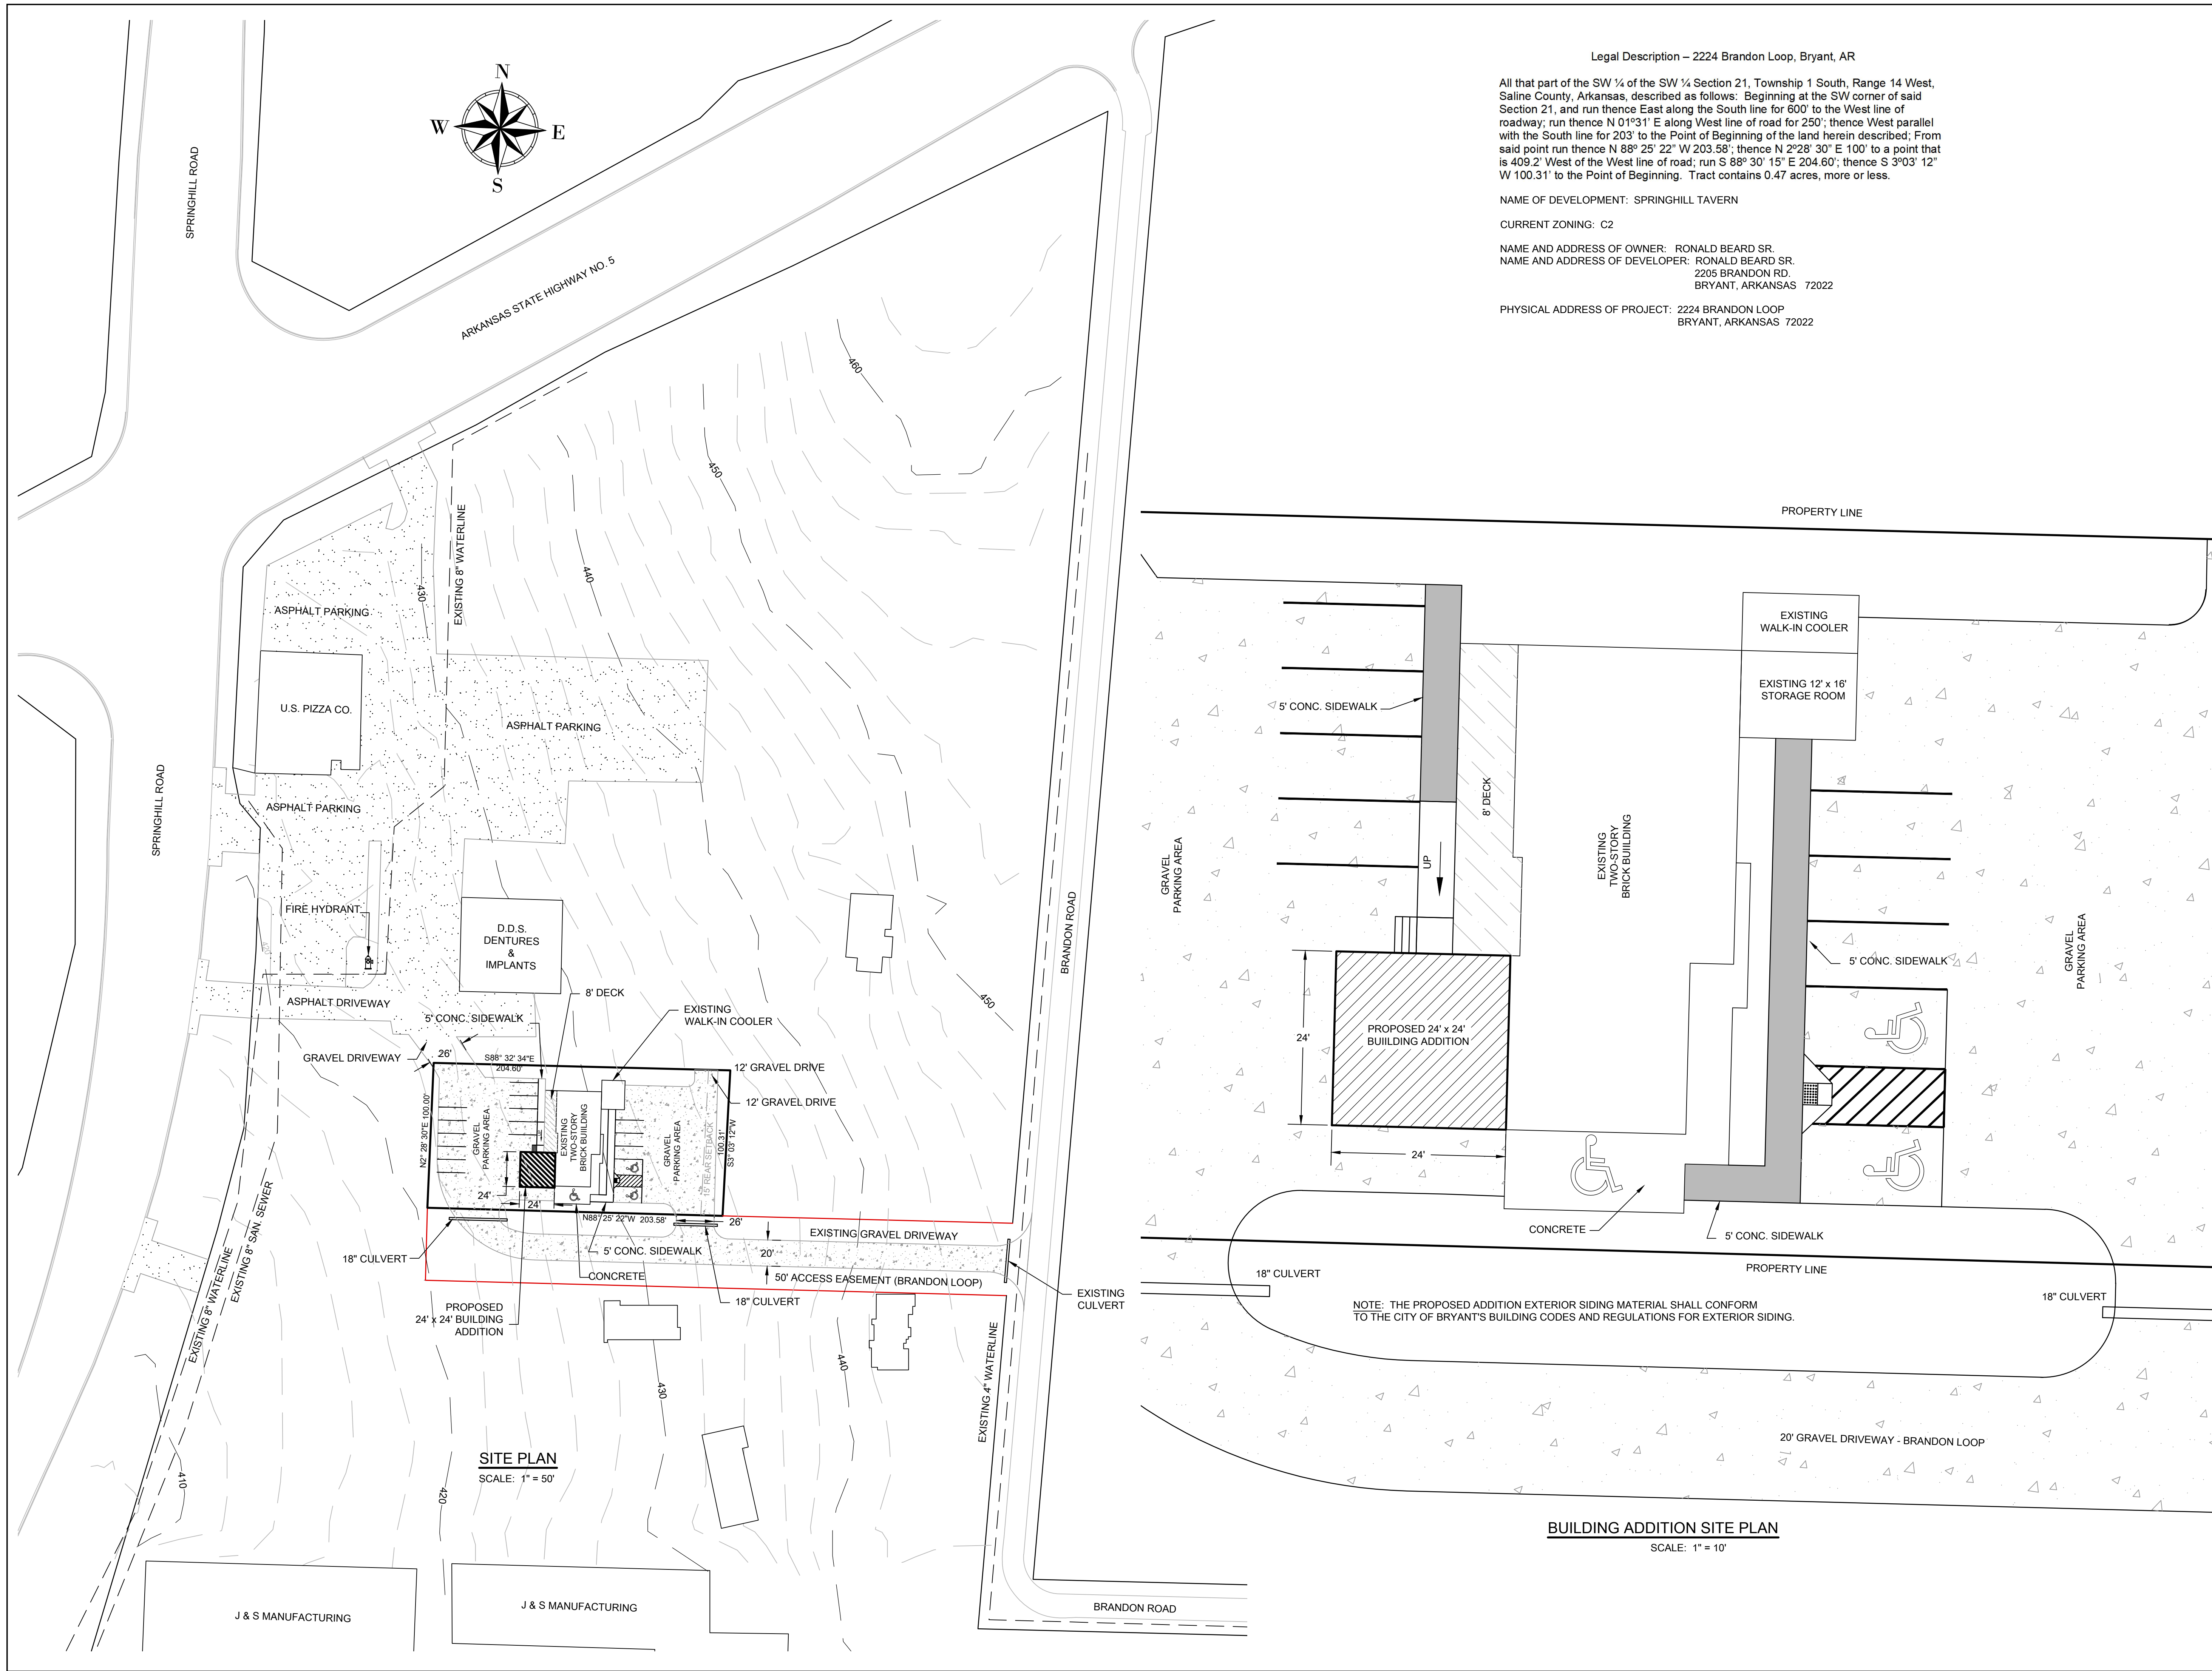


Legal Description – 2224 Brandon Loop, Bryant, AR  
 All that part of the SW ¼ of the SW ¼ Section 21, Township 1 South, Range 14 West, Saline County, Arkansas, described as follows: Beginning at the SW corner of said Section 21, and run thence East along the South line for 600' to the West line of roadway; run thence N 01°31' E along West line of road for 250'; thence West parallel with the South line for 203' to the Point of Beginning of the land herein described; From said point run thence N 88° 25' 22" W 203.58'; thence N 2°28' 30" E 100' to a point that is 409.2' West of the West line of road; run S 88° 30' 15" E 204.60'; thence S 3°03' 12" W 100.31' to the Point of Beginning. Tract contains 0.47 acres, more or less.

NAME OF DEVELOPMENT: SPRINGHILL TAVERN  
 CURRENT ZONING: C2  
 NAME AND ADDRESS OF OWNER: RONALD BEARD SR.  
 NAME AND ADDRESS OF DEVELOPER: RONALD BEARD SR.  
 2205 BRANDON RD.  
 BRYANT, ARKANSAS 72022  
 PHYSICAL ADDRESS OF PROJECT: 2224 BRANDON LOOP  
 BRYANT, ARKANSAS 72022

**MICHAEL BOLIN & ASSOCIATES, INC.**  
**CONSULTING ENGINEERS**  
 P.O. BOX 605, BENTON, AR 72018, (501) 776-2692  
 FAX (501) 776-2619 EMAIL: cmbolin@sbcglobal.net

BRYANT, ARKANSAS  
**SPRINGHILL TAVERN**  
 2224 BRANDON LOOP  
**BUILDING ADDITION SITE PLAN**

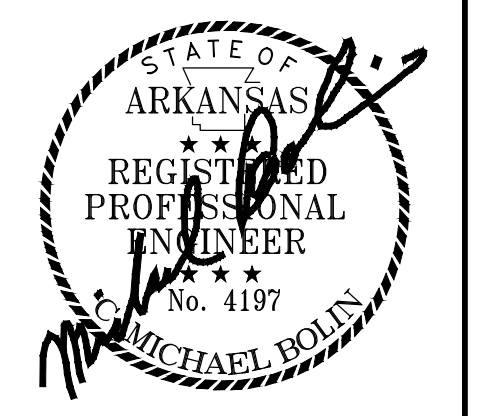

AS-BUILT DATE:  
 CONTACT PERSON:  
 M. BOLIN  
 SCALE:  
 AS SHOWN  
 DATE: AUGUST 2022

BUILDING ADDITION SITE PLAN  
 SHEET NO.  
 JOB NO. 1 OF 1

NOTE: THE PROPOSED ADDITION EXTERIOR SIDING MATERIAL SHALL CONFORM TO THE CITY OF BRYANT'S BUILDING CODES AND REGULATIONS FOR EXTERIOR SIDING.

**BUILDING ADDITION SITE PLAN**  
 SCALE: 1" = 10"

# Bryant Planning Commission

## SMALL SCALE DEVELOPMENT COMMERCIAL BUILDING CHECKLIST

CITY OF BRYANT  
210 SW 3<sup>RD</sup> STREET  
BRYANT, AR 72022  
501-943-0309

**PC MEETING DATE:** THURSDAY OF EACH WEEK  
**TIME:** 9:00 A.M.  
**PLACE:** ADMINISTRATION CONFERENCE ROOM-BRYANT OFFICE COMPLEX  
**AGENDA DEADLINE:** 5:00 P.M. FRIDAY PRIOR TO SCHEDULED MEETING DATE


### REQUIREMENTS FOR SUBMISSION

1. COMPLETED CHECKLIST (SUBDIVISION OR BUILDING)
2. ADA/ABA FORM COMPLETED
3. TWO FULL SETS OF BUILDING PLANS
4. 12 FOLDED COPIES OF SITE PLAN (MINIMUM SIZE 17" X 34") THAT INCLUDES THE FOLLOWING:
  - A. VICINITY MAP
  - B. LEGAL DESCRIPTION
  - C. LANDSCAPING PLAN
5. 12 FOLDED COPIES OF FLOOR PLAN
6. 12 COPIES OF FRONT AND REAR BUILDING ELEVATIONS
7. A CD IN .PDF FORMAT
8. COPY OF ADEQ STORMWATER POLLUTION PREVENTION PLAN FOR PROPERTY PARCEL CONTAINING ONE ACRE OR LARGER.
9. 2 COPIES OF STORMWATER DETENTION PLAN
10. \$250.00 FOR STORMWATER DETENTION AND DRAINAGE PLAN REVIEW

### ALL REQUIREMENTS LISTED ABOVE MUST BE COMPLETED AND ATTACHED BEFORE SUBMITTING APPLICATION TO BE PLACED ON THE PLANNING COMMISSION AGENDA.

NOTE: WHEN MAKING CHANGES TO AN APPROVED SITE PLAN, A REVISED SITE PLAN MUST BE SUBMITTED TO THE BRYANT PLANNING COMMISSION FOR APPROVAL. THIS MUST BE DONE PRIOR TO IMPLEMENTATION. FAILURE TO COMPLY WILL RESULT IN PENALTIES/FINES BEING IMPOSED IN ACCORDANCE WITH CITY ORDINANCES.

I HAVE COMPLIED WITH THE REQUIREMENTS LISTED ABOVE AND HAVE CHECKED ALL OF THE BOXES ON THE CHECKLIST WHICH APPLY TO THIS PROJECT SUBMITTAL.

  
SIGNATURE

  
DATE

# City of Bryant Commercial Building Checklist

Name of Development SPRINGHILL TAVERN  
Site Location 2224 BRANDON LOOP Current zoning C 2  
Owner RONALD BEARD Phone 501-231-6558

## I. BASIC INFORMATION NEEDED ON THE SITE PLAN

- ✓ 1. Name of Development
- ✓ 2. Current zoning
- ✓ 3. Name and Address of owner of Record
- ✓ 4. Name and address of the architect, landscape architect, engineer, surveyor, or other person involved in the preparation of the plan
- ✓ 5. Date of preparation of the plan
- ✓ 6. Vicinity map locating streets, highways, section lines, railroad, schools, & parks within ½ mile
- ✓ 7. Legal description of the property with exact boundary lines
- ✓ 8. North arrow & Scale
- ✓ 9. Identification of any land areas within the 100 year floodplain and within the 100 year floodway
- ✓ 10. Lot area in square feet
- ✓ 11. Show scale (not less than 1" = 100') (paper size minimum 17" X 34")
- ✓ 12. Existing streams, drainage channels, and other bodies of water
- ✓ 13. Drainage easements for stormwater run-off and detention shown & labeled
- ✓ 14. Location and name of existing streets
- ✓ 15. Show source of water supply
- ✓ 16. Show location of waste water connection to municipal system & sanitary sewer layout
- ✓ 17. Fire Hydrant placement
- ✓ 18. Proposed location of buildings and other structures, parking areas, drives, loading areas, service areas, alleys, walks, screening, and public streets
- ✓ 19. Sufficient dimensions to indicate relationship between buildings, property lines, parking areas and other elements of the plan
- ✓ 20. Extent and character of proposed landscaping. Common and/or Botanical plant names and sizes of new vegetation must be clearly indicated.
- ✓ 21. Location, massing and pattern of existing vegetation to be retained
- ✓ 22. Existing structures on the site
- ✓ 23. Pedestrian and vehicular access points, sidewalks, crosswalks, etc.
- N/A  
EXIST. BLDG. ✓ 24. Typical building elevations depicting the style, size and exterior construction materials of the buildings proposed. Where several building types are proposed on the plan, such as apartments and commercial buildings, a separate sketch shall be prepared for each type. The elevations shall be drawn at a minimum scale of 1/16" to a foot and must show adjoining context.
- N/A ✓ 25. Any variance approvals

II ADDITIONAL INFORMATION NEEDED, BUT NOT ON THE SITE PLAN

COMMERCIAL BUILDING WORKSHEET

	Yes	No
Site is compatible with Master Street Plan	<input checked="" type="checkbox"/>	<input type="checkbox"/>
Proposed improvement is within building line setbacks Front <u>0</u> ft. Side <u>0</u> ft. CNR Side <u>0</u> ft. Back <u>15</u> ft.	<input checked="" type="checkbox"/>	<input type="checkbox"/>
Parking requirements can be satisfied Floor Space <u>3351</u> sq.ft. divided by 300 = <u>11.17</u> (no. of parking spaces required)	<input checked="" type="checkbox"/>	<input type="checkbox"/>
Improvement is outside 100 year flood plain (if answer is no - Provide 404 Permit for site)	<input checked="" type="checkbox"/>	<input type="checkbox"/>
Lowest building floor level and all mechanical equipment are above FEMA 100 year flood elevation	<input checked="" type="checkbox"/>	<input type="checkbox"/>
Will there be a dumpster located on the site?	<input type="checkbox"/>	<input checked="" type="checkbox"/>
Will there be a construction site office?	<input type="checkbox"/>	<input checked="" type="checkbox"/>
Have you made "One Call"?	<input type="checkbox"/>	<input checked="" type="checkbox"/>
Structure and site complies with ADA (Americans with Disability Act) and ABA (Architectural Barriers Act) Accessibility Guidelines	<input checked="" type="checkbox"/>	<input type="checkbox"/>
Design complies with Arkansas Plumbing Code and National Electric Code requirements	<input checked="" type="checkbox"/>	<input type="checkbox"/>
Foundation and structure meet earthquake requirements for Zone 1.	<input checked="" type="checkbox"/>	<input type="checkbox"/>
Structure meets Arkansas Energy Code for specified use.	<input checked="" type="checkbox"/>	<input type="checkbox"/>
Complies with Arkansas Fire Prevention Code	<input checked="" type="checkbox"/>	<input type="checkbox"/>
Complies with International Code Council regulations	<input checked="" type="checkbox"/>	<input type="checkbox"/>
Will a Site Clearance Permit be required? (City Ordinance 2002-03)	<input type="checkbox"/>	<input checked="" type="checkbox"/>
Are you granted any variances by the Board of Adjustment?	<input type="checkbox"/>	<input checked="" type="checkbox"/>
If you have been granted a variance please explain in detail:		

III. LANDSCAPING COMPLIANCE WITH REQUIREMENTS

	YES	NO
No planting within 5 feet of a fire hydrant	<input checked="" type="checkbox"/>	<input type="checkbox"/>
Spacing will be 40' between trees	<input checked="" type="checkbox"/>	<input type="checkbox"/>
Tree must be a minimum 3" in diameter at the base and 12' + tall	<input checked="" type="checkbox"/>	<input type="checkbox"/>
Existing trees meeting the minimum size can be counted to meet above criteria	<input checked="" type="checkbox"/>	<input type="checkbox"/>
No trees can be planted within 30 feet of a property corner or driveway	<input checked="" type="checkbox"/>	<input type="checkbox"/>
Shrubs along street right-of-way lines cannot exceed 30 inches in height	<input checked="" type="checkbox"/>	<input type="checkbox"/>

**IV. SITE COVERAGE COMPLIANCE WITH REQUIREMENTS**

(FOR YOUR CONVENIENCE WE HAVE LISTED THE THREE COMMERCIAL ZONING SITE COVERAGE REQUIREMENTS - CHOOSE THE ZONING FOR THIS PROJECT AND COMPLETE ONLY THAT SECTION)

	<u>YES</u>	<u>NO</u>
<b>1. C-1 Zoning - Neighborhood Commercial</b>		
Lot area: minimum of 2,500 square feet; maximum 16,000 square feet	_____	_____
Front Yard: none required	_____	_____
Side Yard: minimum of 5 feet each side	_____	_____
Rear Yard: minimum of 55 feet	_____	_____
Maximum lot coverage of 70% of the total area of the site for all principal, accessory buildings, parking lots, sidewalks, private streets, or drives.	_____	_____
Parking: one space per each 200 sq. ft. of commercial use	_____	_____
Loading areas: physically separated from all streets with 10 ft grassy area	_____	_____
When abuts a residential district, a minimum 6' high wood, rock, or masonry fence is required with a landscape screen	_____	_____
<b>2. C-2 Zoning - Lots fronting along roadways designated as Interstate 30 and frontage roads, State Highway 5 and 183</b>		
Front Yard: not less than 50 feet from front property line	_____	_____
Side Yard: not required, except where they abut a street or a residential lot line then a minimum of 25 feet is required	_____	_____
Rear Yard: minimum of 15 feet, except where they abut residential area then a minimum of 55 feet is required	_____	_____
A maximum lot coverage of 35% of the total area of the site for all principal and accessory buildings	_____	_____
Parking: one space per each 300 sq. ft. of occupied space	_____	_____
When abuts a residential district, a minimum 6' high wood, rock, or masonry fence is required with a landscape screen	_____	_____
<b>3. C-2 Zoning - Lots fronting along roadways designated as interior local.</b>		
Front Yard: none required	✓	_____
Side Yard: not required, except where they abut a street or a residential lot line then a minimum of 25 percent of lot dimension	✓	_____
Rear Yard: minimum of 15 feet, except where they abut residential area then a minimum of 55 feet is required	✓	_____
A maximum lot coverage of 85% of the total area of the site for all principal, accessory buildings and parking	✓	_____
Parking: one space per each 300 sq. ft. of occupied space	✓	_____
When abuts a residential district, a minimum 6' high wood, rock, or masonry fence is required with a landscape screen	N/A	_____

**V. SITE PLAN ATTACHMENTS**

(APPLICATION WILL NOT BE ACCEPTED UNTIL ALL ATTACHMENT REQUIREMENTS ARE MET)

- 26. Letter to Planning Commission stating your request
- 27. Completed Checklist
- 28. Completed ADA/ABA Form
- 29. Two full sets of Building Plans
- 30. 20<sup>12</sup> copies of Site Plan (folded to no larger than 8 1/2 X 14 size) that includes vicinity map and landscaping plan (minimum size 17" X 34" paper)
- 31. 20<sup>12</sup> copies of Landscaping Plan (folded to no larger than 8 1/2 X 14 size)
- 32. 20<sup>12</sup> copies of building floor plan (folded to no larger than 8 1/2 X 14 size)
- N/A 33. Copy of Stormwater Detention approval
- N/A 34. Copy of ADEQ Stormwater Pollution Prevention Plan for property containing one acre or larger.
- 35. IBM compatible diskette or CD with data in PDF format.
- 36. Receipt for \$250.00 for Stormwater Detention and Drainage Plan review

I CERTIFY that the design of SPRINGHILL TAVERN in the City of Bryant, Arkansas complies with the above regulations, laws and codes.

Ronnie Beard  
 Owner  
2205 BRANDON Rd.  
 Mailing Address  
Bryant, AR 72022  
 City

Michael Bol  
 Engineer/Architect  
501-231-6558  
 Phone #  
8/8/2022  
 Date

**CITY USE**

Action Taken:

\_\_\_\_\_  
 \_\_\_\_\_  
 \_\_\_\_\_

Special Conditions:

\_\_\_\_\_  
 \_\_\_\_\_

Permit Issued:	Date _____	Sq.Ft. _____	Amount \$ _____
----------------	------------	--------------	-----------------

Construction Completed Certified For Occupancy:	Date: _____
	Inspector: _____



Permit No. \_\_\_\_\_

## BUILDING PERMIT

### ADA/ABA ACCESSIBILITY STANDARDS

The *Americans with Disability Act* and *Architectural Barriers Act* Accessibility Guidelines were prepared by the U.S. Access Board and mandated by the U. S. Department of Justice regulations implementing Title III as the official ADA/ABA accessibility guidelines. **All new construction, remodeling, and modifications must conform to these building standards** for places of public accommodation and commercial facilities. Residential is exempt.

The ADA/ABA accessibility guidelines contain general design standards for building and site elements, such as accessible entrances and routes, ramps, parking spaces, stairs, elevators, restrooms, signage, etc. Also included are specific standards for restaurants, medical care facilities, libraries and transportation facilities and vehicles, and places of lodging.

The guidelines also include "scoping" requirements that outline the necessary features or appropriate quantity for achieving ready access. For example, at least 50 percent of all public entrances to buildings must be accessible with an accessible path of travel. In public restrooms, at least one bathroom stall must be accessible unless there are more than six stalls, in which case the number increases.

I hereby certify that I have read and examined the above notice and will comply with all guidelines of the ADA Accessibility Guidelines. I further understand that a copy of the ADA/ABA Regulations are available for inspection during business hours of City Hall or I may obtain a copy by writing:

**The Access Board**  
1331 F Street, NW, Suite 1000  
Washington, DC 20004-1111  
(202) 272-0080 (v) (202) 272-0082 (TTY) (202) 272-0081 (fax)  
(800) 872-2253 (v) (800) 993-2822 (TTY)  
email: [info@access-board.gov](mailto:info@access-board.gov)

Signature of Contractor  
or Authorized Agent \_\_\_\_\_ Date \_\_\_\_\_

Signature of Owner  
( if owner-builder) Ronnie Beard \_\_\_\_\_ Date 8/8/22

Application of Permit Approved: \_\_\_\_\_ Date \_\_\_\_\_  
Commission - Chairman

Bryant Water & Sewer Department

**GREASE TRAP STANDARDS**

The City of Bryant requires all commercial buildings comply with plumbing codes found in the Arkansas State Plumbing Code, Latest Edition. All new construction, remodeling, and modifications must conform to these plumbing standards for places of public accommodation and commercial facilities. These guidelines contain general design standards for construction and site elements relating to plumbing.

As of 7/27/04, the Bryant Sewer & Water Commission requires stringent specification standards for commercial or public businesses that involve any food preparation on the premise. The new standard requires calculations, and associated data to be submitted to the Bryant Water Utilities General Manager concurrent with the proposed building plumbing plans along with a grease trap calculation form. Building Permits will not be issued until this form has been received and approved by the Bryant Water Utilities General Manager.

All new buildings or strip centers containing sections designated for commercial enterprise are encouraged to provide a stub-out for a separate waste line for future grease interceptor installation. The owner of a new strip center shall consider suitable physical property space and sewer gradient that will be conducive for the installation of an exterior, in-ground grease interceptor(s) for any flex space contained within the strip center. Physical Property Restrictions and sewer gradient shall not be a defense for failure to install an exterior, in-ground grease interceptor.

I hereby certify that I have read and examined the above notice and will comply with all guidelines of the City of Bryant Water & Sewer Department. I further understand that copies of the Grease Interceptor Design and Structural Criteria regulations will be available from the Bryant Water/Wastewater Plant (501-847-8083) during business hours.

Project Name \_\_\_\_\_




Signature of Contractor  
or Authorized Agent \_\_\_\_\_ Date \_\_\_\_\_

Signature of Owner  
( if owner-builder) Ronnie Beard Date 8-8-22

Calculations  
Approved: \_\_\_\_\_ Date \_\_\_\_\_  
Bryant Water Utilities General Manager

# OLDE SALEM TOWNSHIP SUBDIVISION-PHASE 2 FOR FISER DEVELOPMENT, LLC SALINE COUNTY, ARKANSAS

OLDE SALEM  
TOWNSHIP  
SUBDIVISION

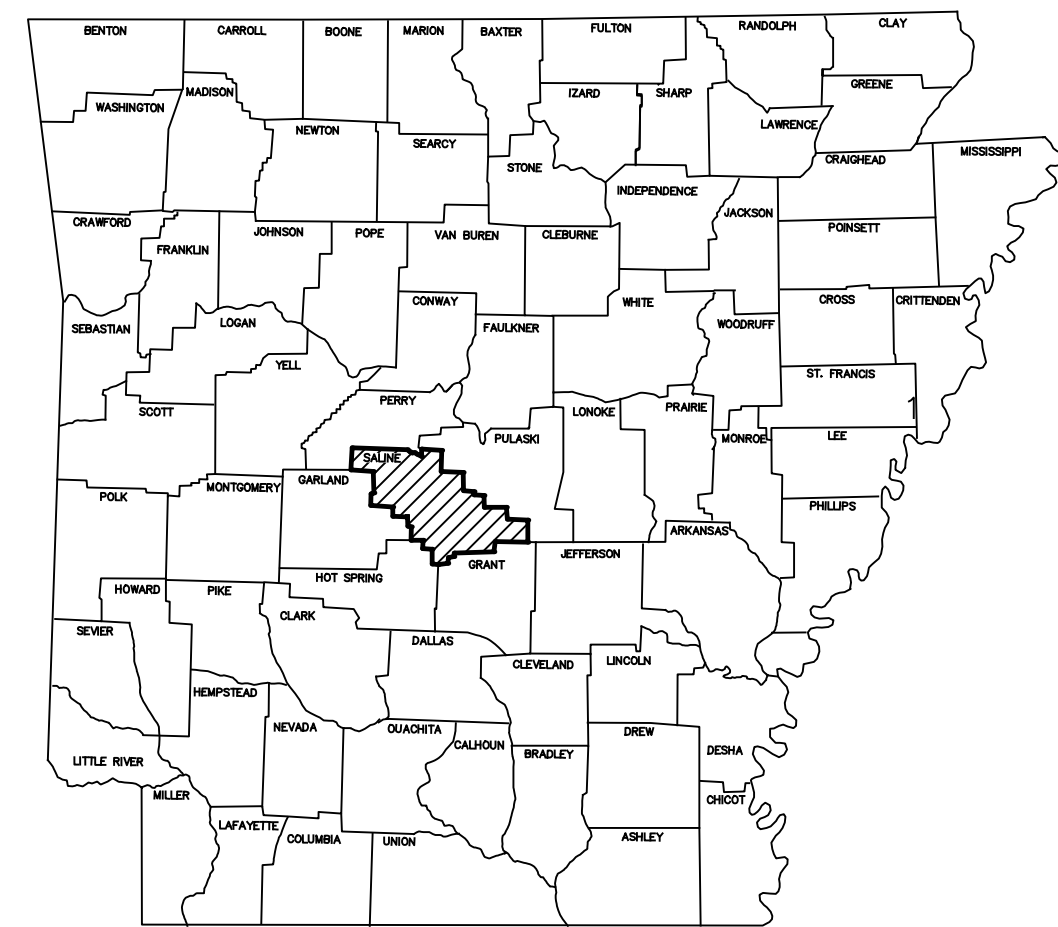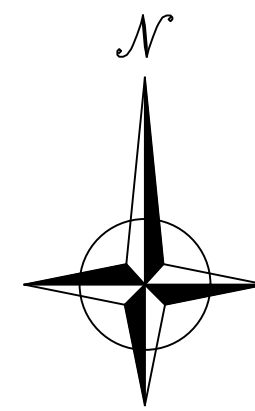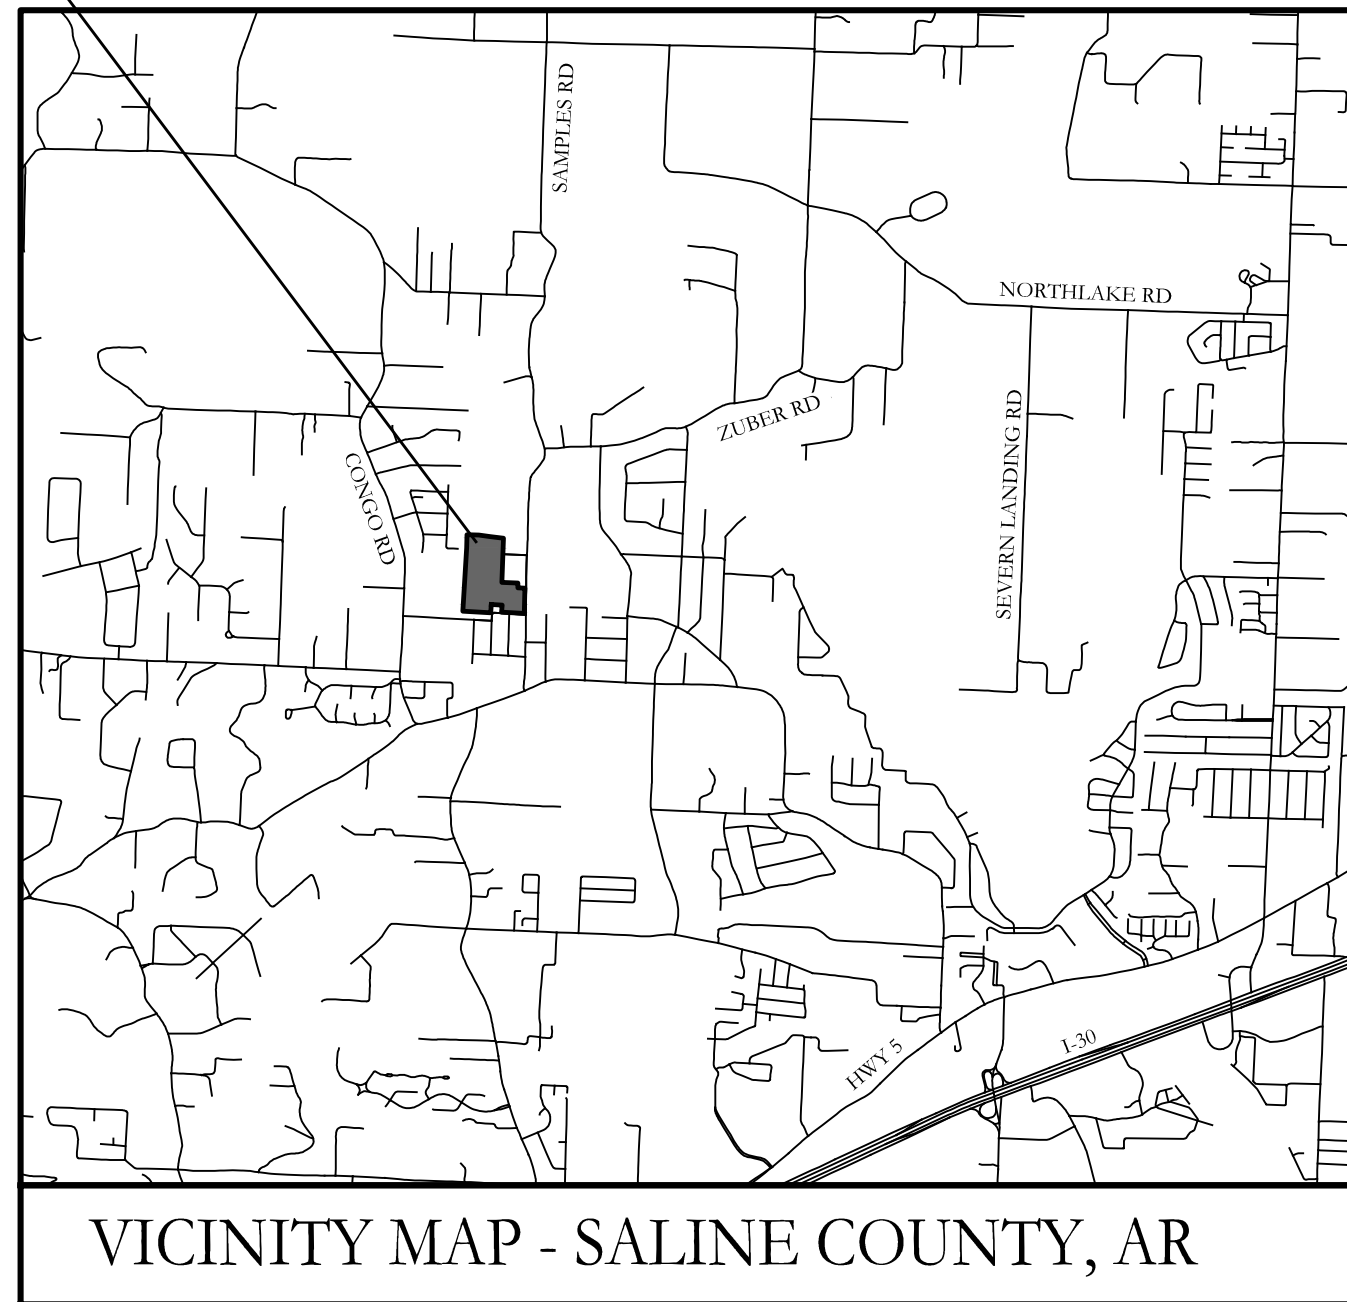

ARKANSAS


Prepared by:

**GarNat Engineering, LLC**

P.O. Box 116 (72018)  
2909 Military Road  
Benton, AR 72015

Ph (501) 408-4650  
Fx (888) 900-3068  
www.garnatengineering.com

RECORD  
DRAWING

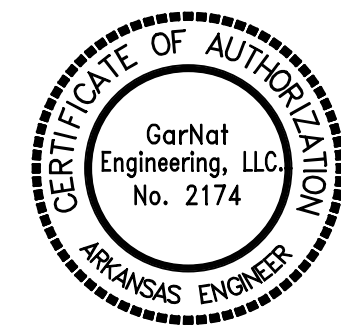

DRAWING INDEX:

- 1 FINAL PLAT
- 2 OVERALL WATER PLAN- PHASE 2
- 3 OVERALL SEWER PLAN (PHASE 1 DRAWINGS)
- 4 SANITARY SEWER PLAN & PROFILE - MAIN E  
STA 0+00 - 10+20 (PHASE 1 DRAWING)
- 5 OVERALL DRAINAGE PLAN- PHASE 2
- 6 DRAINAGE PROFILES
- 7 DRAINAGE PROFILES
- 8 DRAINAGE PROFILES
- 9 ROADWAY PROFILE ESSEX DRIVE  
STA 14+00-26+64 (PHASE 1 DRAWING)
- 10 ROADWAY PROFILES  
(SEVEN GABLES, HAWTHORNE, & SETTLEMENT HOUSE)  
(PHASE 1 DRAWING)

DATE	REVISION	BY
1/26/21	REVISION-1	BLW

Curve #	Length	Radius	Delta	Chord Direction	Chord Length
C1 RD	3.82	100.00	2°11'14"	S4° 17' 16"W	3.82
C2 RD	21.71	100.00	12°26'11"	S11° 14' 45"W	21.66
C3 RD	38.29	100.00	21°56'27"	N12° 58' 01"E	38.06
C4	39.27	25.00	90°00'00"	N48° 11' 39"E	35.36
C5	39.27	25.00	90°00'00"	N41° 48' 21"W	35.36
C6	1.87	75.00	1°25'31"	S3° 54' 25"W	1.87
C7	4.90	125.00	2°14'40"	N4° 18' 59"E	4.90
C8	15.83	75.00	12°05'33"	S11° 04' 27"W	15.80
C9	0.45	75.00	0°20'38"	S17° 17' 32"W	0.45
C10	25.70	125.00	11°46'44"	N10° 55' 02"E	25.65
C11	1.43	125.00	0°39'27"	N17° 08' 08"E	1.43

Curve #	Length	Radius	Delta	Chord Direction	Chord Length
C12	1.49	125.00	0°40'56"	S23° 35' 46"W	1.49
C13	46.38	125.00	21°15'31"	S12° 37' 33"W	46.11
C14	28.72	75.00	21°56'27"	N12° 58' 01"E	28.55
C15	36.51	265.00	7°53'38"	S13° 31' 02"W	36.48
C16	38.75	25.00	88°48'08"	S42° 24' 17"E	34.98
C17	39.79	25.00	91°11'52"	N47° 35' 43"E	35.72
C18	35.03	265.00	7°34'26"	S5° 47' 00"W	35.00

**PROPERTY SPECIFICATIONS:**

ZONING CLASSIFICATION: N/A  
 MIN. LOT SIZE: 8,750 S.F.  
 NUMBER OF LOTS: 35  
 SOURCE OF WATER: SALEM WATER USERS  
 SOURCE OF SEWER: BRYANT



**BUILDING SETBACKS:**  
 FRONT: 15' OR AS SHOWN  
 REAR: 10' OR AS SHOWN  
 SIDE: 5' OR AS SHOWN

**EASEMENTS: UTILITY & DRAINAGE (D.E. & U.E.)**  
 FRONT: 10' OR AS SHOWN  
 REAR: 10' OR AS SHOWN  
 SIDE: 5' OR AS SHOWN

STREET RIGHT OF WAY: 50' OR AS SHOWN  
 STREET WIDTH: 24' BOC TO BOC  
 LOT CORNERS: SET 8" REBAR WITH CAP

**SUBDIVISION IMPROVEMENT DISTRICT**

OLDE SALEM TOWNSHIP PROPERTY OWNERS  
 MULTIPURPOSE IMPROVEMENT DISTRICT #99 OF  
 SALINE COUNTY.

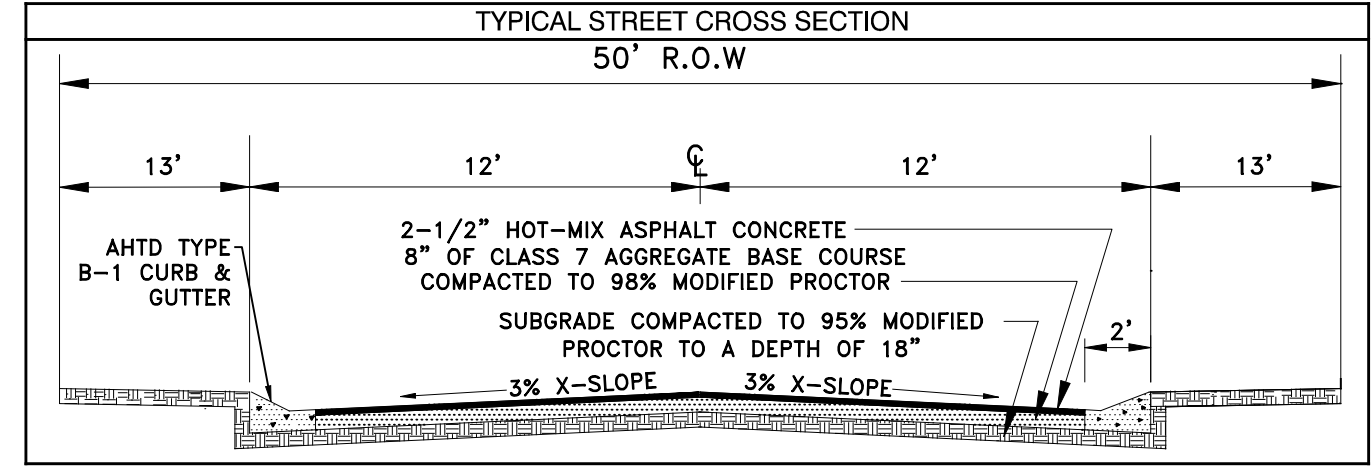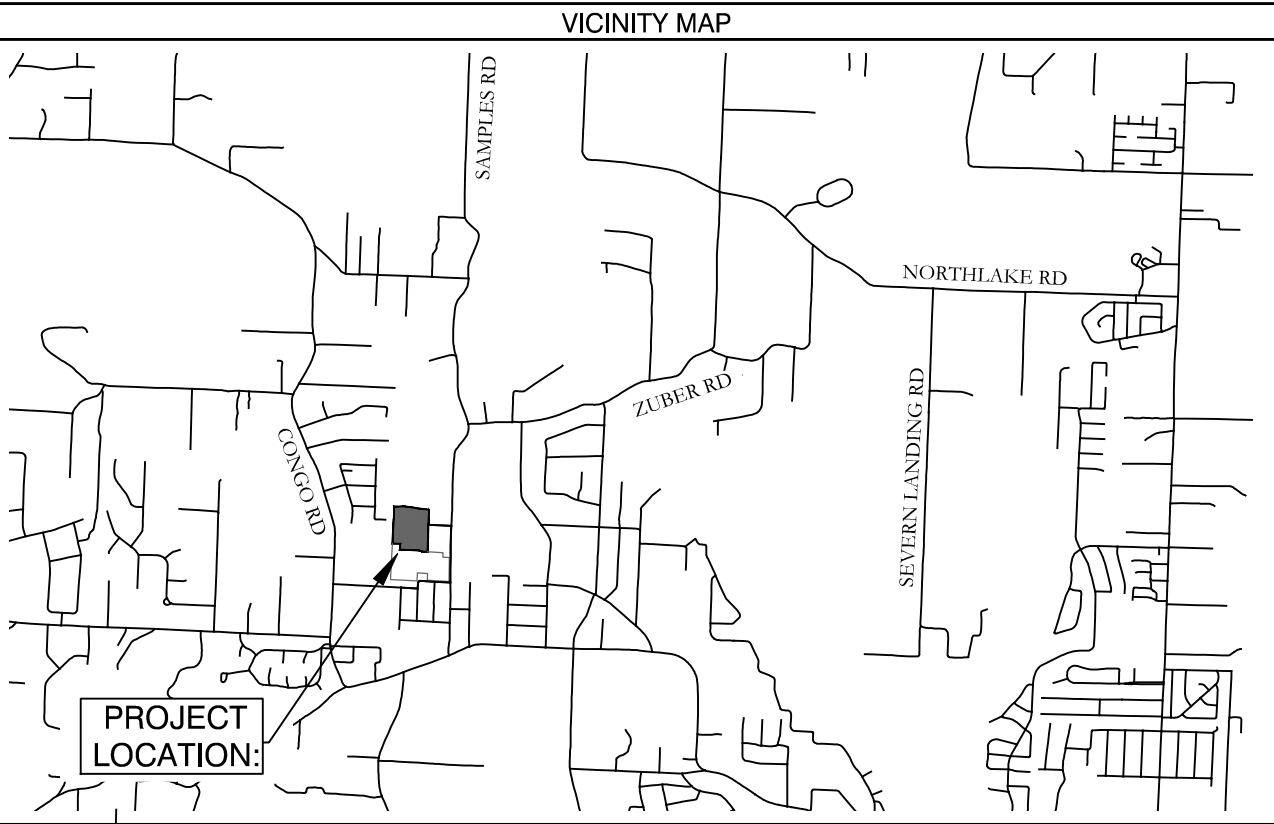

**PROPERTY DESCRIPTION:**

THAT PORTION OF THE NORTHEAST QUARTER OF THE SOUTHWEST QUARTER (NE1/4 SE1/4) AND THE SOUTHWEST QUARTER OF THE NORTHEAST QUARTER (SE1/4 NE1/4) OF SECTION 14, TOWNSHIP ONE SOUTH, RANGE 15 WEST, SALINE COUNTY, ARKANSAS, MORE PARTICULARLY DESCRIBED AS FOLLOWS: BEGINNING AT A 3/4" PIPE FOR THE SOUTH-WEST CORNER OF SAID SE1/4 NE1/4, THENCE NORTH 02°04'39" EAST ALONG THE WEST LINE OF SAID SE1/4 NE1/4 288.38 FEET TO A FOUND FENCE CORNER, THENCE SOUTH 89°21'09" EAST 246.21 FEET TO A SET 1/2" REBAR WITH CAP #1573, THENCE SOUTH 82°24'46" EAST 241.75 FEET TO A SET 1/2" REBAR WITH CAP #1573, THENCE SOUTH 81°45'49" EAST 272.85 FEET TO A SET 1/2" REBAR WITH CAP #1573, THENCE SOUTH 02°30'20" WEST 57.51 FEET TO A FOUND 5/8" REBAR AT THE NORTHWEST CORNER OF RHODES SUBDIVISION, THENCE SOUTH 01°52'27" WEST ALONG WEST LINE OF SAID SUBDIVISION 245.94 FEET TO A SET 1/2" REBAR WITH CAP #1573, THENCE CONTINUING SOUTH 02°07'12" WEST ALONG WEST LINE OF SAID SUBDIVISION 293.47 FEET TO A SET 1/2" REBAR WITH CAP #1573, THENCE SOUTH 01°58'37" WEST 230.42 FEET TO A FOUND 1/2" REBAR WITH CAP #1573 AT THE NORTH-EAST CORNER OF LOT 101, PHASE 2, THENCE NORTH 88°48'21" WEST 431.73 FEET TO A FOUND 1/2" REBAR WITH CAP #1573, THENCE NORTH 03°11'39" EAST 124.15 FEET TO A COMPUTED POINT, THENCE NORTH 88°48'21" WEST 170.00 FEET TO A FOUND REBAR ON THE WEST LINE OF SAID NE1/4 SE1/4, THENCE LEAVING SAID NORTH LINE OF SUBDIVISION, NORTH 03°11'39" EAST ALONG WEST LINE OF SAID NE1/4 SE1/4 A DISTANCE OF 534.33 FEET TO THE POINT OF BEGINNING, CONTAINING 15.51 ACRES, MORE OR LESS.

**BASIS OF BEARINGS:**

GRID NORTH ARKANSAS COORDINATE SYSTEM, SOUTH ZONE BY GPS OBSERVATION

**FLOODPLAIN CERTIFICATION:**

By affixing my seal and signature, I, George P. Wooden, PLS No. 1573, hereby certify that this drawing correctly depicts a survey compiled under my supervision.

According to the Federal Emergency Management Agency (FEMA) Flood Insurance Rate Map (FIRM) for Saline County, Arkansas and incorporated areas, panel # 05125C0225D dated 6/19/2012, no portion (Zone 'X') of the property described hereon does lie within the 100 year flood hazard boundary.

**PLAT CERTIFICATES:**

**OWNER:** Fiser Development, LLC  
**DEVELOPER:** Fiser Development, LLC  
**Name:** Fiser Development, LLC  
**Address:** P.O. Box 1980, Benton, Arkansas 72018-1980

**CERTIFICATE OF OWNER:**  
 We, the undersigned, owners of the real estate shown and described herein do hereby certify that we have laid off, platted and subdivided, and do hereby lay off, plat and subdivide said real estate in accordance with the plat.

Date: \_\_\_\_\_ Signed: \_\_\_\_\_  
 Dee Fiser  
 Fiser Development, LLC

Source of Title: SALINE COUNTY, ARKANSAS  
 Saline County Document# 2014-063332

**CERTIFICATE OF RECORDING:**

**CERTIFICATE OF PROPERTY OWNERSHIP:**  
 I, James E. Villines, hereby certify that the deed records in the office of the Circuit Clerk and Ex-Officio Recorder of Saline County Arkansas, reflect that Fiser Development, LLC is the record title owner of real property more particularly described Herein on plat, dated this \_\_\_\_\_ day of \_\_\_\_\_, 2022.

Licensed Abstractor No. 221-B  
 Or Attorney Bar No. \_\_\_\_\_

**CERTIFICATE OF FINAL SURVEYING ACCURACY:**  
 I, George P. Wooden, hereby certify that this plat correctly represents a boundary survey made by me or under my supervision; that all monuments shown hereon actually exist and their location, size, type and material are correctly shown; and that all interior lot lines are accurately described in terms of length and direction of the property sides.


Date: \_\_\_\_\_ Signed: \_\_\_\_\_  
 George P. Wooden  
 Registered Land Surveyor  
 No. 1573, Arkansas

**CERTIFICATE OF ENGINEERING ACCURACY:**  
 I, Vernon J. Williams, hereby certify that this plat correctly represents a plan made or reviewed by me, and that the engineering requirements of the Saline County Subdivision Rules and Regulations have been complied with.

Date: \_\_\_\_\_ Signed: \_\_\_\_\_  
 Vernon J. Williams  
 Registered Professional Engineer  
 No. 9551, Arkansas

**CERTIFICATE OF FINAL PLAT APPROVAL:**  
 Pursuant to the Saline County Subdivision Rules and Regulations, and all the conditions of approval having been completed, this document is hereby Accepted. This certificate is hereby executed under the authority of said rules and regulations.

Date: \_\_\_\_\_ Signed: \_\_\_\_\_  
 Layne Penfield, Chairman  
 Saline County Planning Board

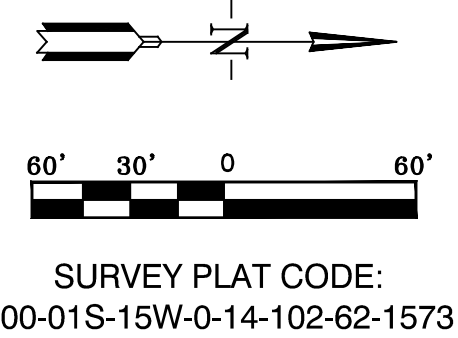

**FINAL PLAT**  
**OLDE SALEM TOWNSHIP**  
**PHASE 2**  
**PLANNED UNIT DEVELOPMENT**  
**SALINE COUNTY, ARKANSAS**

**DUDLEY ROAD**  
**RIGHT OF WAY**  
**0.14 ACRES**  
**6023 Sq. Ft.**

**SURVEY PLAT CODE:**  
**500-01S-15W-0-14-102-62-1573**

BY	
REVISION	
DATE	
<b>GarNat Engineering, LLC</b> Designing our client's success P.O. Box 116 Benton, AR 72018 Ph. (501) 408-4650 garnaengineering@gmail.com	
<b>FINAL PLAT</b> <b>OLDE SALEM TOWNSHIP</b> <b>PHASE 2</b> <b>PLANNED UNIT DEVELOPMENT</b> <b>SALINE COUNTY, ARKANSAS</b>	
<b>FINAL PLAT</b>	
PROJECT NO:	15004
DATE:	FEB. 2022
SHEET NO:	1

- NOTES:**
1. ALL SEWER CONSTRUCTION SHALL BE INSTALLED PER CITY OF BRYANT STANDARD SPECIFICATIONS & DETAILS
  2. MAINTAIN 10 FEET OF HORIZONTAL SEPARATION AND 18 INCHES OF VERTICAL SEPARATION (WATER OVER SEWER) BETWEEN WATER AND SEWER MAINS. IF REQUIRED SEPARATION CANNOT BE ACHIEVED, CONTACT ENGINEER.


COMMON AREA TRACT 'E' OWNED BY POA  
0.49 ACRES  
21322 Sq. Ft.

COMMON AREA TRACT 'A' OWNERSHIP OF IMPROVEMENT DISTRICT  
(WILL REMAIN UNDER IMPROVEMENT DISTRICT)

PARKING AREA TRACT 'F' OWNED BY POA  
0.28 ACRES  
12214 Sq. Ft.


LIFT STATION SITE

# OVERALL SEWER PLAN

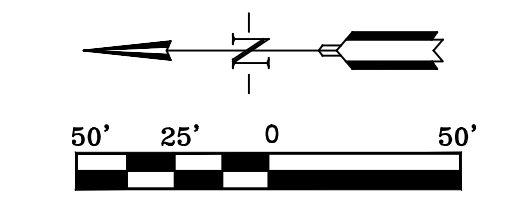

BY	
REVISION	
DATE	
<p><b>GNE</b> Designing our client's success  <b>GarNat Engineering, LLC</b>          P.O. Box 116 (72018) Ph (501) 408-4650          406 W. South St. Suite B Bx (888) 900-3068          Benton, AR 72015 gnatengineering@gmail.com</p>	
<p>OLDE SALEM TOWNSHIP SUBDIVISION FOR FISER DEVELOPMENT, LLC          SALINE COUNTY, ARKANSAS</p>	
<p><b>RECORD DRAWING</b></p>	
<p>CONTENTS:</p> <p><b>OVERALL SEWER PLAN</b></p>	
PROJECT NO:	15004
DATE:	MAY 2015
SHEET NO:	3

J:\Projects\GIS\Projects\15004\Draw Plan - Old Salem Township\Phase 2 AS BUILTS\DRAWINGS\15004 - WATER AND SEWER PLANS - PH 2 - AS-BUILT-072822.dwg

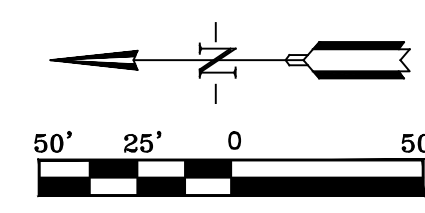


72015.8352  
 8203 SAMPLES RD BR  
 FAYAT, AR 72103  
 001-100

COMMON AREA  
 TRACT 'E'  
 OWNED BY POA  
 0.49 ACRES  
 21322 Sq. Ft.

COMMON AREA  
 OWNED BY POA  
 2.08 ACRES  
 90448 Sq. Ft.

MAIN PHASE 2 PROFILE

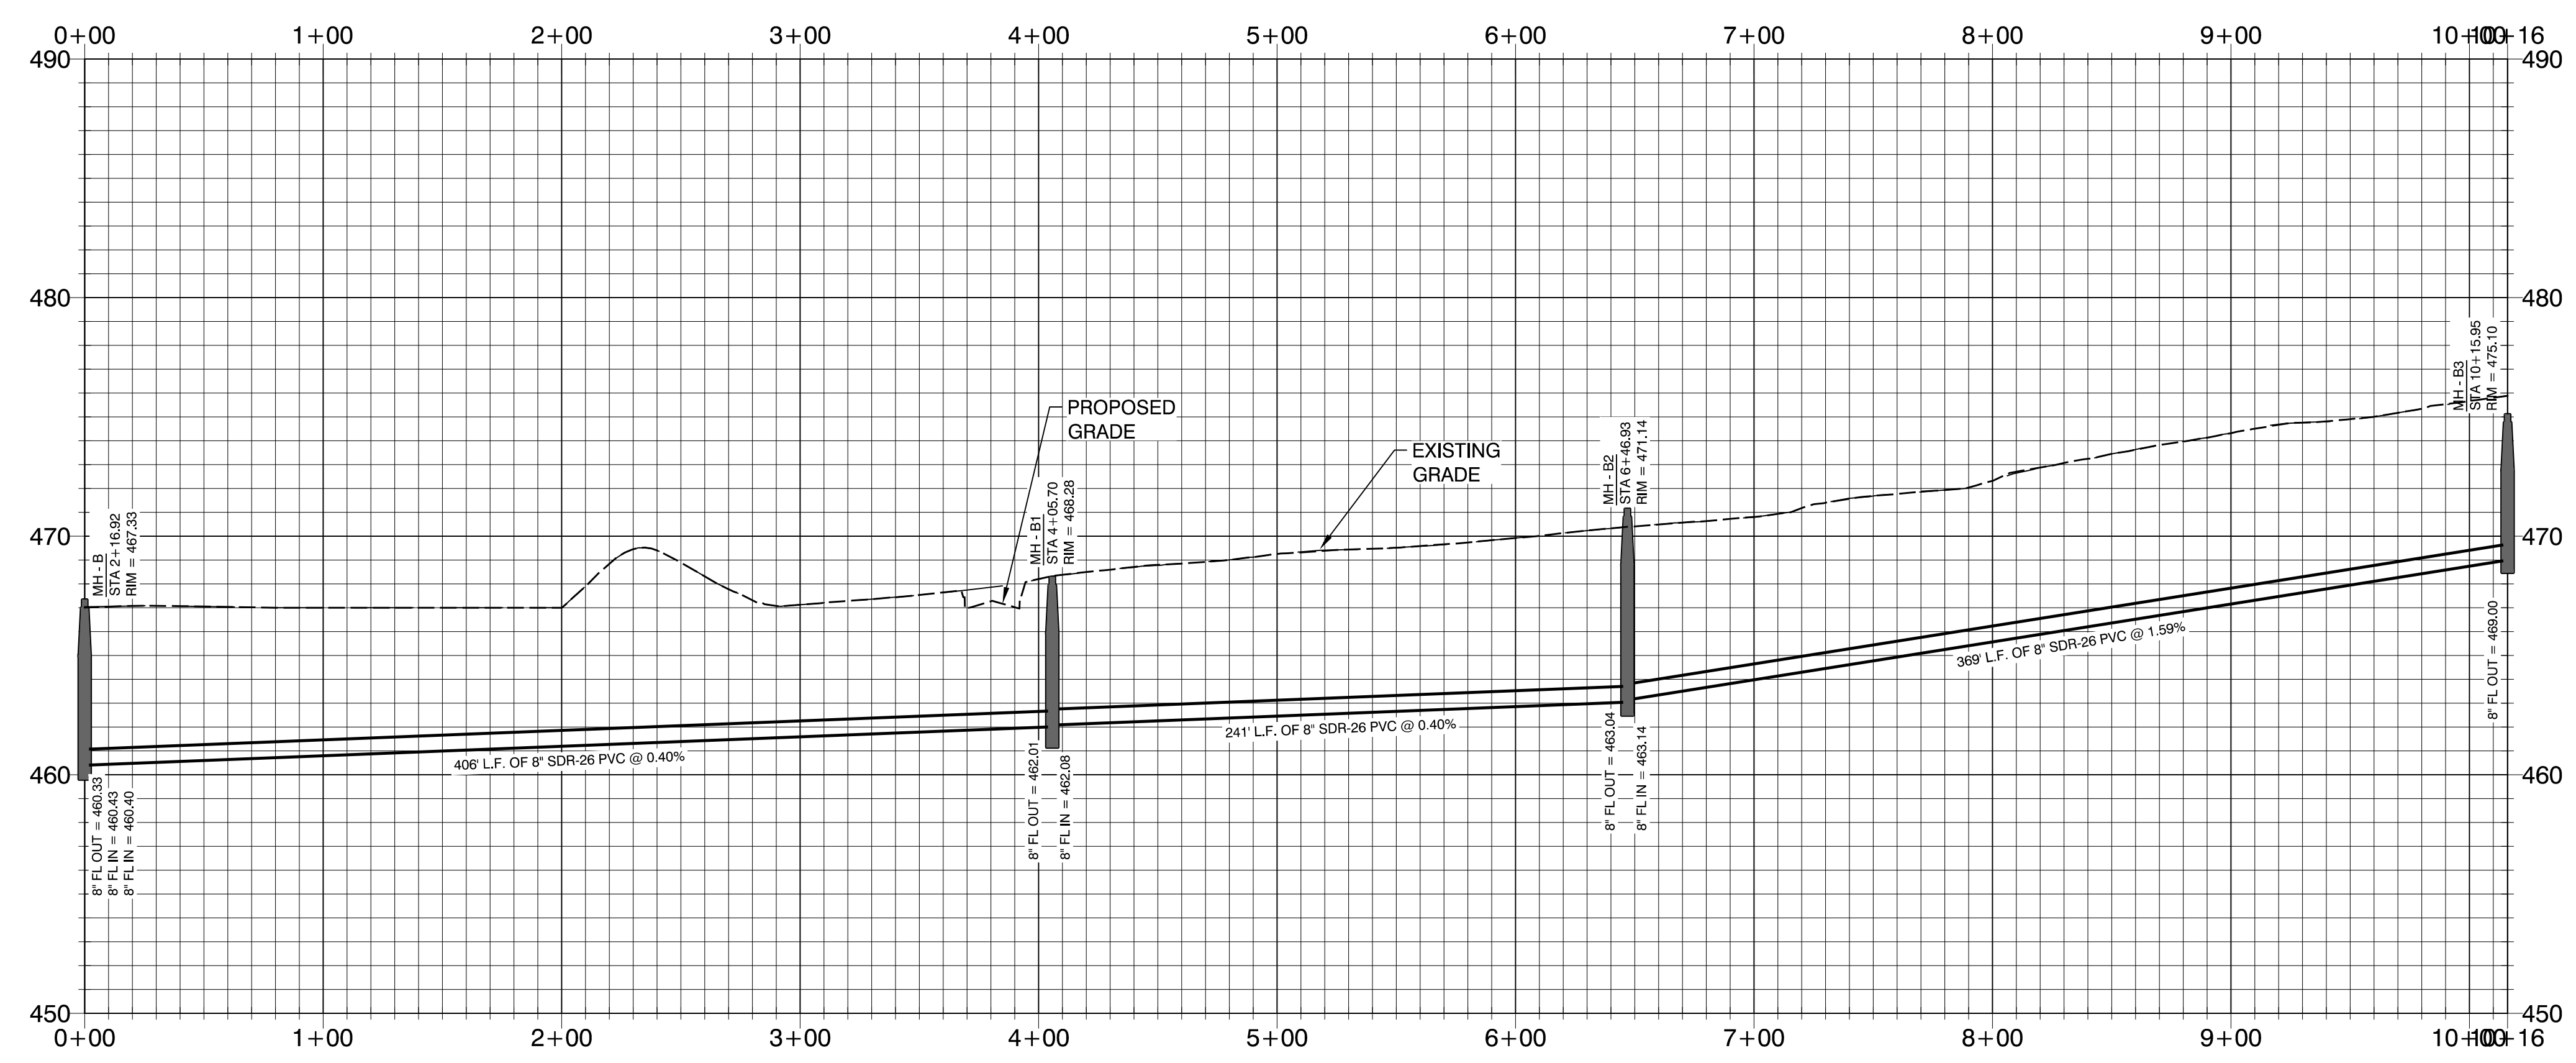

MAIN B - PHASE 2  
 SEWER PROFILES

SCALE:  
 1"=50' : H  
 1"=5' : V

BY	REVISION
DATE	

**GNE** Designing our client's success  
**GarNat Engineering, LLC**  
 P.O. Box 116 (72018) Ph (501) 408-4650  
 406 W. South St. Suite B Fx (888) 900-3068  
 Benton, AR 72015 gnatengineering@gmail.com

OLDE SALEM TOWNSHIP SUBDIVISION  
 FOR FISER DEVELOPMENT, LLC  
 SALINE COUNTY, ARKANSAS

**RECORD  
 DRAWING**

CONTENTS:  
 SANITARY  
 SEWER  
 PLAN & PROFILE  
 MAIN B - PH 2

PROJECT NO:  
 15004

DATE:  
 MARCH 2015



SHEET NO:  
**4**

J:\Projects\0318 Projects\15004.dwg - Phase - Olde Salem Township\0318\Phase 2 AS BUILTS DRAWINGS\15004\_FISER - WATER AND SEWER PLANS - PH 2\_P2-AS-BUILT-072822.dwg



130-00013-000  
SWADLEY BLAKE, A & BLANCHE CHARLENE  
7905 SPRINGHILL RD

130-00015-001  
SYENABELE, BRUCE W & RTA L  
2220 JOYCE CIR

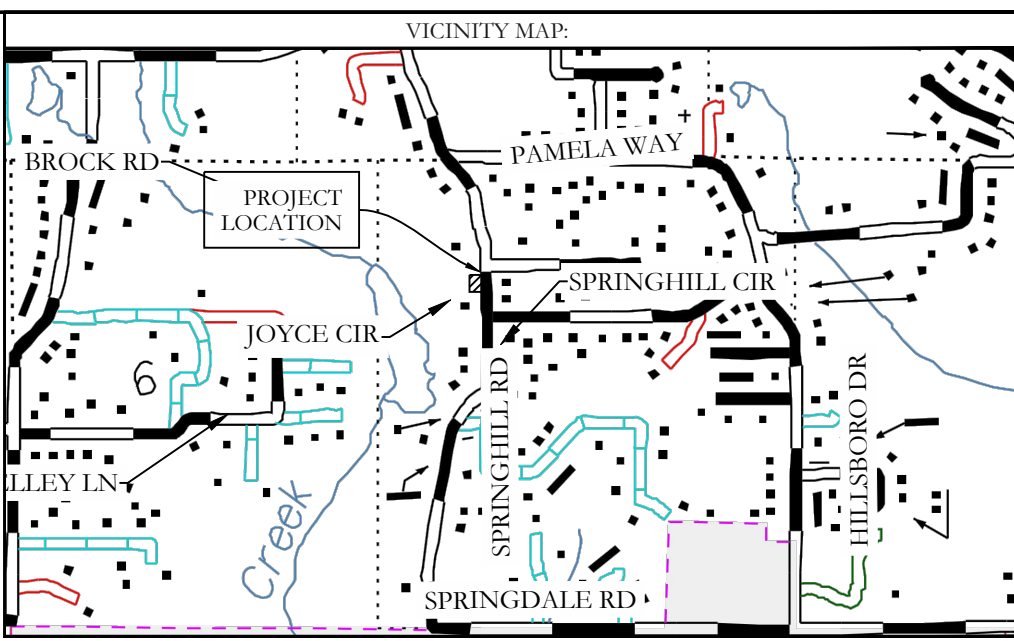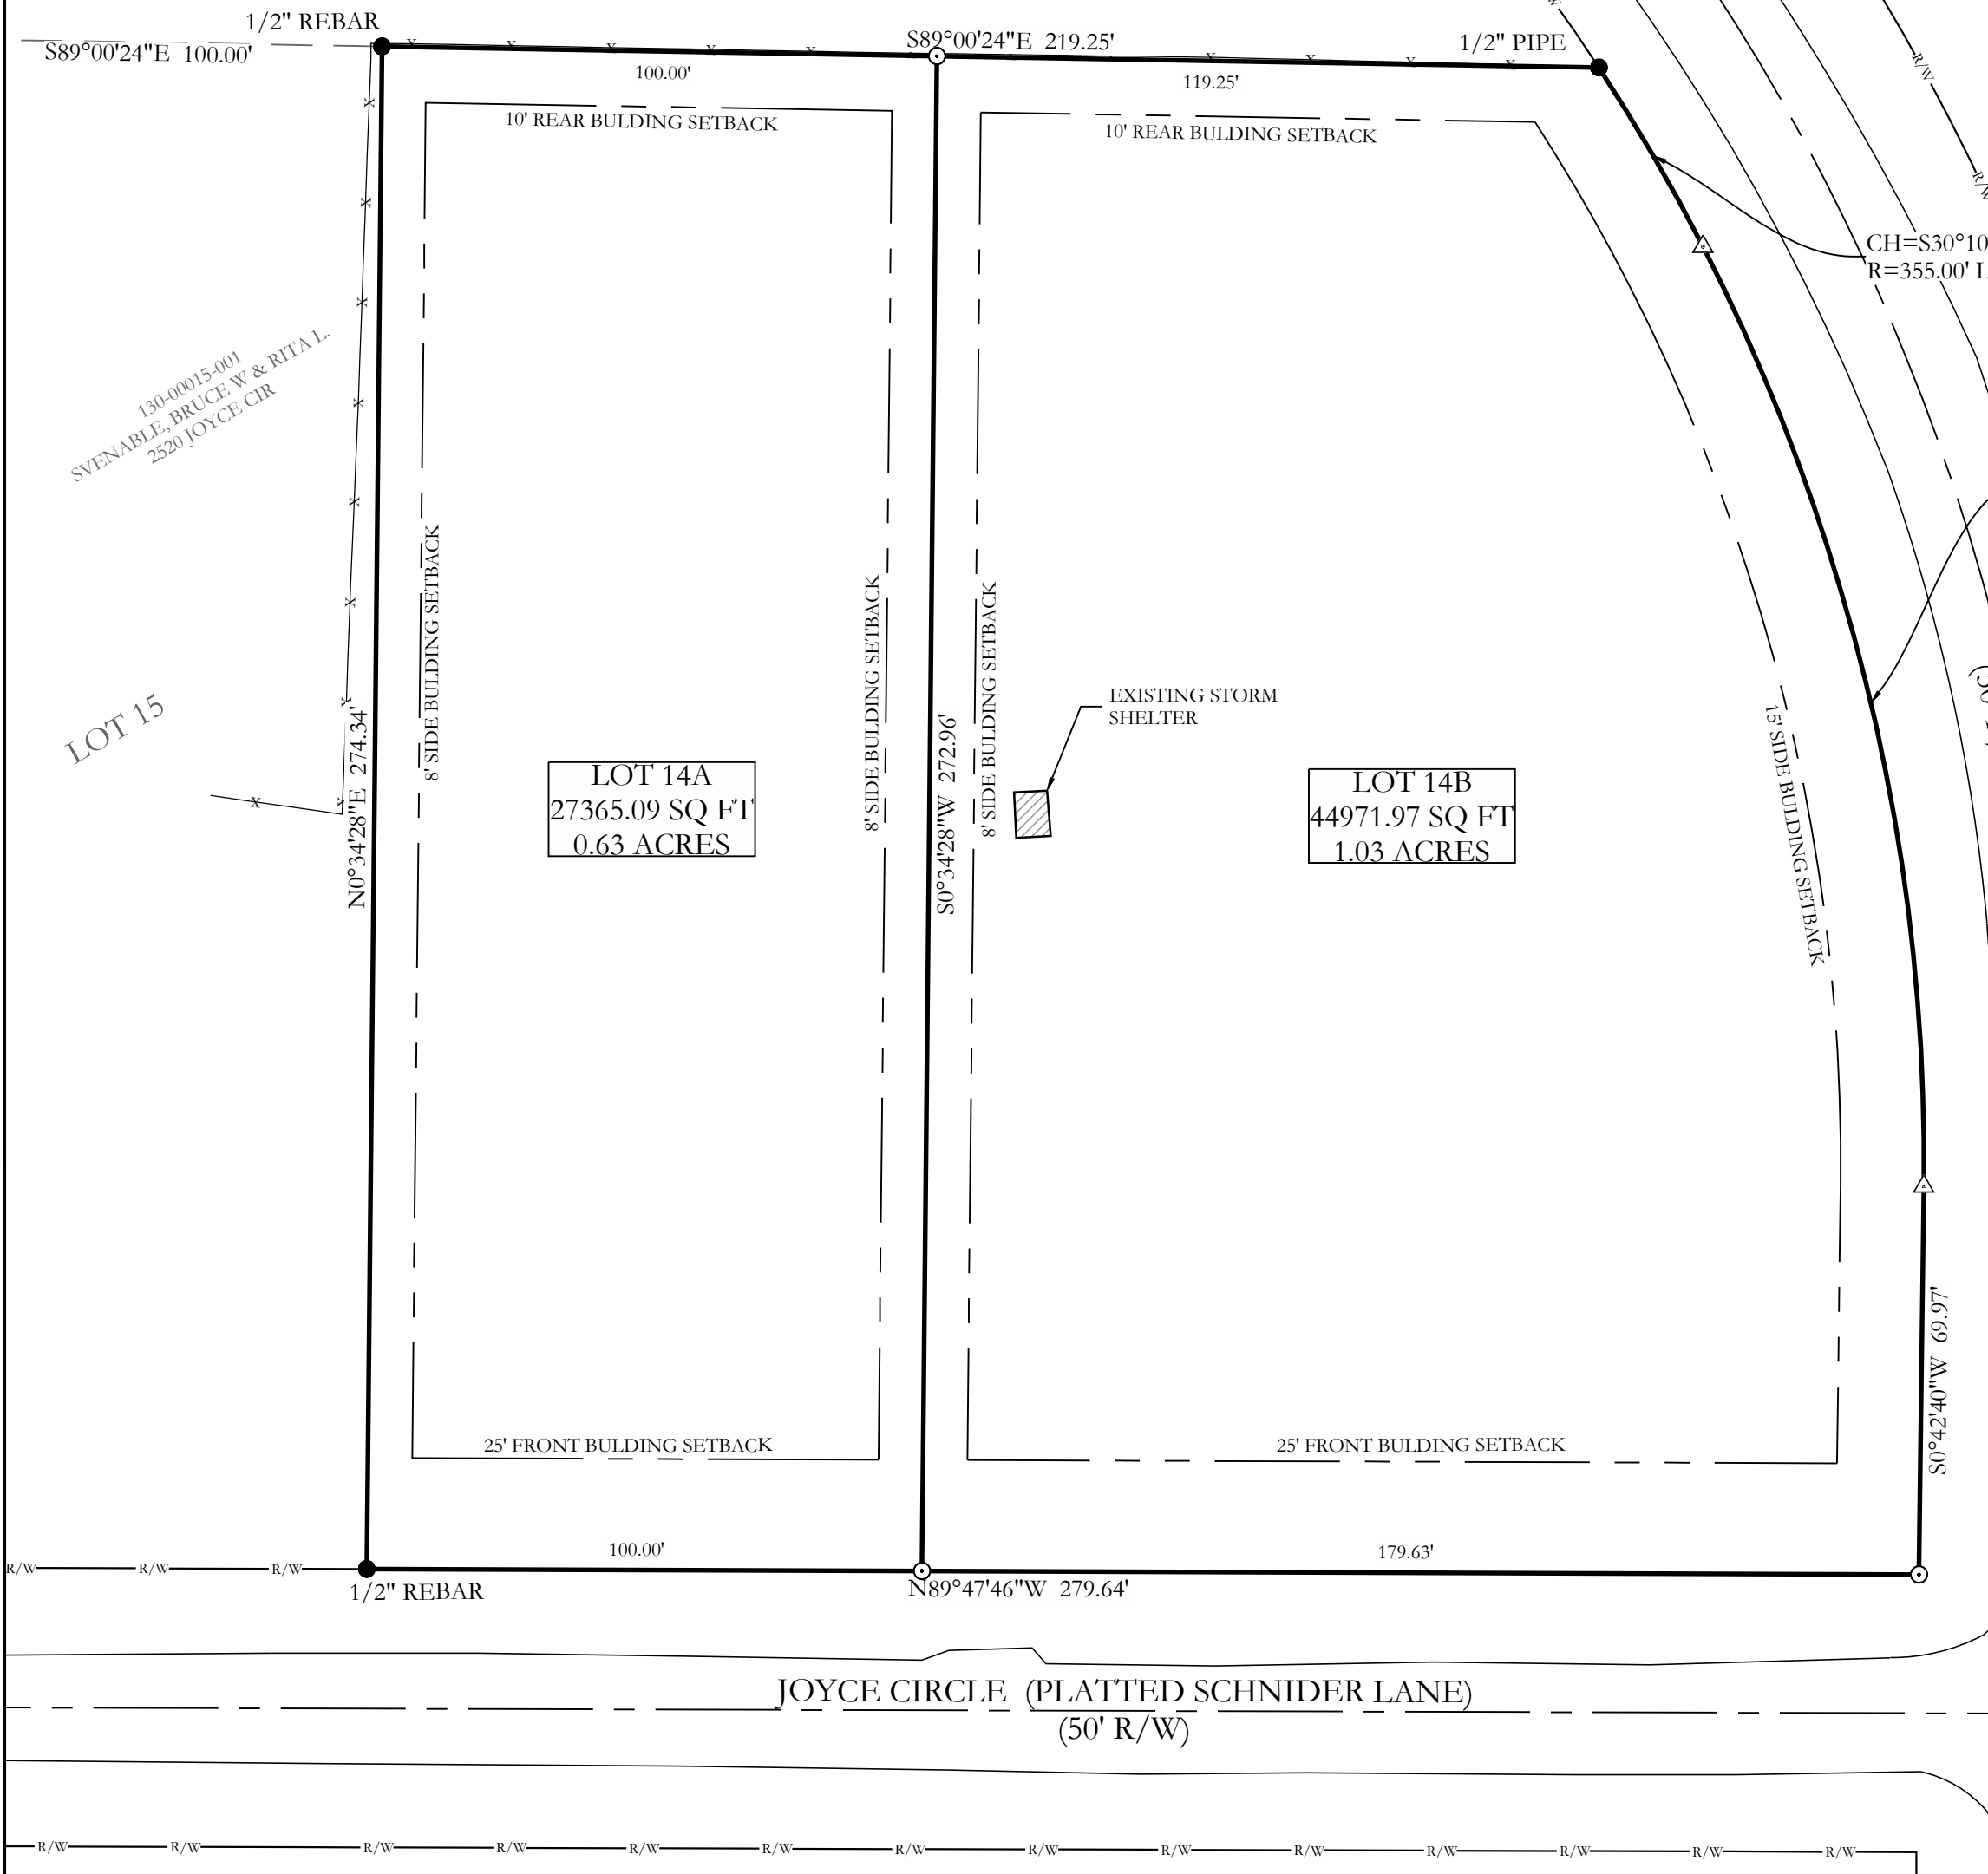

OWNER: NAME: Tony Bessent  
DEVELOPER: Tony Bessent  
Address: 3621 Independence Drive, Bryant, Arkansas 72022

CERTIFICATE OF OWNER:  
We, the undersigned, owners of the real estate shown and described herein do hereby certify that we have laid off, platted and subdivided, and do hereby lay off, plat and subdivide said real estate in accordance with the plat.

Date of Execution \_\_\_\_\_ Name: \_\_\_\_\_  
Source of Title: Saline County Document # 2013-91073

CERTIFICATE OF FINAL SURVEYING ACCURACY:  
I, Corbitt R. Shoffner, hereby certify that this plat correctly represents a survey completed by me, or under my supervision, that the boundary lines shown hereon correspond with the description in the deeds cited in the above Source of Titles; and that all monuments which were found or placed on the property are correctly described and located.

May 27, 2022  
Date of Execution  
Name: W. Corbitt R. Shoffner, Registered Professional Land Surveyor, No. 1664 Arkansas

CERTIFICATE OF PROPERTY OWNERSHIP:  
I, \_\_\_\_\_, hereby certify that the deed records in the office of Circuit Clerk and Ex-Officio recorder of Saline County, Arkansas, reflect that \_\_\_\_\_ are the record title owners of real property more particularly described Herein on plat, dated this \_\_\_\_\_ day of \_\_\_\_\_, 20\_\_\_\_\_.  
Licensed Abstractor No. \_\_\_\_\_

CERTIFICATE OF FINAL APPROVAL:  
Pursuant to the Saline County Subdivision Rules and Regulations, this document was given approval by the Saline County Director. All of the conditions of approval having been completed, this document is hereby accepted, and this certificate executed under the authority of said rules and regulations.

Date of Execution \_\_\_\_\_ Layne Penfield, Saline County Planning Chairman




By affixing my seal and signature, I, Corbitt Shoffner, Arkansas PS No. 1664, hereby certify that this drawing correctly depicts a survey compiled by me or under my direct supervision.

FLOOD STATEMENT  
NO PORTION OF THE PROPERTY DESCRIBED HEREON LIES WITHIN A SPECIAL FLOOD HAZARD AREA, ACCORDING TO FLOOD INSURANCE RATE MAP, PANEL # 05125C0225D, DATED: 06/19/2012

**HOPE CONSULTING**  
ENGINEERS - SURVEYORS  
117 S. Market Street, Benton, Arkansas 72015  
PH. (501)315-2626  
FAX (501) 315-0024  
www.hopeconsulting.com

FOR USE AND BENEFIT OF:  
BESSENT CONSTRUCTION, LLC  
LOT 14A & 14B  
A REPLAT OF LOT 14,  
H. E. & L. SUBDIVISION,  
A SUBDIVISION IN SALINE COUNTY, ARKANSAS

**GENERAL SURVEY NOTES:**  
CURRENT OWNER: TONY T. BESSENT  
PHYSICAL ADDRESS: 2512 JOYCE CIRCLE, ALEXANDER, AR  
COUNTY PARCEL ID: 130-00014-000  
THIS PLAT REPRESENTS A BOUNDARY SURVEY AND REPLAT OF LOT 14, H. E. & L. SUBDIVISION INTO TWO NEW LOTS BEING LOT 14A AND LOT 14B.  
ALL LISTED MEASUREMENTS ARE AS MEASURED IN THE FIELD. FOR RECORD MEASUREMENTS, SEE DEEDS OF RECORD.  
ADJACENT OWNERSHIP IS LISTED AS FILED IN THE SALINE COUNTY TAX ASSESSOR'S OFFICE AND IS SHOWN FOR REFERENCE ONLY.  
THIS SURVEY IS FOR THE EXCLUSIVE USE AND BENEFIT OF PARTIES SHOWN HEREIN. USE OR DUPLICATION OF THIS DOCUMENT BY ANY OTHER PARTIES IS PROHIBITED AND VOIDS SAID DOCUMENT.

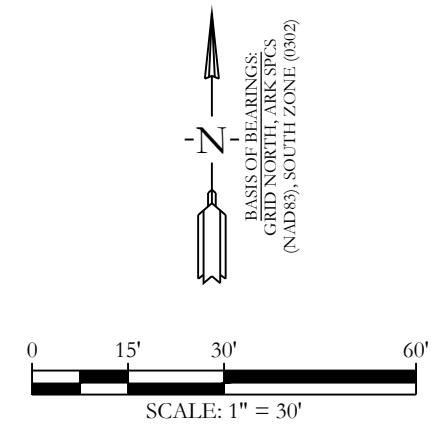


**LEGEND**

- - Found Aliquot Corner
- - Found monument
- - Set 1/2" Rebar
- △ - Computed point
- (M) - Measured
- (P) - Plat/Deed
- - - - - Fence

DATE: 05/24/2022	C.A.D. BY: MD	DRAWING NUMBER:
REVISED:	CHECKED BY: WCS	22-0534
SHEET: 500	SCALE: 1" = 30'	
01N	14W	0 05 130 62 1664

KS Land Surveyors 2022/05/24 15:58:15 LOT 14 H, E. & L. SUBDIVISION Survey DWG 214634 HSI LOT 14 H, E. & L. SUBDIVISION.dwg | PLOTTED: 5/29/22 12:46 PM

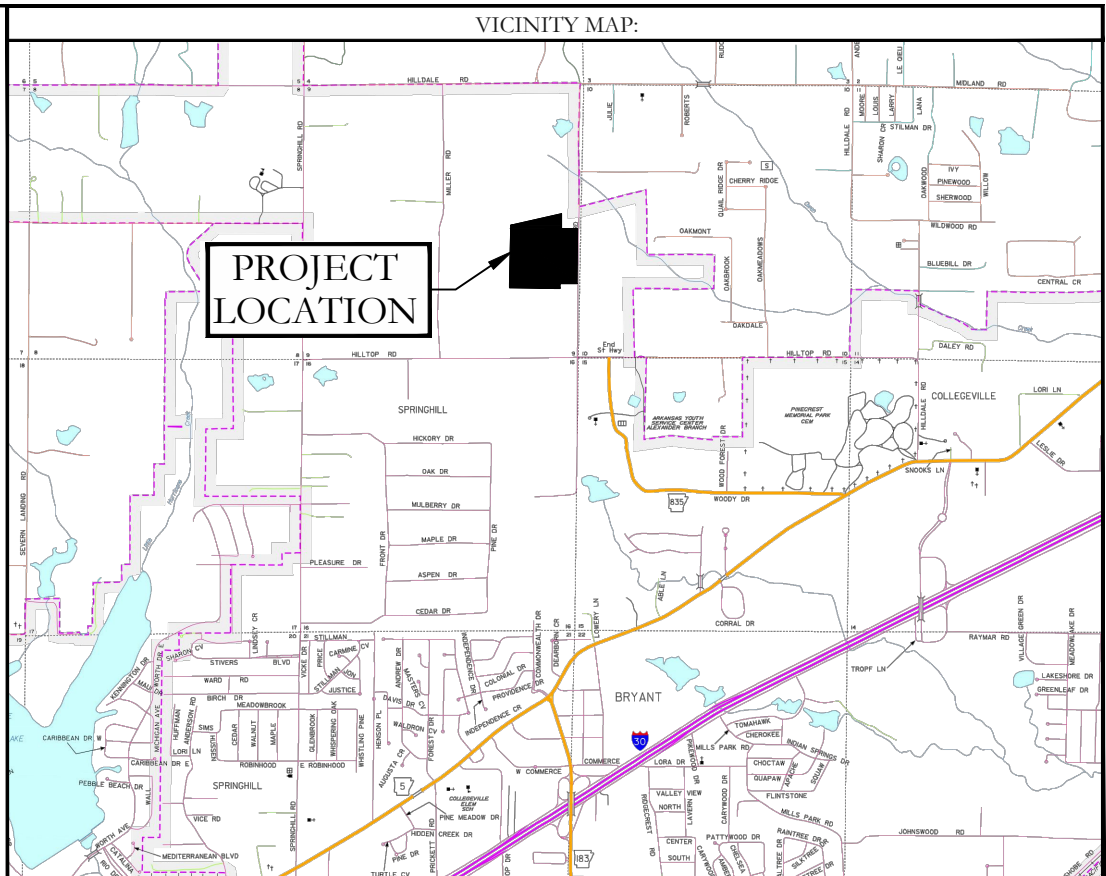

**CERTIFICATIONS:**

**OWNER:** SOUTHERN GENERAL CONTRACTORS  
 Name: SOUTHERN GENERAL CONTRACTORS  
 Address: BOX 242146  
 LITTLE ROCK, AR 72223

**DEVELOPER:** SOUTHERN GENERAL CONTRACTORS  
 Name: SOUTHERN GENERAL CONTRACTORS  
 Address: BOX 242146  
 LITTLE ROCK, AR 72223

**CERTIFICATE OF OWNER:**

We, the undersigned, owners of the real estate shown and described herein do hereby certify that we have had lot, platted and subdivided, and do hereby lay off, plat and subdivide said real estate in accordance with the within plat.

Date of Execution: \_\_\_\_\_ Name: \_\_\_\_\_

**CERTIFICATE OF SURVEYING ACCURACY:**

I, Jonathan L. Hope, hereby certify that this plat correctly represents a survey and a plan made by me or under my supervision; that all monuments shown hereon actually exist and their location, size, type and material are correctly shown; and that all interior lot lines have been adjusted to "as built conditions" and are accurately described on the plat and identified on the ground in terms of length and direction of the property side as required in accord with the City of Bryant Subdivision Regulation Ordinance.

Date of Execution: \_\_\_\_\_ Jonathan L. Hope  
 Registered Professional  
 Land Surveyor No. 1762  
 Arkansas

**CERTIFICATE OF FINAL ENGINEERING ACCURACY:**

I, William W. McFadden, hereby certify that this plat correctly represents a plan made by me, and that the engineering requirements of the City of Bryant Subdivision Rules and Regulations have been followed.


Date of Execution: \_\_\_\_\_ William W. McFadden  
 Registered Professional  
 Engineer, No. 14048  
 Arkansas

**CERTIFICATE OF FINAL APPROVAL:**

Pursuant to the City of Bryant Subdivision Rules and Regulations, this document was given approval by the Bryant Planning Commission at a meeting held on \_\_\_\_\_, 2017. All of the document is hereby accepted, and this certificate executed under the authority of said rules and regulations.

Date of Execution: \_\_\_\_\_ Rick Johnson,  
 Bryant Planning Commission

**FINAL PLAT**  
**LOMBARD HEIGHTS SUBDIVISION, PHASE 1**  
 A SUBDIVISION IN THE CITY OF BRYANT, SALINE COUNTY, ARKANSAS




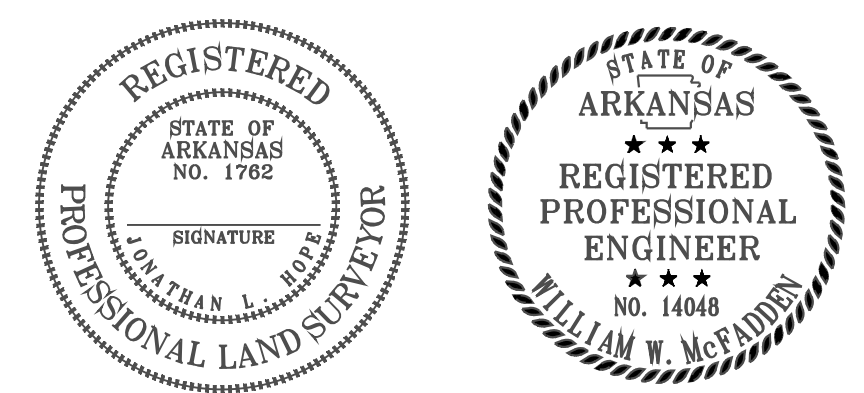


**PROPERTY DESCRIPTION:**

PART OF THE NORTHEAST QUARTER OF THE SOUTHEAST QUARTER (NE/4 SE/4), PART OF THE SOUTHWEST QUARTER OF THE SOUTHEAST QUARTER (SW/4 SE/4), ALL IN SECTION 9, TOWNSHIP 1 SOUTH, RANGE 14 WEST OF THE FIFTH PRINCIPAL MERIDIAN MORE PARTICULARLY DESCRIBED AS FOLLOWS:

**COMMENCING AT THE NE CORNER OF SAID SE 1/4 OF THE SE 1/4, SAID POINT BEING A FOUND 1/2" REBAR WITH A CAP, THENCE, ALONG THE NORTH LINE OF SAID SE 1/4, SE 1/4 S 89°29'56" W A DISTANCE OF 40.65 FEET TO THE POINT OF BEGINNING; THENCE, S 0°09'30"26" E A DISTANCE OF 152.28 FEET; THENCE, N 63°32'07" W A DISTANCE OF 106.51 FEET; THENCE, N88°19'27" W A DISTANCE OF 613.43 FEET; THENCE, N 01°50'33" E A DISTANCE OF 175.01 FEET; THENCE, N13°18'33" E A DISTANCE OF 51.05 FEET; THENCE, N 02°32'03" E A DISTANCE OF 8000 FEET; THENCE, S 88°19'27" E A DISTANCE OF 410.05 FEET; THENCE, N 70°39'30" E A DISTANCE OF 53.88 FEET; THENCE, S 87°27'57" E A DISTANCE OF 169.40 FEET; THENCE, S 64°38'17" E A DISTANCE OF 228.48 FEET; THENCE, S 88°19'27" E A DISTANCE OF 210.44 FEET TO A POINT THE WEST RIGHT OF WAY OF LOMBARD HEIGHTS ROAD; THENCE, ALONG SAID RIGHT OF WAY S01°13'12" W A DISTANCE OF 19.44 FEET; THENCE, S02°49'06" W A DISTANCE OF 71.03 FEET; THENCE, S04°06'35" W A DISTANCE OF 110.40 FEET; THENCE, S05°06'02" W A DISTANCE OF 55.48 FEET; THENCE, S03°10'56" W A DISTANCE OF 205.50 FEET TO THE POINT OF BEGINNING AND HAVING AN AREA OF 8.50 ACRES (370,381 SQUARE FEET).**

Curve #	Delta	Chord B & D	Arc Length	Arc Radius
C1	91°41'52"	S42°28'51"E 35.88	40.01	25.00
C2	11°27'21"	S82°35'47"E 45.91	45.99	230.00
C3	4°59'05"	S74°22'34"E 20.00	20.01	230.00
C4	73°15'55"	S68°07'04"E 30.21	30.24	230.00
C5	20°07'22"	S74°24'47"E 94.34	94.83	270.00
C6	3°58'59"	S86°23'58"E 18.14	18.14	270.00
C7	89°08'29"	N47°06'23"E 35.09	38.89	25.00
C8	90°51'40"	S42°53'37"E 35.62	39.65	25.00
C9	80°08'29"	N47°06'18"E 35.09	38.90	25.00
C10	90°51'31"	S42°53'42"E 35.62	39.64	25.00
C11	11°17'16"	S82°43'59"E 62.38	62.48	320.00
C12	12°47'06"	S70°44'39"E 71.26	71.40	320.00
C13	23°58'21"	S76°20'17"E 74.76	75.31	180.00
C14	85°57'35"	N48°44'47"E 34.09	37.51	25.00
C15	23°58'21"	S76°20'17"E 74.76	75.31	205.00
C16	23°58'21"	N76°20'17"W 122.53	123.43	295.00

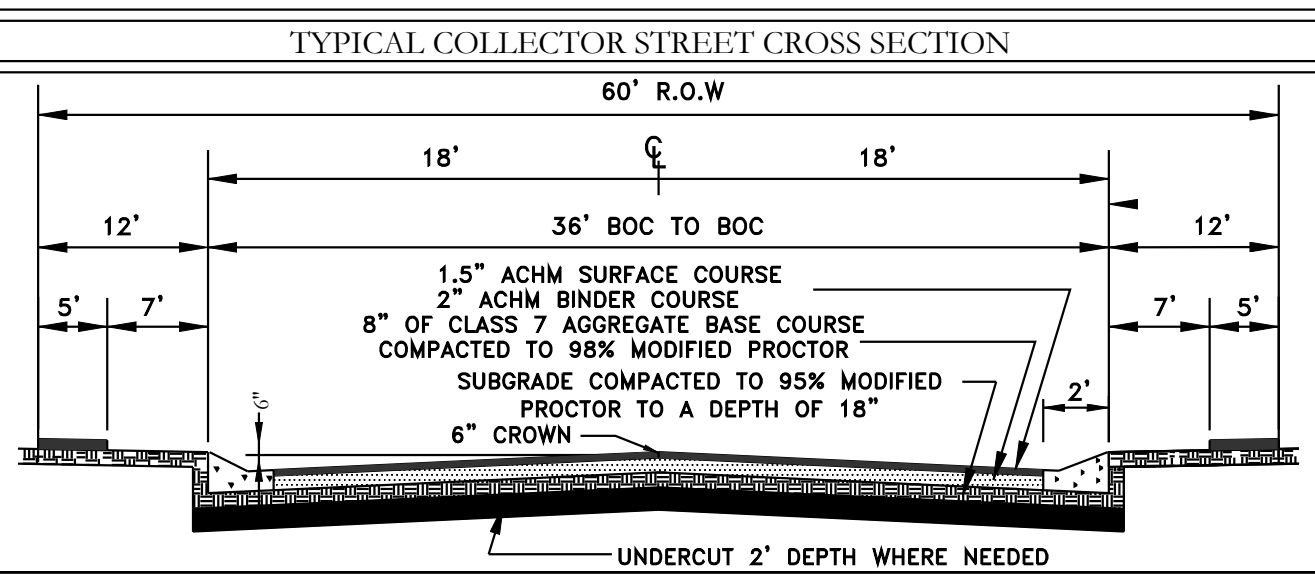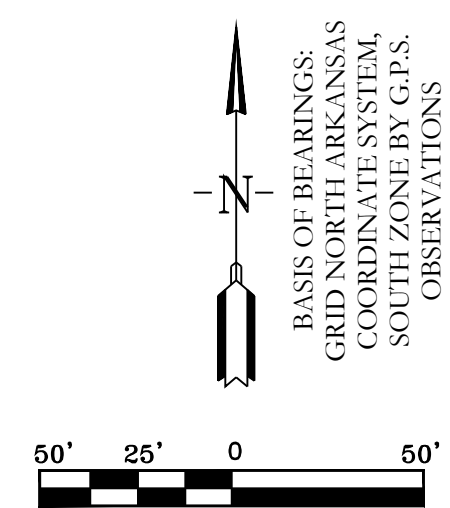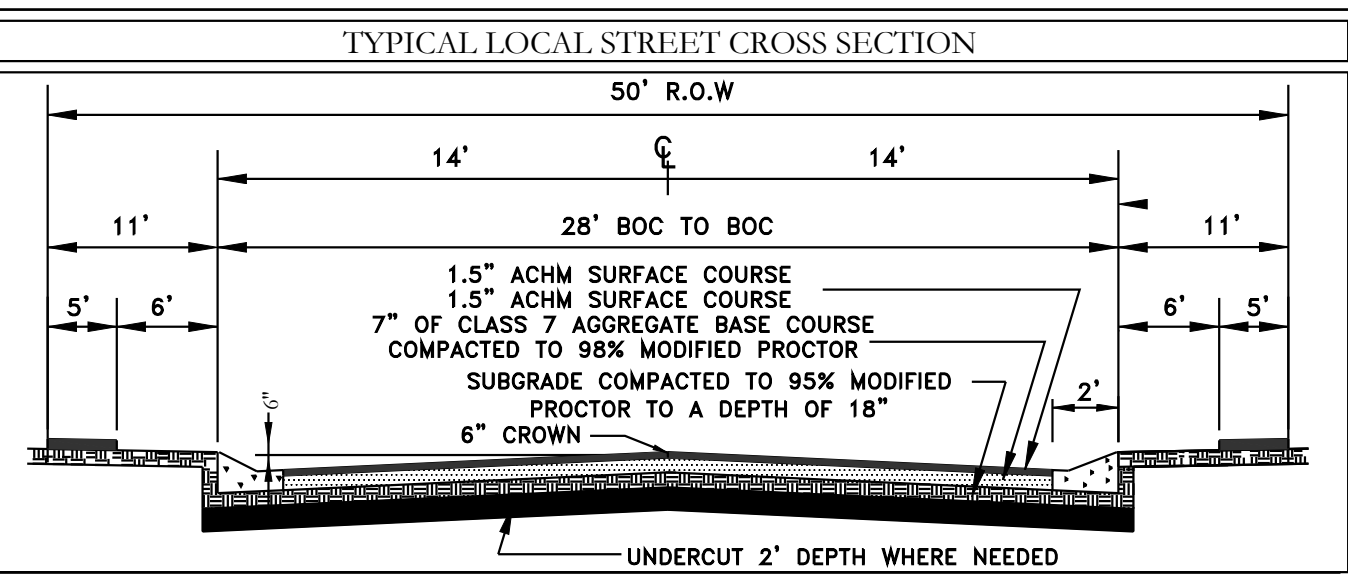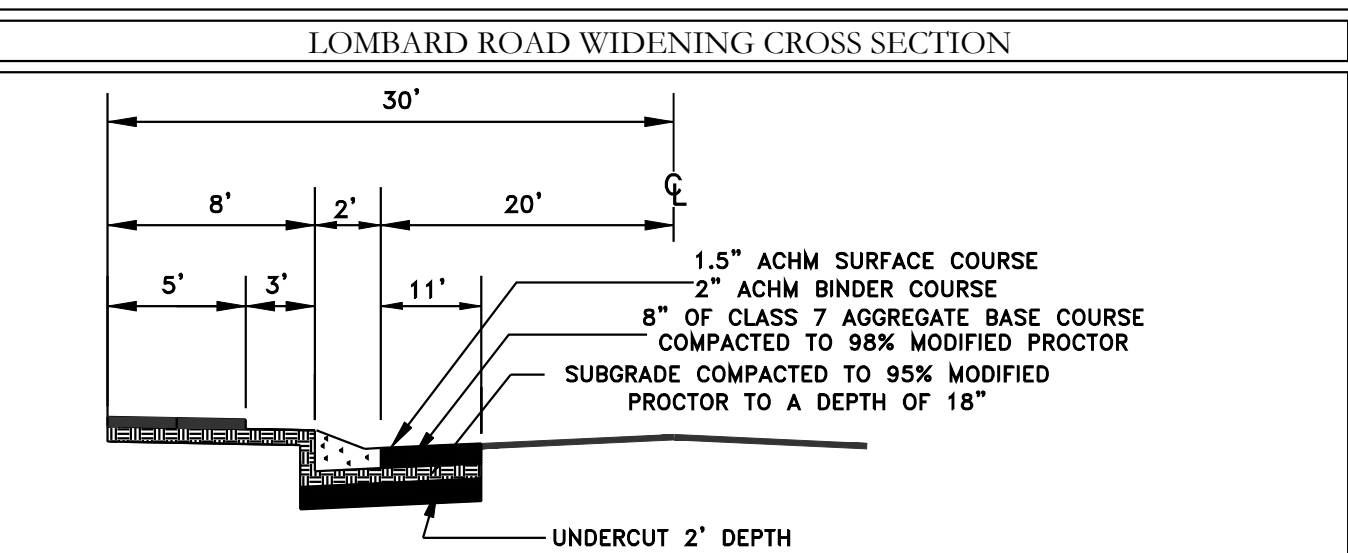

- LEGEND**
- (P) - No Parking Sign
  - - Stop Sign
  - - Street Light
  - - Fire Hydrant
  - ▲ - Computed Point
  - - Found monument
  - (S) - Set #4 RB/Plas. Cap (SIP)
  - (D) - Deeded
  - (M) - Measured
  - (P) - Platted

**PROPERTY SPECIFICATIONS:**

OWNER: SOUTHERN GENERAL CONTRACTORS P.O. BOX 242146 LITTLE ROCK, AR 72223	MIN. LOT SIZE: 6000 S.F. NUMBER OF LOTS: 24
DEVELOPER: SOUTHERN GENERAL CONTRACTORS P.O. BOX 242146 LITTLE ROCK, AR 72223	SOURCE OF WATER: SALINE WATER USERS
ENGINEERS: HOPE CONSULTING INC. 117 S MARKET STREET BENTON, AR 72015	SOURCE OF SEWER: CITY OF BRYANT SOURCE OF ELECTRIC: FIRST ELECTRIC COOP SOURCE OF GAS: CUSTEER POINT ENERGY
NAME OF SUBDIVISION: LOMBARD HEIGHTS SUBDIVISION	BUILDING SETBACKS: FRONT - 20' OR AS SHOWN REAR - 20' OR AS SHOWN SIDE - 10' OR AS SHOWN
ZONING CLASSIFICATION: R-1.5	EASEMENTS: UTILITY & DRAINAGE (D.E. & U.E.) FRONT - 10' OR AS SHOWN REAR - 10' OR AS SHOWN SIDE - 5' OR AS SHOWN
SOURCE OF TITLE: 2017-11245	STREET RIGHT OF WAYS: 50' OR AS SHOWN STREET WIDTH: 25' TO 100' LOT CORNERS: SET 1/2" REBAR WITH CAP

**HOPE CONSULTING ENGINEERS - SURVEYORS**




117 S. Market Street,  
Benton, Arkansas 72015  
PH. (501)315-2626  
FAX (501) 315-0024  
www.hopeconsulting.com

FOR USE AND BENEFIT OF:  
SOUTHERN GENERAL CONTRACTORS

**FINAL PLAT**  
**LOMBARD HEIGHTS, PHASE 1**  
 A SUBDIVISION IN THE CITY OF BRYANT, SALINE COUNTY, ARKANSAS

DATE: 08/10/2022	C.A.D. BY: RJOHNSON	DRAWING NUMBER:
REVISION:	CHECKED BY:	19-0238
500	SCALE: 1"=100'	500
01S	14W	0
14W	0	29
300	62	1762



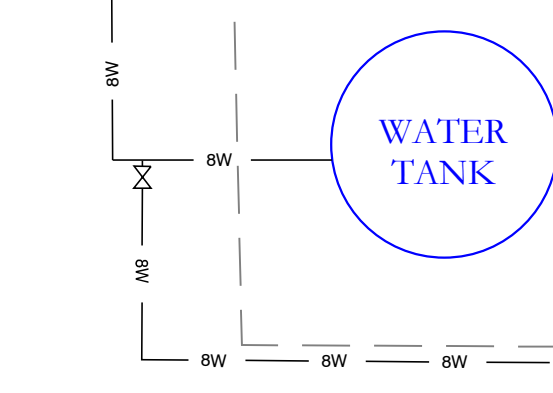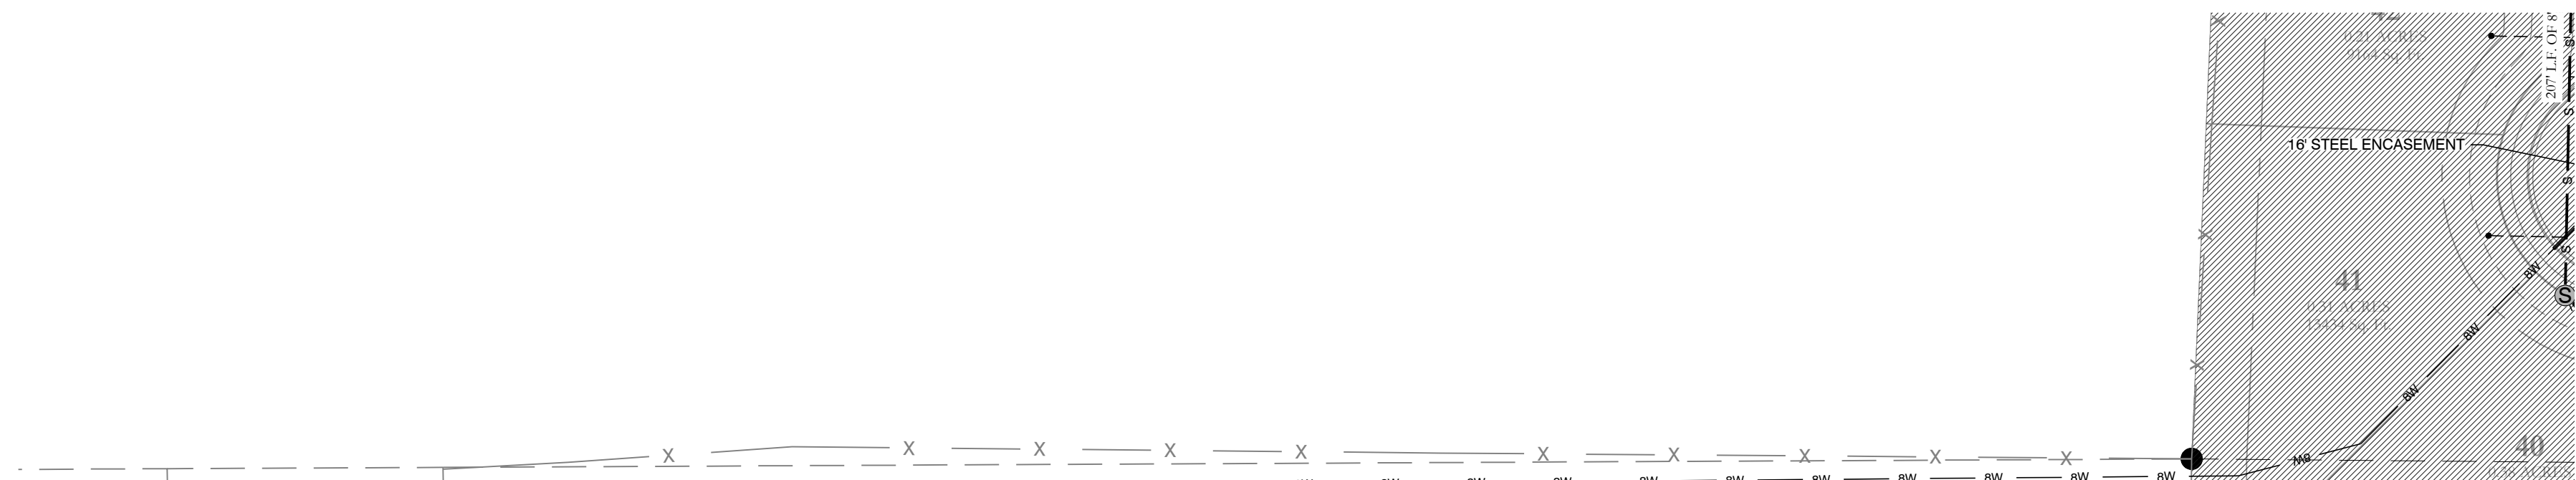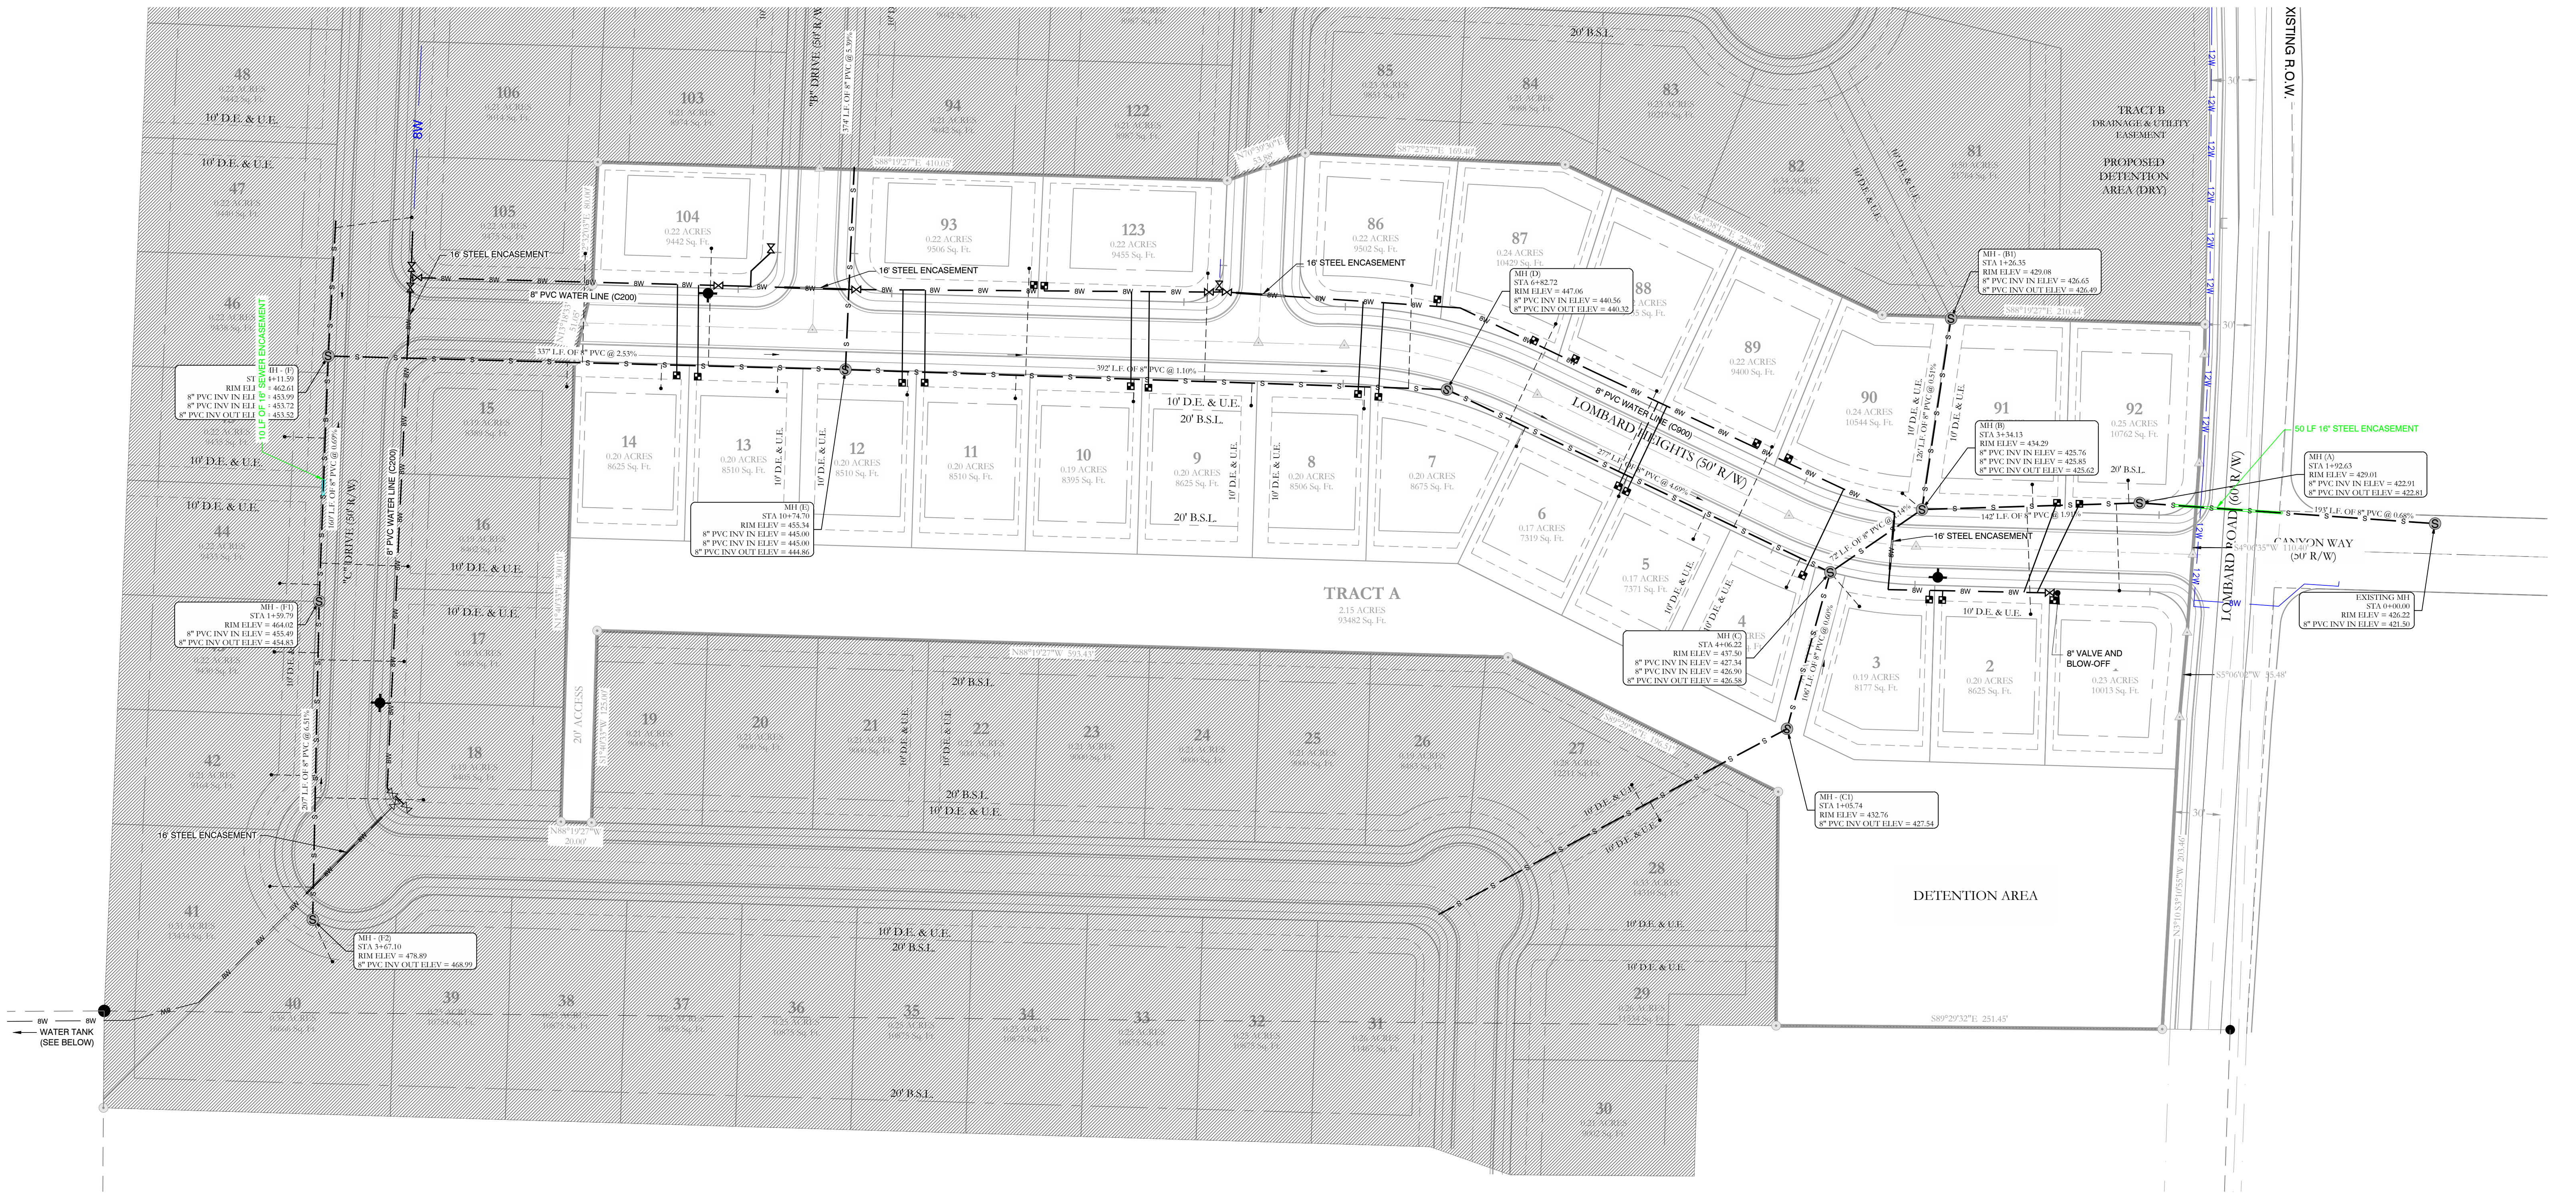

WATER LEGEND:	
2" BLOW OFF	GATE VALVE
WATER MAIN	REDUCER
FIRE HYDRANT	DOUBLE WATER SERVICE
SINGLE WATER SERVICE	

NOTE:  
ALL FIRE HYDRANT LEADERS HAVE A GATE VALVE BETWEEN MAIN AND FIRE HYDRANT.

TYPICAL FIRE HYDRANT:	
2" BLOW OFF	REDUCER
6"	GATE VALVE
FIRE HYDRANT	

FIRE HYDRANT  
(2 TO 6 FEET FROM EDGE OF PAVEMENT)

SEWER LEGEND:	
SEWER SERVICE	SEWER MANHOLE
SEWER MAIN	

NOTE:  
USE SDR-26 PVC SEWER PIPE EXCEPT WHERE DUCTILE IRON PIPE REQUIRED FOR COVER. USE DUCTILE IRON PIPE WHERE 3' MINIMUM COVER CANNOT BE MAINTAINED.  
CONTRACTOR IS RESPONSIBLE FOR LOCATING ALL BURIED UTILITIES PRIOR TO CONSTRUCTION.


117 S. Market Street,  
Benton, Arkansas 72015  
PH. (501)315-2626  
FAX (501) 315-0024  
www.hopeconsulting.com


FOR USE AND BENEFIT OF:  
**LOMBARD HEIGHTS**

**WATER & SEWER ASBUILTS**  
**LOMBARD HEIGHTS, PHASE 1**  
A SUBDIVISION IN THE CITY OF BRYANT, SALINE COUNTY, ARKANSAS

DATE: 08/10/2022	C.A.D. BY: B. JOHNSON	DRAWING NUMBER:
REVISED:	CHECKED BY: =	20-1388
SHEET:	SCALE: AS SHOWN	

500	01S	14W	16	201	62	128
-----	-----	-----	----	-----	----	-----

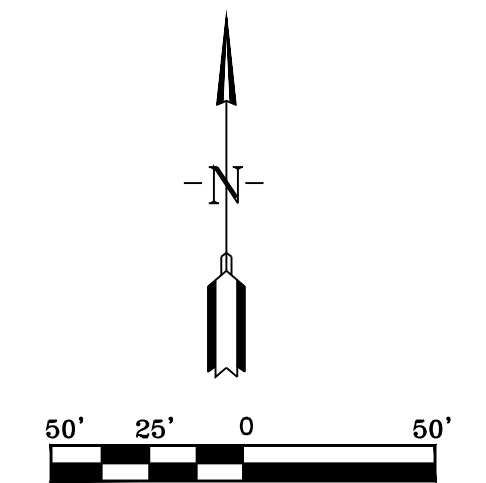

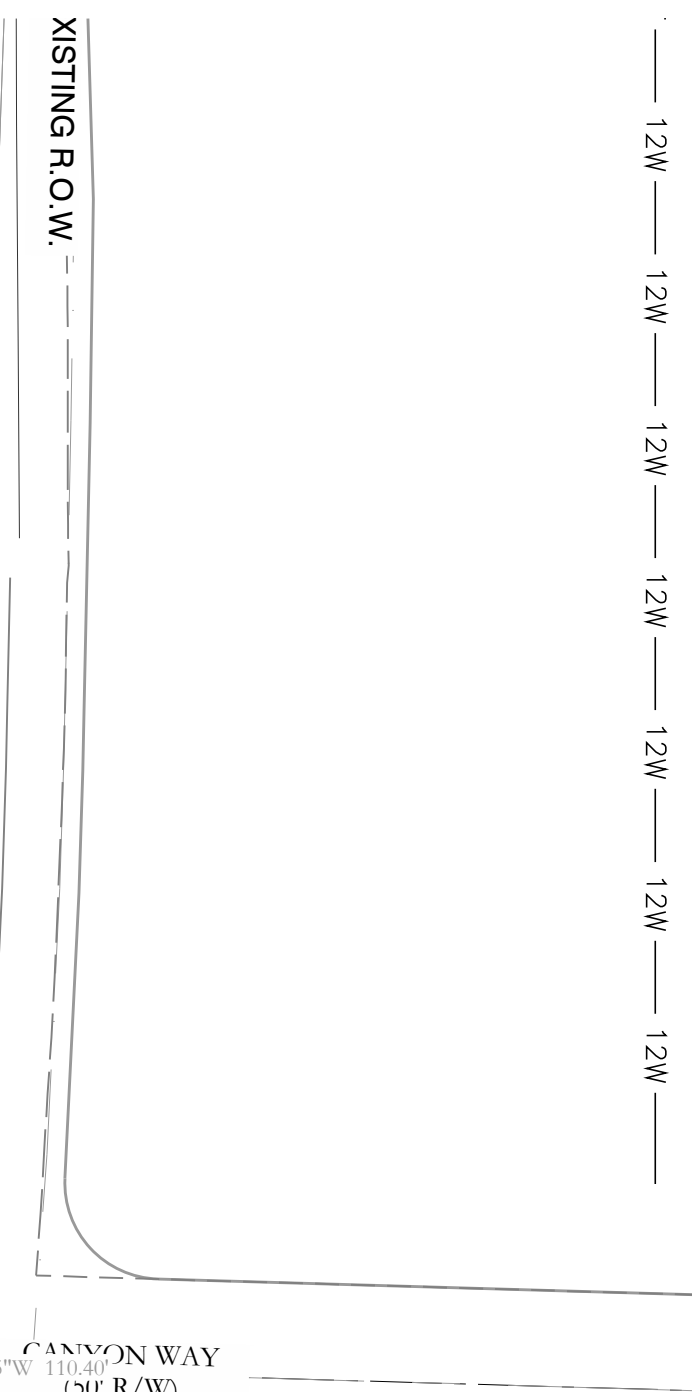

**HOPE CONSULTING**  
ENGINEERS - SURVEYORS

117 S. Market Street,  
Benton, Arkansas 72015  
PH. (501)315-2826  
FAX (501) 315-0024  
www.hopeconsulting.com

FOR USE AND BENEFIT OF:  
**LOMBARD HEIGHTS**

**DRAINAGE ASBUILTS**  
**LOMBARD HEIGHTS, PHASE 1**  
A SUBDIVISION IN THE CITY OF BRYANT, SALINE COUNTY, ARKANSAS

DATE: 08/10/2022	C.A.D. BY: B. JOHNSON	DRAWING NUMBER:
REVISION:	CHECKED BY: =	20-1388
SHEET:	SCALE: AS SHOWN	

500	01S	14W	16	201	62	128
-----	-----	-----	----	-----	----	-----

**CREEKSIDE ADDITION PHASE 2**  
**DRAINAGE CALCULATIONS – SUMMARY**  
**8/10/2022**

**DESCRIPTION OF PROJECT**

Creekside Addition phase 2 is an approximately 14.34 acres residential development located in the City of Bryant, Arkansas approximately a mile north of midland Road. There are four drainage basins on the site. All basins will be detained in a pipe network storage located back of the curb and between lots. The detention for the storage network will be underground in 36", 30", 24", and 18" RCP or HDPE pipe.

Stormwater Calculations were prepared with the intent to comply with the City of Bryant's Drainage Code. The primary intent of this analysis is to produce a drainage system adequately sized to convey post development runoff while attenuating post development discharge levels equal to or less than pre development flows.

Hydraulic calculations were made using the Rational Method. Design frequencies were analyzed for 2, 5, 10, 25, 50, and 100 year return periods.

These calculations are divided into the following sections:

**Summary of Drainage Basins**

**Summary of Inlets**

**Summary of Pipes**

**Pipe Network Storage Summary**

**Appendices**

Exhibit A – Pre-Development Drainage Basins

Exhibit B – Post-Development Drainage Basins

**CREEKSIDE ADDITION PHASE 2**  
**DRAINAGE CALCULATIONS – SUMMARY**  
**8/10/2022**

**SUMMARY OF DRAINAGE BASINS**

**PRE-DEVELOPMENT CONDITIONS**

The entire area for pre-existing drainage area of the site drains to low land to the northeast. There is a drainage basin west of the site that flows through the site then discharges onto the northeast. This discharge will not be captured.

**POST-DEVELOPMENT CONDITIONS**

As previously described, this site is being developed into a subdivision. Slopes range from 1% to 6%. Basin 1 and 2 drains to the northeast of the site and collected separately. Basin 3 and 4 drains to the southeast of the site and detained jointly. Runoff drains from the developed areas to underground detention in the back of the curb of the proposed road.

**SUMMARY OF INLETS**

On the drainage plan you will see labels for all of the inlets for these calculations. The flows shown are for the 25-year return storm. The distance from the face of the curb to the center of the street is 15 feet.

**SUMMARY OF PIPES**

All pipes used in this project are HDPE and RCP. Therefore, a manning's of 0.012 was used on all pipes in the analysis.

**PIPE NETWORK STORAGE SUMMARY**

The pipe network storage in these calculations detains flows from all of the developed areas of the site. Three pipe network storages are provided. The pipe network storage 1 is located in the north portion of the development. It is made of 518 linear feet of 30" and 36" pipes and has a volume of 3,575 cf.

The pipe network storage 2 is located between lots. It is made of 143 linear feet of 30" HDPE pipe and has a volume of 735 cf.

The pipe network storage 3 is located in the south portion of the development. It is made of 828 linear feet of 30" and 36" pipes and has a volume of 3,185 cf. Water collected in the storm water system is discharged into the pipe network via curb inlets.

Concrete control structures are constructed at the end of the pipe network storage. This control structure uses a slotted weir to limit the discharge through the structure to that of the 2, 10, 25, and 100-year pre-development flow. The pipe network storage is designed to hold the 100-year storm event.



DATE	REVISION	BY

**GNE** Designing our client's success  
**GarNat Engineering, LLC**  
 P.O. Box 116 (72018)  
 2909 Military Rd  
 Benton, AR 72015  
 Ph (501) 408-4650  
 Fax (888) 900-3068  
 gnatengineering@gmail.com

CREEKSIDE ADDITION PHASE 2  
 ALL OF LOT 101 AND PART OF LOT 99  
 AND PART OF LOT 100, MIDLAND FARM SUBDIVISION  
 PART OF THE NE 1/4 NW 1/4, PART OF THE W 1/2 SE  
 1/4 NW 1/4 AND THE NW 1/4 NE 1/4 SW 1/4 ALL IN  
 SECTION 12, T-1-S, R-14-W,  
 SALINE COUNTY, ARKANSAS

**DRAFT**

CONTENTS:  
**PRE DEVELOPMENT BASIN**

PROJECT NO:  
**18054**

DATE:  
**JULY 2022**

SHEET NO:  
**1**

J:\Projects\2018 Projects\18054 - Creekside Addition\Phase 2\9-14-22\Drawings\Bain.dwg



BY	REVISION	DATE

**GNE** Designing our client's success  
**GarNat Engineering, LLC**  
 P.O. Box 116 (72018)  
 2909 Military Rd  
 Benton, AR 72015  
 Ph (501) 408-4650  
 Fx (888) 900-3068  
 gnatengineering@gmail.com

CREEKSIDE ADDITION PHASE 2  
 ALL OF LOT 101 AND PART OF LOT 99  
 AND PART OF LOT 100, MIDLAND FARM SUBDIVISION  
 PART OF THE NE 1/4 NW 1/4, PART OF THE W 1/2 SE  
 1/4 NW 1/4 AND THE NW 1/4 NE 1/4 SW 1/4 ALL IN  
 SECTION 12, T-1-S, R-14-W,  
 SALINE COUNTY, ARKANSAS

**DRAFT**

CONTENTS:  
**POST DEVELOPMENT BASIN**

PROJECT NO:  
**18054**

DATE:  
**JULY 2022**

SHEET NO:  
**2**

J:\Projects\2018 Projects\18054 Creekside Addition\Phase 2\AR-01722-Drainage Basin.dwg

**Stormwater Calcs - Creekside Addition Phase 2  
Using Rational Method**

Pre-development

**Calculated Tc values - Drainage Basin 1**

$$T_c = \frac{56 * L^{0.6} * n^{0.6}}{i^{0.4} * S^{0.3}} \text{ seconds}$$

L1 = 100 feet  
 n1 = 0.15 Sheet Flow  
 S1 = 0.09 ft/ft  
 I<sub>assumed</sub> = 6.10 inches  
 T<sub>c</sub>calculated = 284 seconds  
 T<sub>c</sub>calculated = 4.73 minutes

Tc = 14.12 minutes  
 I = 6.10 inches

Use Tc = 17.00 minutes

L1 = 500 feet  
 n1 = 0.07 Medium Brush and Trees  
 S1 = 0.05 ft/ft  
 I<sub>assumed</sub> = 6.10 inches  
 T<sub>c</sub>calculated = 563 seconds  
 T<sub>c</sub>calculated = 9.39 minutes

Tc for 25-yr Storm from Exhibit 400-1 of Bryant Drainage Manual  
 i for 25-yr Storm from Exhibit 400-1 of Bryant Drainage Manual

I<sub>100</sub> = 7.4 Inches  
 I<sub>50</sub> = 6.8 Inches  
 I<sub>25</sub> = 6.10 Inches  
 I<sub>10</sub> = 5.3 Inches  
 I<sub>5</sub> = 4.8 Inches  
 I<sub>2</sub> = 4.1 Inches

**Calculated Tc values - Drainage Basin 2**

$$T_c = \frac{56 * L^{0.6} * n^{0.6}}{i^{0.4} * S^{0.3}} \text{ seconds}$$

L1 = 100 feet  
 n1 = 0.15 Sheet Flow  
 S1 = 0.07 ft/ft  
 I<sub>assumed</sub> = 5.30 inches  
 T<sub>c</sub>calculated = 324 seconds  
 T<sub>c</sub>calculated = 5.40 minutes

Tc = 20.18 minutes  
 I = 5.30 inches

Use Tc = 20.00 minutes

L1 = 970 feet  
 n1 = 0.07 Medium Brush and Trees  
 S1 = 0.05 ft/ft  
 I<sub>assumed</sub> = 5.30 inches  
 T<sub>c</sub>calculated = 887 seconds  
 T<sub>c</sub>calculated = 14.78 minutes

Tc for 25-yr Storm from Exhibit 400-1 of Bryant Drainage Manual  
 i for 25-yr Storm from Exhibit 400-1 of Bryant Drainage Manual

I<sub>100</sub> = 6.5 Inches  
 I<sub>50</sub> = 5.9 Inches  
 I<sub>25</sub> = 5.30 Inches  
 I<sub>10</sub> = 4.8 Inches  
 I<sub>5</sub> = 4.3 Inches  
 I<sub>2</sub> = 3.6 Inches

**Calculated Tc values - Drainage Basin 3**

$$T_c = \frac{56 * L^{0.6} * n^{0.6}}{i^{0.4} * S^{0.3}} \text{ seconds}$$

L1 = 100 feet  
 n1 = 0.15 Sheet Flow  
 S1 = 0.05 ft/ft  
 I<sub>assumed</sub> = 5.20 inches  
 T<sub>c</sub>calculated = 361 seconds  
 T<sub>c</sub>calculated = 6.02 minutes

Tc = 21.70 minutes  
 I = 5.20 inches

Use Tc = 21.50 minutes

L1 = 400 feet  
 n1 = 0.03 Clean, Straight  
 S1 = 0.04 ft/ft  
 I<sub>assumed</sub> = 5.20 inches  
 T<sub>c</sub>calculated = 338 seconds  
 T<sub>c</sub>calculated = 5.63 minutes

L1 = 450 feet  
 n1 = 0.07 Medium Brush and Trees  
 S1 = 0.04 ft/ft  
 I<sub>assumed</sub> = 5.20 inches  
 T<sub>c</sub>calculated = 603 seconds  
 T<sub>c</sub>calculated = 10.05 minutes

Tc for 25-yr Storm from Exhibit 400-1 of Bryant Drainage Manual  
 i for 25-yr Storm from Exhibit 400-1 of Bryant Drainage Manual

I<sub>100</sub> = 6.4 Inches  
 I<sub>50</sub> = 5.8 Inches  
 I<sub>25</sub> = 5.20 Inches  
 I<sub>10</sub> = 4.8 Inches  
 I<sub>5</sub> = 4.2 Inches  
 I<sub>2</sub> = 3.6 Inches

**Calculated Tc values - Drainage Basin 4**

$$T_c = \frac{56 * L^{0.6} * n^{0.6}}{i^{0.4} * S^{0.3}} \text{ seconds}$$

L1 = 100 feet  
 n1 = 0.15 Sheet Flow  
 S1 = 0.04 ft/ft  
 I<sub>assumed</sub> = 5.30 inches  
 T<sub>c</sub>calculated = 383 seconds  
 T<sub>c</sub>calculated = 6.39 minutes

Tc = 20.52 minutes  
 I = 5.30 inches

Use Tc = 20.50 minutes

L1 = 140 feet  
 n1 = 0.03 Clean, Straight  
 S1 = 0.04 ft/ft  
 I<sub>assumed</sub> = 5.30 inches  
 T<sub>c</sub>calculated = 179 seconds  
 T<sub>c</sub>calculated = 2.98 minutes

L1 = 470 feet  
 n1 = 0.07 Medium Brush and Trees  
 S1 = 0.03 ft/ft  
 I<sub>assumed</sub> = 5.30 inches  
 T<sub>c</sub>calculated = 669 seconds  
 T<sub>c</sub>calculated = 11.16 minutes

Tc for 25-yr Storm from Exhibit 400-1 of Bryant Drainage Manual  
 i for 25-yr Storm from Exhibit 400-1 of Bryant Drainage Manual

I<sub>100</sub> = 6.5 Inches  
 I<sub>50</sub> = 5.9 Inches  
 I<sub>25</sub> = 5.30 Inches  
 I<sub>10</sub> = 4.9 Inches  
 I<sub>5</sub> = 4.3 Inches  
 I<sub>2</sub> = 3.7 Inches

Stormwater Calcs - Creekside Addition Phase 2  
Using Rational Method

Post-development

Calculated Tc values - Drainage Basin 1

$T_c = \frac{56 * L^{0.6} * n^{0.6}}{i^{0.4} * S^{0.3}}$ seconds		$T_c = \frac{6 * L^{0.6} * n^{0.6}}{i^{0.4} * S^{0.3}}$					
L1 =	100 feet	L1 =	275 feet	L1 =	190 feet	L1 =	310 feet
n1 =	0.15 Sheet Flow	n1 =	0.07 Medium Brush and Trees	n1 =	0.03 Clean, Straight	n1 =	0.013 Asphalt
S1 =	0.09 ft/ft	S1 =	0.09 ft/ft	S1 =	0.04 ft/ft	S1 =	0.03 ft/ft
I <sub>assumed</sub> =	5.70 inches	I <sub>assumed</sub> =	5.70 inches	I <sub>assumed</sub> =	5.70 inches	I <sub>assumed</sub> =	5.70 inches
T <sub>Ccalculated</sub>	292 seconds	T <sub>Ccalculated</sub>	339 seconds	T <sub>Ccalculated</sub>	208 seconds	T <sub>Ccalculated</sub>	184 seconds
T <sub>Ccalculated</sub>	4.86 minutes	T <sub>Ccalculated</sub>	5.65 minutes	T <sub>Ccalculated</sub>	3.47 minutes	T <sub>Ccalculated</sub>	3.07 minutes
Tc =	17.06 minutes	Tc for 25-yr Storm from Exhibit 400-1 of Bryant Drainage Manual					
I =	5.70 inches	i for 25-yr Storm from Exhibit 400-1 of Bryant Drainage Manual					
Use Tc =	17.00 minutes	I <sub>100</sub> =	7 Inches	I <sub>10</sub> =	5.1 Inches		
		I <sub>50</sub> =	6.3 Inches	I <sub>5</sub> =	4.6 Inches		
		I <sub>25</sub> =	5.7 Inches	I <sub>2</sub> =	3.9 Inches		

Calculated Tc values - Drainage Basin 2

$T_c = \frac{56 * L^{0.6} * n^{0.6}}{i^{0.4} * S^{0.3}}$ seconds		$T_c = \frac{6 * L^{0.6} * n^{0.6}}{i^{0.4} * S^{0.3}}$		seconds			
L1 =	100 feet	L1 =	415 feet	L1 =	150 feet	L1 =	435 feet
n1 =	0.15 Sheet Flow	n1 =	0.07 Medium Brush and Trees	n1 =	0.03 Clean, Straight	n1 =	0.013 Asphalt
S1 =	0.07 ft/ft	S1 =	0.06 ft/ft	S1 =	0.04 ft/ft	S1 =	0.005 ft/ft
I <sub>assumed</sub> =	5.00 inches	I <sub>assumed</sub> =	5.00 inches	I <sub>assumed</sub> =	5.00 inches	I <sub>assumed</sub> =	5.00 inches
T <sub>Ccalculated</sub>	332 seconds	T <sub>Ccalculated</sub>	516 seconds	T <sub>Ccalculated</sub>	191 seconds	T <sub>Ccalculated</sub>	408 seconds
T <sub>Ccalculated</sub>	5.53 minutes	T <sub>Ccalculated</sub>	8.61 minutes	T <sub>Ccalculated</sub>	3.18 minutes	T <sub>Ccalculated</sub>	6.80 minutes
Tc =	24.11 minutes	Tc for 25-yr Storm from Exhibit 400-1 of Bryant Drainage Manual					
I =	5.00 inches	i for 25-yr Storm from Exhibit 400-1 of Bryant Drainage Manual					
Use Tc =	24.00 minutes	I <sub>100</sub> =	6 Inches	I <sub>10</sub> =	4.5 Inches		
		I <sub>50</sub> =	5.5 Inches	I <sub>5</sub> =	4.0 Inches		
		I <sub>25</sub> =	5.0 Inches	I <sub>2</sub> =	3.4 Inches		

Calculated Tc values - Drainage Basin 3

$T_c = \frac{56 * L^{0.6} * n^{0.6}}{i^{0.4} * S^{0.3}}$ seconds		$T_c = \frac{6 * L^{0.6} * n^{0.6}}{i^{0.4} * S^{0.3}}$		seconds			
L1 =	100 feet	L1 =	400 feet	L1 =	770 feet		
n1 =	0.15 Sheet Flow	n1 =	0.03 Clean, Straight	n1 =	0.013 Asphalt/Culvert		
S1 =	0.04 ft/ft	S1 =	0.04 ft/ft	S1 =	0.005 ft/ft		
I <sub>assumed</sub> =	5.20 inches	I <sub>assumed</sub> =	5.20 inches	I <sub>assumed</sub> =	5.20 inches		
T <sub>Ccalculated</sub>	386 seconds	T <sub>Ccalculated</sub>	338 seconds	T <sub>Ccalculated</sub>	565 seconds		
T <sub>Ccalculated</sub>	6.44 minutes	T <sub>Ccalculated</sub>	5.63 minutes	T <sub>Ccalculated</sub>	9.42 minutes		
Tc =	21.49 minutes	Tc for 25-yr Storm from Exhibit 400-1 of Bryant Drainage Manual					
I =	5.20 inches	i for 25-yr Storm from Exhibit 400-1 of Bryant Drainage Manual					
Use Tc =	21.50 minutes	I <sub>100</sub> =	6.4 Inches	I <sub>10</sub> =	4.7 Inches		
		I <sub>50</sub> =	5.8 Inches	I <sub>5</sub> =	4.2 Inches		
		I <sub>25</sub> =	5.2 Inches	I <sub>2</sub> =	3.6 Inches		

Calculated Tc values - Drainage Basin 4

$T_c = \frac{56 * L^{0.6} * n^{0.6}}{i^{0.4} * S^{0.3}}$ seconds		$T_c = \frac{6 * L^{0.6} * n^{0.6}}{i^{0.4} * S^{0.3}}$		seconds			
L1 =	100 feet	L1 =	365 feet	L1 =	260 feet	L1 =	70 feet
n1 =	0.15 Smooth Concrete/Asphalt	n1 =	0.03 Clean, Straight	n1 =	0.07 Medium Brush and	n1 =	0.013 Asphalt/Culvert
S1 =	0.04 ft/ft	S1 =	0.04 ft/ft	S1 =	0.03 ft/ft	S1 =	0.005 ft/ft
I <sub>assumed</sub> =	5.10 inches	I <sub>assumed</sub> =	5.10 inches	I <sub>assumed</sub> =	5.10 inches	I <sub>assumed</sub> =	5.10 inches
T <sub>Ccalculated</sub>	389 seconds	T <sub>Ccalculated</sub>	322 seconds	T <sub>Ccalculated</sub>	477 seconds	T <sub>Ccalculated</sub>	135 seconds
T <sub>Ccalculated</sub>	6.49 minutes	T <sub>Ccalculated</sub>	5.37 minutes	T <sub>Ccalculated</sub>	7.94 minutes	T <sub>Ccalculated</sub>	2.25 minutes
Tc =	22.05 minutes	Tc for 25-yr Storm from Exhibit 400-1 of Bryant Drainage Manual					
I =	5.10 inches	i for 25-yr Storm from Exhibit 400-1 of Bryant Drainage Manual					
Use Tc =	22.00 minutes	I <sub>100</sub> =	6.2 Inches	I <sub>10</sub> =	4.6 Inches		
		I <sub>50</sub> =	5.7 Inches	I <sub>5</sub> =	4.1 Inches		
		I <sub>25</sub> =	5.1 Inches	I <sub>2</sub> =	3.5 Inches		



**Stormwater Calcs - Creekside Addition Phase 2  
using Rational Method**

**Pre-development**

**Calculated C values - Drainage Basin 1**

	Area	C <sub>100</sub>	C <sub>50</sub>	C <sub>25</sub>	C <sub>10</sub>	C <sub>5</sub>	C <sub>2</sub>
Pasture/Range							
Forest/Woodlands	7.13	0.52	0.48	0.45	0.41	0.39	0.35
<b>Total Area =</b>	<b>7.13</b>	<b>0.52</b>	<b>0.48</b>	<b>0.45</b>	<b>0.41</b>	<b>0.39</b>	<b>0.35</b>

(C values taken from Table 400-2 of City of Bryant Drainage Manual)

Steep, Over 7%

**Calculated C values - Drainage Basin 2**

	Area	C <sub>100</sub>	C <sub>50</sub>	C <sub>25</sub>	C <sub>10</sub>	C <sub>5</sub>	C <sub>2</sub>
Pasture/Range	2.28	0.53	0.49	0.46	0.42	0.4	0.37
Forest/Woodlands	3.79	0.47	0.43	0.4	0.36	0.34	0.31
<b>Total Area =</b>	<b>6.07</b>	<b>0.49</b>	<b>0.45</b>	<b>0.42</b>	<b>0.38</b>	<b>0.36</b>	<b>0.33</b>

(C values taken from Table 400-2 of City of Bryant Drainage Manual)

Steep, Over 7%

Average, 2-7%

**Calculated C values - Drainage Basin 3**

	Area	C <sub>100</sub>	C <sub>50</sub>	C <sub>25</sub>	C <sub>10</sub>	C <sub>5</sub>	C <sub>2</sub>
Pasture/Range	4.56	0.53	0.49	0.46	0.42	0.4	0.37
Forest/Woodlands	4.86	0.47	0.43	0.4	0.36	0.34	0.31
<b>Total Area =</b>	<b>9.42</b>	<b>0.50</b>	<b>0.46</b>	<b>0.43</b>	<b>0.39</b>	<b>0.37</b>	<b>0.34</b>

(C values taken from Table 400-2 of City of Bryant Drainage Manual)

Steep, Over 7%

Average, 2-7%

**Calculated C values - Drainage Basin 4**

	Area	C <sub>100</sub>	C <sub>50</sub>	C <sub>25</sub>	C <sub>10</sub>	C <sub>5</sub>	C <sub>2</sub>
Pasture/Range	0.93	0.49	0.45	0.42	0.38	0.36	0.33
Forest/Woodlands	2.48	0.47	0.43	0.4	0.36	0.34	0.31
<b>Total Area =</b>	<b>3.41</b>	<b>0.48</b>	<b>0.44</b>	<b>0.41</b>	<b>0.37</b>	<b>0.35</b>	<b>0.32</b>

(C values taken from Table 400-2 of City of Bryant Drainage Manual)

Average, 2-7%

Average, 2-7%

**Stormwater Calcs - Creekside Addition Phase 2  
using Rational Method**

**Post-development**

**Calculated C values - Drainage Basin 1**

	Area	C <sub>100</sub>	C <sub>50</sub>	C <sub>25</sub>	C <sub>10</sub>	C <sub>5</sub>	C <sub>2</sub>
Single Family House	5.83	0.7	0.65	0.6	0.5	0.4	0.35
Off-Site	1.30	0.52	0.48	0.45	0.41	0.39	0.35
<b>Total Area =</b>	<b>7.13</b>	<b>0.67</b>	<b>0.62</b>	<b>0.57</b>	<b>0.48</b>	<b>0.40</b>	<b>0.35</b>

(C values taken from Table 400-2 of City of Bryant Drainage Manual)

Residential Table 2.1 City of Little Rock Manual  
Steep, Over 7%

**Calculated C values - Drainage Basin 2**

	Area	C <sub>100</sub>	C <sub>50</sub>	C <sub>25</sub>	C <sub>10</sub>	C <sub>5</sub>	C <sub>2</sub>
Single Family House	4.05	0.7	0.65	0.6	0.5	0.4	0.35
Off-Site	2.02	0.49	0.45	0.42	0.38	0.36	0.33
<b>Total Area =</b>	<b>6.07</b>	<b>0.63</b>	<b>0.58</b>	<b>0.54</b>	<b>0.46</b>	<b>0.39</b>	<b>0.34</b>

(C values taken from Table 400-2 of City of Bryant Drainage Manual)

Residential Table 2.1 City of Little Rock Manual

**Calculated C values - Drainage Basin 3**

	Area	C <sub>100</sub>	C <sub>50</sub>	C <sub>25</sub>	C <sub>10</sub>	C <sub>5</sub>	C <sub>2</sub>
Single Family House	3.98	0.70	0.65	0.60	0.50	0.40	0.35
Off-Site	5.44	0.49	0.45	0.42	0.38	0.36	0.33
<b>Total Area =</b>	<b>9.42</b>	<b>0.58</b>	<b>0.53</b>	<b>0.50</b>	<b>0.43</b>	<b>0.38</b>	<b>0.34</b>

(C values taken from Table 400-2 of City of Bryant Drainage Manual)

Residential Table 2.1 City of Little Rock Manual

**Calculated C values - Drainage Basin 4**

	Area	C <sub>100</sub>	C <sub>50</sub>	C <sub>25</sub>	C <sub>10</sub>	C <sub>5</sub>	C <sub>2</sub>
Single Family House	1.61	0.70	0.65	0.60	0.50	0.40	0.35
Off-Site	1.80	0.49	0.45	0.42	0.38	0.36	0.33
<b>Total Area =</b>	<b>3.41</b>	<b>0.59</b>	<b>0.54</b>	<b>0.50</b>	<b>0.44</b>	<b>0.38</b>	<b>0.34</b>

(C values taken from Table 400-2 of City of Bryant Drainage Manual)

Residential Table 2.1 City of Little Rock Manual

Stormwater Calcs - Creekside Addition Phase 2  
using Rational Method

Pre-development

Drainage Basin 1

Q <sub>100</sub> = 27.44 CFS	Q <sub>60</sub> = 23.27 CFS	Q <sub>25</sub> = 19.57 CFS	Q <sub>10</sub> = 15.49 CFS	Q <sub>5</sub> = 13.35 CFS	Q <sub>2</sub> = 10.23 CFS
c = 0.52	c = 0.48	c = 0.45	c = 0.41	c = 0.39	c = 0.35
i = 7.40 in/hr	i = 6.80 in/hr	i = 6.10 in/hr	i = 5.30 in/hr	i = 4.80 in/hr	i = 4.10 in/hr
A = 7.13 acres	A = 7.13 acres	A = 7.13 acres	A = 7.13 acres	A = 7.13 acres	A = 7.13 acres

Drainage Basin 2

Q <sub>100</sub> = 19.43 CFS	Q <sub>60</sub> = 16.21 CFS	Q <sub>25</sub> = 13.59 CFS	Q <sub>10</sub> = 11.15 CFS	Q <sub>5</sub> = 9.46 CFS	Q <sub>2</sub> = 7.27 CFS
c = 0.49	c = 0.45	c = 0.42	c = 0.38	c = 0.36	c = 0.33
i = 6.50 in/hr	i = 5.90 in/hr	i = 5.30 in/hr	i = 4.80 in/hr	i = 4.30 in/hr	i = 3.60 in/hr
A = 6.07 acres	A = 6.07 acres	A = 6.07 acres	A = 6.07 acres	A = 6.07 acres	A = 6.07 acres

Drainage Basin 3

Q <sub>100</sub> = 30.09 CFS	Q <sub>60</sub> = 25.08 CFS	Q <sub>25</sub> = 21.02 CFS	Q <sub>10</sub> = 17.59 CFS	Q <sub>5</sub> = 14.60 CFS	Q <sub>2</sub> = 11.50 CFS
c = 0.50	c = 0.46	c = 0.43	c = 0.39	c = 0.37	c = 0.34
i = 6.40 in/hr	i = 5.80 in/hr	i = 5.20 in/hr	i = 4.80 in/hr	i = 4.20 in/hr	i = 3.60 in/hr
A = 9.42 acres	A = 9.42 acres	A = 9.42 acres	A = 9.42 acres	A = 9.42 acres	A = 9.42 acres

Drainage Basin 4

Q <sub>100</sub> = 10.54 CFS	Q <sub>60</sub> = 8.76 CFS	Q <sub>25</sub> = 7.33 CFS	Q <sub>10</sub> = 6.11 CFS	Q <sub>5</sub> = 5.07 CFS	Q <sub>2</sub> = 3.98 CFS
c = 0.48	c = 0.44	c = 0.41	c = 0.37	c = 0.35	c = 0.32
i = 6.50 in/hr	i = 5.90 in/hr	i = 5.30 in/hr	i = 4.90 in/hr	i = 4.30 in/hr	i = 3.70 in/hr
A = 3.41 acres	A = 3.41 acres	A = 3.41 acres	A = 3.41 acres	A = 3.41 acres	A = 3.41 acres

Post-development

Drainage Basin 1

Q <sub>100</sub> = 33.30 CFS	Q <sub>60</sub> = 27.81 CFS	Q <sub>25</sub> = 23.27 CFS	Q <sub>10</sub> = 17.58 CFS	Q <sub>5</sub> = 13.06 CFS	Q <sub>2</sub> = 9.73 CFS
c = 0.67	c = 0.62	c = 0.57	c = 0.48	c = 0.40	c = 0.35
i = 7.00 in/hr	i = 6.30 in/hr	i = 5.70 in/hr	i = 5.10 in/hr	i = 4.60 in/hr	i = 3.90 in/hr
A = 7.13 acres	A = 7.13 acres	A = 7.13 acres	A = 7.13 acres	A = 7.13 acres	A = 7.13 acres

Drainage Basin 2

Q <sub>100</sub> = 22.95 CFS	Q <sub>60</sub> = 19.48 CFS	Q <sub>25</sub> = 16.39 CFS	Q <sub>10</sub> = 12.57 CFS	Q <sub>5</sub> = 9.39 CFS	Q <sub>2</sub> = 7.09 CFS
c = 0.63	c = 0.58	c = 0.54	c = 0.46	c = 0.39	c = 0.34
i = 6.00 in/hr	i = 5.50 in/hr	i = 5.00 in/hr	i = 4.50 in/hr	i = 4.00 in/hr	i = 3.40 in/hr
A = 6.07 acres	A = 6.07 acres	A = 6.07 acres	A = 6.07 acres	A = 6.07 acres	A = 6.07 acres

Drainage Basin 3

Q <sub>100</sub> = 34.89 CFS	Q <sub>60</sub> = 29.20 CFS	Q <sub>25</sub> = 24.30 CFS	Q <sub>10</sub> = 19.07 CFS	Q <sub>5</sub> = 14.91 CFS	Q <sub>2</sub> = 11.48 CFS
c = 0.58	c = 0.53	c = 0.50	c = 0.43	c = 0.38	c = 0.34
i = 6.40 in/hr	i = 5.80 in/hr	i = 5.20 in/hr	i = 4.70 in/hr	i = 4.20 in/hr	i = 3.60 in/hr
A = 9.42 acres	A = 9.42 acres	A = 9.42 acres	A = 9.42 acres	A = 9.42 acres	A = 9.42 acres

Drainage Basin 4

Q <sub>100</sub> = 12.46 CFS	Q <sub>60</sub> = 10.58 CFS	Q <sub>25</sub> = 8.78 CFS	Q <sub>10</sub> = 6.85 CFS	Q <sub>5</sub> = 5.30 CFS	Q <sub>2</sub> = 4.05 CFS
c = 0.59	c = 0.54	c = 0.50	c = 0.44	c = 0.38	c = 0.34
i = 6.20 in/hr	i = 5.70 in/hr	i = 5.10 in/hr	i = 4.60 in/hr	i = 4.10 in/hr	i = 3.50 in/hr
A = 3.41 acres	A = 3.41 acres	A = 3.41 acres	A = 3.41 acres	A = 3.41 acres	A = 3.41 acres

Detention Volume

Pond-1 for Q100	
Cundev=	0.52
lundev=	7.40 in/hr
Cdev=	0.67
ldev=	7.00 in/hr
R=	0.82
A=	4.26 acres
Tc=	17.00 minutes
	60 sec/min
Detention Volume=	3,573 cubic feet

Pond-2 for Q100	
Cundev=	0.49
lundev=	6.50 in/hr
Cdev=	0.63
ldev=	6.00 in/hr
R=	0.58
A=	0.88 acres
Tc=	24.00 minutes
	60 sec/min
Detention Volume=	734 cubic feet

Pond-3 for Q100	
Cundev=	0.50
lundev=	6.40 in/hr
Cdev=	0.58
ldev=	6.40 in/hr
R=	0.51
A=	4.84 acres
Tc=	21.50 minutes
	60 sec/min
Detention Volume=	3,184 cubic feet

$$R = (Cdev * ldev) - (Cundev * lundev)$$

$$Detention Volume = R * A * Tc * 60$$

Stormwater Calcs - Creekside Addition Phase 2  
 using Rational Method  
 Detention Culverts

Pond 1

PIPE NAME	DIAMETER (IN)	LENGTH (FT)	AREA (SF)	VOLUME (CF)
DETENTION PIPE 1	36.00	179	7.07	1265.28
DETENTION PIPE 2	36.00	173	7.07	1222.86
DETENTION PIPE 3	36.00	92	7.07	650.31
DETENTION PIPE 4	36.00	32	7.07	226.19
DETENTION PIPE 4	30.00	42	4.91	206.17
STORM DRAINAGE BOX	48.00	4	12.57	50.27
<b>TOTAL</b>		<b>522</b>		<b>3621.08</b>

Pond 2

PIPE NAME	DIAMETER (IN)	LENGTH (FT)	AREA (SF)	VOLUME (CF)
DETENTION PIPE 1	30.00	143	4.91	701.95
STORM DRAINAGE BOX	48.00	4	12.57	50.27
			0.00	0.00
			0.00	0.00
<b>TOTAL</b>		<b>147</b>		<b>752.22</b>

Pond 3

PIPE NAME	DIAMETER (IN)	LENGTH (FT)	AREA (SF)	VOLUME (CF)
DETENTION PIPE 1	30.00	381	4.91	1870.23
DETENTION PIPE 2	24.00	381	3.14	1196.95
DETENTION PIPE 3	18.00	33	1.77	58.32
DETENTION PIPE 4	18.00	33	1.77	58.32
STORM DRAINAGE BOX	48.00	4	12.57	50.27
<b>TOTAL</b>		<b>832</b>		<b>3234.07</b>

**Stormwater Calcs - Creekside Addition Phase 2**  
**Box Culvert Capacity**

Q<sub>10</sub> = 106.55 CFS  
 Q<sub>25</sub> = 117.20 CFS  
 Q<sub>100</sub> = 133.19 CFS

<b>Manning's Equation Method</b>	
Contributing Basin, Ac	68.30
Design Flow, Qd=	117.20
No. Barrels	1
Height of Barrel=	2
Width of Barrel=	4
Area Opening One Barrel=	8
Wetted Perimeter One Barrel=	8
Hydraulic Radius of One Barrel=	1.00
Roughness, N=	0.012
Slope, S=	1.50%
Flow Capacity, Qcap of One Barrel=	121.33
Total Flow Capacity, Qct=	121.33

OK

97%

Stormwater Calcs - Creekside Addition Phase 2  
Pipe Capacity


Outlet Pipes			Q25										
Pipe	From	To	Design Flow (cfs):	Slope (ft/ft):	Diameter (inches)	No. Pipes	Manning's	Area Full (sf)	Wetted Perimeter Full (ft)	Hydraulic Radius Full (ft)	Flow Capacity (cfs)	% Capacity	
18" HDPE	JB-3	FES-1	11.69	0.0250	18	1	0.012	1.77	4.712	0.375	17.99	65%	
18" HDPE	CI-13	FES-2	10.80	0.0113	18	1	0.012	1.77	4.712	0.375	12.10	89%	

Drainage Pipes			Q25										
Pipe	From	To	Design Flow (cfs):	Slope (ft/ft):	Diameter (inches)	No. Pipes	Manning's	Area Full (sf)	Wetted Perimeter Full (ft)	Hydraulic Radius Full (ft)	Flow Capacity (cfs)	% Capacity	
18" RCP	CI-1	CI-2	4.84	0.0250	18	1	0.012	1.77	4.712	0.375	17.99	27%	
18" RCP	CI-2	CI-3	6.25	0.0250	18	1	0.012	1.77	4.712	0.375	17.99	35%	
18" RCP	CI-9	CI-10	5.90	0.0250	18	1	0.012	1.77	4.712	0.375	17.99	33%	
18" HDPE	CI-10	JB-2	7.08	0.0250	18	1	0.012	1.77	4.712	0.375	17.99	39%	
18" HDPE	JB-2	CI-12	8.27	0.0250	18	1	0.012	1.77	4.712	0.375	17.99	46%	
18" RCP	CI-15	CI-12	2.40	0.0250	18	1	0.012	1.77	4.712	0.375	17.99	13%	

Stormwater Calcs -  
 using Rational Method  
 Weir & Detention Pond Sizing - Pond 1

Storm Event	Flow (cfs)
Q2 - Pre	6.11
Q5 - Pre	7.97
Q10 - Pre	9.26
Q25 - Pre	11.69
Q50 - Pre	13.90
Q100 - Pre	16.39
Q25 - Post	13.91

**Rectangular Weir**

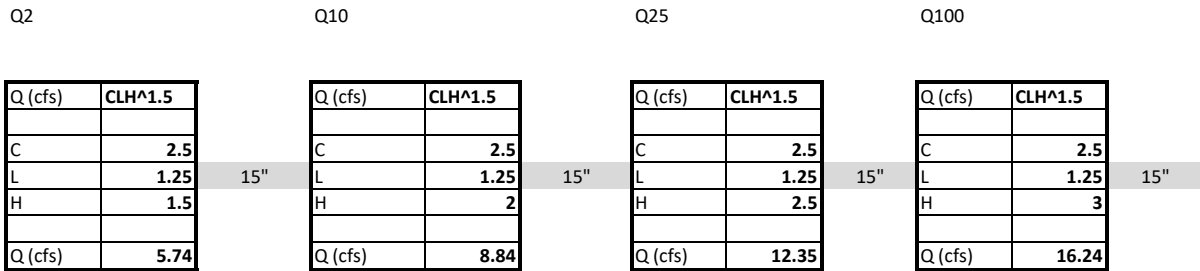

Stormwater Calcs -  
 using Rational Method  
 Weir & Detention Pond Sizing - Pond 2

Storm Event	Flow (cfs)
Q2 - Pre	1.05
Q5 - Pre	1.37
Q10 - Pre	1.62
Q25 - Pre	1.97
Q50 - Pre	2.35
Q100 - Pre	2.82
Q25 - Post	2.38

**Rectangular Weir**

Q2

Q10

Q25

Q100

Q (cfs)	CLH <sup>1.5</sup>
C	2.5
L	0.25
H	1
Q (cfs)	0.63

3"

Q (cfs)	CLH <sup>1.5</sup>
C	2.5
L	0.25
H	1.5
Q (cfs)	1.15

3"

Q (cfs)	CLH <sup>1.5</sup>
C	2.5
L	0.25
H	2
Q (cfs)	1.77

3"

Q (cfs)	CLH <sup>1.5</sup>
C	2.5
L	0.25
H	2.5
Q (cfs)	2.47

3"



**Stormwater Calcs -  
using Rational Method  
Weir & Detention Pond Sizing - Pond 2**

Storm Event	Flow (cfs)
Q2 - Pre	5.91
Q5 - Pre	7.50
Q10 - Pre	9.04
Q25 - Pre	10.80
Q50 - Pre	12.89
Q100 - Pre	15.46
Q25 - Post	11.56

**Rectangular Weir**

Q2

Q (cfs)	CLH <sup>1.5</sup>
C	2.5
L	1.5
H	1.33
Q (cfs)	5.75

18"

Q10

Q (cfs)	CLH <sup>1.5</sup>
C	2.5
L	1.5
H	1.75
Q (cfs)	8.68

Q25

Q (cfs)	CLH <sup>1.5</sup>
C	2.5
L	1.5
H	2
Q (cfs)	10.61

Q100

Q (cfs)	CLH <sup>1.5</sup>
C	2.5
L	1.5
H	2.5
Q (cfs)	14.82



**Stormwater Calcs - Creekside Addition Phase 2**  
**Using Rational Method**

Post-development Basin

**Calculated Tc values - Drainage Basin CI-1**

$$T_c = \frac{56 * L^{.6} * n^{.6}}{i^{.4} * S^{.3}} \text{ seconds}$$

L1 = 700 feet  
n1 = 0.013 Smooth Concrete/Asphalt  
S1 = 0.031 ft/ft  
I<sub>assumed</sub> = 7.20 inches  
T<sub>c</sub><sub>calculated</sub> = 271 seconds  
T<sub>c</sub><sub>calculated</sub> = 4.52 minutes  
  
Tc = 4.52 minutes  
I = 7.20 inches  
  
Use Tc = **5.00** minutes

**Calculated Tc values - Drainage Basin CI-7**

$$T_c = \frac{56 * L^{.6} * n^{.6}}{i^{.4} * S^{.3}} \text{ seconds}$$

L1 = 650 feet  
n1 = 0.013 Smooth Concrete/Asphalt  
S1 = 0.031 ft/ft  
I<sub>assumed</sub> = 7.20 inches  
T<sub>c</sub><sub>calculated</sub> = 259 seconds  
T<sub>c</sub><sub>calculated</sub> = 4.32 minutes  
  
Tc = 4.32 minutes  
I = 7.20 inches  
  
Use Tc = **5.00** minutes

Stormwater Calcs - Creekside Addition Phase 2  
using Rational Method  
POST-DEV C VALUES

CI-1	Area	C <sub>10</sub>	C <sub>25</sub>	C <sub>100</sub>	(C values taken from Table 400-2 of City of Bryant Drainage Manual)
	0.96	0.5	0.6	0.7	Residential
<b>Total Area =</b>	<b>0.96</b>	<b>0.50</b>	<b>0.60</b>	<b>0.70</b>	

CI-2	Area	C <sub>10</sub>	C <sub>25</sub>	C <sub>100</sub>	(C values taken from Table 400-2 of City of Bryant Drainage Manual)
	0.28	0.5	0.6	0.7	Residential
<b>Total Area =</b>	<b>0.28</b>	<b>0.50</b>	<b>0.60</b>	<b>0.70</b>	

CI-3					
Area	C <sub>10</sub>	C <sub>25</sub>	C <sub>100</sub>	(C values taken from Table 400-2 of City of Bryant Drainage Manual)	
	0.04	0.5	0.6	0.7	Residential
<b>Total Area =</b>	<b>0.04</b>	<b>0.50</b>	<b>0.60</b>	<b>0.70</b>	

CI-4					
Area	C <sub>10</sub>	C <sub>25</sub>	C <sub>100</sub>	(C values taken from Table 400-2 of City of Bryant Drainage Manual)	
	0.20	0.5	0.6	0.7	Residential
<b>Total Area =</b>	<b>0.20</b>	<b>0.50</b>	<b>0.60</b>	<b>0.70</b>	

CI-5					
Area	C <sub>10</sub>	C <sub>25</sub>	C <sub>100</sub>	(C values taken from Table 400-2 of City of Bryant Drainage Manual)	
	0.87	0.5	0.6	0.7	Residential
<b>Total Area =</b>	<b>0.87</b>	<b>0.50</b>	<b>0.60</b>	<b>0.70</b>	

CI-6					
Area	C <sub>10</sub>	C <sub>25</sub>	C <sub>100</sub>	(C values taken from Table 400-2 of City of Bryant Drainage Manual)	
	0.51	0.5	0.6	0.7	Residential
<b>Total Area =</b>	<b>0.51</b>	<b>0.50</b>	<b>0.60</b>	<b>0.70</b>	

CI-7					
	Area	C <sub>10</sub>	C <sub>25</sub>	C <sub>100</sub>	(C values taken from Table 400-2 of City of Bryant Drainage Manual)
	1.89	0.5	0.6	0.7	Residential
<b>Total Area =</b>	<b>1.89</b>	<b>0.50</b>	<b>0.60</b>	<b>0.70</b>	

CI-8					
	Area	C <sub>10</sub>	C <sub>25</sub>	C <sub>100</sub>	(C values taken from Table 400-2 of City of Bryant Drainage Manual)
	0.88	0.5	0.6	0.7	Residential
<b>Total Area =</b>	<b>0.88</b>	<b>0.50</b>	<b>0.60</b>	<b>0.70</b>	

CI-9					
	Area	C <sub>10</sub>	C <sub>25</sub>	C <sub>100</sub>	(C values taken from Table 400-2 of City of Bryant Drainage Manual)
	1.17	0.5	0.6	0.7	Residential
<b>Total Area =</b>	<b>1.17</b>	<b>0.50</b>	<b>0.60</b>	<b>0.70</b>	

CI-10					
	Area	C <sub>10</sub>	C <sub>25</sub>	C <sub>100</sub>	(C values taken from Table 400-2 of City of Bryant Drainage Manual)
	0.33	0.5	0.6	0.7	Residential
<b>Total Area =</b>	<b>0.33</b>	<b>0.50</b>	<b>0.60</b>	<b>0.70</b>	

CI-11					
	Area	C <sub>10</sub>	C <sub>25</sub>	C <sub>100</sub>	
					(C values taken from Table 400-2 of City of Bryant Drainage Manual)
	0.17	0.5	0.6	0.7	Residential
<b>Total Area =</b>	<b>0.17</b>	<b>0.50</b>	<b>0.60</b>	<b>0.70</b>	

CI-12					
	Area	C <sub>10</sub>	C <sub>25</sub>	C <sub>100</sub>	
					(C values taken from Table 400-2 of City of Bryant Drainage Manual)
	0.26	0.5	0.6	0.7	Residential
<b>Total Area =</b>	<b>0.26</b>	<b>0.50</b>	<b>0.60</b>	<b>0.70</b>	

CI-13					
	Area	C <sub>10</sub>	C <sub>25</sub>	C <sub>100</sub>	
					(C values taken from Table 400-2 of City of Bryant Drainage Manual)
	0.24	0.9	0.92	0.97	Residential
<b>Total Area =</b>	<b>0.24</b>	<b>0.90</b>	<b>0.92</b>	<b>0.97</b>	

CI-14					
	Area	C <sub>10</sub>	C <sub>25</sub>	C <sub>100</sub>	
					(C values taken from Table 400-2 of City of Bryant Drainage Manual)
	0.22	0.9	0.92	0.97	Residential
<b>Total Area =</b>	<b>0.22</b>	<b>0.90</b>	<b>0.92</b>	<b>0.97</b>	

CI-15					
Area	C <sub>10</sub>	C <sub>25</sub>	C <sub>100</sub>	(C values taken from Table 400-2 of City of Bryant Drainage Manual)	
	0.35	0.5	0.6	0.7	Residential
<b>Total Area =</b>	<b>0.35</b>	<b>0.50</b>	<b>0.60</b>	<b>0.70</b>	

CI-16					
Area	C <sub>10</sub>	C <sub>25</sub>	C <sub>100</sub>	(C values taken from Table 400-2 of City of Bryant Drainage Manual)	
	0.29	0.9	0.92	0.97	Residential
<b>Total Area =</b>	<b>0.29</b>	<b>0.90</b>	<b>0.92</b>	<b>0.97</b>	

CI-17					
Area	C <sub>10</sub>	C <sub>25</sub>	C <sub>100</sub>	(C values taken from Table 400-2 of City of Bryant Drainage Manual)	
	1.37	0.5	0.6	0.7	Residential
<b>Total Area =</b>	<b>1.37</b>	<b>0.50</b>	<b>0.60</b>	<b>0.70</b>	



**Stormwater Calcs - Creekside Addition Phase 2**  
**using Rational Method**  
**Post Development Flowrates**

CI-1	$Q_{10} =$	3.46 CFS
	$c =$	0.50
	$i =$	7.20 in/hr
	$A =$	0.96 acres

CI-2	$Q_{10} =$	1.01 CFS
	$c =$	0.50
	$i =$	7.20 in/hr
	$A =$	0.28 acres

CI-3	$Q_{10} =$	0.14 CFS
	$c =$	0.50
	$i =$	7.20 in/hr
	$A =$	0.04 acres

CI-4

$Q_{10} =$  0.72 CFS  
 $c =$  0.50  
 $i =$  7.20 in/hr  
 $A =$  0.20 acres

CI-5

$Q_{10} =$  3.13 CFS  
 $c =$  0.50  
 $i =$  7.20 in/hr  
 $A =$  0.87 acres

CI-6

$Q_{10} =$  1.84 CFS  
 $c =$  0.50  
 $i =$  7.20 in/hr  
 $A =$  0.51 acres

CI-7

$Q_{10} =$  6.80 CFS  
 $c =$  0.50  
 $i =$  7.20 in/hr  
 $A =$  1.89 acres

CI-8

$Q_{10} = 3.17$  CFS  
 $c = 0.50$   
 $i = 7.20$  in/hr  
 $A = 0.88$  acres

CI-9

$Q_{10} = 4.21$  CFS  
 $c = 0.50$   
 $i = 7.20$  in/hr  
 $A = 1.17$  acres

CI-10

$Q_{10} = 1.19$  CFS  
 $c = 0.50$   
 $i = 7.20$  in/hr  
 $A = 0.33$  acres

CI-11

$Q_{10} = 0.61$  CFS  
 $c = 0.50$   
 $i = 7.20$  in/hr  
 $A = 0.17$  acres

CI-12

$Q_{10} = 0.94$  CFS  
 $c = 0.50$   
 $i = 7.20$  in/hr  
 $A = 0.26$  acres

CI-13

$Q_{10} = 1.56$  CFS  
 $c = 0.90$   
 $i = 7.20$  in/hr  
 $A = 0.24$  acres

CI-14

$Q_{10} = 1.43$  CFS  
 $c = 0.90$   
 $i = 7.20$  in/hr  
 $A = 0.22$  acres

CI-15

$Q_{10} = 1.26$  CFS  
 $c = 0.50$   
 $i = 7.20$  in/hr  
 $A = 0.35$  acres

CI-16

$Q_{10} = 1.88$  CFS  
 $c = 0.90$   
 $i = 7.20$  in/hr  
 $A = 0.29$  acres

CI-17

$Q_{10} = 4.93$  CFS  
 $c = 0.50$   
 $i = 7.20$  in/hr  
 $A = 1.37$  acres

## Creekside Addition Phase 2 GUTTER SPREAD 10-YR STORM

### CI-1

$$T = \left( \frac{Q \cdot n}{k_u \cdot S_x^{1.67} \cdot S_L^{0.5}} \right)^{.375}$$

Q	3.46 cfs	Q= Flowrate(cfs)
n	0.012	n=manning's number
k <sub>u</sub>	0.56	k=0.56
S <sub>x</sub>	0.028	S <sub>x</sub> = cross slope
S <sub>L</sub>	0.031	S <sub>L</sub> = longitudinal slope
T	<u>6.78</u> ft	T= Gutter Spread

### CI-2

$$T = \left( \frac{Q \cdot n}{k_u \cdot S_x^{1.67} \cdot S_L^{0.5}} \right)^{.375}$$

Q	1.01 cfs
n	0.012
k <sub>u</sub>	0.56
S <sub>x</sub>	0.03
S <sub>L</sub>	0.017
T	<u>4.58</u> ft

### CI-3

$$T = \left( \frac{Q \cdot n}{k_u \cdot S_x^{1.67} \cdot S_L^{0.5}} \right)^{.375}$$

Q	0.14 cfs
n	0.012
k <sub>u</sub>	0.56
S <sub>x</sub>	0.028
S <sub>L</sub>	0.03
T	<u>2.10</u> ft

**CI-4**

$$T = \left( \frac{Q \cdot n}{k_u \cdot S_x^{1.67} \cdot S_L^{0.5}} \right)^{.375}$$

Q	0.72 cfs
n	0.012
$k_u$	0.56
$S_x$	0.03
$S_L$	0.03
T	<b><u>3.68</u></b> ft

**CI-5**

$$T = \left( \frac{Q \cdot n}{k_u \cdot S_x^{1.67} \cdot S_L^{0.5}} \right)^{.375}$$

Q	3.13 cfs
n	0.012
$k_u$	0.56
$S_x$	0.028
$S_L$	0.03
T	<b><u>6.58</u></b> ft

**CI-6**

$$T = \left( \frac{Q \cdot n}{k_u \cdot S_x^{1.67} \cdot S_L^{0.5}} \right)^{.375}$$

Q	1.84 cfs
n	0.012
$k_u$	0.56
$S_x$	0.03
$S_L$	0.03
T	<b><u>5.22</u></b> ft

**CI-7**

$$T = \left( \frac{Q \cdot n}{k_u \cdot S_x^{1.67} \cdot S_L^{0.5}} \right)^{.375}$$

Q	6.80 cfs
n	0.012
$k_u$	0.56
$S_x$	0.03
$S_L$	0.03
T	<b><u>8.43</u></b> ft

**CI-8**

$$T = \left( \frac{Q \cdot n}{k_u \cdot S_x^{1.67} \cdot S_L^{0.5}} \right)^{.375}$$

Q	3.17 cfs
n	0.012
k <sub>u</sub>	0.56
S <sub>x</sub>	0.028
S <sub>L</sub>	0.03
T	<b><u>6.61</u></b> ft

**CI-9**

$$T = \left( \frac{Q \cdot n}{k_u \cdot S_x^{1.67} \cdot S_L^{0.5}} \right)^{.375}$$

Q	4.21 cfs
n	0.012
k <sub>u</sub>	0.56
S <sub>x</sub>	0.028
S <sub>L</sub>	0.03
T	<b><u>7.35</u></b> ft

**CI-10**

$$T = \left( \frac{Q \cdot n}{k_u \cdot S_x^{1.67} \cdot S_L^{0.5}} \right)^{.375}$$

Q	1.19 cfs
n	0.012
k <sub>u</sub>	0.56
S <sub>x</sub>	0.03
S <sub>L</sub>	0.03
T	<b><u>4.38</u></b> ft

**CI-11**

$$T = \left( \frac{Q \cdot n}{k_u \cdot S_x^{1.67} \cdot S_L^{0.5}} \right)^{.375}$$

Q	0.61 cfs
n	0.012
k <sub>u</sub>	0.56
S <sub>x</sub>	0.02
S <sub>L</sub>	0.02
T	<b><u>4.75</u></b> ft

**CI-12**

$$T = \left( \frac{Q \cdot n}{k_u \cdot S_x^{1.67} \cdot S_L^{0.5}} \right)^{.375}$$

Q	0.94 cfs
n	0.012
k <sub>u</sub>	0.56
S <sub>x</sub>	0.03
S <sub>L</sub>	0.03
T	<b><u>4.00</u></b> ft

**CI-13**

$$T = \left( \frac{Q \cdot n}{k_u \cdot S_x^{1.67} \cdot S_L^{0.5}} \right)^{.375}$$

Q	1.56 cfs
n	0.012
k <sub>u</sub>	0.56
S <sub>x</sub>	0.03
S <sub>L</sub>	0.03
T	<b><u>4.84</u></b> ft

**CI-14**

$$T = \left( \frac{Q \cdot n}{k_u \cdot S_x^{1.67} \cdot S_L^{0.5}} \right)^{.375}$$

Q	1.43 cfs
n	0.012
k <sub>u</sub>	0.56
S <sub>x</sub>	0.03
S <sub>L</sub>	0.03
T	<b><u>4.69</u></b> ft

**CI-15**

$$T = \left( \frac{Q \cdot n}{k_u \cdot S_x^{1.67} \cdot S_L^{0.5}} \right)^{.375}$$

Q	1.26 cfs
n	0.012
k <sub>u</sub>	0.56
S <sub>x</sub>	0.03
S <sub>L</sub>	0.03
T	<b><u>4.48</u></b> ft



**CI-16**

$$T = \left( \frac{Q \cdot n}{k_u \cdot S_x^{1.67} \cdot S_L^{0.5}} \right)^{.375}$$

Q	1.88 cfs
n	0.012
$k_u$	0.56
$S_x$	0.03
$S_L$	0.03
T	<b><u>5.20</u></b> ft

**CI-17**

$$T = \left( \frac{Q \cdot n}{k_u \cdot S_x^{1.67} \cdot S_L^{0.5}} \right)^{.375}$$

Q	4.93 cfs
n	0.012
$k_u$	0.56
$S_x$	0.03
$S_L$	0.03
T	<b><u>7.47</u></b> ft

## Creekside Addition Phase 2 - CURB INLETS

10-YEAR STORM

Area #	Area	I	C	Weir			Required L (ft)	Actual L (ft)	
				Q (cfs)	Q=3.0LY <sup>1.5</sup> Q (cfs)	Y (ft)			
CI-1	0.96	7.20	0.50	3.46	3.46	0.49	<b>3.36</b>	<b>4</b>	4' box
CI-2	0.28	7.20	0.50	1.01	1.01	0.49	<b>0.98</b>	<b>4</b>	4' box
CI-3	0.04	7.20	0.90	0.26	0.26	0.49	<b>0.25</b>	<b>5</b>	5' box
CI-4	0.20	7.20	0.50	0.72	0.72	0.49	<b>0.70</b>	<b>5</b>	5' box
CI-5	0.87	7.20	0.50	3.13	3.13	0.49	<b>3.04</b>	<b>5</b>	5' box
CI-6	0.51	7.20	0.50	1.84	1.84	0.49	<b>1.78</b>	<b>5</b>	5' box
CI-7	1.89	7.20	0.50	6.80	6.80	0.49	<b>6.61</b>	<b>7'-6"</b>	5' box with 3'-6" wing
CI-8	0.88	7.20	0.50	3.17	3.17	0.49	<b>3.08</b>	<b>5</b>	5' box
CI-9	1.17	7.20	0.50	4.21	4.21	0.49	<b>4.09</b>	<b>7'-6"</b>	4' box with 3'-6" wing
CI-10	0.33	7.20	0.50	1.19	1.19	0.49	<b>1.15</b>	<b>4</b>	4' box
CI-11	0.17	7.20	0.50	0.61	0.61	0.49	<b>0.59</b>	<b>4</b>	4' box
CI-12	0.26	7.20	0.50	0.94	0.94	0.49	<b>0.91</b>	<b>5</b>	5' box
CI-13	0.24	7.20	0.90	1.56	1.56	0.49	<b>1.51</b>	<b>5</b>	5' box
CI-14	0.22	7.20	0.50	0.79	0.79	0.49	<b>0.77</b>	<b>5</b>	5' box
CI-15	0.35	7.20	0.50	1.26	1.26	0.49	<b>1.22</b>	<b>4</b>	4' box
CI-16	0.29	7.20	0.90	1.88	1.88	0.49	<b>1.83</b>	<b>4</b>	4' box
CI-17	1.37	7.20	0.50	4.93	4.93	0.49	<b>4.79</b>	<b>7'-6"</b>	4' box with 3'-6" wing



# CREEKSIDE SUBDIVISION PHASE 2 BRYANT, ARKANSAS

Prepared by:  
**GarNat Engineering, LLC**


Designing our client's success  
[www.garnatengineering.com](http://www.garnatengineering.com)

P.O. Box 116  
Benton, AR 72018  
Ph (501) 408-4650



3825 Mt Carmel Road  
Bryant, AR 72022  
Fx (888) 900-3068

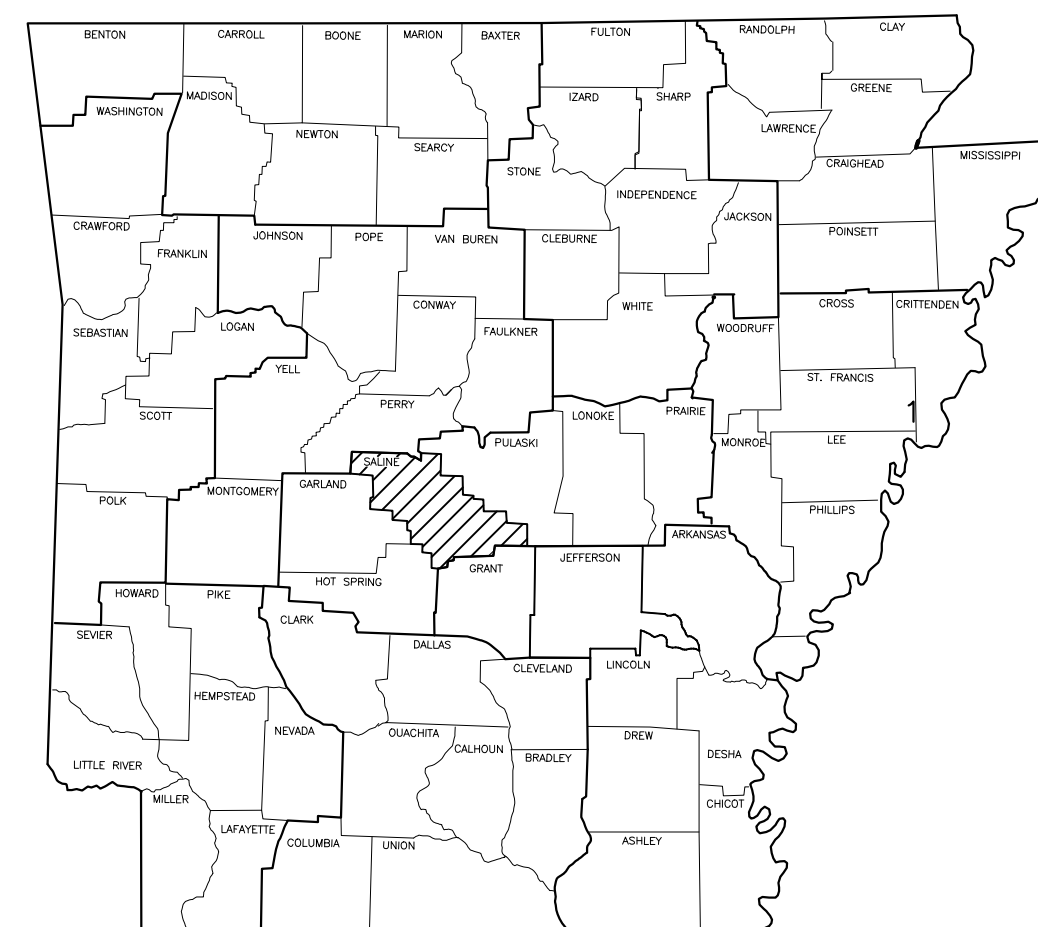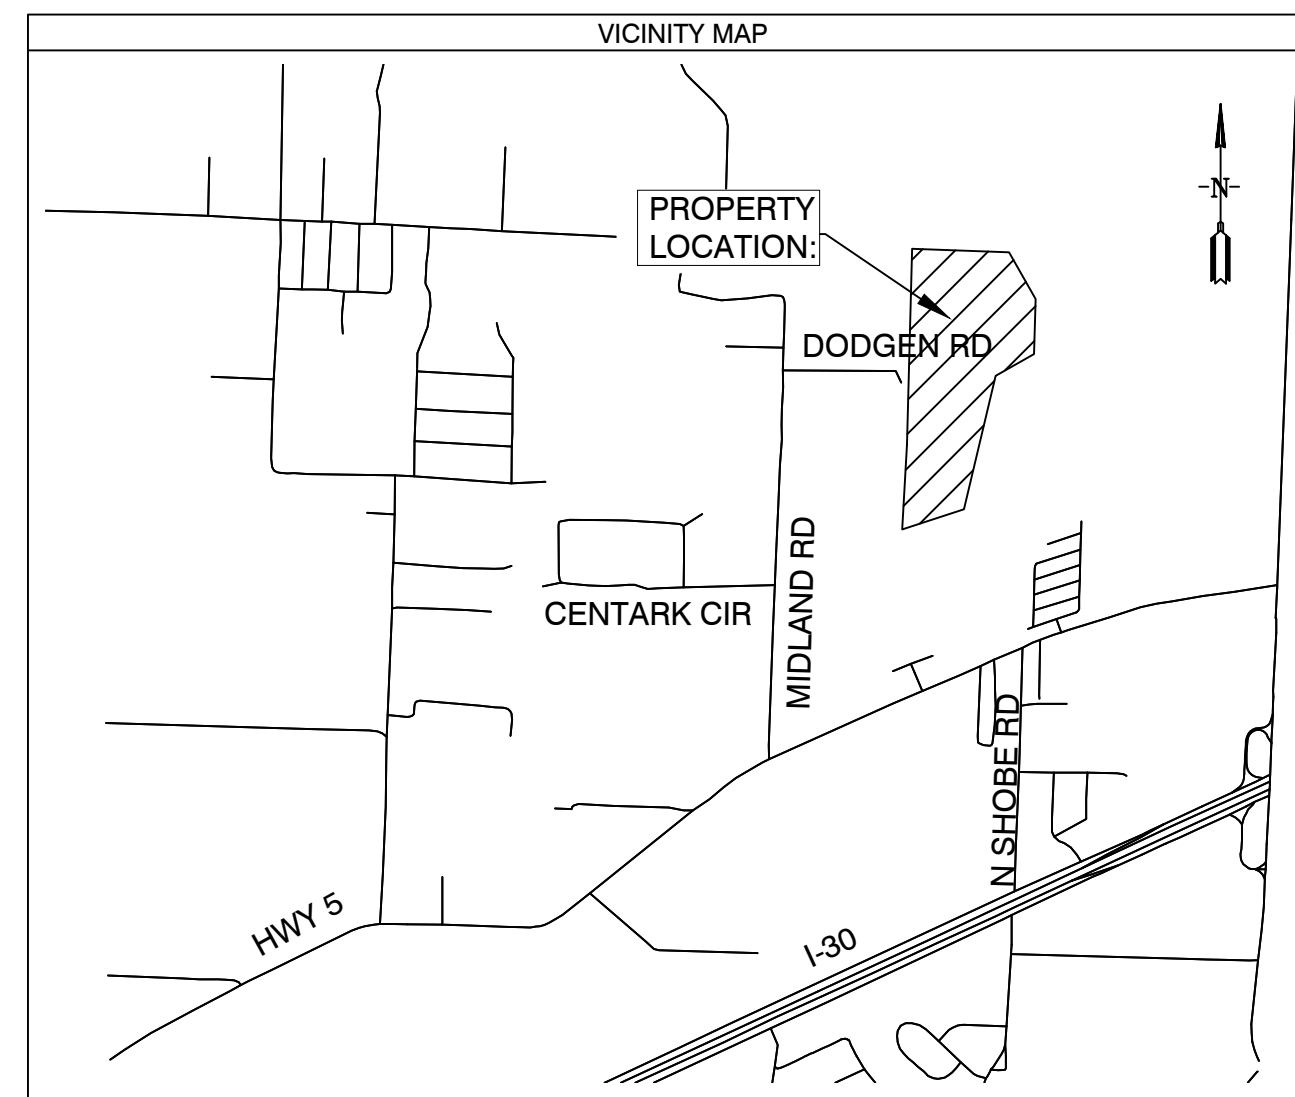

- 1 PRELIMINARY PLAT OVERALL
- 2 PRELIMINARY PLAT SOUTH HALF
- 3 PRELIMINARY PLAT NORTH HALF
- 4 DRAINAGE PLAN
- 5 ROAD PROFILES
- 6 DRAINAGE PROFILES
- 7 OVER SEWER & WATER PLANS
- 8 OULET STRUCTURE DETAILS

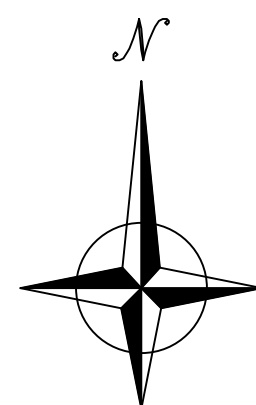

# PRELIMINARY PLAT CREEKSIDE ADDITION PHASE 2 SALINE COUNTY, ARKANSAS

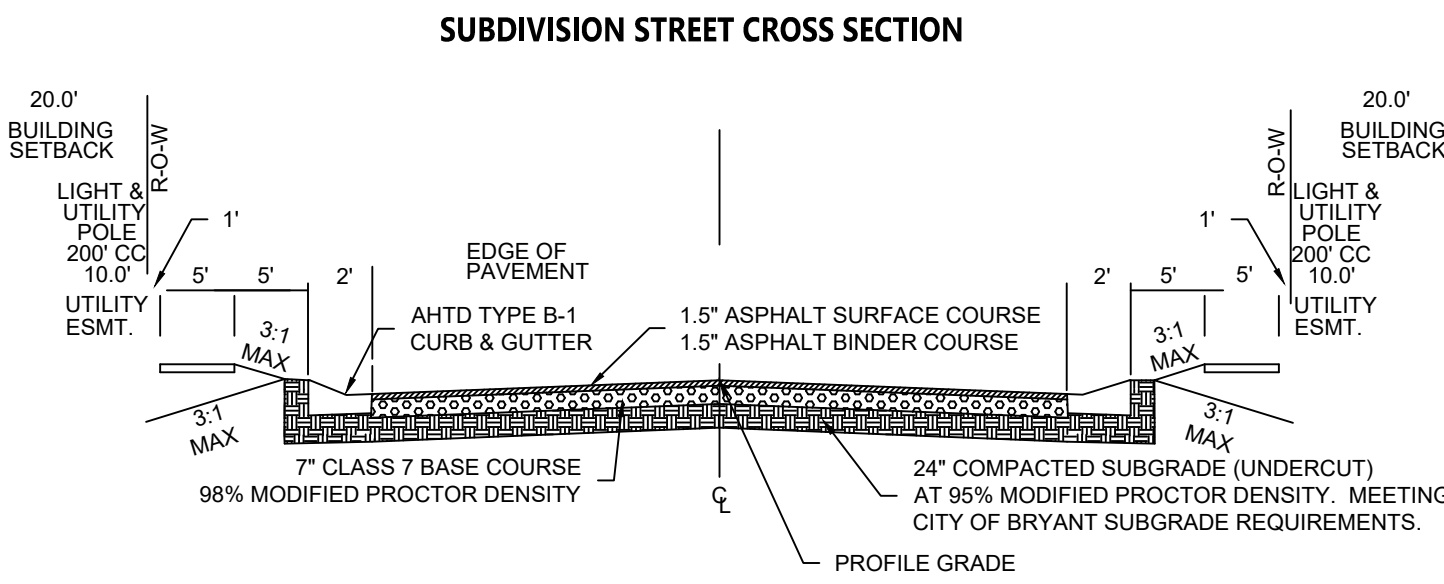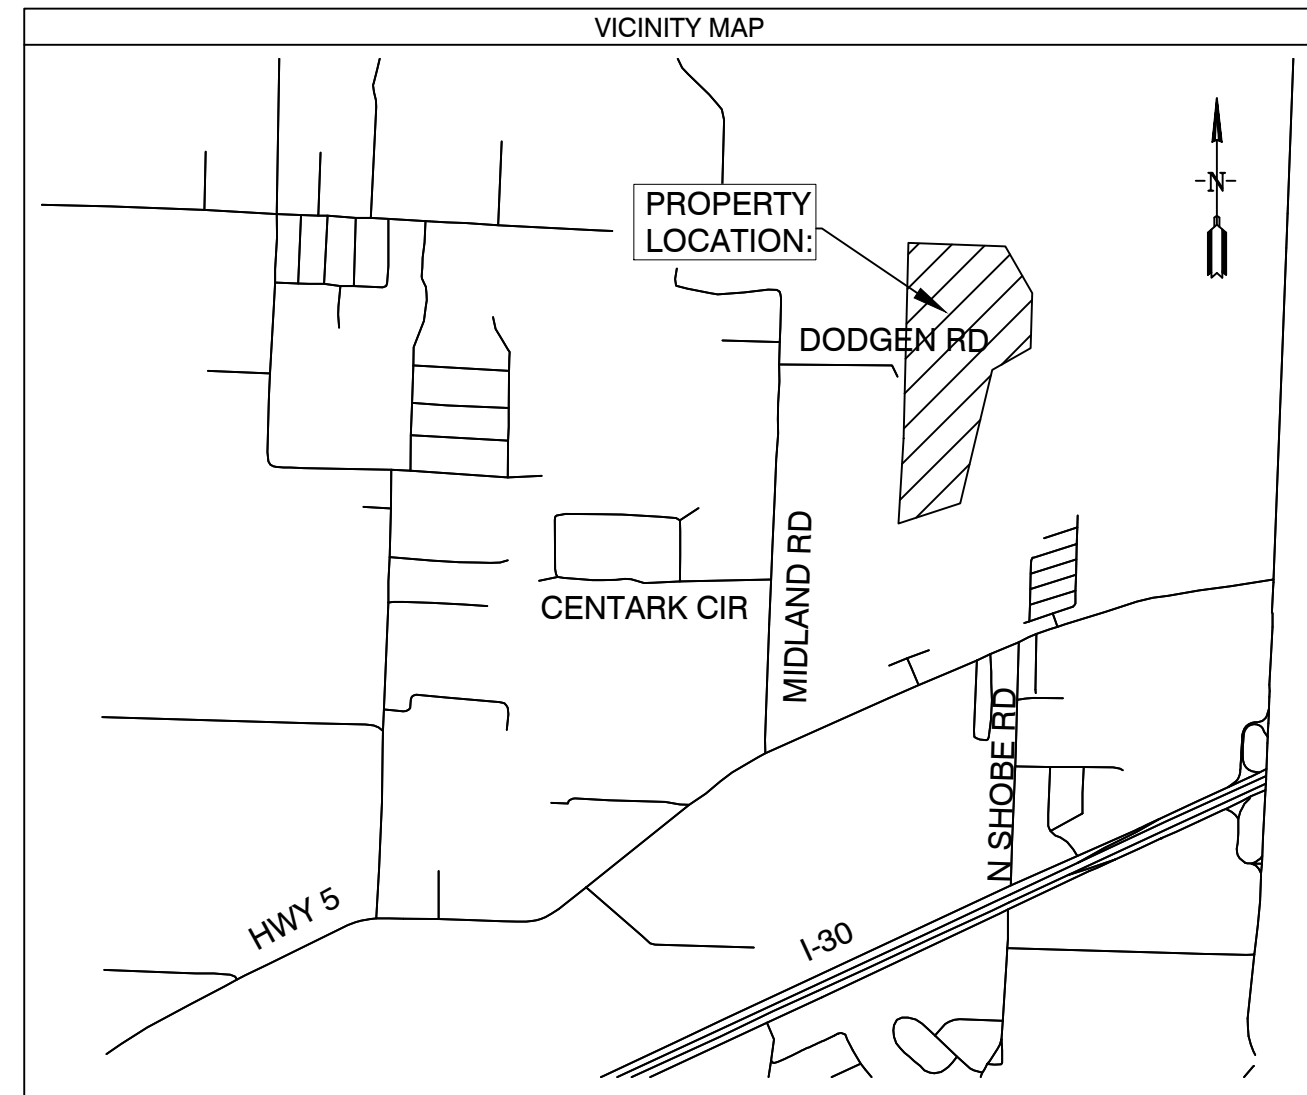

Line #	Length	Direction
L1	26.63	S45° 37' 43"W
L2	67.59	S42° 51' 15"W
L3	69.25	S42° 51' 15"W
L4	61.55	S33° 56' 28"W
L5	74.18	S59° 11' 07"W
L6	85.44	S57° 05' 38"W
L7	45.43	S61° 02' 07"W
L8	20.44	S2° 04' 49"W
L9	75.92	S78° 58' 48"E
L10	68.17	S70° 19' 12"E
L11	82.17	S51° 58' 45"E
L12	43.85	S41° 47' 58"E
L13	44.83	S16° 41' 28"E
L14	59.73	S6° 28' 58"E
L15	61.47	S0° 55' 57"E
L16	67.51	S19° 41' 07"W
L17	118.71	S50° 16' 07"W
L18	136.69	S38° 51' 03"W
L19	100.82	S22° 07' 30"W
L20	37.28	S6° 12' 28"W

Line #	Length	Direction
L21	41.25	S21° 27' 38"E
L22	43.04	S21° 27' 38"E
L23	28.95	S0° 00' 17"W
L24	114.30	S34° 41' 56"W
L25	10.01	N89° 52' 05"W

**PROPERTY DESCRIPTION:**  
PART OF THE EAST HALF OF THE NORTHWEST QUARTER ALL IN SECTION 12, TOWNSHIP 1 SOUTH, RANGE 14 WEST, SALINE COUNTY, ARKANSAS, DESCRIBED AS FOLLOWS:

COMMENCING AT THE NORTHWEST CORNER OF LOT 77 OF THE CREEK SIDE ADDITION, PHASE 1 TO THE CITY OF BRYANT, SALINE COUNTY, ARKANSAS AND RUN THENCE NORTH 1°58'21" EAST ALONG THE EAST LINE OF CREEK WATER DRIVE A DISTANCE OF 115.05 FEET TO THE POINT OF BEGINNING; THENCE NORTH 89°52'06" WEST ALONG THE NORTH LINE OF SAID CREEKSIDE ADDITION, PHASE 1, A DISTANCE OF 275.01 FEET; THENCE NORTH 31°22'58" EAST 94.60 FEET; NORTH 22°56'11" EAST 80.29 FEET; NORTH 26°04'51" EAST 82.13 FEET; NORTH 24°48'10" EAST 81.34 FEET; NORTH 8°56'14" EAST 60.55 FEET; SOUTH 87°58'11" EAST 57.60 FEET; NORTH 2°01'49" EAST 319.19 FEET; SOUTH 45°37'43" WEST 26.63 FEET; SOUTH 42°51'15" WEST 67.59 FEET; SOUTH 42°51'15" WEST 69.25 FEET; SOUTH 33°56'28" WEST 61.55 FEET; SOUTH 59°11'07" WEST 74.18 FEET; SOUTH 57°05'38" WEST 85.44 FEET TO A POINT ON THE WEST LINE OF SAID E 1/2 NW 1/4; THENCE NORTH 2°04'49" EAST ALONG THE WEST LINE OF SAID E 1/2 NW 1/4 A DISTANCE OF 1694.30 FEET TO THE NORTH WEST CORNER OF THE NORTHWEST QUARTER OF SAID SECTION 12; THENCE SOUTH 89°14'31" EAST ALONG THE NORTH LINE OF SAID NE 1/4 NW 1/4 A DISTANCE OF 109.53 FEET; THENCE SOUTH 23°32'08" EAST 116.13 FEET TO THE START OF A CURVE TO THE LEFT THENCE 86.62 FEET ALONG THE ARC OF A CURVE HAVING A RADIUS OF 70.0', SAID CURVE HAVING A CHORD BEARING & DISTANCE OF SOUTH 78°06'51" EAST 81.20 FEET; THENCE SOUTH 84°18'55" EAST 153.41 FEET; SOUTH 5°41'05" WEST 71.66 FEET; SOUTH 61°02'07" WEST 45.43 FEET; NORTH 86°35'33" WEST 113.34 FEET TO THE START OF A CURVE TO THE LEFT; THENCE 29.41 FEET ALONG THE ARC OF A CURVE HAVING RADIUS OF 70.0', SAID CURVE HAVING A CHORD BEARING & DISTANCE OF SOUTH 62°56'29" WEST 29.19 FEET; THENCE ALONG THE ARC OF ANOTHER CURVE HAVING A RADIUS OF 15.00' TO THE LEFT A DISTANCE OF 19.08 FEET, SAID CURVE HAVING A CHORD BEARING AND DISTANCE OF SOUTH 38°31'41" WEST 17.82 FEET; THENCE SOUTH 2°04'49" WEST 112.09 FEET; THENCE SOUTH 48°25'26" EAST 103.75 FEET; SOUTH 57°22'48" EAST 74.02 FEET; SOUTH 2°04'49" WEST 20.44 FEET; SOUTH 78°58'48" EAST 75.92 FEET; SOUTH 70°19'12" EAST 68.17 FEET; SOUTH 51°58'45" EAST 82.17 FEET; SOUTH 41°47'58" EAST 43.85 FEET; SOUTH 16°41'28" EAST 44.83 FEET; SOUTH 6°28'58" EAST 59.73 FEET; SOUTH 0°55'57" EAST 61.47 FEET; SOUTH 19°41'07" WEST 67.51 FEET; SOUTH 50°16'07" WEST 118.71 FEET; SOUTH 38°51'03" WEST 136.69; SOUTH 22°07'30" WEST 100.82 FEET; SOUTH 6°12'28" WEST 37.28 FEET; SOUTH 21°27'38" EAST 41.25 FEET; SOUTH 21°27'38" EAST 43.04 FEET; SOUTH 0°01'17" WEST 28.95 FEET; SOUTH 34°41'56" WEST 114.30 FEET; SOUTH 2°01'49" WEST FOR 761.91 FEET; THENCE NORTH 89°52'05" WEST 10.01 FEET TO THE POINT OF BEGINNING, CONTAINING 16.17 ACRES MORE OR LESS.

Curve #	Length	Radius	Chord Direction	Chord Length
C1	86.62	70.00	S78° 06' 51"E	81.20
C2	29.41	70.00	S62° 56' 29"W	29.19
C3	19.08	15.00	S38° 31' 41"W	17.82

- DOCUMENTS USED:**
- SURVEY PLAT OF RECORD RASBERRY SURVEYING 10/23/2014
  - DEED OF RECORD 2014 PAGE 25641 WILLIAMS TO DIAMOND DEVELOPMENT II
  - DEED OF RECORD 2004 PAGE 112595 THOMAS TO DIAMOND DEVELOPMENT II
  - SURVEY PLAT OF RECORD MIDLAND FARM SUBDIVISION BY HENRY N. CONWAY 8/13/1951

**BASIS OF BEARINGS:**  
BENCHMARK(S) PROVIDED ARE REBAR AND COORDINATES ON BENCHMARKS ARE NORTH AMERICAN DATUM 1983, ARKANSAS SOUTH ZONE, US SURVEY FEET, GRID COORDINATES AND ELEVATIONS ARE NAVD 1988. COORDINATES AND ELEVATIONS WERE ESTABLISHED USING GPS AND WERE PROCESSED USING THE NATIONAL GEODETIC SURVEYS' "ONLINE POSITIONING USER SERVICE" (OPUS).

**PLAT CERTIFICATES:**

**OWNER:** Name: Diamond Development II, Address: 1599 Lawson Oaks, Little Rock, AR 72210

**DEVELOPER:** Name: Diamond Development II, Address: 1599 Lawson Oaks, Little Rock, AR 72210

**CERTIFICATE OF RECORDING:**

**CERTIFICATE OF OWNER:**  
We, the undersigned, owners of the real estate shown and described herein do hereby certify that we have laid off, platted and subdivided, and do hereby lay off, plat and subdivide said real estate in accordance with the within plat.

Date: \_\_\_\_\_ Signed: \_\_\_\_\_  
DIAMOND DEVELOPMENT II

Source of Title: SALINE COUNTY, ARKANSAS  
Saline County Document# 2014-25641 & 2004-112595

**CERTIFICATE OF PRELIMINARY ENGINEERING ACCURACY:**  
I, Vernon J. Williams, hereby certify that this plat correctly represents a survey and a plan made by me or under my supervision; that all monuments shown hereon actually exist and their locations, size, type, and material are correctly shown; and that all requirements of the City of Bryant Subdivision Rules and Regulations have been fully complied with.


Date: \_\_\_\_\_ Signed: \_\_\_\_\_  
Vernon J. Williams  
Registered Professional Engineer  
No. 9551, Arkansas

**CERTIFICATE OF PRELIMINARY SURVEYING ACCURACY:**  
I, George P. Wooden, hereby certify that this proposed preliminary plat correctly represents a boundary survey made by me or under my supervision on 6/07/2022; that the boundary lines shown hereon correspond with the description in the deeds cited in the above Source of Title; and that all monuments which were found or placed on the property are correctly described and located.

Date: \_\_\_\_\_ Signed: \_\_\_\_\_  
George P. Wooden  
Registered Land Surveyor  
No. 1573, Arkansas

**CERTIFICATE OF PRELIMINARY PLAT APPROVAL:**  
All requirements of the City of Bryant Subdivision Rules and Regulations relative to the preparation and submittal of a Preliminary Plat having been fulfilled, approval of this plat is hereby granted, subject to further provisions of said Rules and Regulations.

Date: \_\_\_\_\_ Signed: \_\_\_\_\_  
Rick Johnson, Chairman  
Bryant Planning Commission


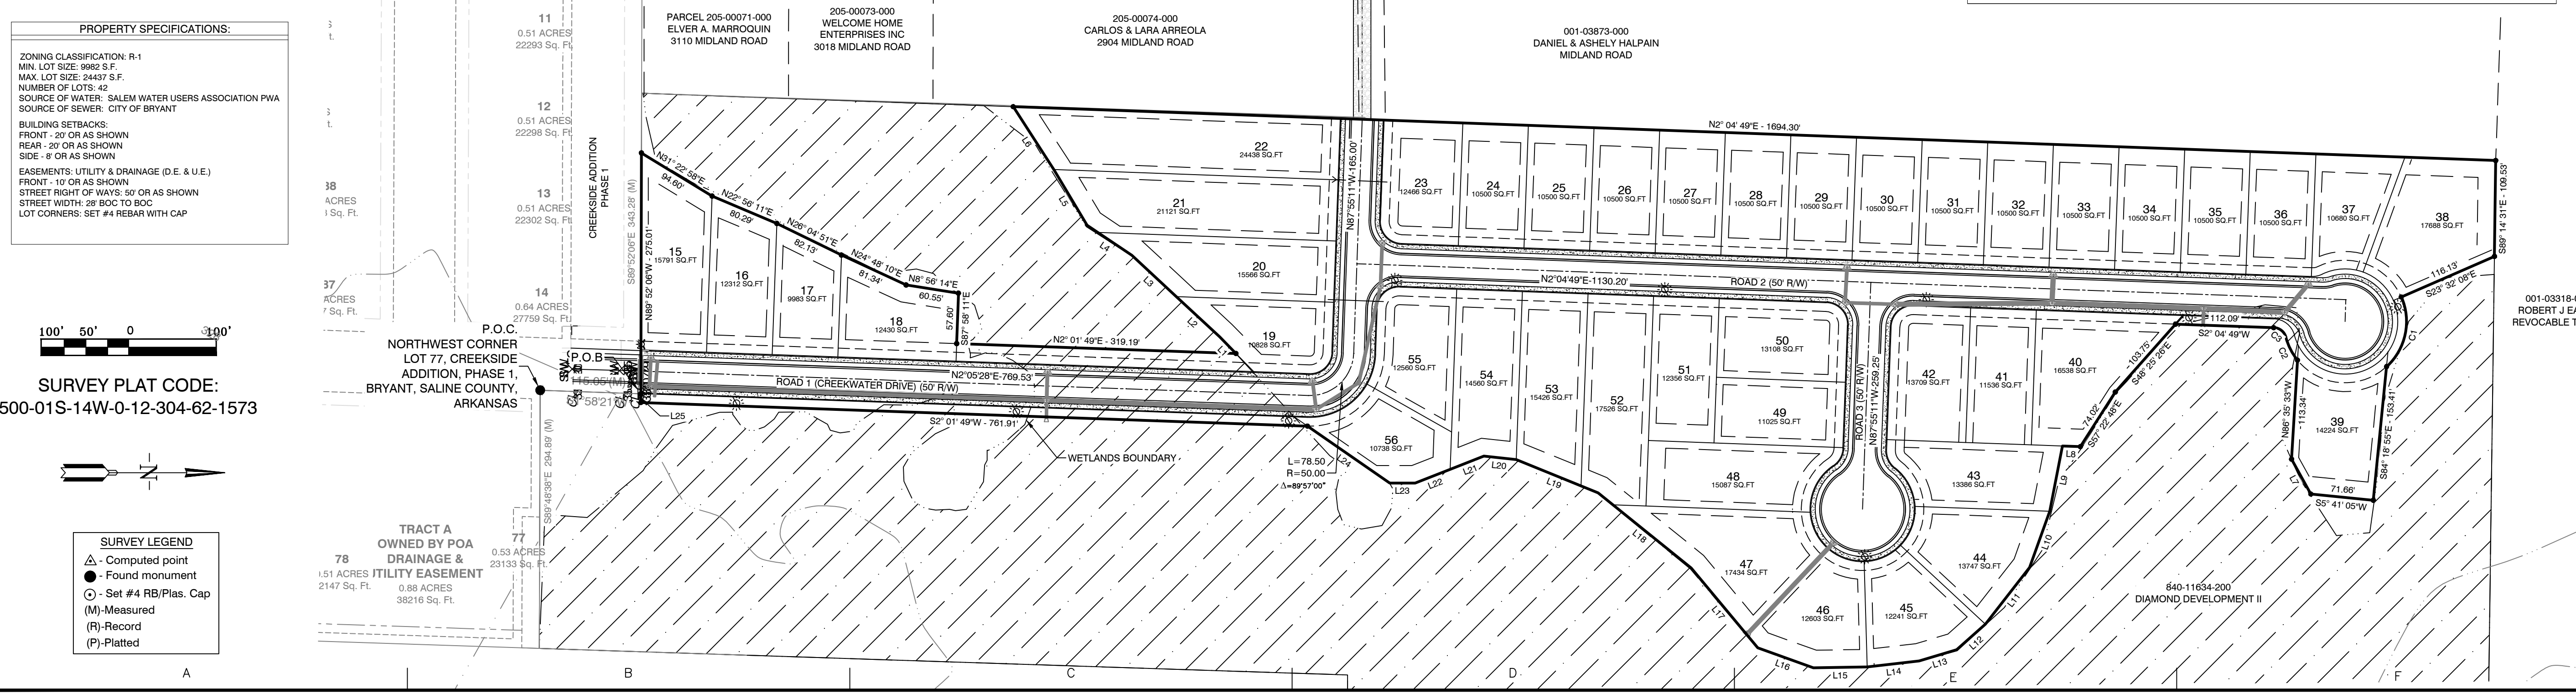


**GNE** Designing our client's success  
**GarNat Engineering, LLC**  
 P.O. Box 116 (72018) Ph (501) 408-4650  
 3925 Mt. Carmel Road Fx (888) 900-3068  
 Bryant, AR 72022 gnatengr@gmail.com

CREEKSIDE ADDITION PHASE 2  
 ALL OF LOT 101 AND PART OF LOT 99  
 AND PART OF LOT 100, MIDLAND FARM SUBDIVISION  
 PART OF THE NE 1/4 NW 1/4, PART OF THE W 1/2 SE  
 1/4 NW 1/4 AND THE NW 1/4 NE 1/4 SW 1/4 ALL IN  
 SECTION 12, T-1-S, R-14-W,  
 SALINE COUNTY, ARKANSAS

**DRAFT**

CONTENTS:  
**PRELIMINARY PLAT OVERALL**  
 PROJECT NO: 18054  
 DATE: AUGUST 2022  
 SHEET NO: 1

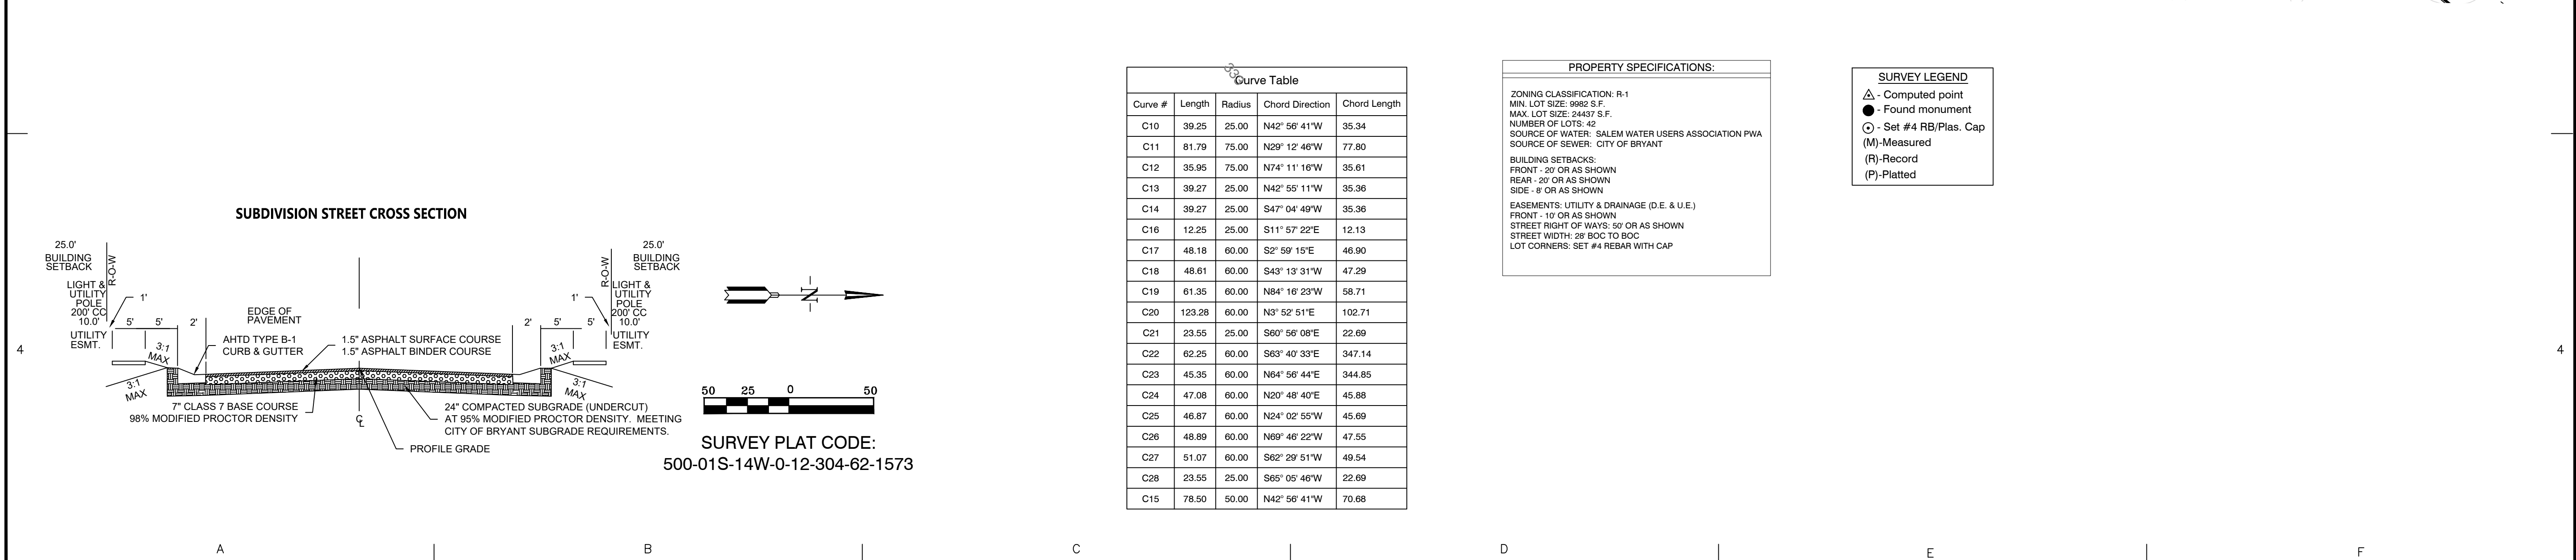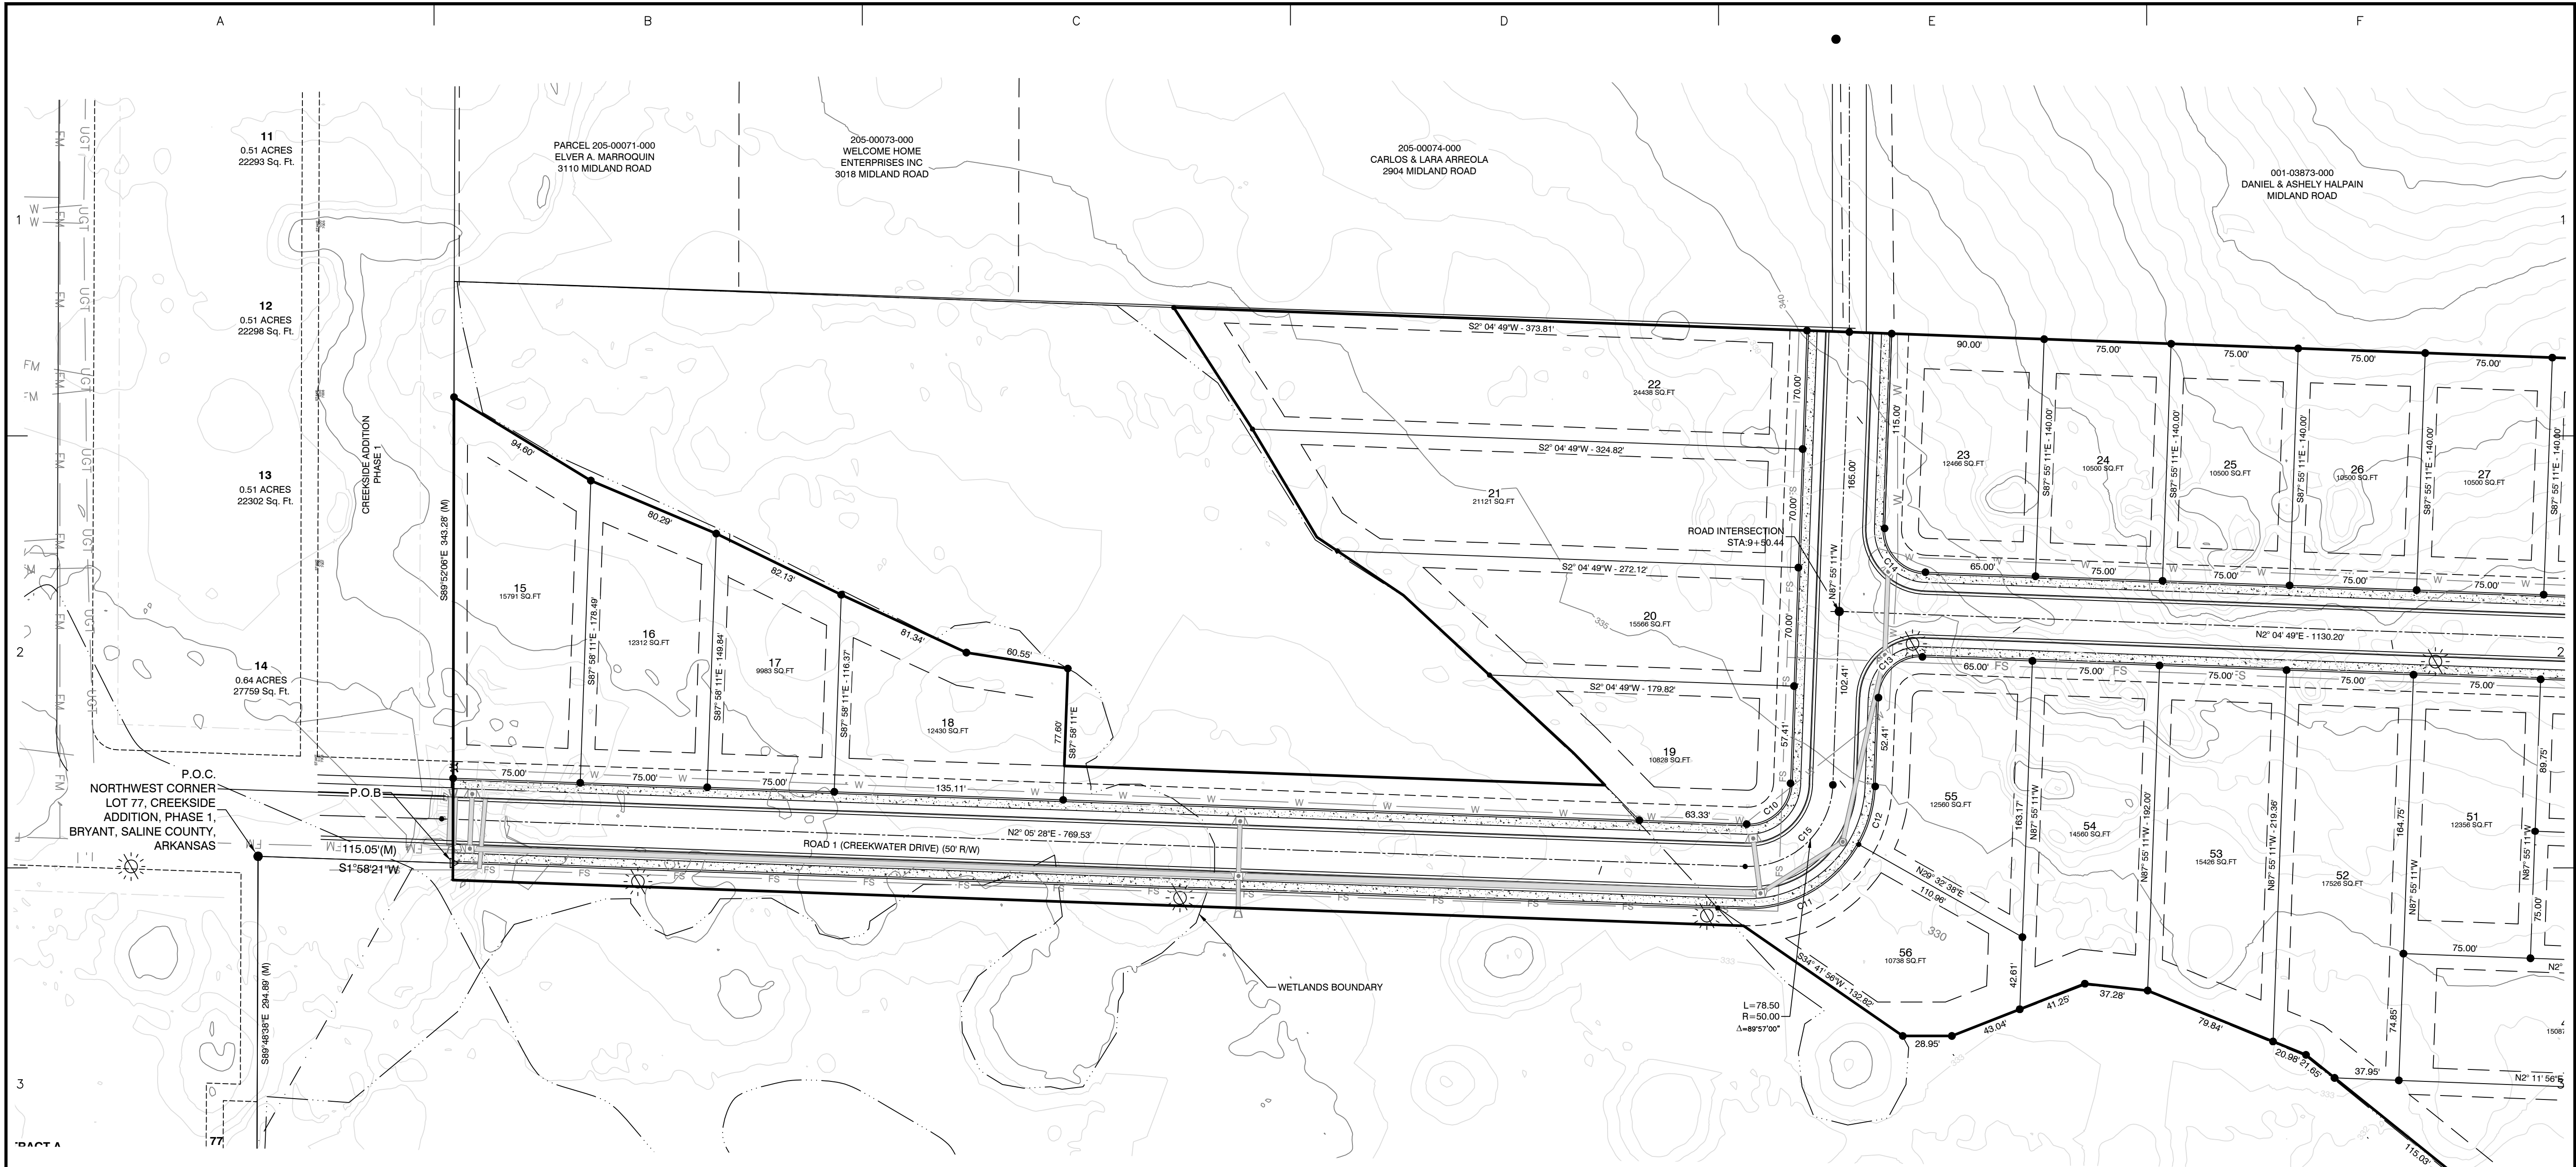

**Curve Table**

Curve #	Length	Radius	Chord Direction	Chord Length
C10	39.25	25.00	N42° 56' 41"W	35.34
C11	81.79	75.00	N29° 12' 46"W	77.80
C12	35.95	75.00	N74° 11' 16"W	35.61
C13	39.27	25.00	N42° 55' 11"W	35.36
C14	39.27	25.00	S47° 04' 49"W	35.36
C16	12.25	25.00	S11° 57' 22"E	12.13
C17	48.18	60.00	S2° 59' 15"E	46.90
C18	48.61	60.00	S43° 13' 31"W	47.29
C19	61.35	60.00	N84° 16' 23"W	58.71
C20	123.28	60.00	N3° 52' 51"E	102.71
C21	23.55	25.00	S60° 56' 08"E	22.69
C22	62.25	60.00	S63° 40' 33"E	347.14
C23	45.35	60.00	N64° 56' 44"E	344.85
C24	47.08	60.00	N20° 48' 40"E	45.88
C25	46.87	60.00	N24° 02' 55"W	45.69
C26	48.89	60.00	N69° 46' 22"W	47.55
C27	51.07	60.00	S62° 29' 51"W	49.54
C28	23.55	25.00	S65° 05' 46"W	22.69
C15	78.50	50.00	N42° 56' 41"W	70.68

**PROPERTY SPECIFICATIONS:**

ZONING CLASSIFICATION: R-1  
 MIN. LOT SIZE: 9662 S.F.  
 MAX. LOT SIZE: 24491 S.F.  
 NUMBER OF LOTS: 42  
 SOURCE OF WATER: SALEM WATER USERS ASSOCIATION PWA  
 SOURCE OF SEWER: CITY OF BRYANT

**BUILDING SETBACKS:**  
 FRONT - 20' OR AS SHOWN  
 REAR - 20' OR AS SHOWN  
 SIDE - 8' OR AS SHOWN

**EASEMENTS: UTILITY & DRAINAGE (D.E. & U.E.)**  
 FRONT - 10' OR AS SHOWN  
 STREET RIGHT OF WAYS: 50' OR AS SHOWN  
 STREET WIDTH: 28' BOC TO BOC  
 LOT CORNERS: SET #4 REBAR WITH CAP

**SURVEY LEGEND**


- △ - Computed point
- - Found monument
- - Set #4 RB/Plas. Cap
- (M) - Measured
- (R) - Record
- (P) - Platted

**SURVEY PLAT CODE:**  
 500-01S-14W-0-12-304-62-1573


BY		REVISION		DATE	
<p><b>GNE</b> Designing our client's success  <b>GarNat Engineering, LLC</b>        P.O. Box 116 (72018) Ph (501) 408-4650        3825 Mt. Carmel Road Fx (888) 900-3068        Bryant, AR 72022 gnatengineering@gmail.com</p>					
<p>CREEKSIDE ADDITION PHASE 2        ALL OF LOT 101 AND PART OF LOT 99        AND PART OF LOT 100, MIDLAND FARM SUBDIVISION        PART OF THE NE 1/4 NW 1/4, PART OF THE W 1/2 SE        1/4 NW 1/4 AND THE NW 1/4 NE 1/4 SW 1/4 ALL IN        SECTION 12, T-1-S, R-14-W,        SALINE COUNTY, ARKANSAS</p>					
DRAFT					
<p>CONTENTS:</p> <p>PRELIMINARY        PLAT        SOUTH HALF</p>					
<p>PROJECT NO:        18054</p>					
<p>DATE:        AUGUST 2022</p>					
<p>SHEET NO:  <span style="font-size: 2em; font-weight: bold;">2</span></p>					





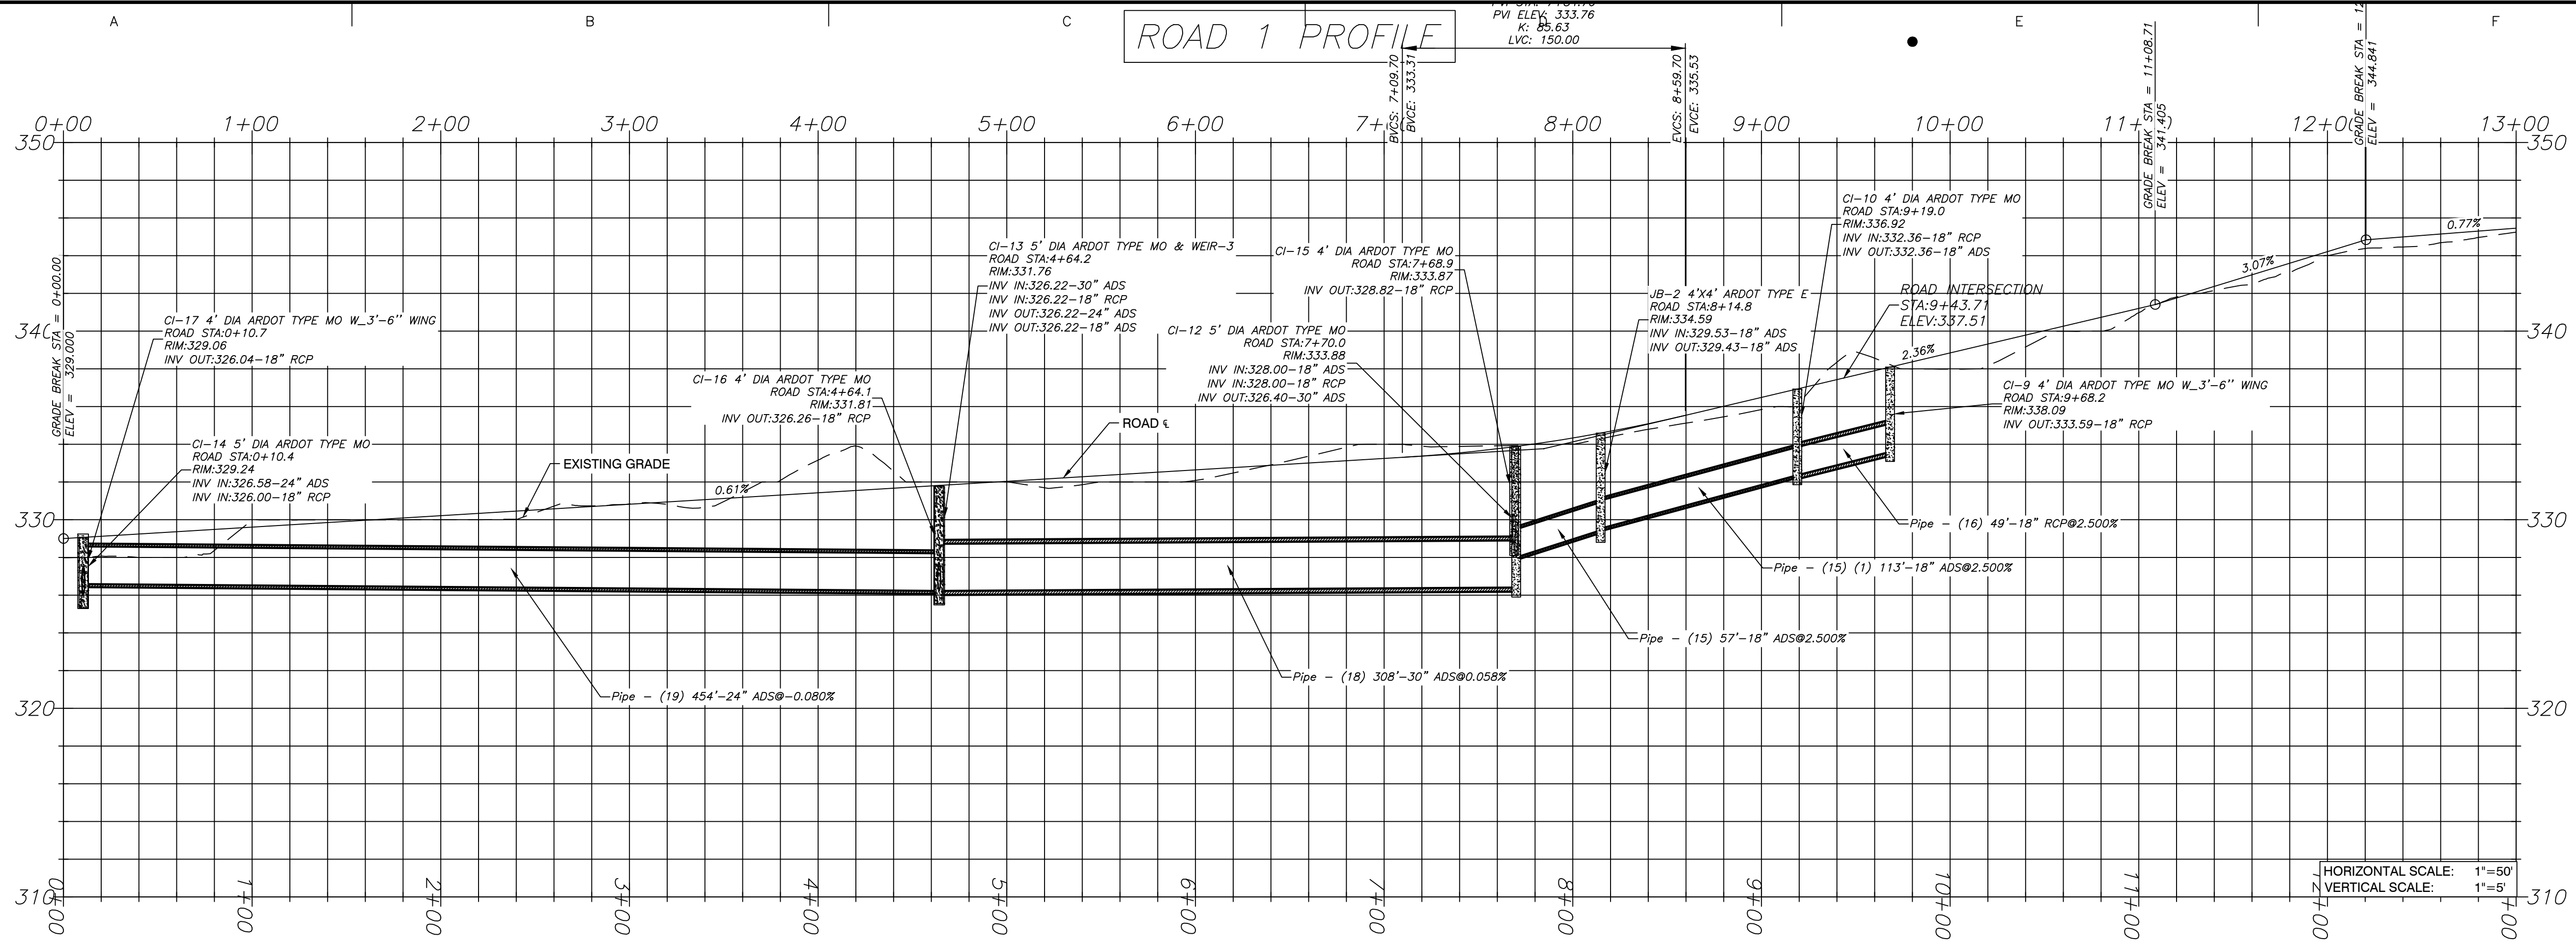

ROAD 1 PROFILE

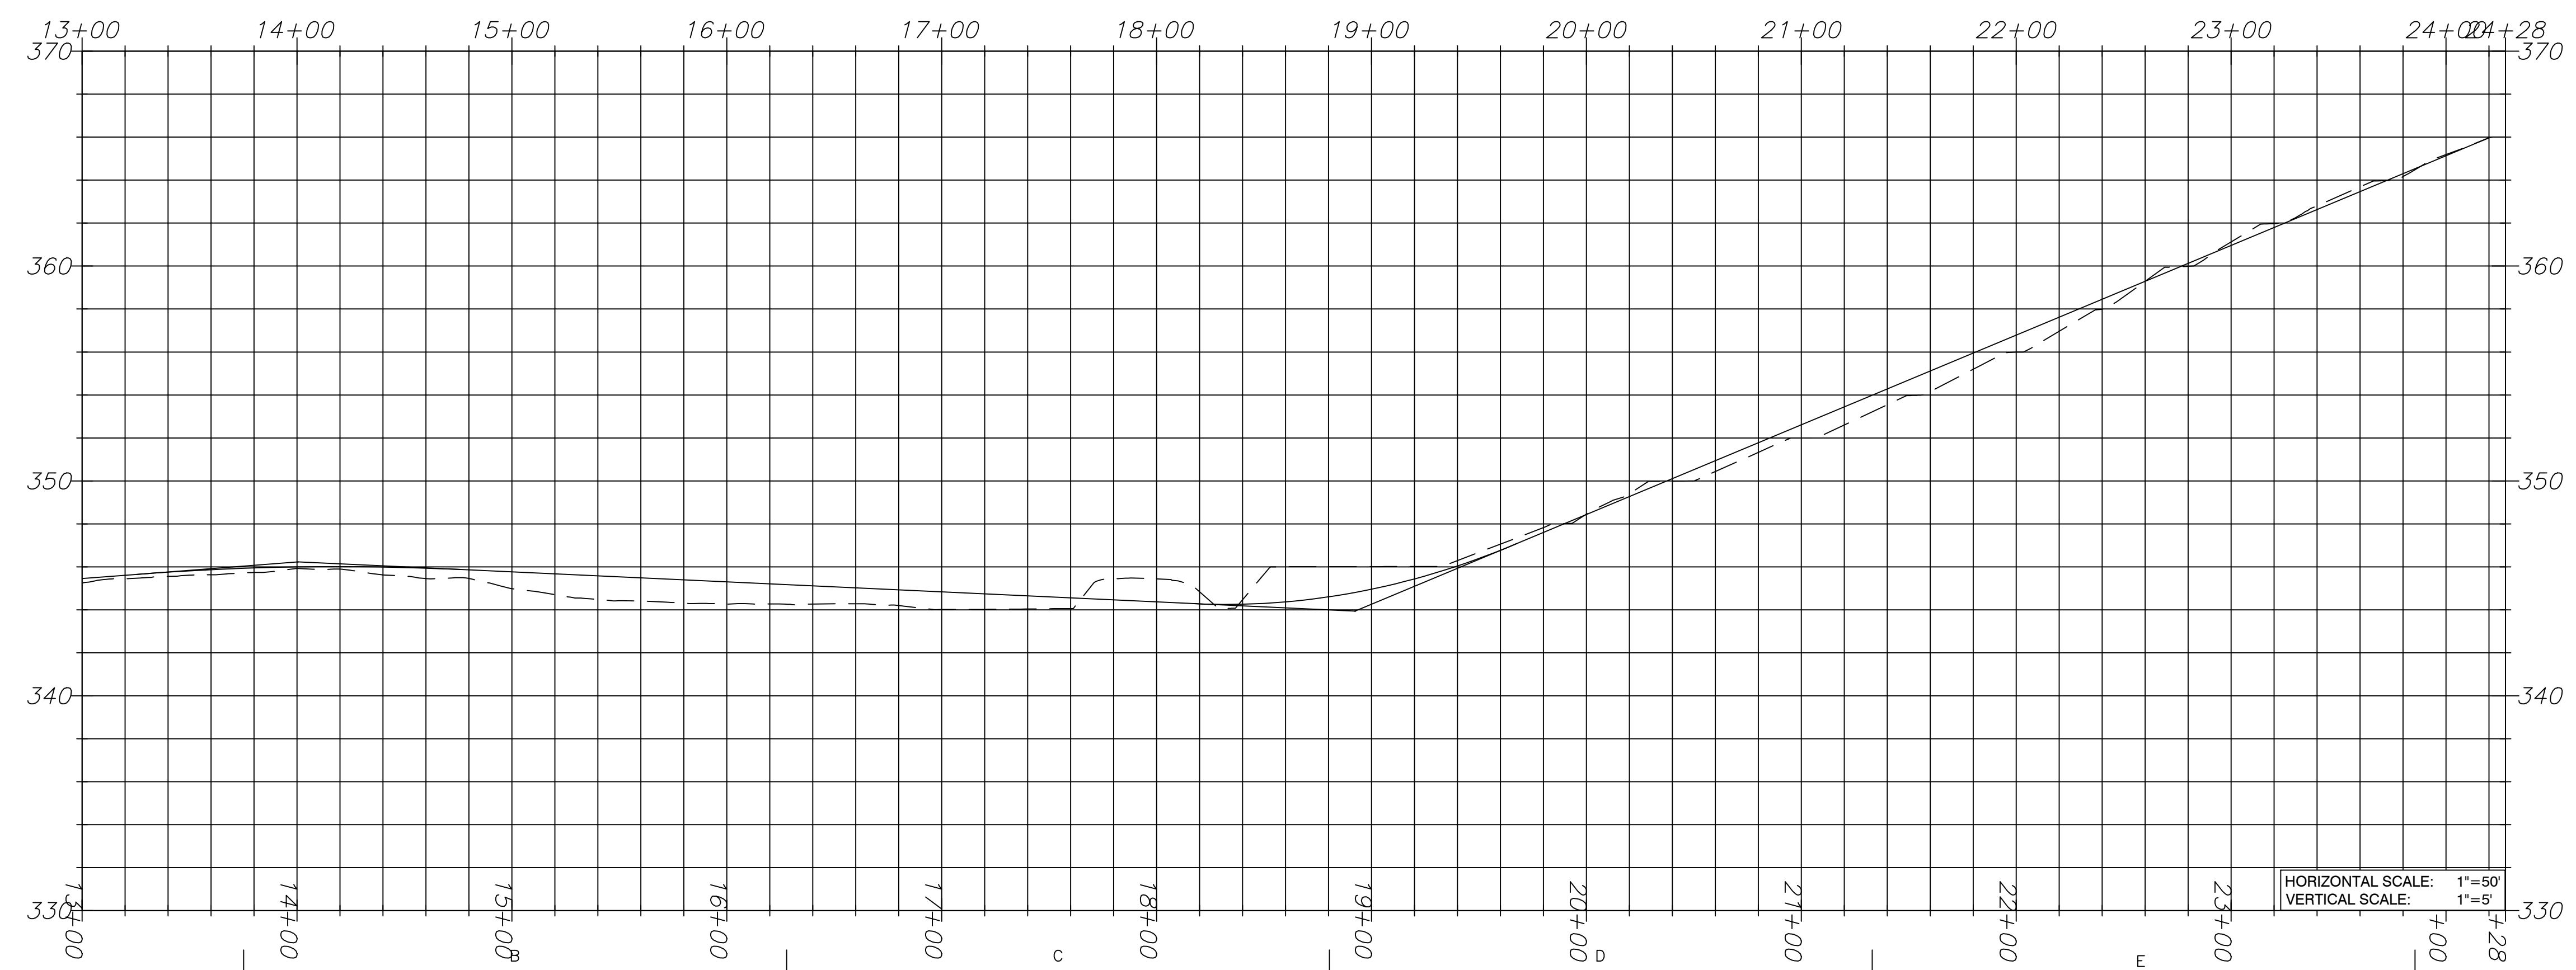

BY	REVISION	DATE
	1	

**GNE** Designing our client's success  
**GarNat Engineering, LLC**  
 P.O. Box 116 (72018)  
 2909 Military Rd  
 Benton, AR 72015  
 Ph (501) 408-4650  
 Fax (888) 900-3068  
 gnatengineering@gmail.com

CREEKSIDE ADDITION PHASE 2  
 ALL OF LOT 101 AND PART OF LOT 99  
 AND PART OF LOT 100, MIDLAND FARM SUBDIVISION  
 PART OF THE NE 1/4 NW 1/4, PART OF THE W 1/2 SE  
 1/4 NW 1/4 AND THE NW 1/4 NE 1/4 SW 1/4 ALL IN  
 SECTION 12, T-1-S, R-14-W,  
 SALINE COUNTY, ARKANSAS



08-10-2022

CONTENTS:  
 ROAD PROFILES


PROJECT NO:  
 18054

DATE:  
 JULY 2022


SHEET NO:  
 5




# ROAD 2 PROFILE

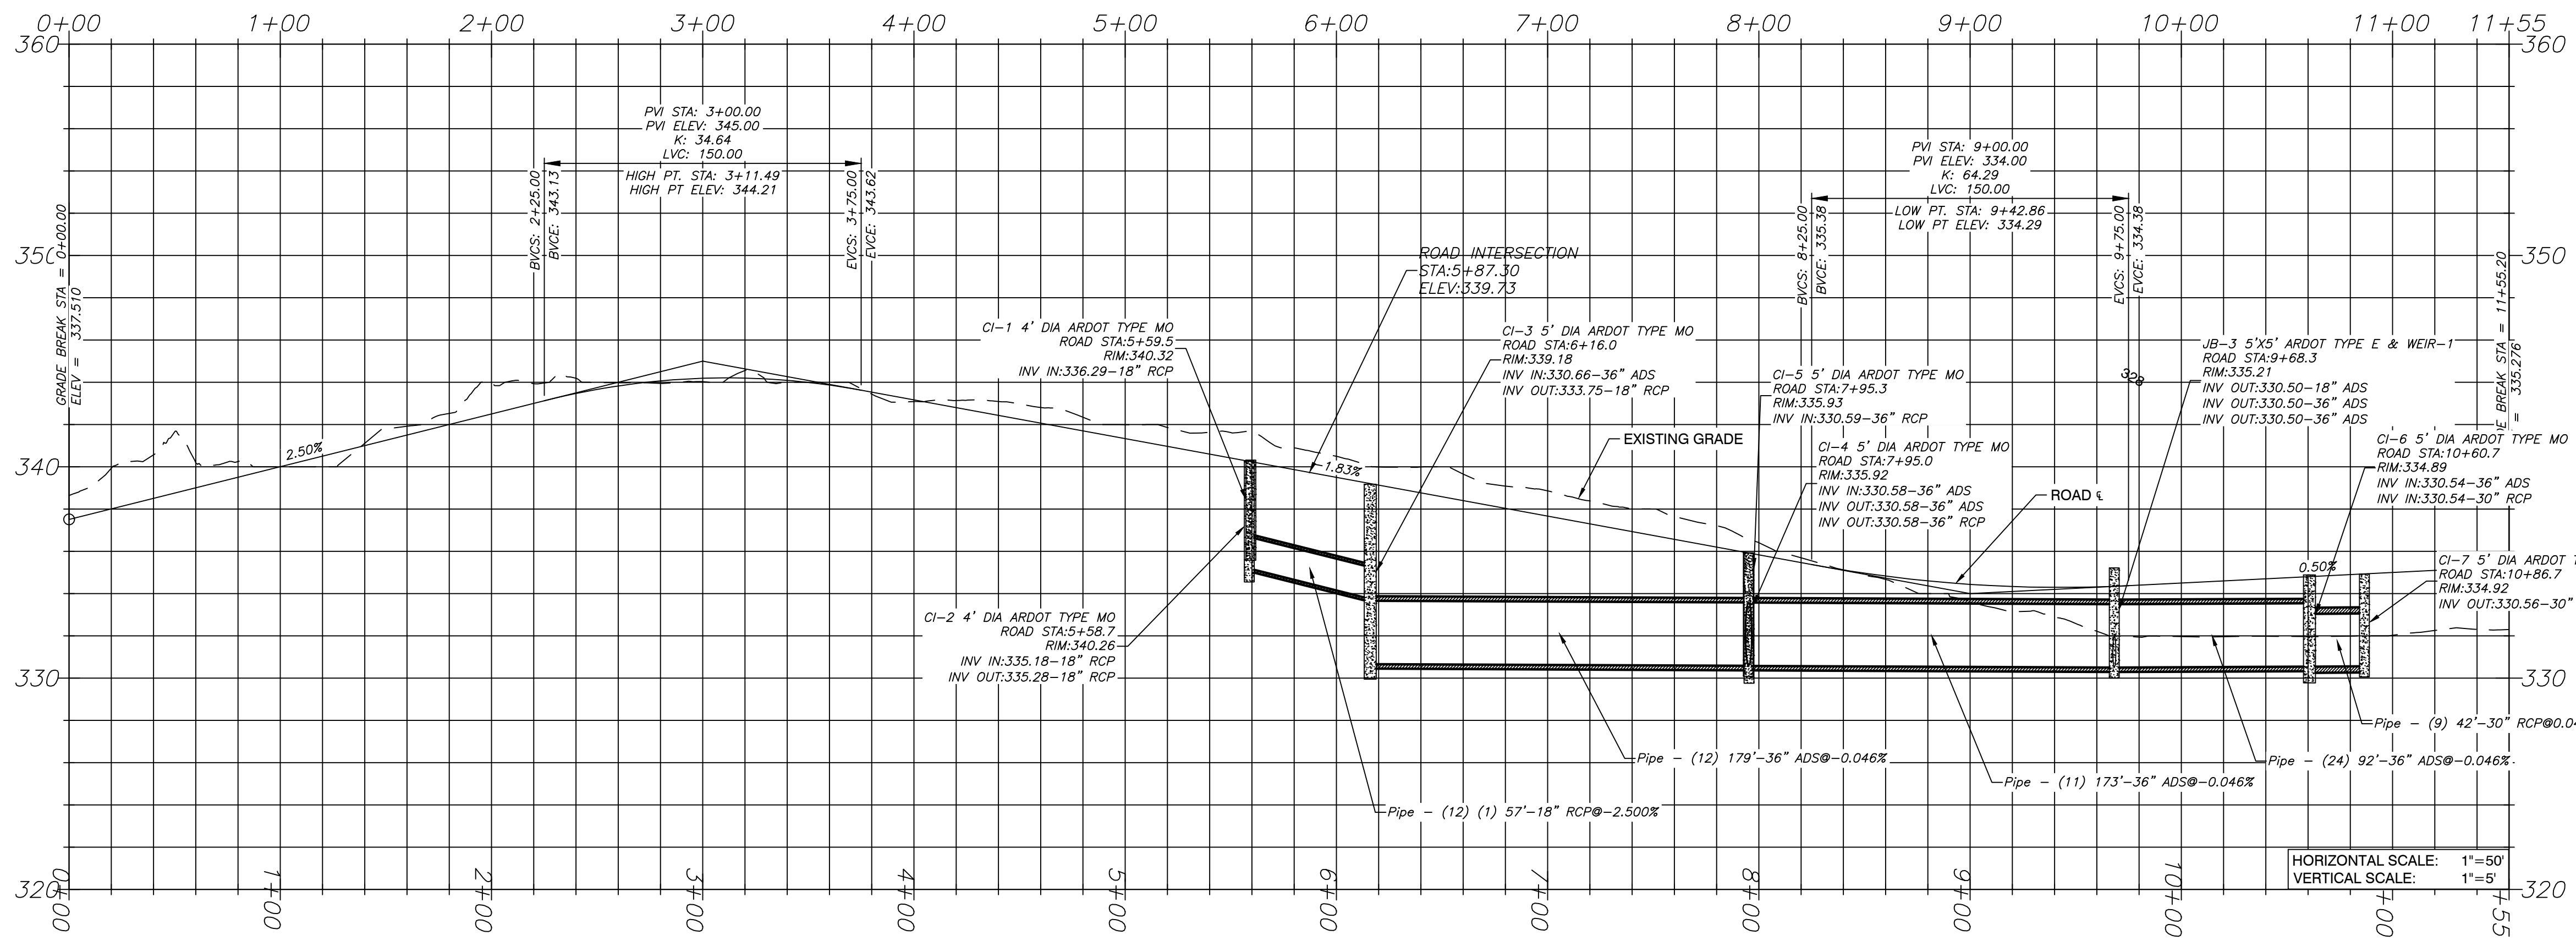


# ROAD 3 PROFILE

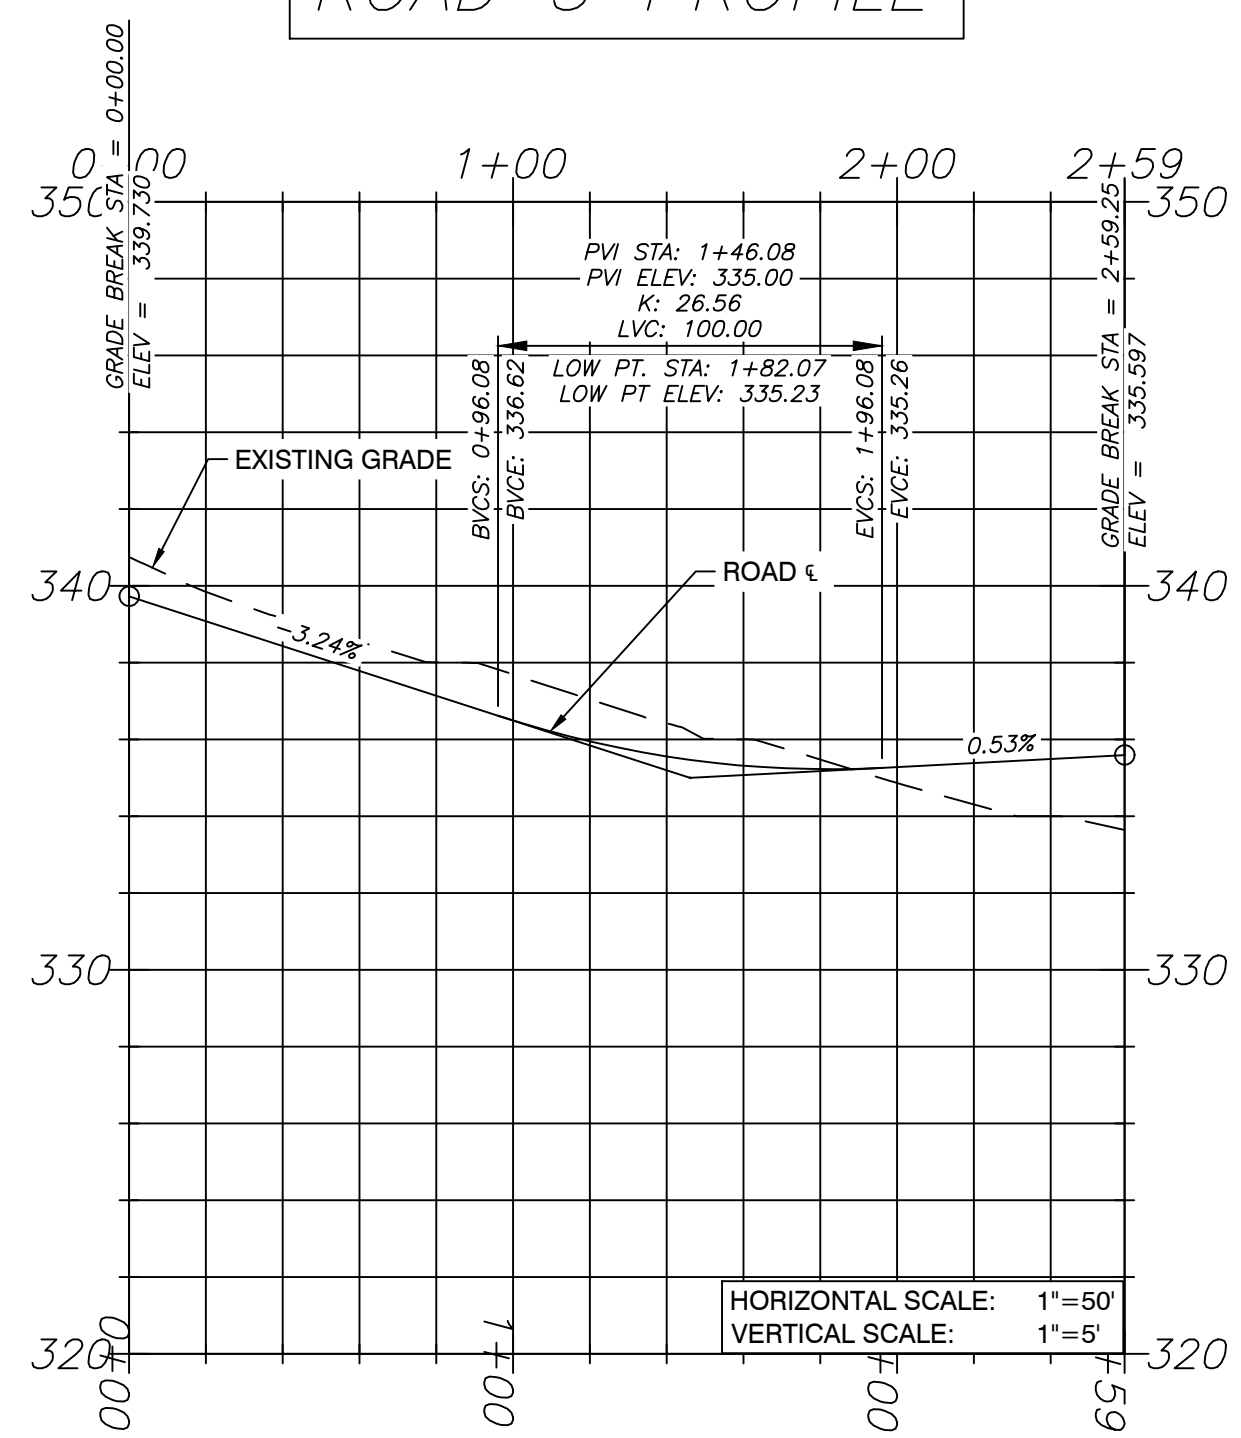

# EAST DETENTION PROFILE

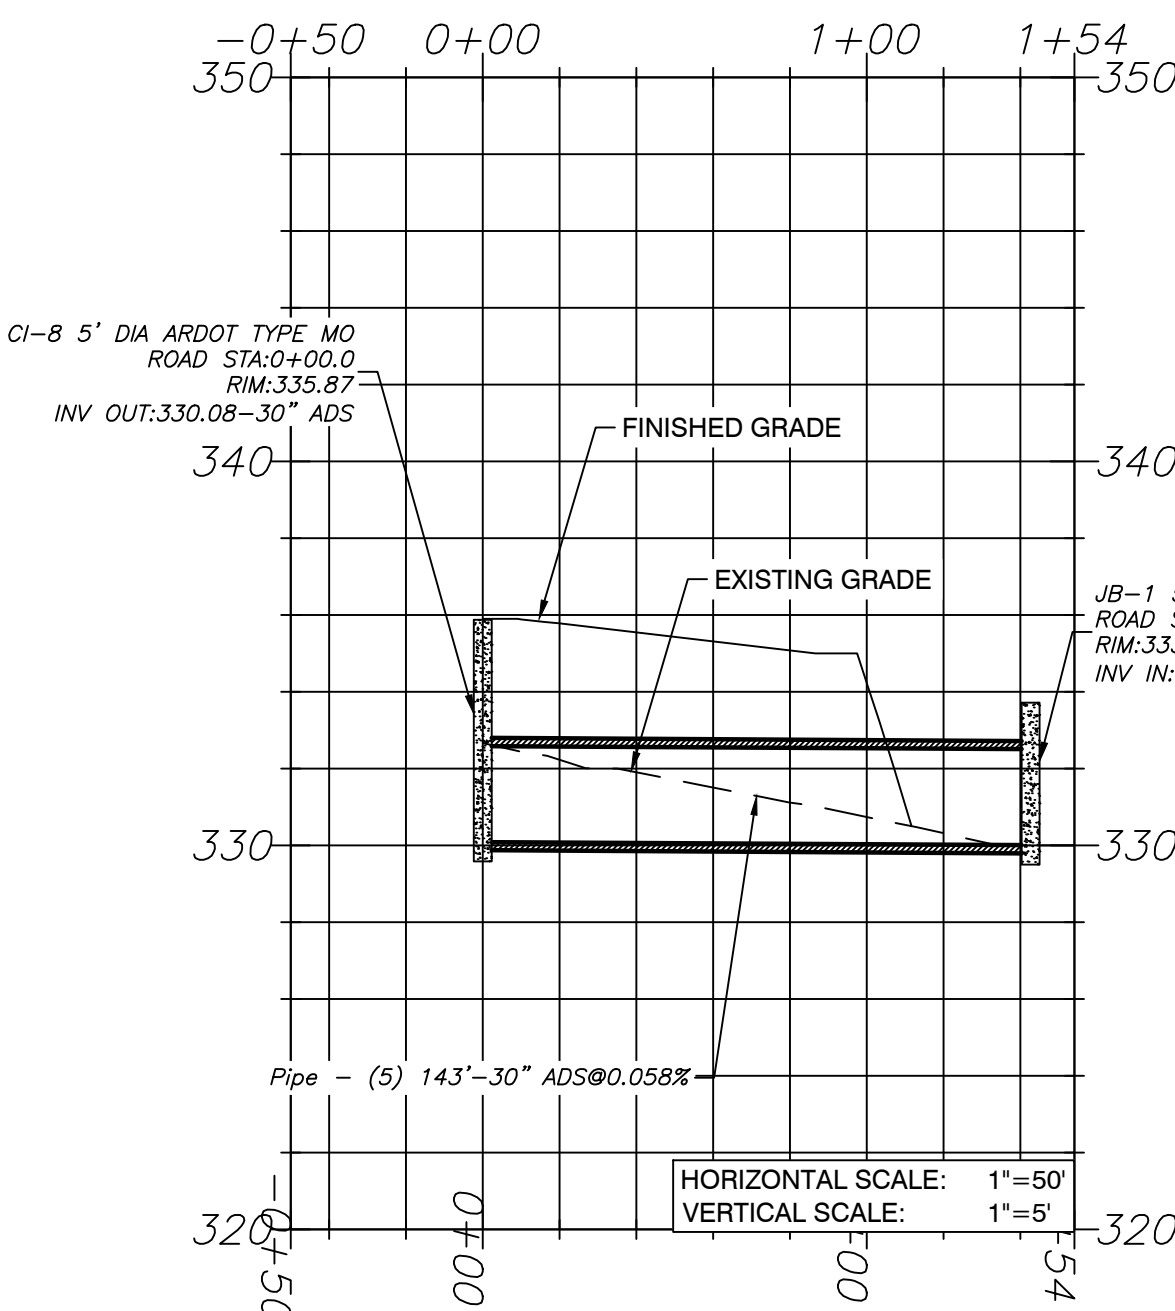

# DITCH CULVERT PROFILE

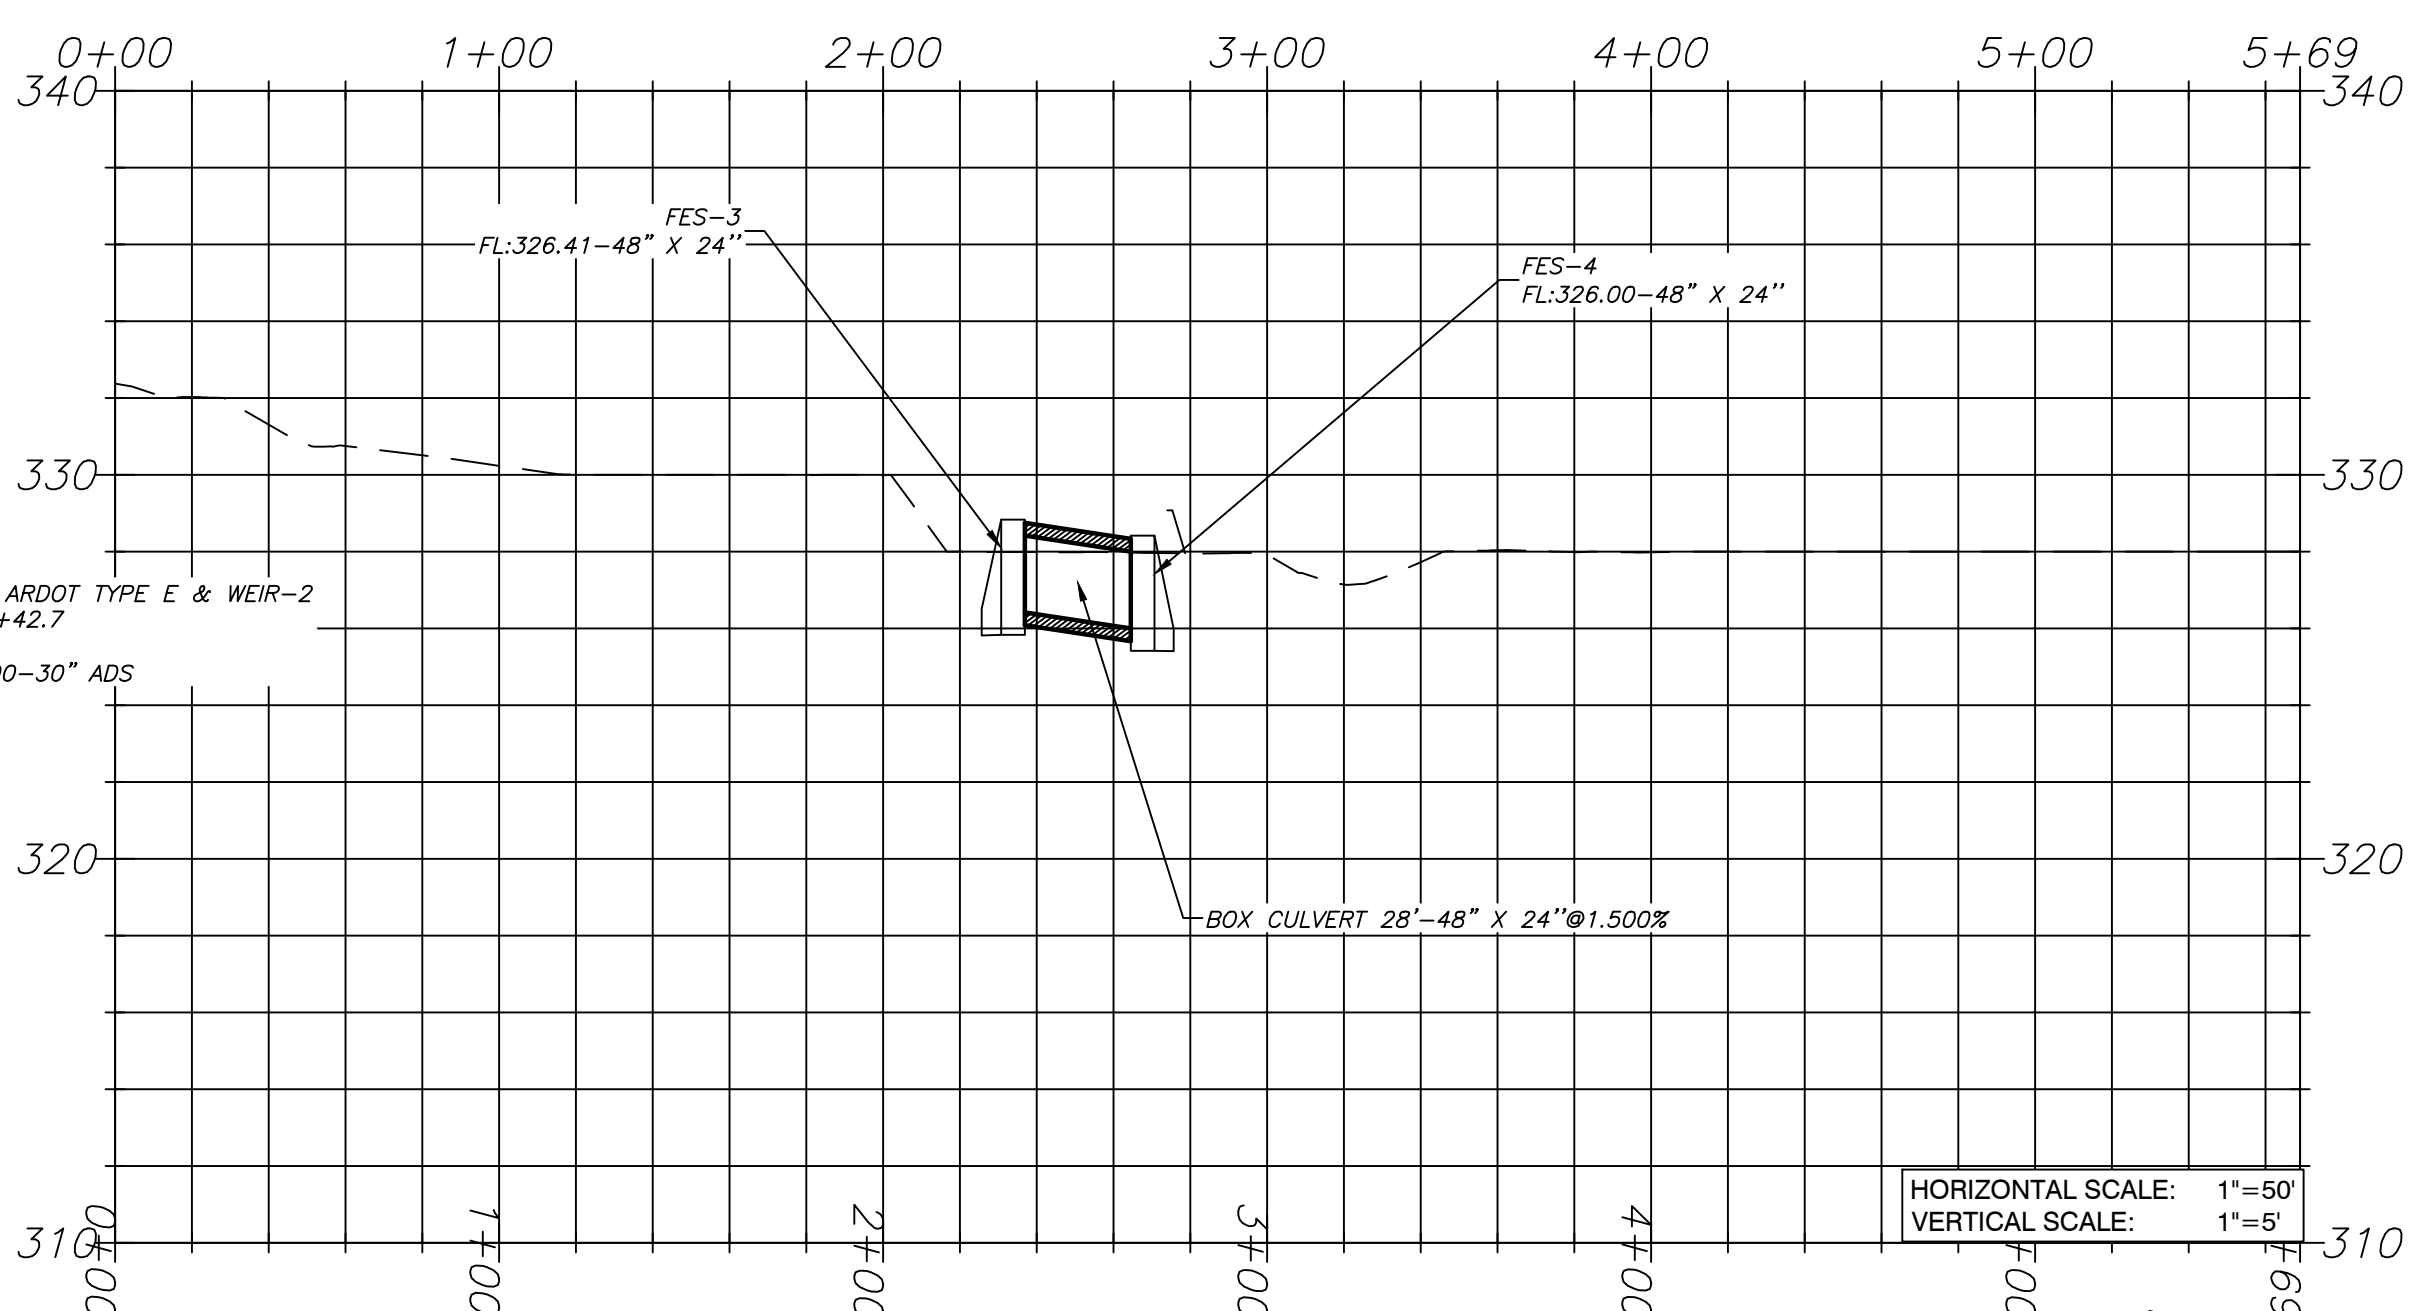

BY	REVISION	DATE
	1	

**GNE** Designing our client's success  
**GarNat Engineering, LLC**  
 Ph (501) 408-4650  
 P.O. Box 116 (72018)  
 2909 Military Rd  
 Benton, AR 72015  
 gnatengineering@gmail.com

CREEKSIDE ADDITION PHASE 2  
 ALL OF LOT 101 AND PART OF LOT 99  
 AND PART OF LOT 100, MIDLAND FARM SUBDIVISION  
 PART OF THE NE 1/4 NW 1/4, PART OF THE W 1/2 SE  
 1/4 NW 1/4 AND THE NW 1/4 NE 1/4 SW 1/4 ALL IN  
 SECTION 12, T-1-S, R-14-W,  
 SALINE COUNTY, ARKANSAS



08-10-2022


CONTENTS:  
**DRAINAGE PROFILES**

PROJECT NO:  
**18054**

DATE:  
**JULY 2022**

SHEET NO:  
**6**



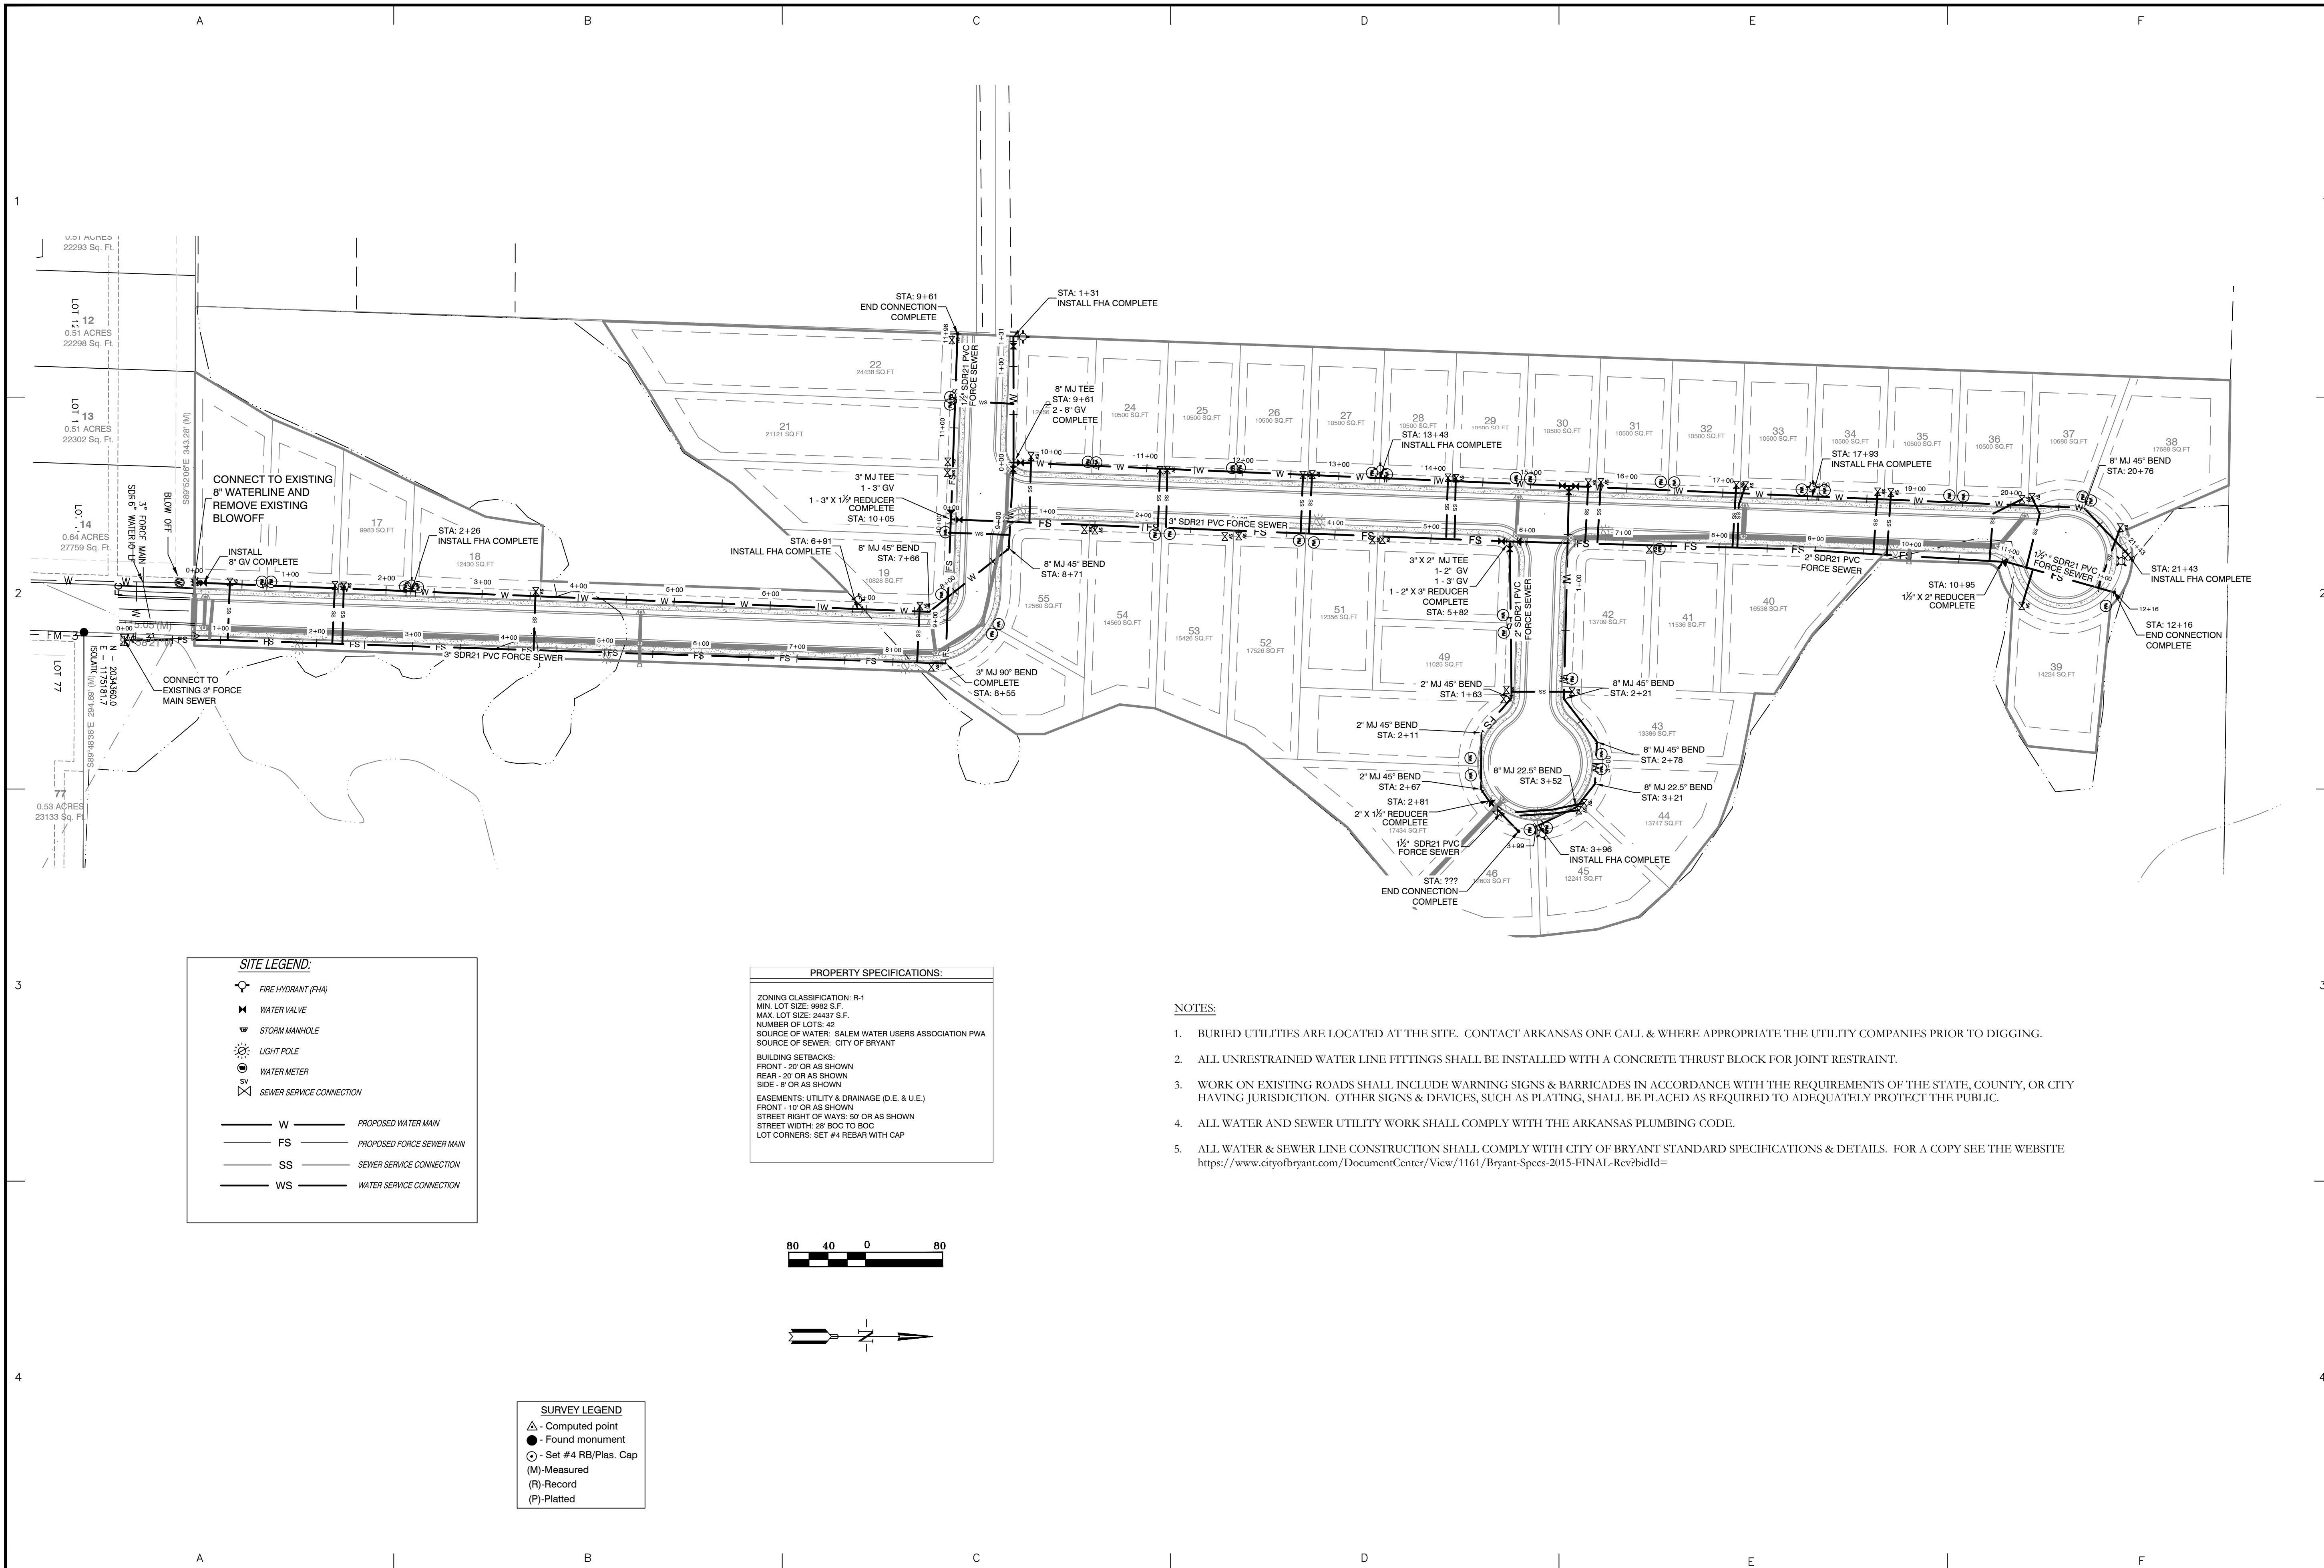

BY	REVISION	DATE

**GNE** Designing our client's success  
**GarNat Engineering, LLC**  
 Ph (501) 408-4650  
 P.O. Box 116 (72018)  
 3825 Mt. Carmel Road  
 Bryant, AR 72022  
 Fax (888) 900-3068  
 gnatengineering@gmail.com


CREEKSIDE ADDITION PHASE 2  
 ALL OF LOT 101 AND PART OF LOT 99  
 AND PART OF LOT 100, MIDLAND FARM SUBDIVISION  
 PART OF THE NE 1/4 NW 1/4, PART OF THE W 1/2 SE  
 1/4 NW 1/4 AND THE NW 1/4 NE 1/4 SW 1/4 ALL IN  
 SECTION 12, T-1-S, R-14-W,  
 SALINE COUNTY, ARKANSAS

**DRAFT**


CONTENTS:  
**WATER & SEWER UTILITY PLAN**

PROJECT NO:  
**18054**  
 DATE:  
**AUGUST 2022**  
 SHEET NO:  
**7**


J:\Projects\18054\18054 - Creekside Addition\Drawings\DWG\18054 - Creekside Addition\Drawings\Phase 2\02 - UTILITY PLAN.dwg

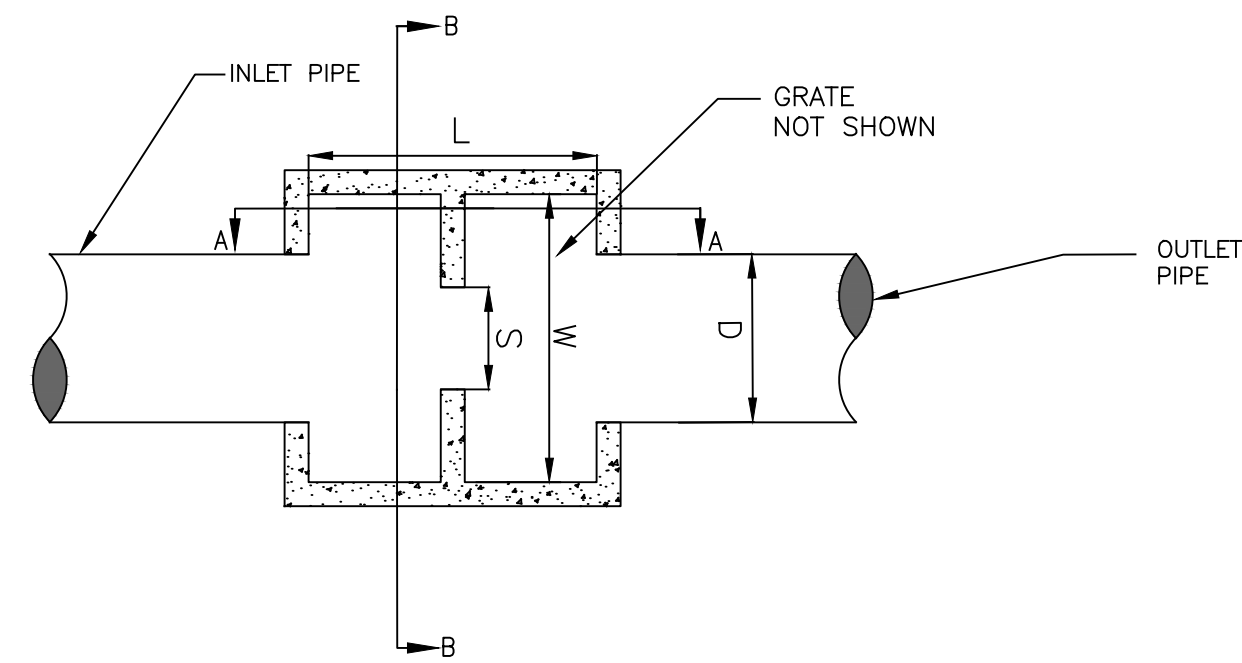


**OUTLET STRUCTURE - WEIR 1 AND 3**  
**PLAN VIEW**  
 NOT TO SCALE

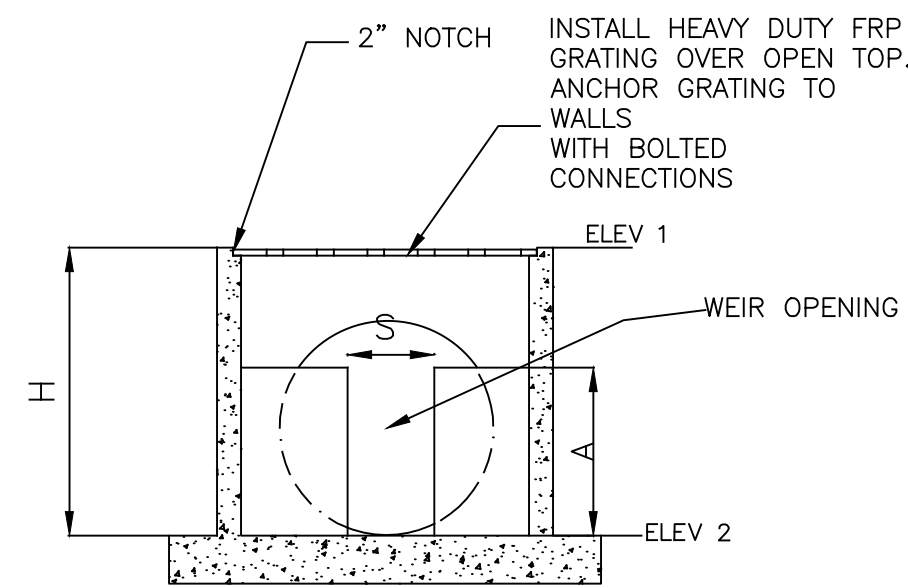


**OUTLET STRUCTURE - WEIR 1 AND 3**  
**SECTION B-B**  
 NOT TO SCALE

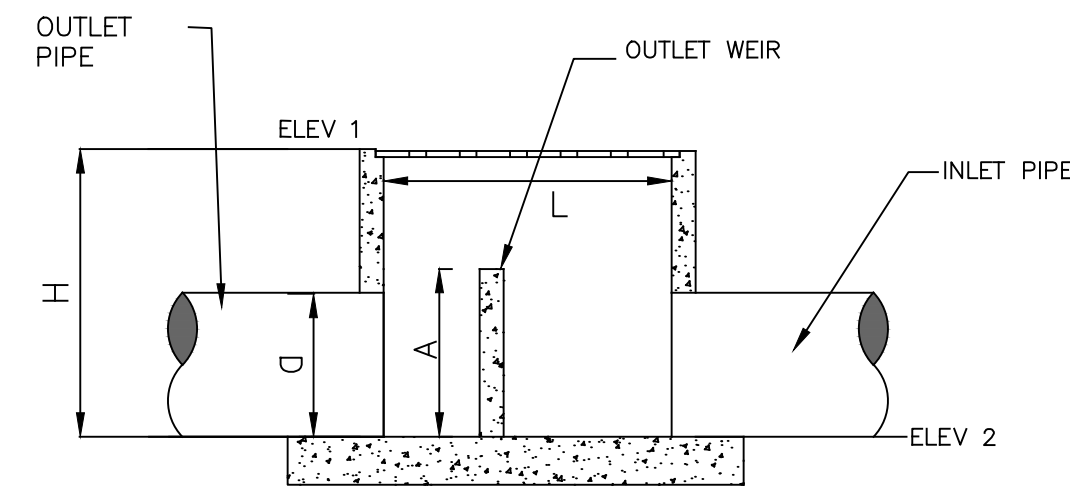


**OUTLET STRUCTURE - WEIR 1 AND 3**  
**SECTION A-A**  
 NOT TO SCALE

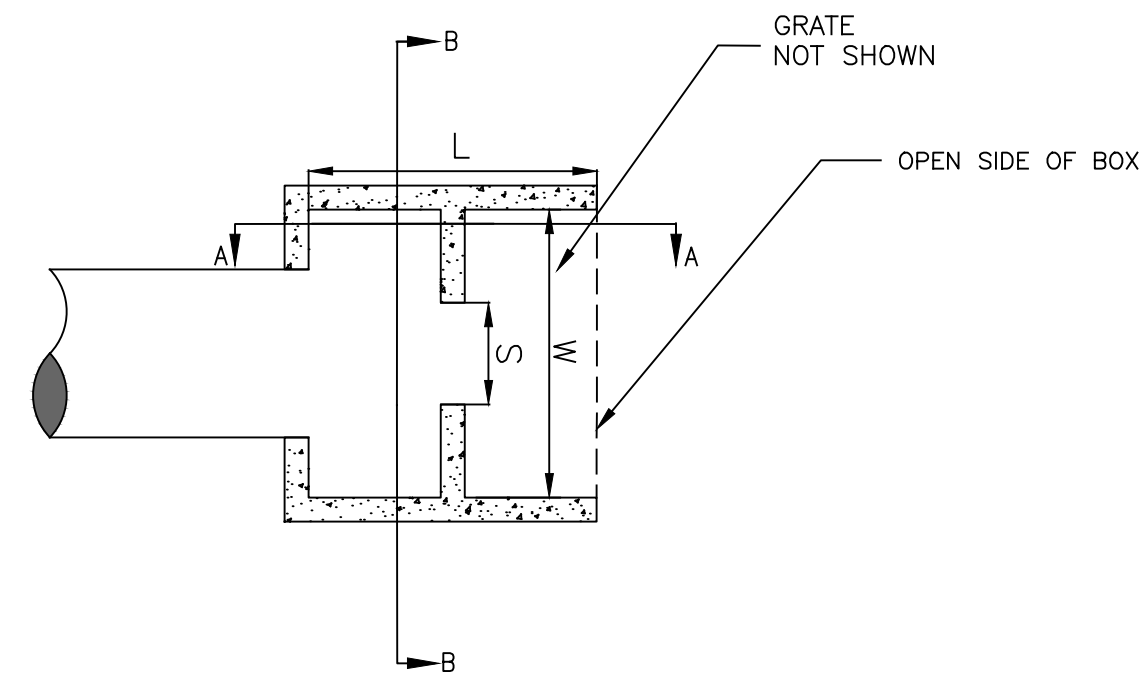

**OUTLET STRUCTURE - WEIR 2**  
**PLAN VIEW**  
 NOT TO SCALE

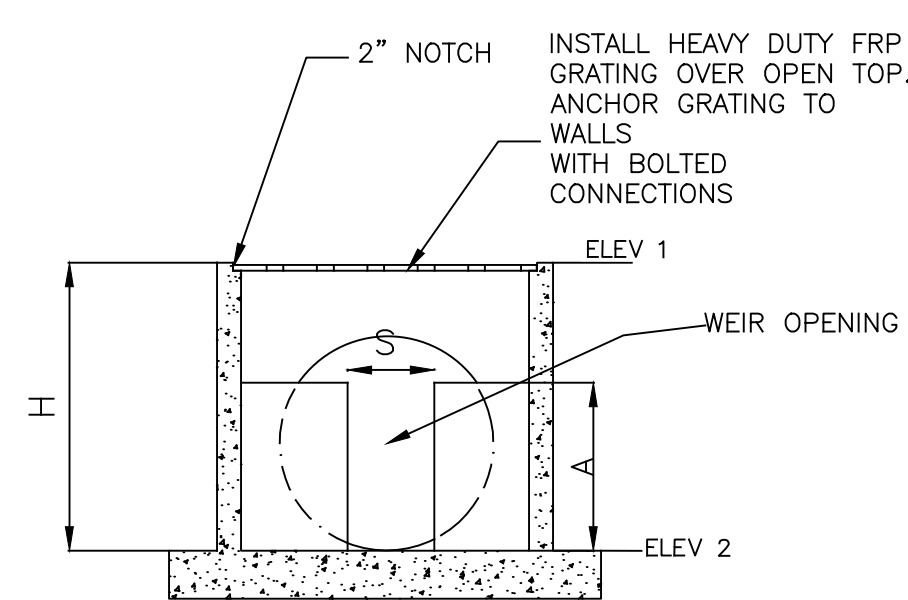

**OUTLET STRUCTURE - WEIR 2**  
**SECTION B-B**  
 NOT TO SCALE

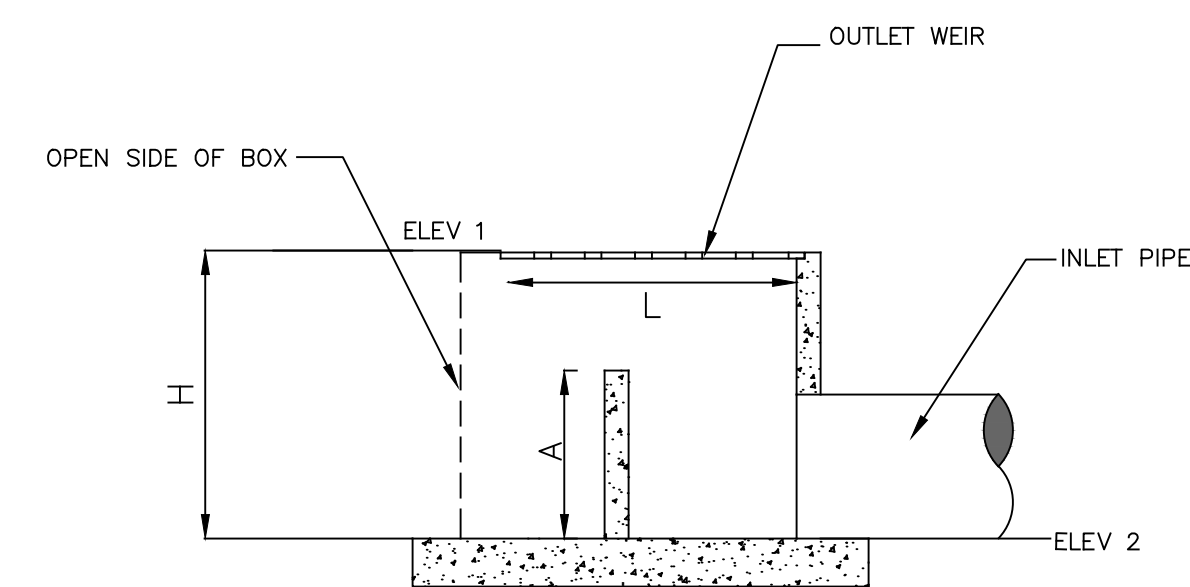

**OUTLET STRUCTURE - WEIR 2**  
**SECTION A-A**  
 NOT TO SCALE

OUTLET STRUCTURE								
OUTLET STRUCTURE	L	W	H	ELEV 1	ELEV 2	S	A	D
WEIR #1	4'-0"	4'-0"	4'-8"	335.20	330.50	1'-3"	3'-0"	18"
WEIR #2	4'-0"	4'-0"	3'-9"	333.75	330.00	0'-3"	2'-6"	
WEIR #3	4'-0"	4'-0"	5'-6"	331.81	326.22	1'-6"	2'-6"	18"

- DETENTION OUTLET NOTES:**
- ALL CONCRETE WALLS SHALL BE A MINIMUM OF 6" THICK & REINFORCED WITH #4S @ 12" O.C. BOTH WAYS.
  - BOTTOM SLAB SHALL BE 12" THICK & REINFORCED WITH #4S @ 12" O.C. BOTH WAYS.

REVISION	DATE	BY

**GNE** Designing our client's success  
**GarNat Engineering, LLC**  
 3825 Mt Carmel Rd  
 Bryant, AR 72022  
 P.O. Box 116  
 Benton, AR 72018  
 Ph: (501) 408-4650  
 gnatengineering@gmail.com

**CREEKSIDE SUBDIVISION  
 PHASE 2  
 BRYANT, ARKANSAS**



08-10-2022



CONTENTS:  
**OUTLET STRUCTURE DETAILS**

PROJECT NO:  
**18054**

DATE:  
**AUGUST 2022**

SHEET NO:  
**8**

# PRELIMINARY PLAT CREEKSIDE ADDITION PHASE 2 SALINE COUNTY, ARKANSAS

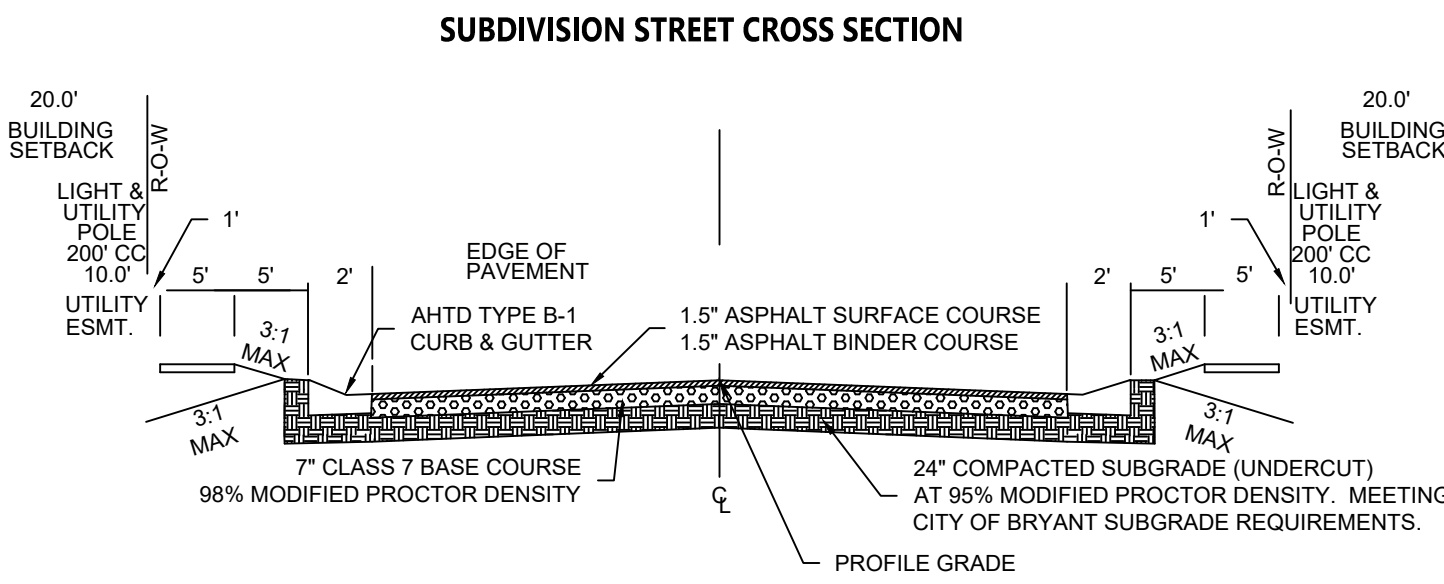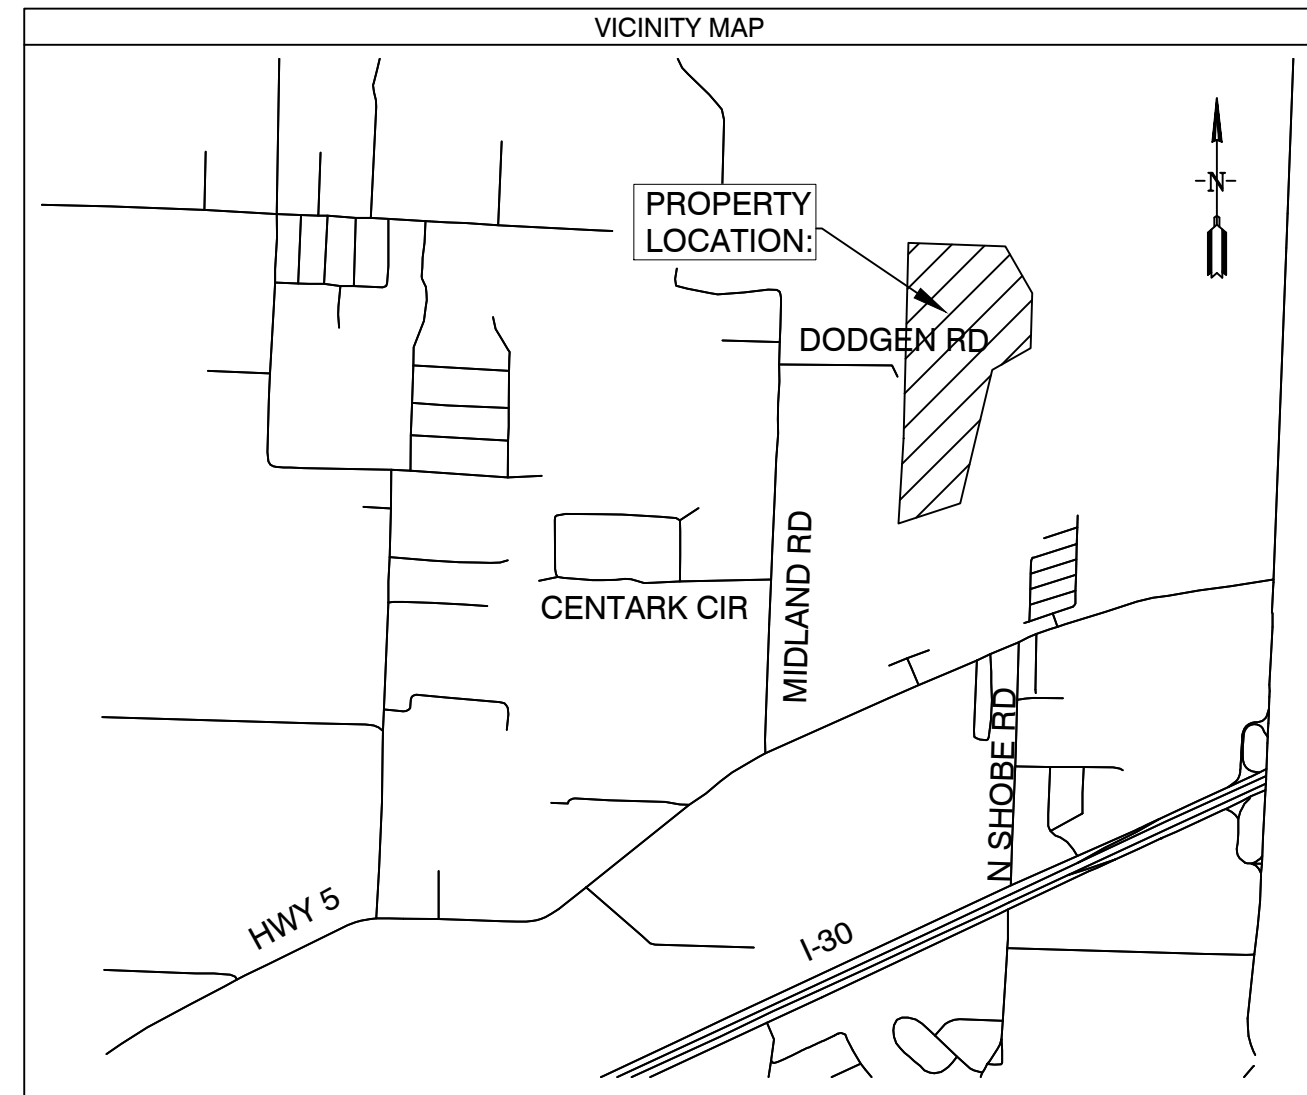

Line #	Length	Direction
L1	26.63	S45° 37' 43\"W
L2	67.59	S42° 51' 15\"W
L3	69.25	S42° 51' 15\"W
L4	61.55	S33° 56' 28\"W
L5	74.18	S59° 11' 07\"W
L6	85.44	S57° 05' 38\"W
L7	45.43	S61° 02' 07\"W
L8	20.44	S2° 04' 49\"W
L9	75.92	S78° 58' 48\"E
L10	68.17	S70° 19' 12\"E
L11	82.17	S51° 58' 45\"E
L12	43.85	S41° 47' 58\"E
L13	44.83	S16° 41' 28\"E
L14	59.73	S6° 28' 58\"E
L15	61.47	S0° 55' 57\"E
L16	67.51	S19° 41' 07\"W
L17	118.71	S50° 16' 07\"W
L18	136.69	S38° 51' 03\"W
L19	100.82	S22° 07' 30\"W
L20	37.28	S6° 12' 28\"W

Line #	Length	Direction
L21	41.25	S21° 27' 38\"E
L22	43.04	S21° 27' 38\"E
L23	28.95	S0° 00' 17\"W
L24	114.30	S34° 41' 56\"W
L25	10.01	N89° 52' 05\"W

**PROPERTY DESCRIPTION:**  
PART OF THE EAST HALF OF THE NORTHWEST QUARTER ALL IN SECTION 12, TOWNSHIP 1 SOUTH, RANGE 14 WEST, SALINE COUNTY, ARKANSAS, DESCRIBED AS FOLLOWS:

COMMENCING AT THE NORTHWEST CORNER OF LOT 77 OF THE CREEK SIDE ADDITION, PHASE 1 TO THE CITY OF BRYANT, SALINE COUNTY, ARKANSAS AND RUN THENCE NORTH 1°58'21\" EAST ALONG THE EAST LINE OF CREEK WATER DRIVE A DISTANCE OF 115.05 FEET TO THE POINT OF BEGINNING; THENCE NORTH 89°52'06\" WEST ALONG THE NORTH LINE OF SAID CREEKSIDE ADDITION, PHASE 1, A DISTANCE OF 275.01 FEET; THENCE NORTH 31°22'58\" EAST 94.60 FEET; NORTH 22°58'11\" EAST 80.29 FEET; NORTH 26°04'51\" EAST 82.13 FEET; NORTH 24°48'10\" EAST 81.34 FEET; NORTH 8°56'14\" EAST 60.55 FEET; SOUTH 87°58'11\" EAST 57.60 FEET; NORTH 2°01'49\" EAST 319.19 FEET; SOUTH 45°37'43\" WEST 26.63 FEET; SOUTH 42°51'15\" WEST 67.59 FEET; SOUTH 42°51'15\" WEST 69.25 FEET; SOUTH 33°56'28\" WEST 61.55 FEET; SOUTH 59°11'07\" WEST 74.18 FEET; SOUTH 57°05'38\" WEST 85.44 FEET TO A POINT ON THE WEST LINE OF SAID E 1/2 NW 1/4; THENCE NORTH 2°04'49\" EAST ALONG THE WEST LINE OF SAID E 1/2 NW 1/4 A DISTANCE OF 1694.30 FEET TO THE NORTH WEST CORNER OF THE NORTHWEST QUARTER OF SAID SECTION 12; THENCE SOUTH 89°14'31\" EAST ALONG THE NORTH LINE OF SAID NE 1/4 NW 1/4 A DISTANCE OF 109.53 FEET; THENCE SOUTH 23°32'08\" EAST 116.13 FEET TO THE START OF A CURVE TO THE LEFT THENCE 86.62 FEET ALONG THE ARC OF A CURVE HAVING A RADIUS OF 70.0', SAID CURVE HAVING A CHORD BEARING & DISTANCE OF SOUTH 78°06'51\" EAST 81.20 FEET; THENCE SOUTH 84°18'55\" EAST 153.41 FEET; SOUTH 5°41'05\" WEST 71.66 FEET; SOUTH 61°02'07\" WEST 45.43 FEET; NORTH 86°35'33\" WEST 113.34 FEET TO THE START OF A CURVE TO THE LEFT; THENCE 29.41 FEET ALONG THE ARC OF A CURVE HAVING RADIUS OF 70.0', SAID CURVE HAVING A CHORD BEARING & DISTANCE OF SOUTH 62°56'29\" WEST 29.19 FEET; THENCE ALONG THE ARC OF ANOTHER CURVE HAVING A RADIUS OF 15.00' TO THE LEFT A DISTANCE OF 19.08 FEET, SAID CURVE HAVING A CHORD BEARING AND DISTANCE OF SOUTH 38°31'41\" WEST 17.82 FEET; THENCE SOUTH 2°04'49\" WEST 112.09 FEET; THENCE SOUTH 48°25'26\" EAST 103.75 FEET; SOUTH 57°22'48\" EAST 74.02 FEET; SOUTH 2°04'49\" WEST 20.44 FEET; SOUTH 78°58'48\" EAST 75.92 FEET; SOUTH 70°19'12\" EAST 68.17 FEET; SOUTH 51°58'45\" EAST 82.17 FEET; SOUTH 41°47'58\" EAST 43.85 FEET; SOUTH 16°41'28\" EAST 44.83 FEET; SOUTH 6°28'58\" EAST 59.73 FEET; SOUTH 0°55'57\" EAST 61.47 FEET; SOUTH 19°41'07\" WEST 67.51 FEET; SOUTH 50°16'07\" WEST 118.71 FEET; SOUTH 38°51'03\" WEST 136.69; SOUTH 22°07'30\" WEST 100.82 FEET; SOUTH 6°12'28\" WEST 37.28 FEET; SOUTH 21°27'38\" EAST 41.25 FEET; SOUTH 21°27'38\" EAST 43.04 FEET; SOUTH 0°01'17\" WEST 28.95 FEET; SOUTH 34°41'56\" WEST 114.30 FEET; SOUTH 2°01'49\" WEST FOR 761.91 FEET; THENCE NORTH 89°52'05\" WEST 10.01 FEET TO THE POINT OF BEGINNING, CONTAINING 16.17 ACRES MORE OR LESS.

Curve #	Length	Radius	Chord Direction	Chord Length
C1	86.62	70.00	S78° 06' 51\"E	81.20
C2	29.41	70.00	S62° 56' 29\"W	29.19
C3	19.08	15.00	S38° 31' 41\"W	17.82

**DOCUMENTS USED:**

- SURVEY PLAT OF RECORD RASBERRY SURVEYING 10/23/2014
- DEED OF RECORD 2014 PAGE 25641 WILLIAMS TO DIAMOND DEVELOPMENT II
- DEED OF RECORD 2004 PAGE 112595 THOMAS TO DIAMOND DEVELOPMENT II
- SURVEY PLAT OF RECORD MIDLAND FARM SUBDIVISION BY HENRY N. CONWAY 8/13/1951

**BASIS OF BEARINGS:**

BENCHMARK(S) PROVIDED ARE REBAR AND COORDINATES ON BENCHMARKS ARE NORTH AMERICAN DATUM 1983, ARKANSAS SOUTH ZONE, US SURVEY FEET, GRID COORDINATES AND ELEVATIONS ARE NAVD 1988. COORDINATES AND ELEVATIONS WERE ESTABLISHED USING GPS AND WERE PROCESSED USING THE NATIONAL GEODETIC SURVEYS' "ONLINE POSITIONING USER SERVICE" (OPUS).

**PLAT CERTIFICATES:**

**OWNER:** Name: Diamond Development II, Address: 1599 Lawson Oaks, Little Rock, AR 72210

**DEVELOPER:** Name: Diamond Development II, Address: 1599 Lawson Oaks, Little Rock, AR 72210

**CERTIFICATE OF RECORDING:**

**CERTIFICATE OF OWNER:** We, the undersigned, owners of the real estate shown and described herein do hereby certify that we have laid off, platted and subdivided, and do hereby lay off, plat and subdivide said real estate in accordance with the within plat.

**CERTIFICATE OF PRELIMINARY SURVEYING ACCURACY:** I, George P. Wooden, hereby certify that this proposed preliminary plat correctly represents a boundary survey made by me or under my supervision on 6/07/2022; that the boundary lines shown hereon correspond with the description in the deeds cited in the above Source of Title; and that all monuments which were found or placed on the property are correctly described and located.

**CERTIFICATE OF PRELIMINARY ENGINEERING ACCURACY:** I, Vernon J. Williams, hereby certify that this plat correctly represents a survey and a plan made by me or under my supervision; that all monuments shown hereon actually exist and their locations, size, type, and material are correctly shown; and that all requirements of the City of Bryant Subdivision Rules and Regulations have been fully complied with.

**CERTIFICATE OF PRELIMINARY PLAT APPROVAL:** All requirements of the City of Bryant Subdivision Rules and Regulations relative to the preparation and submittal of a Preliminary Plat having been fulfilled, approval of this plat is hereby granted, subject to further provisions of said Rules and Regulations.



**PROPERTY SPECIFICATIONS:**

ZONING CLASSIFICATION: R-1  
MIN. LOT SIZE: 9982 S.F.  
MAX. LOT SIZE: 24437 S.F.  
NUMBER OF LOTS: 42  
SOURCE OF WATER: SALEM WATER USERS ASSOCIATION PWA  
SOURCE OF SEWER: CITY OF BRYANT

**BUILDING SETBACKS:**  
FRONT: 20' OR AS SHOWN  
REAR: 20' OR AS SHOWN  
SIDE: 8' OR AS SHOWN

**EASEMENTS: UTILITY & DRAINAGE (D.E. & U.E.)**  
FRONT: 10' OR AS SHOWN  
STREET RIGHT OF WAYS: 50' OR AS SHOWN  
STREET WIDTH: 28' BOC TO BOC  
LOT CORNERS: SET #4 REBAR WITH CAP

**SURVEY PLAT CODE:**  
500-01S-14W-0-12-304-62-1573

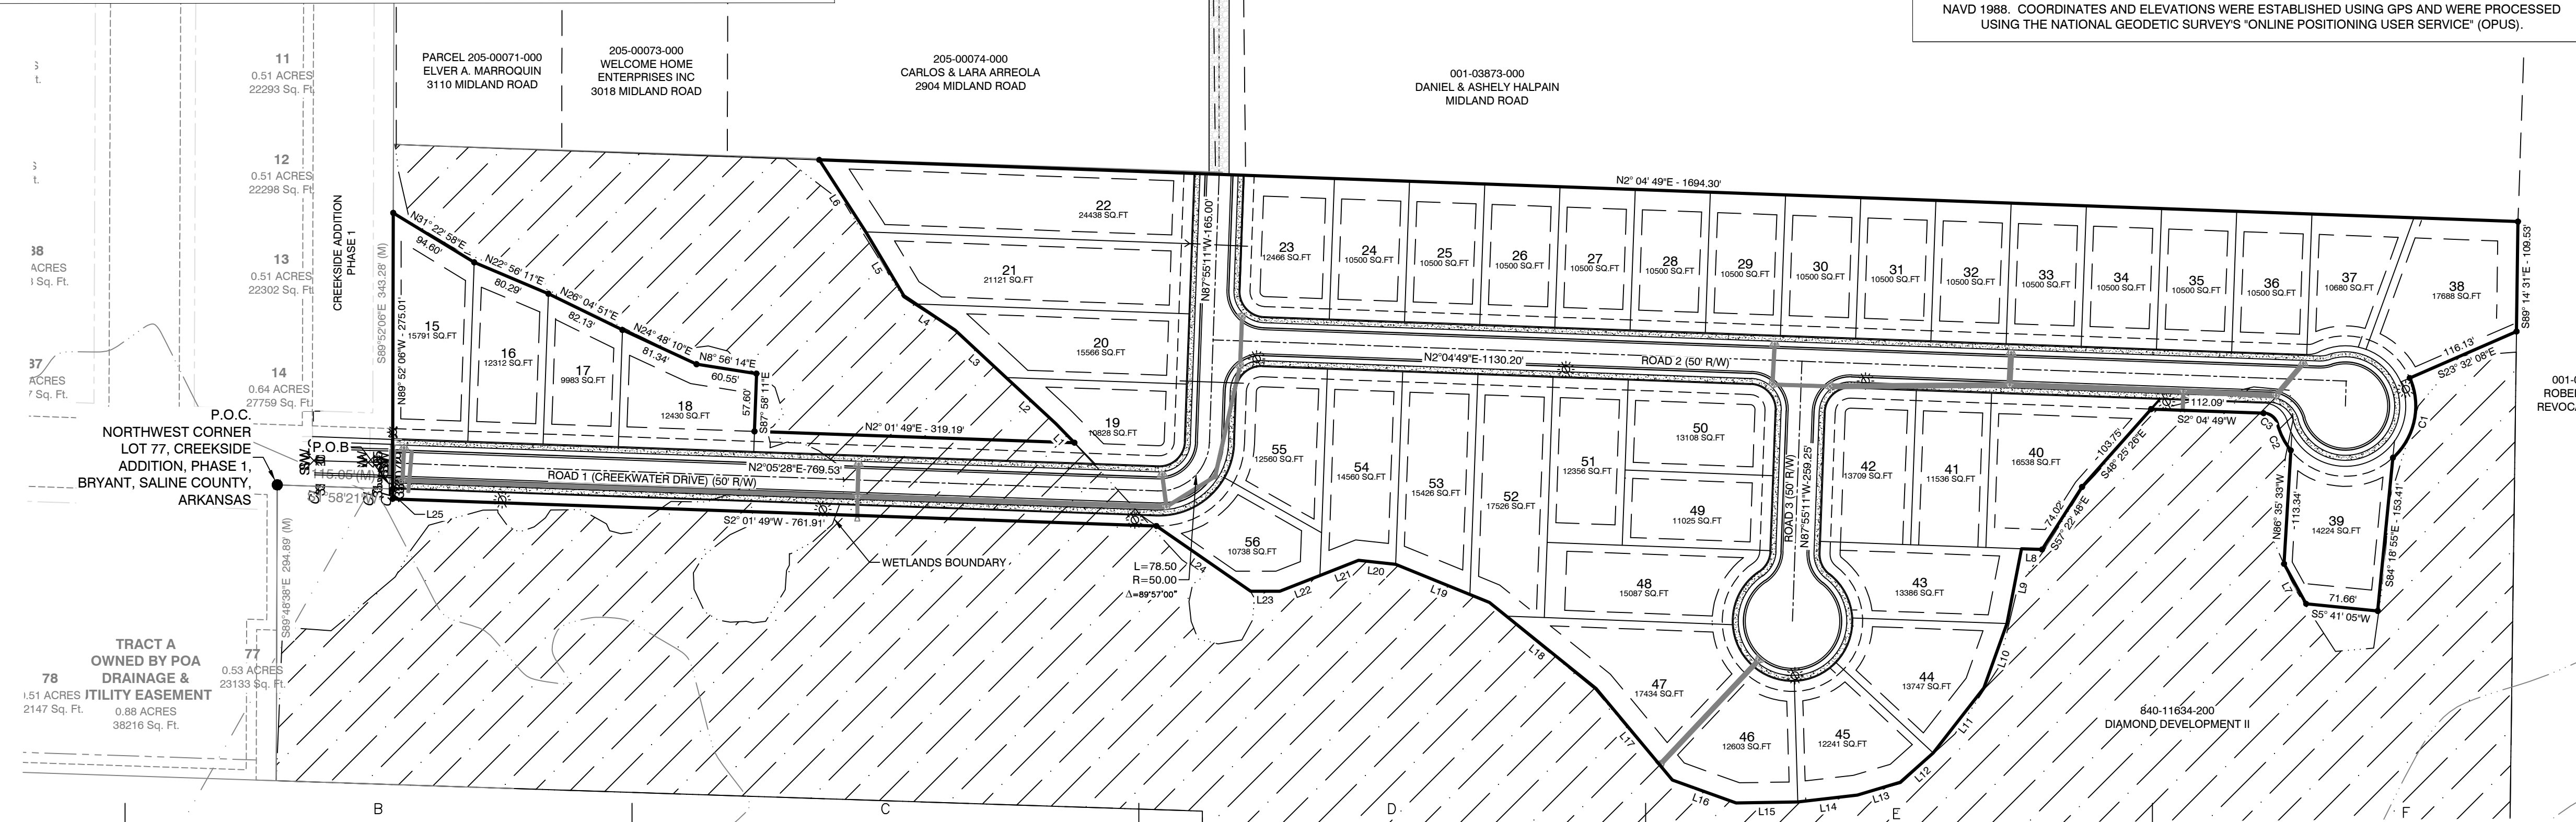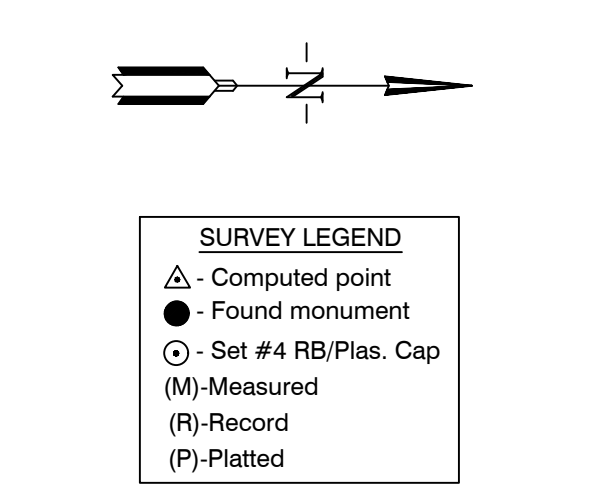

**GNE** Designing our client's success



**GarNat Engineering, LLC**  
P.O. Box 116 (72018) Ph (501) 408-4650  
3925 Mt. Carmel Road Fx (888) 900-3068  
Bryant, AR 72022 gnatengr@gmail.com

CREEKSIDE ADDITION PHASE 2  
ALL OF LOT 101 AND PART OF LOT 99  
AND PART OF LOT 100, MIDLAND FARM SUBDIVISION  
PART OF THE NE 1/4 NW 1/4, PART OF THE W 1/2 SE  
1/4 NW 1/4 AND THE NW 1/4 NE 1/4 SW 1/4 ALL IN  
SECTION 12, T-1-S, R-14-W,  
SALINE COUNTY, ARKANSAS

**DRAFT**

**CONTENTS:**  
PRELIMINARY PLAT OVERALL

PROJECT NO: 18054  
DATE: AUGUST 2022  
SHEET NO: 1

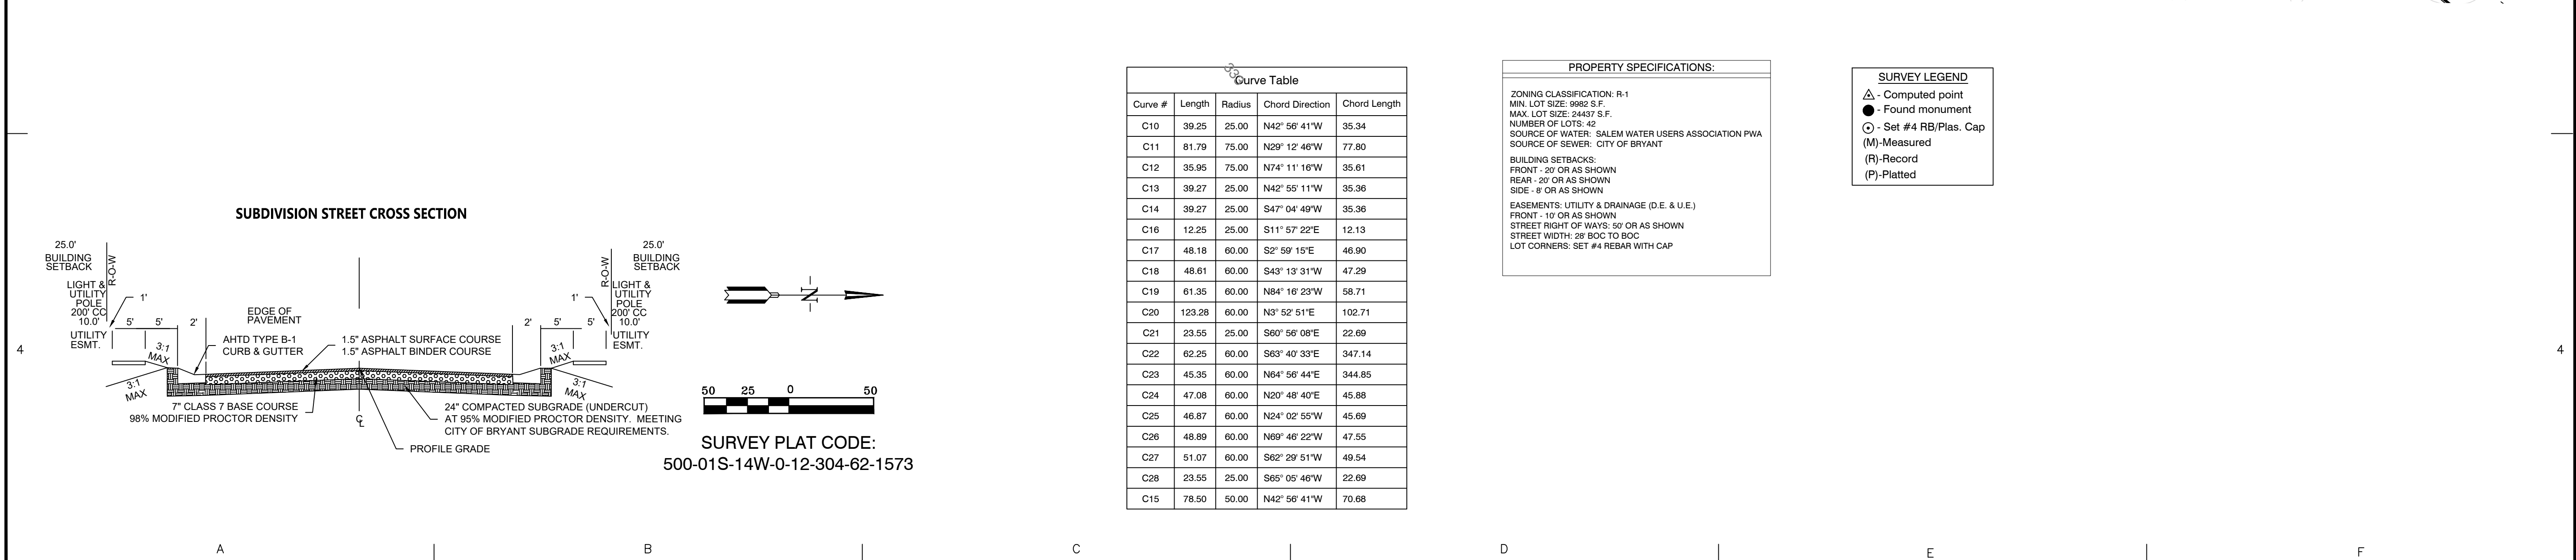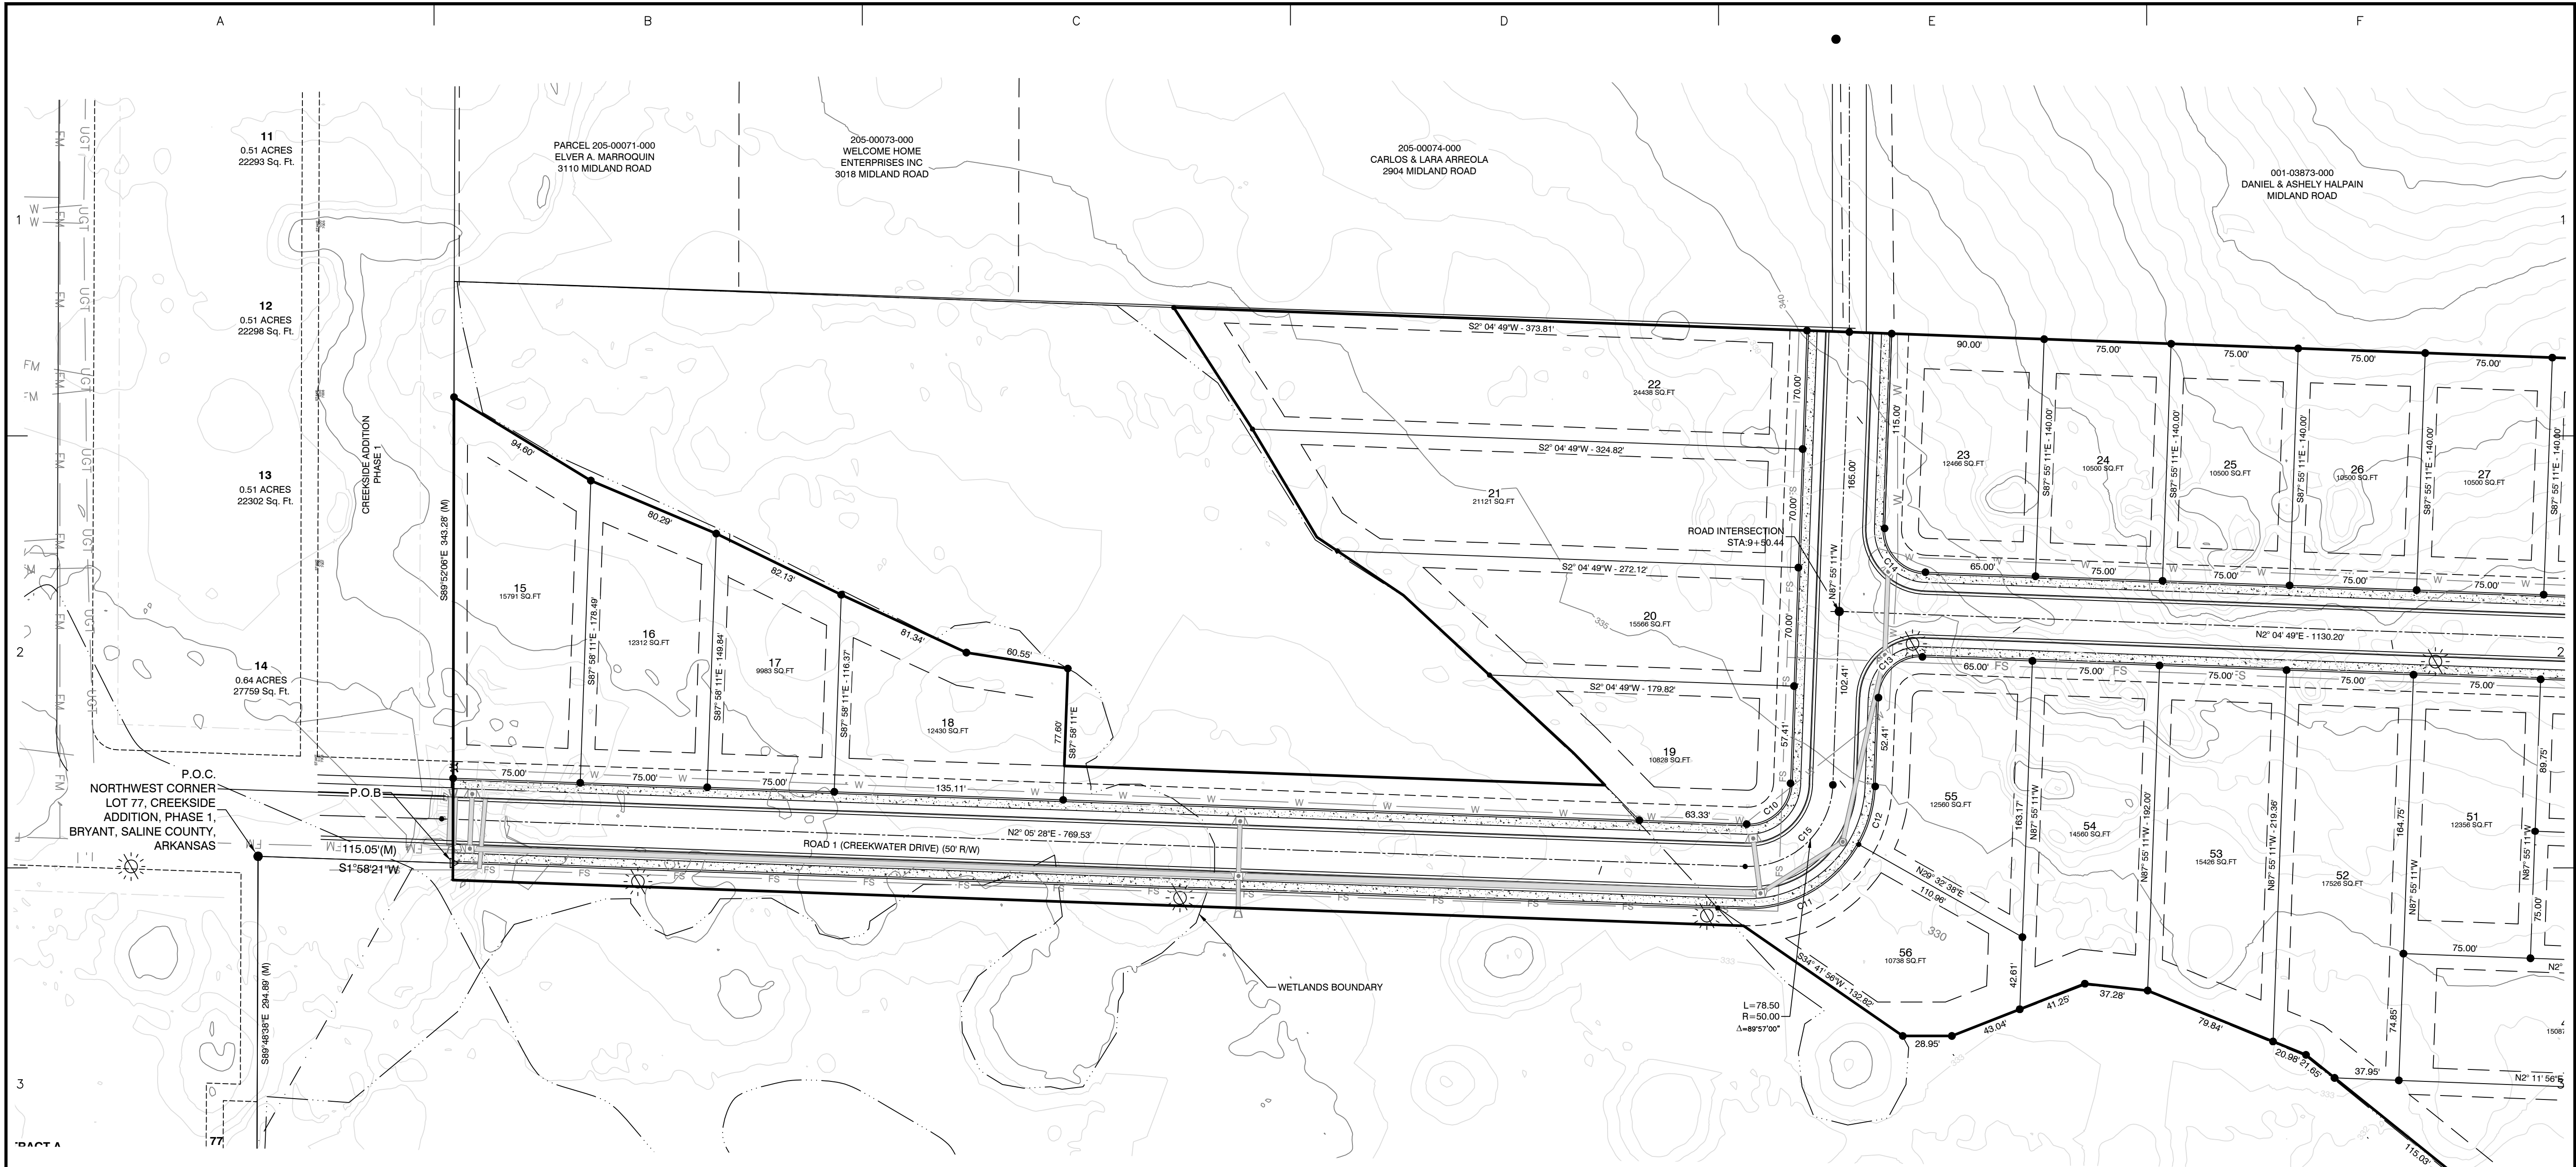

SURVEY PLAT CODE:  
500-01S-14W-0-12-304-62-1573

Curve #	Length	Radius	Chord Direction	Chord Length
C10	39.25	25.00	N42° 56' 41"W	35.34
C11	81.79	75.00	N29° 12' 46"W	77.80
C12	35.95	75.00	N74° 11' 16"W	35.61
C13	39.27	25.00	N42° 55' 11"W	35.36
C14	39.27	25.00	S47° 04' 49"W	35.36
C16	12.25	25.00	S11° 57' 22"E	12.13
C17	48.18	60.00	S2° 59' 15"E	46.90
C18	48.61	60.00	S43° 13' 31"W	47.29
C19	61.35	60.00	N84° 16' 23"W	58.71
C20	123.28	60.00	N3° 52' 51"E	102.71
C21	23.55	25.00	S60° 56' 08"E	22.69
C22	62.25	60.00	S63° 40' 33"E	347.14
C23	45.35	60.00	N64° 56' 44"E	344.85
C24	47.08	60.00	N20° 48' 40"E	45.88
C25	46.87	60.00	N24° 02' 55"W	45.69
C26	48.89	60.00	N69° 46' 22"W	47.55
C27	51.07	60.00	S62° 29' 51"W	49.54
C28	23.55	25.00	S65° 05' 46"W	22.69
C15	78.50	50.00	N42° 56' 41"W	70.68

**PROPERTY SPECIFICATIONS:**

ZONING CLASSIFICATION: R-1  
 MIN. LOT SIZE: 9682 S.F.  
 MAX. LOT SIZE: 24451 S.F.  
 NUMBER OF LOTS: 42  
 SOURCE OF WATER: SALEM WATER USERS ASSOCIATION PWA  
 SOURCE OF SEWER: CITY OF BRYANT

**BUILDING SETBACKS:**  
 FRONT - 20' OR AS SHOWN  
 REAR - 20' OR AS SHOWN  
 SIDE - 8' OR AS SHOWN

**EASEMENTS: UTILITY & DRAINAGE (D.E. & U.E.)**  
 FRONT - 10' OR AS SHOWN  
 STREET RIGHT OF WAYS: 50' OR AS SHOWN  
 STREET WIDTH: 28' BOC TO BOC  
 LOT CORNERS: SET #4 REBAR WITH CAP

**SURVEY LEGEND**

- △ - Computed point
- - Found monument
- - Set #4 RB/Plas. Cap
- (M) - Measured
- (R) - Record
- (P) - Platted

BY		REVISION		DATE	
<p><b>GNE</b> Designing our client's success  <b>GarNat Engineering, LLC</b>          P.O. Box 116 (72018) Ph (501) 408-4650          3825 Mt. Carmel Road Fx (888) 900-3068          Bryant, AR 72022 gnatengineering@gmail.com</p>					
<p>CREEKSIDE ADDITION PHASE 2          ALL OF LOT 101 AND PART OF LOT 99          AND PART OF LOT 100, MIDLAND FARM SUBDIVISION          PART OF THE NE 1/4 NW 1/4, PART OF THE W 1/2 SE          1/4 NW 1/4 AND THE NW 1/4 NE 1/4 SW 1/4 ALL IN          SECTION 12, T-1-S, R-14-W,          SALINE COUNTY, ARKANSAS</p>					
DRAFT					
<p>CONTENTS:  <b>PRELIMINARY          PLAT          SOUTH HALF</b></p>					
<p>PROJECT NO:  <b>18054</b></p>					
<p>DATE:  <b>AUGUST 2022</b></p>					
<p>SHEET NO:  <span style="font-size: 2em; font-weight: bold;">2</span></p>					



# GNE

3825 Mt Carmel Rd.  
Bryant, AR 72022

**GarNat Engineering, LLC**

P.O. Box 116  
Benton, AR 72018

August 8, 2022

Truett Smith  
Planning Director  
City of Bryant  
210 SW 3<sup>rd</sup> Street  
Bryant, AR 72022

Re: Preliminary Plat – Creekside Addition, Phase 2

Dear Mr. Smith:

Please allow this letter and the following list of enclosures to serve as my application for approval of the referenced final plat. It is my desire that this matter be included on the agenda for your September 2022 City of Bryant Planning Commission meeting. The developer for the project is Diamond Development II, 1599 Lawson Oaks, Little Rock, Arkansas, 72210, [jbhastingsjr@aol.com](mailto:jbhastingsjr@aol.com), 501-690-6601.


List of Enclosures

- Affidavit
- Bryant Subdivision Checklist
- 8 copies of the preliminary plat
- Preliminary plat review fee of \$426.00
- Stormwater Detention and Drainage Engineering fee of \$1,050.00
- 2 Full Sets of Subdivision Plans
- Drainage Calculations
- DXF of Subdivision

If you have questions or need any additional information, please do not hesitate to contact me.



Sincerely,

GarNat Engineering, LLC

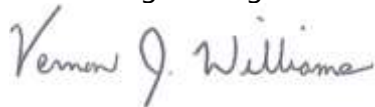

Vernon J. Williams, P.E., President

PIP  
NW CORNER NW 1/4 NW 1/4  
SECTION 16, T-01-S, R-14-W

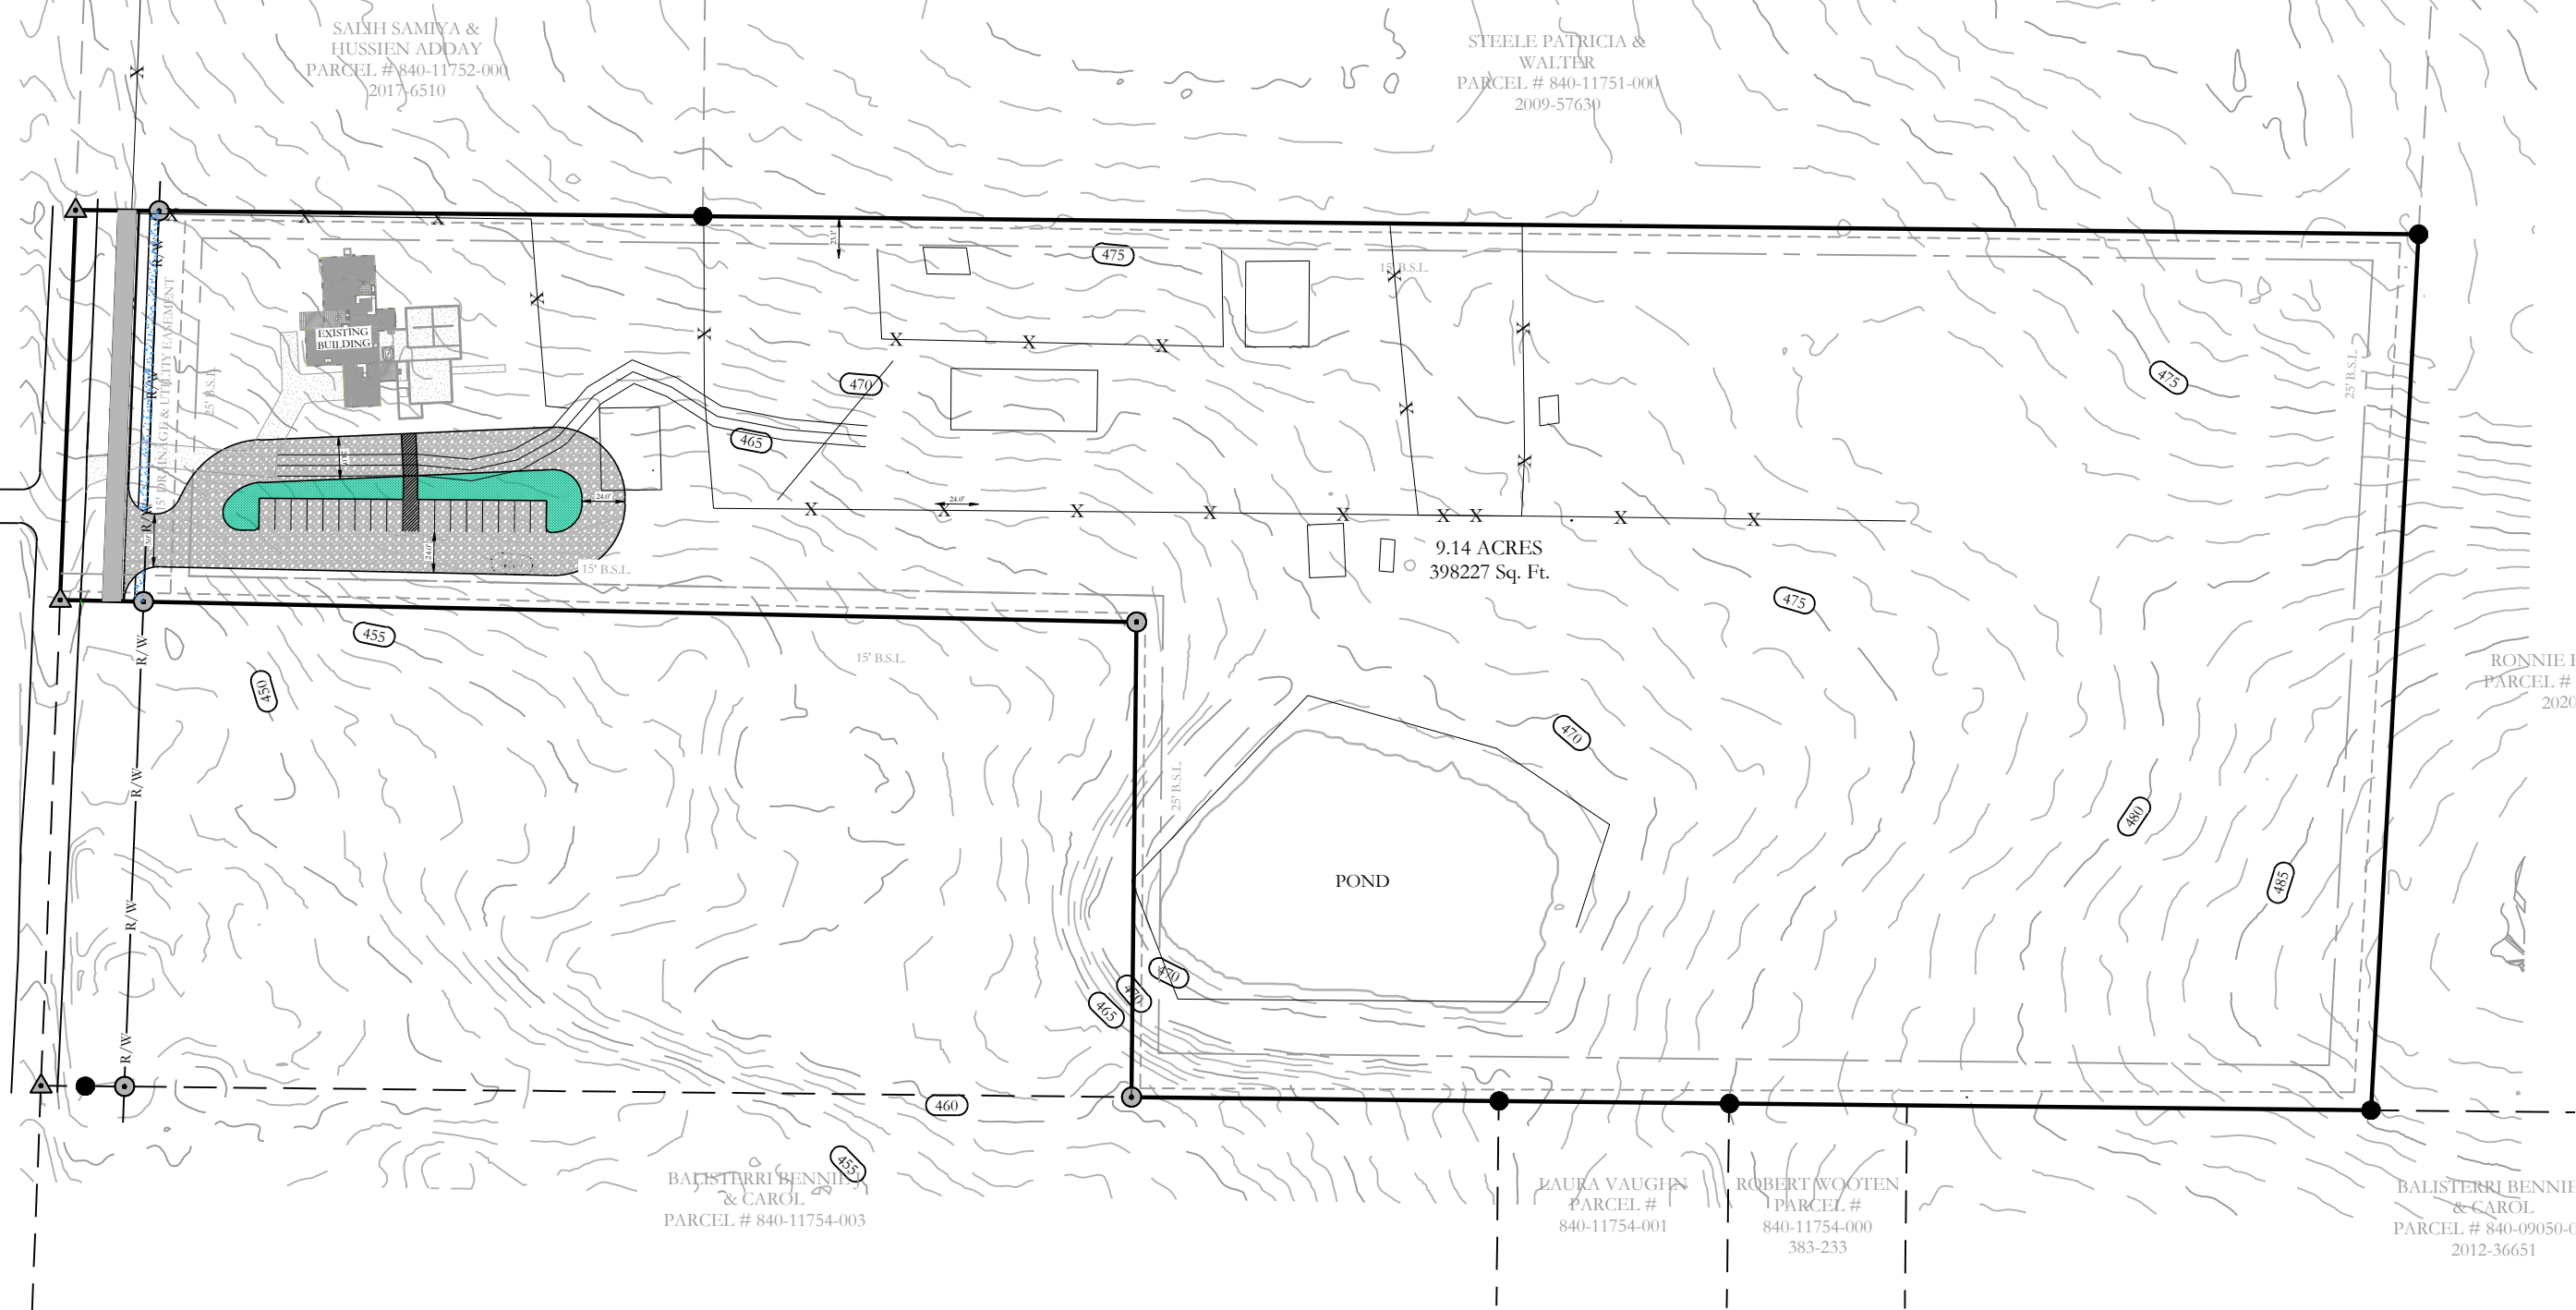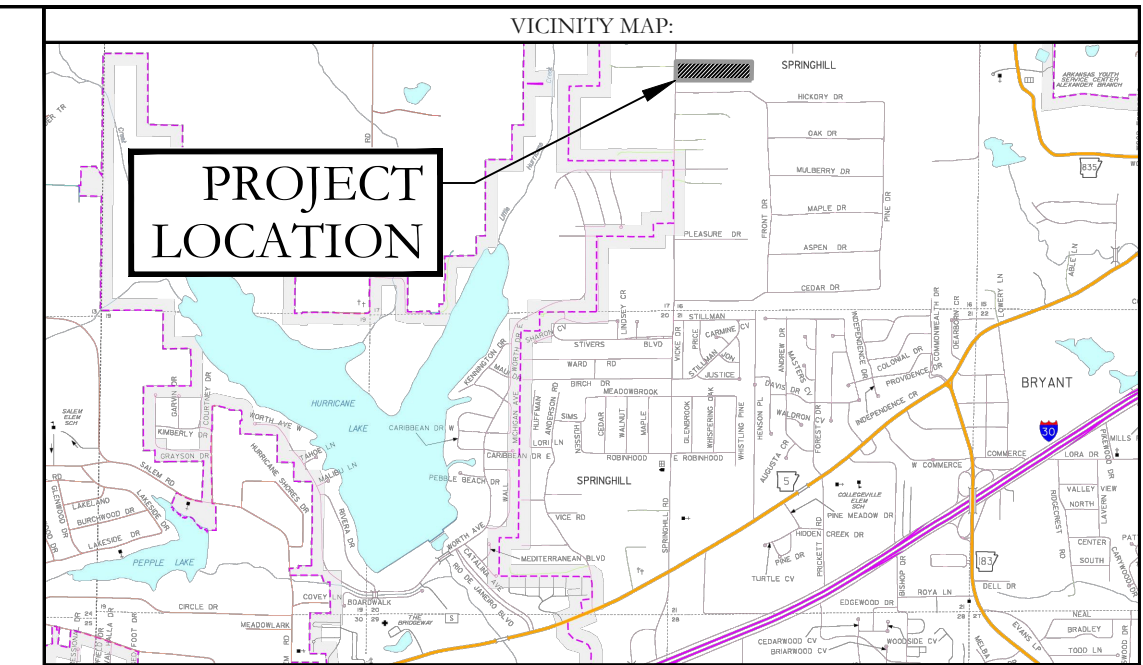

UTILITY PLAN LEGEND	
	WATER METER
	WATER VALVE
	FIRE HYDRANT
	SANITARY SEWER LINE
	WATER LINE
	SEWER MANHOLE
	SANITARY SEWER CLEANOUT

RONNIE I  
PARCEL #  
20120

BALISTERRI BENNIE  
& CAROL  
PARCEL # 840-11754-003

LAURA VAUGHN  
PARCEL #  
840-11754-001

ROBERT WOOTEN  
PARCEL #  
840-11754-000  
383-233

BALISTERRI BENNIE  
& CAROL  
PARCEL # 840-09050-0  
2012-36651

**LEGAL DESCRIPTION:**  
PART OF THE NORTHWEST QUARTER OF THE NORTHWEST QUARTER, SECTION 16, TOWNSHIP 1 SOUTH, RANGE 14 WEST, DESCRIBED AS FOLLOWS: COMMENCING AT THE NORTHWEST CORNER OF SAID NORTHWEST QUARTER OF THE NORTHWEST QUARTER, THENCE S2°15'35"W ALONG WEST LINE OF SAID NORTHWEST QUARTER, A DISTANCE OF 819.14 FEET TO THE **POINT OF BEGINNING**; THENCE S89°26'33"E, A DISTANCE OF 353.66 FEET TO A FOUND IRON PIN AT THE SOUTHEAST CORNER OF LAND DESCRIBED IN INSTRUMENT #2017-006510 FILED IN SALINE COUNTY, ARKANSAS; THENCE ALONG THE SOUTH PROPERTY LINE OF LAND DESCRIBED IN INSTRUMENT #2009-57630 FILED IN SALINE COUNTY, ARKANSAS, S89°23'57"E, A DISTANCE OF 967.93 FEET TO A 3/8" FOUND IRON PIN WITH CAP #128 ON THE WEST PROPERTY LINE OF LANDS OWNED BY RONNY BROADWAY DESCRIBED INSTRUMENT #2020-017777 FILED IN SALINE COUNTY, ARKANSAS; THENCE LEAVING SAID SOUTH LINE ALONG THE WEST LINE OF BROADWAY, S03°06'57"W, A DISTANCE OF 494.53 FEET TO A 3/8" REBAR AND THE NORTH LINE OF LANDS DESCRIBED IN SALINE COUNTY DOCUMENT #2012-36651; THENCE N89°23'43"W, A DISTANCE OF 1313.94 FEET ALONG THE NORTH LINE OF LANDS OWNED BY BALISTERRI, WOOTEN AND VAUGHN; THENCE N02°15'55"E, A DISTANCE OF 493.91 FEET TO THE POINT OF BEGINNING, CONTAINING 14.71 ACRES, MORE OR LESS.

A PORTION OF THE PROPERTY DESCRIBED HEREON LIES WITHIN THE 100 YEAR FLOODPLAIN, ACCORDING TO THE FLOOD INSURANCE RATE MAP, PANEL #05125C0225E, DATED: 6/5/2020.

**BUILDING SETBACKS:**  
FRONT - 25' OR AS SHOWN  
REAR - 25' OR AS SHOWN  
SIDE - 15' OR AS SHOWN

**EASEMENTS: UTILITY & DRAINAGE (D.E. & U.E.)**  
FRONT - 15' OR AS SHOWN  
REAR - 10' OR AS SHOWN  
SIDE - 5' OR AS SHOWN  
LOT CORNERS: SET 1/2" REBAR WITH CAP

SOUND IN PAVEMENT  
SW CORNER SW 1/4 SW 1/4  
SECTION 16, T-01-S, R-14-W

BASIS OF BEARINGS:  
GRID NORTH ARKANSAS  
COORDINATE SYSTEM,  
SOUTH ZONE BY G.P.S.  
OBSERVATIONS



**SITE PLAN**  
**NUCKOLS ESTATES**  
A SUBDIVISION, IN THE CITY OF BRYANT, SALINE COUNTY, ARKANSAS



LEGEND	
	- Found Aliquot Corner
	- Found monument
	- Set 1/2" Rebar
	- Computed point
(M)	- Measured
(P)	- Plat/Deed
- - -	- Fence

<b>HOPE CONSULTING</b> ENGINEERS - SURVEYORS		117 S. Market Street, Benton, Arkansas 72015 PH. (501)315-2626 FAX (501) 315-0024 www.hopeconsulting.com
FOR USE AND BENEFIT OF: <b>SHANNON NUCKOLS</b>		
SITE PLAN <b>NUCKOLS ESTATES</b> A SUBDIVISION, IN THE CITY OF BRYANT, SALINE COUNTY, ARKANSAS		
DATE: 08/10/2022	C.A.D. BY: BJOHNSON	DRAWING NUMBER:
REVISED:	CHECKED BY:	20-0673
SHEET: 500	SCALE: 1" = 100'	
01S	14W	0 16 400 62 1762

K:\Land Projects\2010\Survey\2020\20-0673 M&H\Site\_0110\Springsill Road\20-0673\_Site\_Plan-08-25-22.dwg - 1.dwg





City of Bryant, Arkansas  
 Community Development  
 210 SW 3<sup>rd</sup> Street Bryant, AR 72022  
 501-943-0943

Approved 1 Sign  
 CL 7/26/2022

## SIGN PERMIT APPLICATION

Applicants are advised to read the Sign Ordinance prior to completing and signing this form.  
 The Sign Ordinance is available at [www.cityofbryant.com](http://www.cityofbryant.com) under the Planning and Community Development tab.

Note: Electrical Permits may be Required, Please contact the Community Development Office for more information.

Date: 7/19/2022

### Sign Co. or Sign Owner

Name L. Graphic indoor-outdoor sign  
 Address 701 N. Reynolds Rd  
 City, State, Zip Bryant, AR 72022  
 Phone (501) 653-4444  
 Email Address Joe@LGraphix.com

### Property Owner

Name Ta Miya's studio of Dance, LLC  
 Address 3411 Main St. Ste 5  
 City, State, Zip Bryant, AR 72022  
 Phone (501) 214-8600  
 Email Address \_\_\_\_\_

### GENERAL INFORMATION

Name of Business Ta Miya's studio of Dance, LLC  
 Address/Location of sign 3411 Main St. Suite #5 Bryant, AR 72022  
 Zoning Classification \_\_\_\_\_

Please use following page to provide details on the signs requesting approval. Along with information provided on this application, a Site Plan showing placement of sign(s) and any existing sign(s) on the property is **required** to be submitted. Renderings of the sign(s) showing the correct dimensions is also **required** to be submitted with the application. A thirty-five dollar (\$35) per sign payment will be collected at the time of permit issuance. According to the Sign Ordinance a fee for and sign variance or special sign permit request shall be one hundred dollars (\$100). Additional documentation may be required by Sign Administrator.

### READ CAREFULLY BEFORE SIGNING

I Joe lam, do hereby certify that all information contained within this application is true and correct. I fully understand that the terms of the Sign Ordinance supersede the Sign Administrator's approval and that all signs must fully comply with all terms of the Sign Ordinance regardless of approval. I further certify that the proposed sign is authorized by the owner of the property and that I am authorized by the property owner to make this application. I understand


that no sign may be placed in public right of way. I understand that I must comply with all Building and Electrical Codes and that it is my responsibility to obtain all necessary permits.

**Use table below to enter information regarding each sign for approval. Please use each letter to reference each sign rendering.**

SIGN	Type (Façade, Pole, Monument, other)	Dimensions (Height, Length, Width)	Sqft (Measured in whole as rectangle)	Height of Sign (Measured from lot surface)		Column for Admin Certifying Approval
				Top of Sign	Bottom of Sign	
A	wall mount	96" x 48"	32	18	14	<i>CL 7/26/2022</i>
B						
C						
E						
F						
G						

3411 Main St - suites, Bigant, AR 72022

8 feet

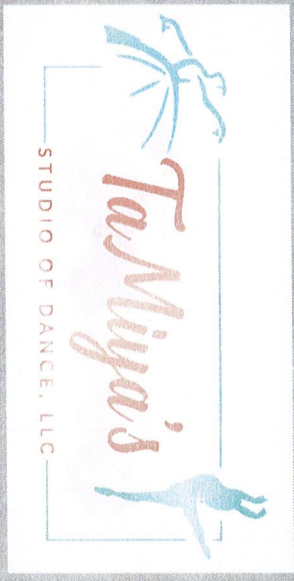

4 feet

WE BUY GOLD



2 Signs Approved 8/11/2022  
CL



City of Bryant, Arkansas  
Community Development  
210 SW 3<sup>rd</sup> Street Bryant, AR 72022  
501-943-0943

## SIGN PERMIT APPLICATION

Applicants are advised to read the Sign Ordinance prior to completing and signing this form.  
The Sign Ordinance is available at [www.cityofbryant.com](http://www.cityofbryant.com) under the Planning and Community Development tab.

Note: Electrical Permits may be Required, Please contact the Community Development Office for more information.

Date: 6-23-22

### Sign Co. or Sign Owner

Name WHITE SIGN COMPANY  
Address 3501 STONELEDGE DR  
City, State, Zip TEXARKANA, TX 75503  
Phone 903-280-7849  
Alternate Phone 903-293-4926

### Property Owner


Name FARMERS BANK & TRUST  
Address \_\_\_\_\_  
City, State, Zip \_\_\_\_\_  
Phone \_\_\_\_\_  
Alternate Phone \_\_\_\_\_

### GENERAL INFORMATION

Name of Business FARMERS BANK & TRUST  
Address/Location of sign 3345 HWY 5 N  
Zoning Classification \_\_\_\_\_

Please use following page to provide details on the signs requesting approval. Along with information provided on this application, a **Site Plan showing placement of sign(s) and any existing sign(s) on the property is required** to be submitted. **Renderings of the sign(s) showing the correct dimensions is also required** to be submitted with the application. A thirty-five dollar (\$35) per sign payment will be collected at the time of permit issuance. According to the Sign Ordinance a fee for and sign variance or special sign permit request shall be one hundred dollars (\$100). Additional documentation may be required by Sign Administrator.

### READ CAREFULLY BEFORE SIGNING

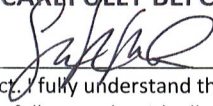
I , do hereby certify that all information contained within this application is true and correct. I fully understand that the terms of the Sign Ordinance supersede the Sign Administrator's approval and that all signs must fully comply with all terms of the Sign Ordinance regardless of approval. I further certify that the proposed sign is authorized by the owner of the property and that I am authorized by the property owner to make this application. I understand

# 2nd Submittal

that no sign may be placed in public right of way. I understand that I must comply with all Building and Electrical Codes and that it is my responsibility to obtain all necessary permits.

Use table below to enter information regarding each sign for approval. Please use each letter to reference each sign rendering.

SIGN	Type (Façade, Pole, Monument, other)	Dimensions (Height, Length, Width)	Sqft (Measured in whole as rectangle)	Height of Sign (Measured from lot surface)		Column for Admin Certifying Approval
				Top of Sign	Bottom of Sign	
A	Pole	30" x 58.5"	12.19		132"	CL 8/11/22
B	Pole	30" x 58.5"	12.19		132"	CL 8/11/22
C						
E						
F						
G						

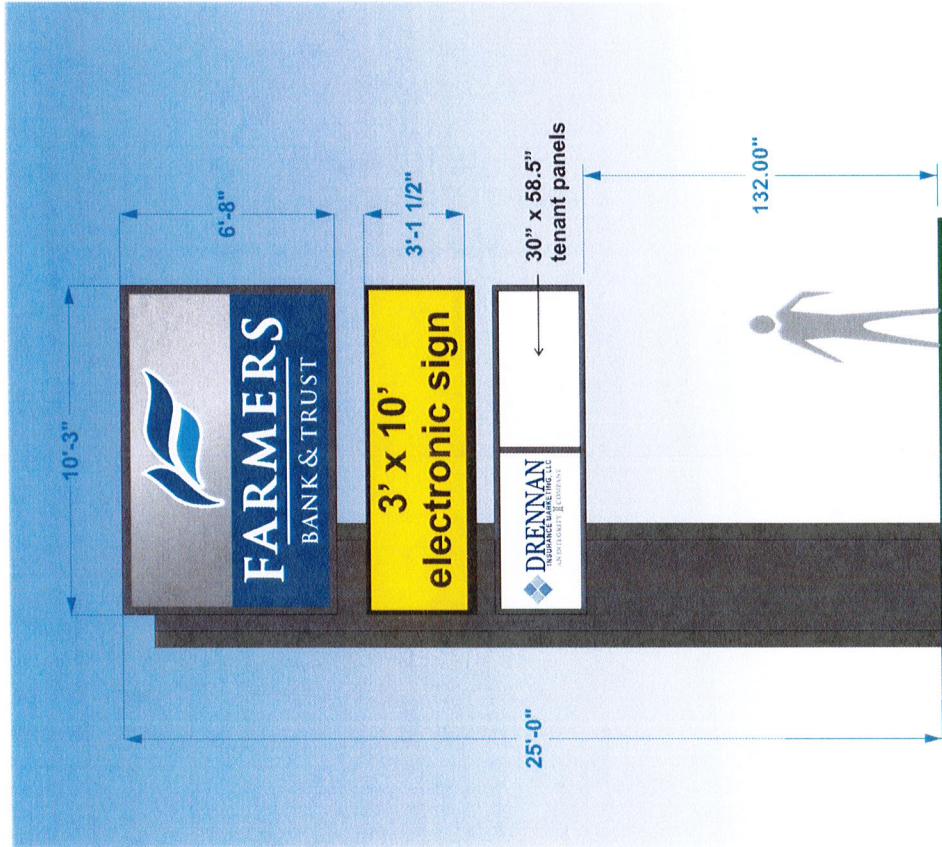

**Farmers Bryant  
Tenant Sign**

File: Farmers Bryant Tenant Sign  
 Date: 7-15-22  
 Customer: Farmers Bank  
 Location: Bryant, AR


Customer Approval

Change As Noted

Notes:

This is an original, unpublished drawing. It is not to be reproduced, copied, or edited in any fashion without written permission from White Sign Company. All other copyrighted designs furnished to White Sign Company by the customer, all other designs herein are the property of White Sign Company.

© Copyright 2022

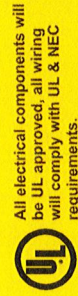

All electrical components will be UL approved, all wiring will comply with UL & NEC requirements.

Signs will bear the UL mark.

All signs will be engineered to meet or exceed local wind load requirements.



Main Office  
 3501 Stonelledge Dr.  
 Texarkana, TX 75503  
 903 280 7849

WHITESIGN.COM