



Bryant Development and Review Committee Meeting

Boswell Municipal Complex - City Hall Conference Room

210 SW 3rd Street

Date: July 03, 2025 - **Time:** 9:00 AM

Call to Order

Old Business

New Business

1. Sky Blue Duplexes Subdivision - Final Plat

Hope Consulting - Requesting Recommendation for Approval of Final Plat

- [0952-PLT-03.pdf](#)
- [0952-ASB-02.pdf](#)
- [0952-LTR-01.pdf](#)
- [0952-RSP-01.pdf](#)

2. Panera Bread - 23146 I-30 - Sign Permit

Arkansas Sign and Neon - Requesting Sign Permit Approval for Pylon Sign

- [REVISED SITE PLAN-PANERA BREAD--BRYANT AR PYLON.pdf](#)
- [Panera Bread - Pylon Sign Application.pdf](#)

3. Midland Estates Subdivision Ph 1 - Final Plat

Hope Consulting - Requesting Recommendation for Final Plat Approval

- [0940-ltr-01.pdf](#)
- [0940-asb-02.pdf](#)
- [0940-bndltr-01.pdf](#)
- [0940-elcltr-01.pdf](#)
- [0940-plt-03.pdf](#)



4. REQUEST TO ADD: Marketplace Subdivision East - Final Plat

GarNat Engineering - Requesting Recommendation for Final Plat Approval

- [0976-ASB-01.pdf](#)
- [0976-PLT-01.pdf](#)
- [0976-LTR-01.pdf](#)
- [0976-APP-01.pdf](#)

Permit Report

Adjournments

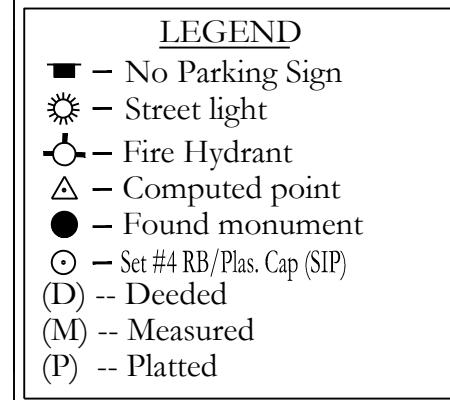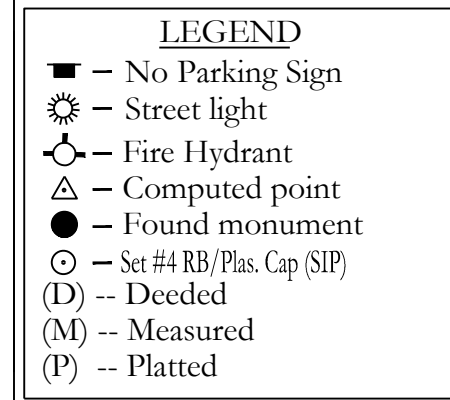

CERTIFICATE OF OWNER:

Date of Execution _____ Name: _____

I, Corbett R. Shoffner, hereby certify that this plat correctly represents a survey and a plan made by me

Corbett R. Shoffner,
Registered Professional

Date of Execution Kazi Tamzidul Islam
Registered Professional

Date of Execution _____



NOTE: This survey was based on legal descriptions and title work furnished by others and does not represent a title search.



PROPERTY SPECIFICATIONS:	

DEVELOPER/ SUBDIVIDER	SKY BLUE, LLC 3621 INDEPENDENCE DRIVE BRYANT, AR 72022	MINIMUM LOT SIZE: 7.2806sq. FT. NUMBER OF LOTS: 4
ENGINEERS	HOPE CONSULTING INC. 117 S. MARKET STREET BRYANT, AR 72015	SOURCE OF WATER: WATER USERS SOURCE OF SEWER: CITY OR BRVANT SOURCE OF ELECTRIC: ENTIRGY
NAME OF SUBDIVISION	SKY BLUE DUPLEXES	<u>BUILDING SETBACKS</u> FRONT: 30' OR AS SHOWN REAR: 20' OR AS SHOWN SIDE: 8' OR AS SHOWN
INSTRUMENT #	2015-7766	<u>UTILITY & DRAINAGE EASEMENTS</u> FRONT: 10' OR AS SHOWN REAR: 5' OR AS SHOWN SIDE: 5' OR AS SHOWN
ZONING	R-X	

FOR USE AND BENEFIT OF:
SKY BLUE, LLC

DATE: 06-23-2025	C.A.D. BY: B.JOHNSON	DRAWING NUMBER:
------------------	----------------------	-----------------

REVISED: 06-30-2025		CHECKED BY:				19-0066		
SHEET:		SCALE: 1"=20'						
500	01S	14W	0	20	230	62	1664	

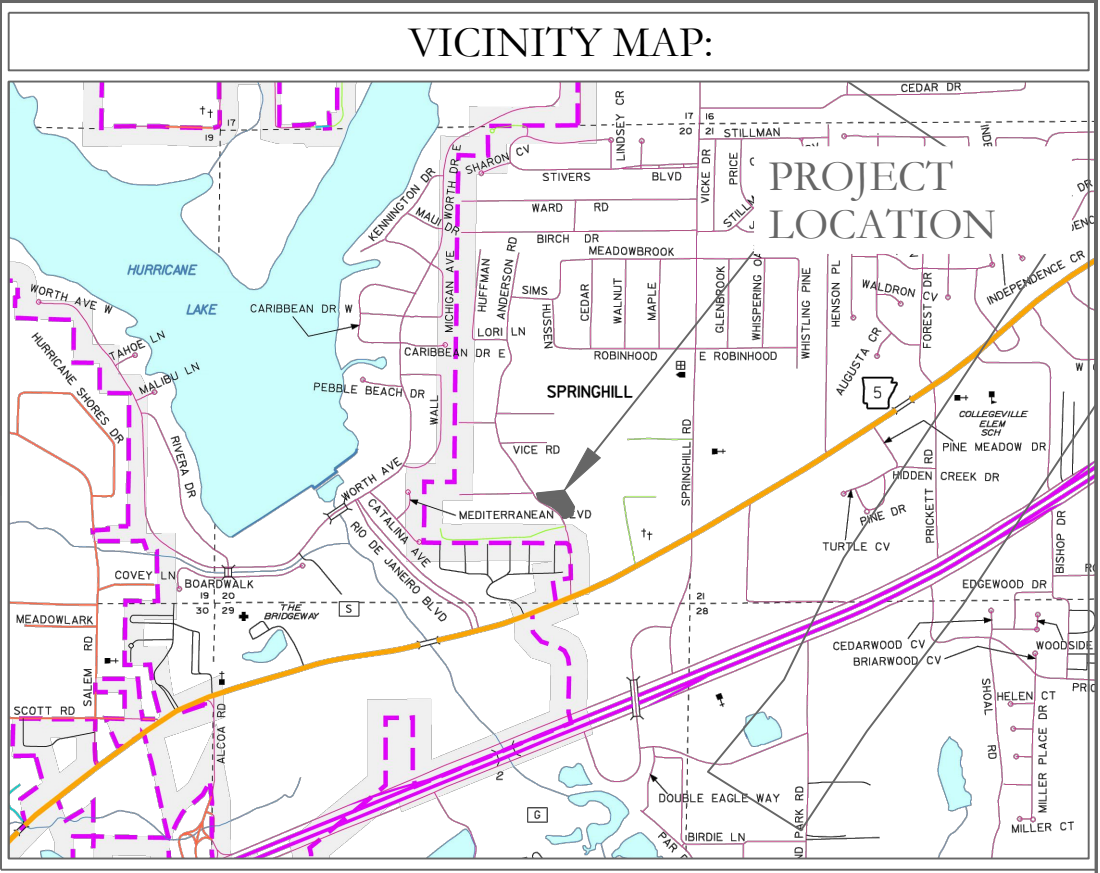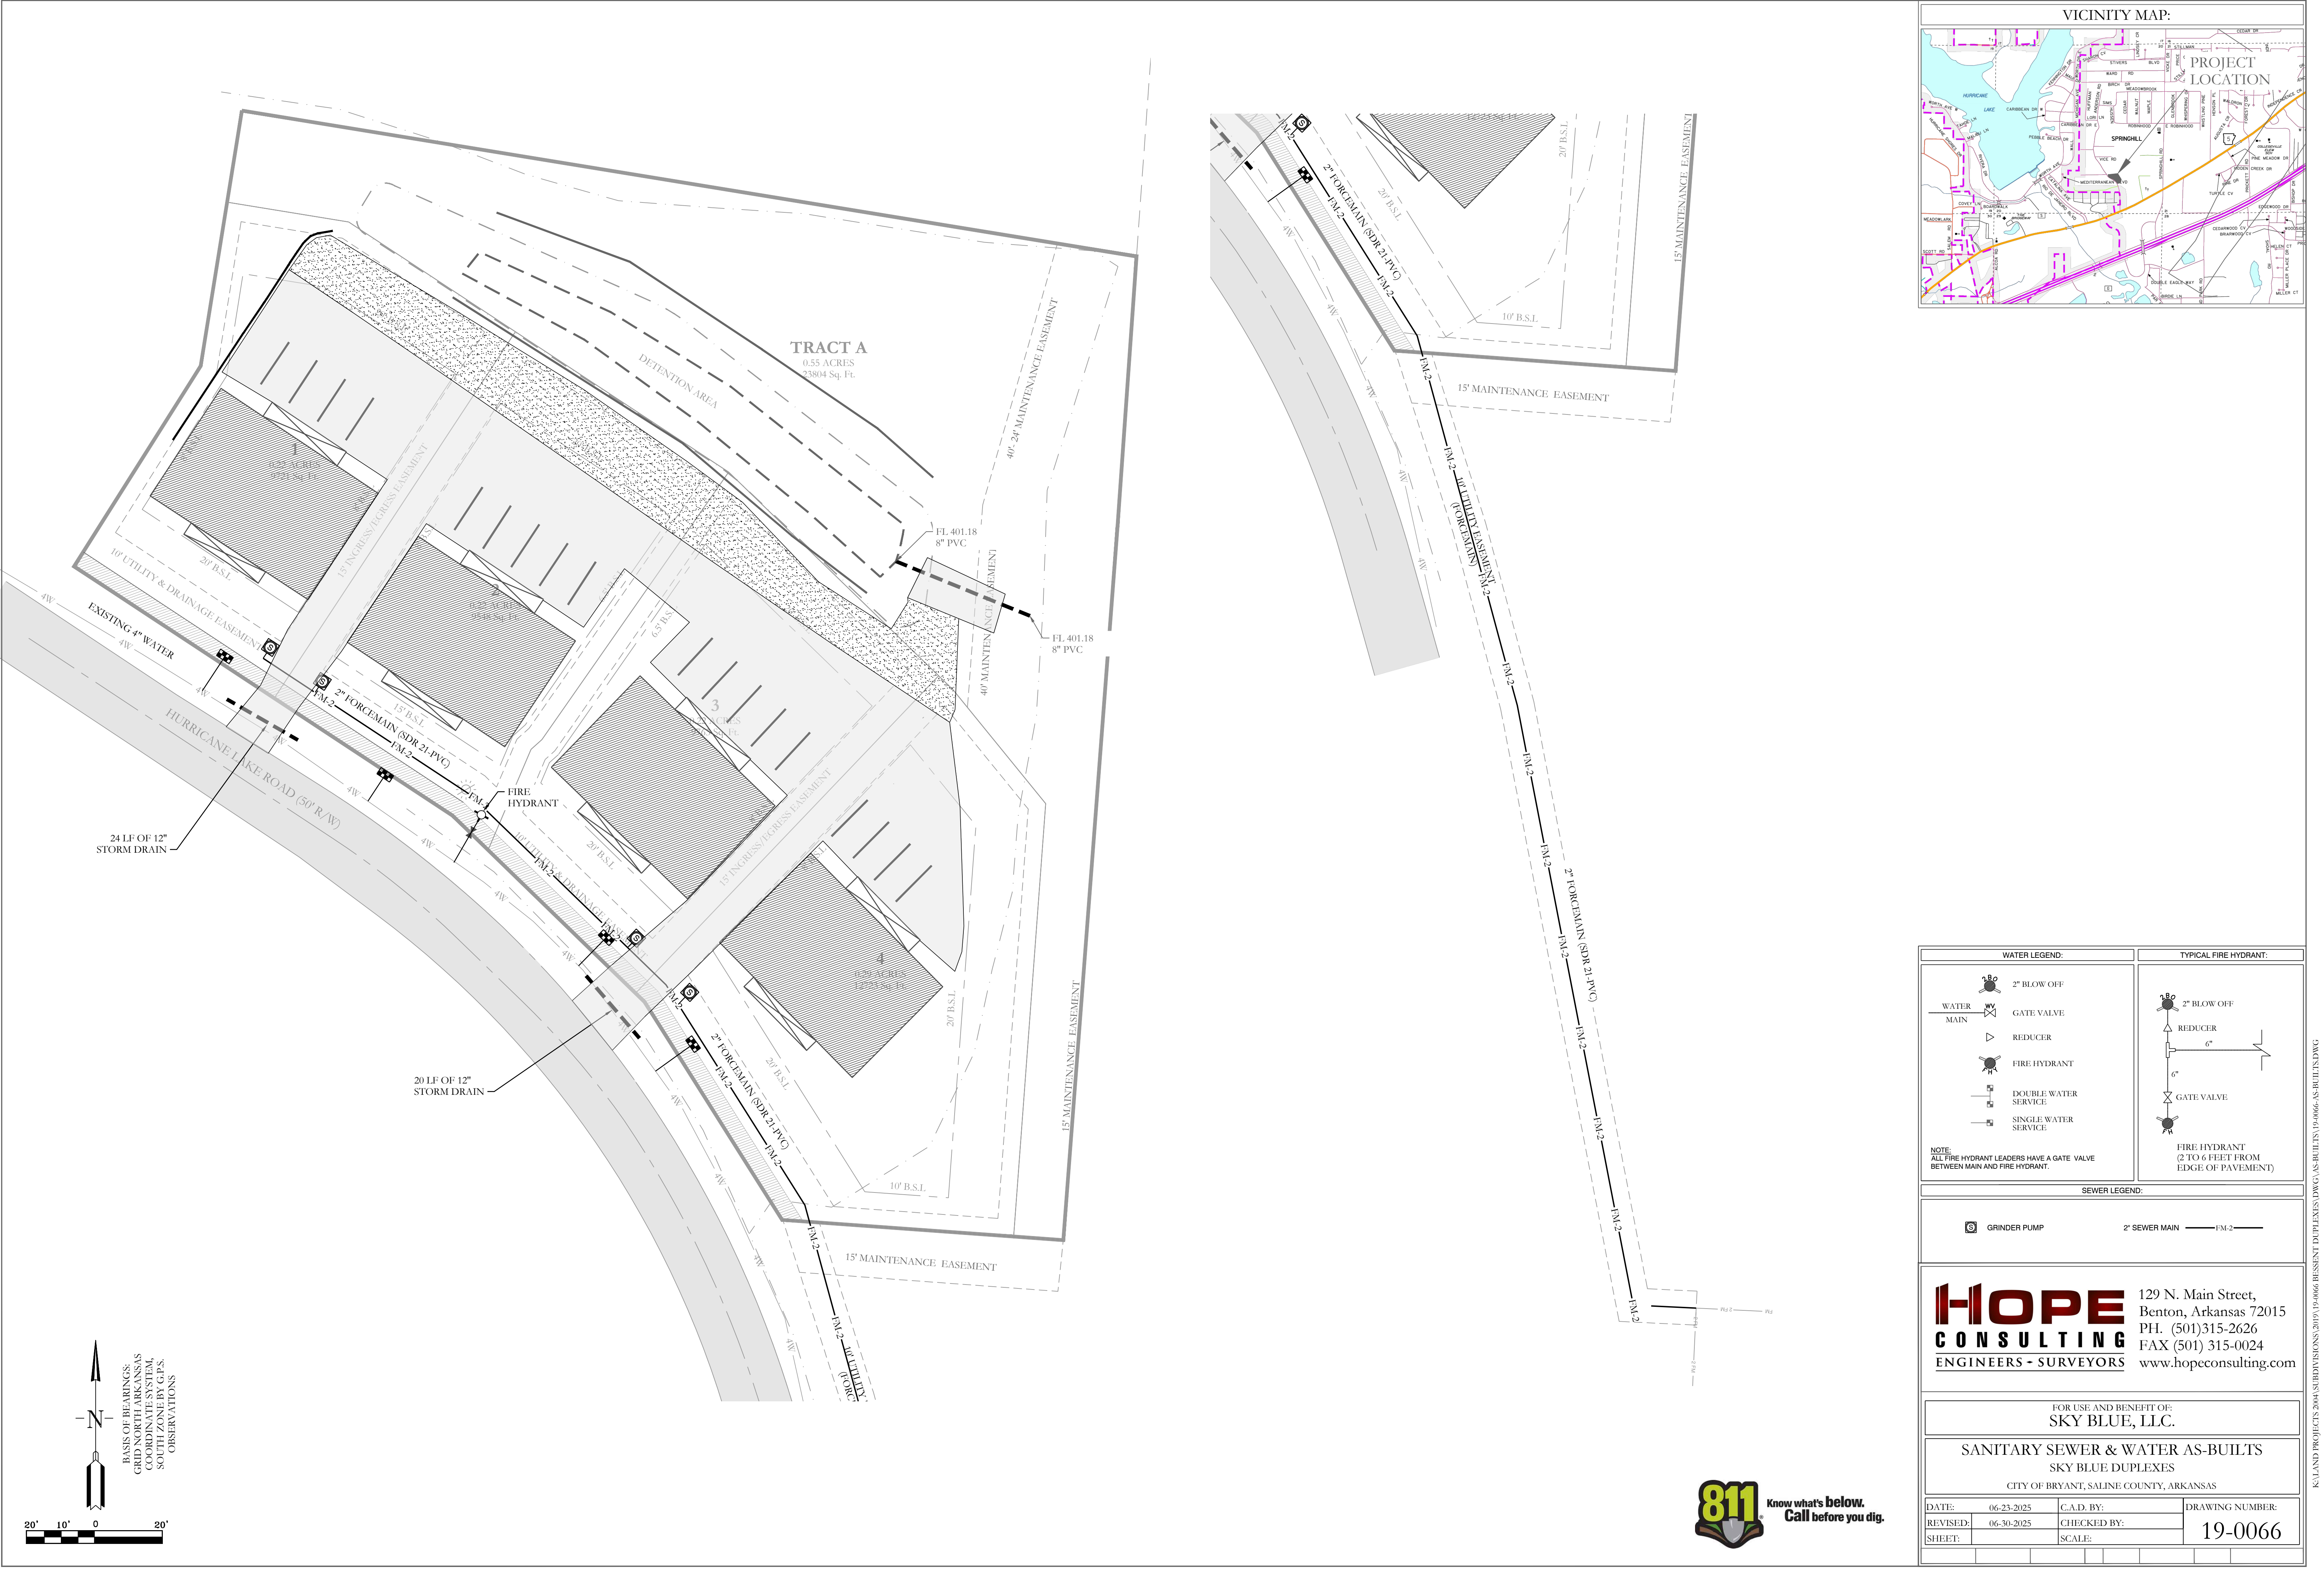

WATER LEGEND:		TYPICAL FIRE HYDRANT:	
	2" BLOW OFF		2" BLOW OFF
 WATER MAIN	GATE VALVE		REDUCER
	REDUCER	 6"	
	FIRE HYDRANT	 6"	
	DOUBLE WATER SERVICE		GATE VALVE
	SINGLE WATER SERVICE		FIRE HYDRANT (2 TO 6 FEET FROM EDGE OF PAVEMENT)
NOTE: ALL FIRE HYDRANT LEADERS HAVE A GATE VALVE BETWEEN MAIN AND FIRE HYDRANT.			

SEWER LEGEND:	
	GRINDER PUMP
	2" SEWER MAIN
	FM-2

HOPE
CONSULTING
ENGINEERS - SURVEYORS

129 N. Main Street,
Benton, Arkansas 72015
PH. (501)315-2626
FAX (501) 315-0024
www.hopeconsulting.com

FOR USE AND BENEFIT OF: SKY BLUE, LLC.		
SANITARY SEWER & WATER AS-BUILTS SKY BLUE DUPLEXES		
CITY OF BRYANT, SALINE COUNTY, ARKANSAS		
DATE: 06-23-2025	C.A.D. BY:	DRAWING NUMBER: 19-0066
REVISED: 06-30-2025	CHECKED BY:	
SHEET:	SCALE:	



K:\LAND PROJECTS\2004\SUBDIVISIONS\2019\19-0066\RESIDENT DUPLEXES\DWG\AS-BUILTS\19-0066-AS-BUILD.DWG



Re: Hurricane Lake Rd Duplex in Bryant Arkansas

From Matthew Finley <finleymatthewm@gmail.com>

Date Mon 6/30/2025 7:14 AM

To Jimmy Worlow <jworlow@entergy.com>

Cc kazi hopeconsulting.com <kazi@hopeconsulting.com>; Stu <stuart@finleyandcompany.com>;
jonathanlhope@gmail.com <jonathanlhope@gmail.com>

Thanks for the quick response. I don't think we want anything fancy. It would be 2 lights max....I will find out and get back with you. Pretty sure it's the basic SL 1 M lights on the existing wood poles.

Thank you..!!

Matthew Finley
501.231.4930 cell

On Jun 30, 2025, at 7:02 AM, Worlow, Jimmy <jworlow@entergy.com> wrote:

The city needs to turn in an LOA to the builder's desk. On that LOA they need to tell us how many lights they want and what type of light. That's what we need from the city since the lights will be added to their account and they will be paying for the streetlights each month. If they only want 2 basic SL1M type lights installed on existing wood poles it shouldn't be too hard, But if they want decorative underground type lights and fiberglass poles to be installed then those are more complicated and have an upfront cost associated with them. Those negotiations are between you and the city, but Entergy can't install any lights without an LOA or install request from the city turned into the Builders Desk signed by the city and in writing.

Jimmy Worlow

From: Matthew Finley <finleymatthewm@gmail.com>

Sent: Monday, June 30, 2025 6:51 AM

To: Worlow, Jimmy <jworlow@entergy.com>

Cc: kazi hopeconsulting. com <kazi@hopeconsulting.com>; Stu <stuart@finleyandcompany.com>;
Jonathan Hope <jonathanlhope@gmail.com>

Subject: Hurricane Lake Rd Duplex in Bryant Arkansas

You don't often get email from finleymatthewm@gmail.com. [Learn why this is important](#)

⚠ HIGH RISK: UNTRUSTED EXTERNAL SENDER. DO NOT click links, or open attachments, if sender is unknown, or the message seems suspicious in any way. DO NOT provide your User ID or Password.

Good Morning Jimmy

We are being asked by the City of Bryant to obtain street lights for a duplex project we are doing on Hurricane Lake Road in Bryant, Arkansas.

I am trying to get some information from you. We have 2 power poles on site and I am assuming they would just be the common LED “night watcher” LED lights.

There are 4 addresses, but the poles sit in between these 2:

2604 Hurricane Lake Road
Bryant, AR 72019

2520 Hurricane Lake Road
Bryant, AR 72019

Please let me know what information you need from us.

Thanks so much...!!

Matthew Finley
501.231.4930
finleymatthewm@gmail.com

This message is intended for the exclusive use of the intended addressee. If you have received this message in error or are not the intended addressee or his or her authorized agent, please notify me immediately by e-mail, discard any paper copies and delete all electronic files of this message.



Colton Leonard <cleonard@cityofbryant.com>

Final Plat and As Built_Sky Blue Duplexes

1 message

kazi hopeconsulting.com <kazi@hopeconsulting.com>

Mon, Jun 30, 2025 at 4:41 PM

To: Colton Leonard <cleonard@cityofbryant.com>

Cc: Matthew Finley <finleymatthewm@gmail.com>, "jonathanlhope@gmail.com" <jonathanlhope@gmail.com>

Colton,

Please see the attached final plat and as-built. Please let us know if you have any questions.

Sky Blue Duplexes Subdivision - Final Plat

Public Works

1. Provide documentation that the private force main has been pressure tested. **Owner has discussed and resolved this issue with city utility department.**
2. Provide utility as-builts. **Attached here.**
3. Water meter boxes need to be cleared of debris and setters straightened. **Owner is aware of this and will be taken care of.**
4. Parking lot is not paved completely. **As built parking area has been shown in the as built plan.**
5. Proof of Street Light Purchase is required. **As been confirmed. Please see the confirmation attachment.**
6. No Parking signs along Hurricane Lake Rd need to be installed. **It is under process to be installed and will be done before 14th.**

Stormwater

1. Detention basin, basin components and stabilization are not complete. **Under process and will be completed this week.**
2. Site stabilization not complete. **Under process and will be completed this week.**
3. Ditch along Hurricane Lake Road is silted in. It will be required to be dugout for proper flow and solid sod stabilized. **Under process and will be completed this week.**

Engineering

1. Field inspections indicate that the site is not complete and does not meet the requirements for approval of a final plat.
2. Do the lot areas shown include the dedicated right of way? **Addressed in the final plat.**
3. The lot boundaries should be shown to the new right of way line, but not include the dedicated right of way. The subdivision boundary should include the dedicated right of way. **Addressed in the final plat.**
4. Signatures and dates are required on all certification statements. **Will be provided after the final approval.**
5. The detention pond does not comply with the requirements in the City's stormwater management manual. **Under process and will be completed this week.**

Planning

1. Verify the detention basin has been completed and inspected by stormwater. **Under process and will be completed this week.**
2. Verify parking area and access drives have been installed. **Shown in the as built plan.**
3. Verify widened driveway aprons have been installed. (Large tapered radius to provide slight de-acceleration area. **Shown in the as built plan.**
4. Final Plat fees will need to be paid. **The owner will be paying the fees.**
5. Note on the plat for the decorative fencing called out in front of the duplexes. Specification for that should be shown on the plans.
6. Note stating the approvals for the setback variances given on Lot 2 will need to be included on the plat. Include dates those approvals were given. **Mentioned in the final plat.**

•

--

Thank you,

Kazi Islam, PE

www.hopeconsulting.com

129 N. Main Street

Benton, Arkansas 72015

Telephone: (501) 315-2626

3 attachments



19-0066-Final Plat-06-30-2025.pdf

724K



19-0066-As-Builts-06-30-2025.pdf

1111K



Street Lighting Confirmation email..pdf

224K

**Approved by Joe Henry
Bryant Public Works 6/30/2025**

SIGN A 20' SETBACK FROM PROPERTY LINE

85°17'06" W 250.10'

CONCRETE

EX. LIGHT TO REMAIN

25'

SET CHISELED X

NEW SIGN SEE ARCH FOR DETAIL

N 04°42'54" E 53.18'

SIGN

SET 1/2" REBAR

N 70°37'13" W 22.95'

FND. 1/2" REBAR

20'

PROPERTY LINE

S 00°39'52" E 43.18'

FND. 1/2" REBAR

S 70°42'47" W 61.38'



City of Bryant, Arkansas
Community Development
210 SW 3rd Street Bryant, AR 72022
501-943-0943

SIGN PERMIT APPLICATION

Applicants are advised to read the Sign Ordinance prior to completing and signing this form.

The Sign Ordinance is available at www.cityofbryant.com under the Planning and Community Development tab.

Date: 06/10/2025

Note: Electrical Permits may be Required, Please contact the Community Development Office for more information.

Sign Co. or Sign Owner

Name ARKANSAS SIGN & NEON
Address 8525 DISTRIBUTION DR
City, State, Zip LITTLE ROCK AR 72209
Phone 501.562.3942
Email Address lora@arkansassign.com

Property Owner

Name PANERA BREAD
Address 23146 I-30
City, State, Zip BRYANT AR
Phone _____
Email Address _____

GENERAL INFORMATION

Name of Business PANERA BREAD
Address/Location of sign 23146 I-30, BRYANT AR
Zoning Classification _____

Please use following page to provide details on the signs requesting approval. Along with information provided on this application, a **Site Plan showing placement of sign(s) and any existing sign(s) on the property is required** to be submitted. **Renderings of the sign(s) showing the correct dimensions is also required** to be submitted with the application. A thirty-five dollar (\$35) per sign payment will be collected at the time of permit issuance. According to the Sign Ordinance a fee for and sign variance or special sign permit request shall be one hundred dollars (\$100). Additional documentation may be required by Sign Administrator.

READ CAREFULLY BEFORE SIGNING

JOB COSTS - \$20000.00

Lora A. Rand

, do hereby certify that all information contained within this application is true and correct. I fully understand that the terms of the Sign Ordinance supersede the Sign Administrator's approval and that all signs must fully comply with all terms of the Sign Ordinance regardless of approval. I further certify that the proposed sign is authorized by the owner of the property and that I am authorized by the property owner to make this application. I understand

that no sign may be placed in public right of way. I understand that I must comply with all Building and Electrical Codes and that it is my responsibility to obtain all necessary permits.

Use table below to enter information regarding each sign for approval. Please use each letter to reference each sign rendering.

SIGN	Type (Façade, Pole, Monument, other)	Dimensions (Height, Length, Width)	Sqft (Measured in whole as rectangle)	Height of Sign (Measured from lot surface)		Column for Admin Certifying Approval
				Top of Sign	Bottom of Sign	
A	PYLON	10' X 12'	120SF	25'	13'	
B						
C						
E						
F						
G						




DESIGN PROPOSAL

PROJECT ID:	0641943Ar3
CLIENT:	PANERA BREAD
ADDRESS:	23146 INTERSTATE 30 BRYANT, ARKANSAS 72022
DATE:	6/ 6/ 2025
CONTACT:	DM/ SR
DESIGNER:	MAB

Pattison



1.866.635.1110
pattisonid.com

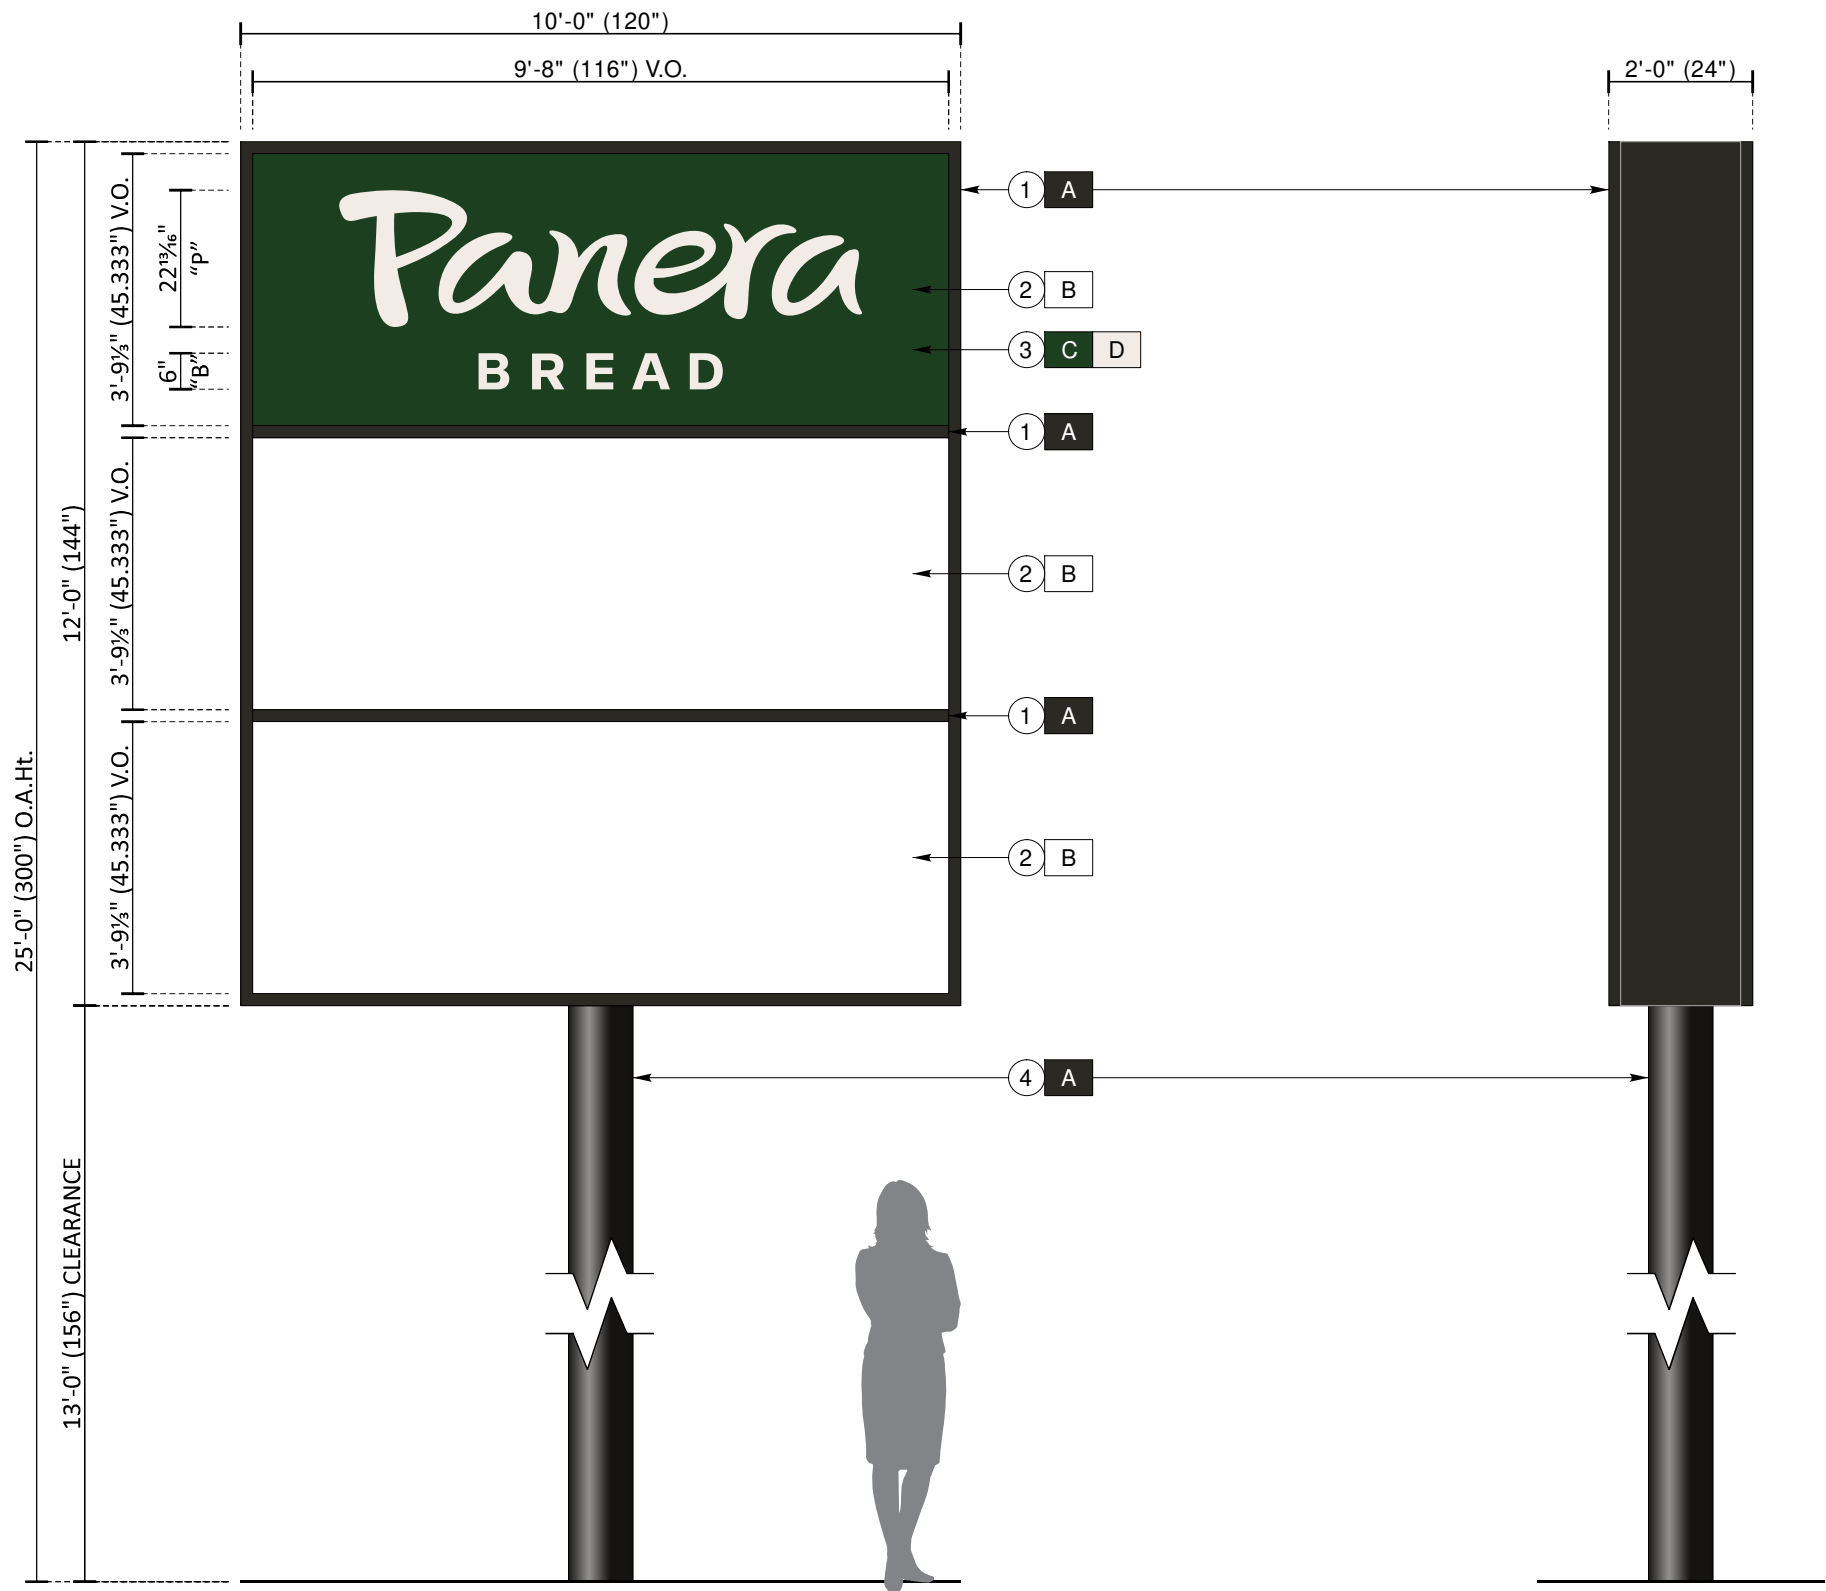

A D/ F PYLON SIGN ELEVATION SCALE: 3/8" = 1'-0"
ONE [1] REQUIRED - MANUFACTURE & INSTALL 120.0 Sq.Ft.

END VIEW

**MANUFACTURE & INSTALL ONE [1]
ILLUMINATED, DOUBLE-FACE, MULTI-
TENANT PYLON SIGN AT 25' TALL**

- | # | DESCRIPTION: |
|----|---|
| 1: | FABRICATED ALUMINUM SIGN CABINET w/ 2" RETAINERS & DIVIDERS - INTERNALLY-ILLUMINATED w/ 6500k WHITE LED's |
| 2: | UV RESISTANT POLYCARBONATE TENANT FACES |
| 3: | 1st SURFACE DIGITALLY-PRINTED "PANERA BREAD" GRAPHICS |
| 4: | STD. STEEL PIPE SUPPORT SET IN A CONCRETE PIER FOUNDATION AS REQ'D PER CODE |

20' SETBACK FROM PL

#	COLORS:
A	P.T.M. PANTONE BLACK c
B	#7328 WHITE POLYCARBONATE
C	DIGITALLY-PRINTED PM S2411c GREEN
D	DIGITALLY-PRINTED PM S9285c CREAM

Project ID
0641943Ar3

PANERA BREAD
23146 I-30
BRYANT, AR 72022

Date: 3/17/25
Contact: DM/SR
Designer: MAB

Sign Item

A: D/ F PYLON SIGN

Scale: 3/8" = 1'-0"

Revision Notes

r1-TS-3/20/25: Color changes & Opt. increase to 25' tall 3 tenant panels
r2-MAB-4/23/25: Change from plate-mount to direct burial
r2-MAB-6/6/25: Omit 20' O.A.Ht. option

**Information Required
for Production**

Customer Approval

Signature

MM/DD/YYYY

All rights reserved. The artwork depicted herein are copyrighted and are the exclusive property of Pattison ID, and as such cannot be reproduced and/or distributed, in whole or in part, without written permission of Pattison ID.


It is the Customer's responsibility to ensure that the sign installation location is suitable to accept and support the installation of the signs being ordered. Notify Pattison ID immediately if further details are required.

NOTE: TECHNICAL SURVEY HAS NOT BEEN PERFORMED. DIMENSIONS MUST BE VERIFIED PRIOR TO PRODUCTION.

Pattison



1.866.635.1110
pattisonid.com

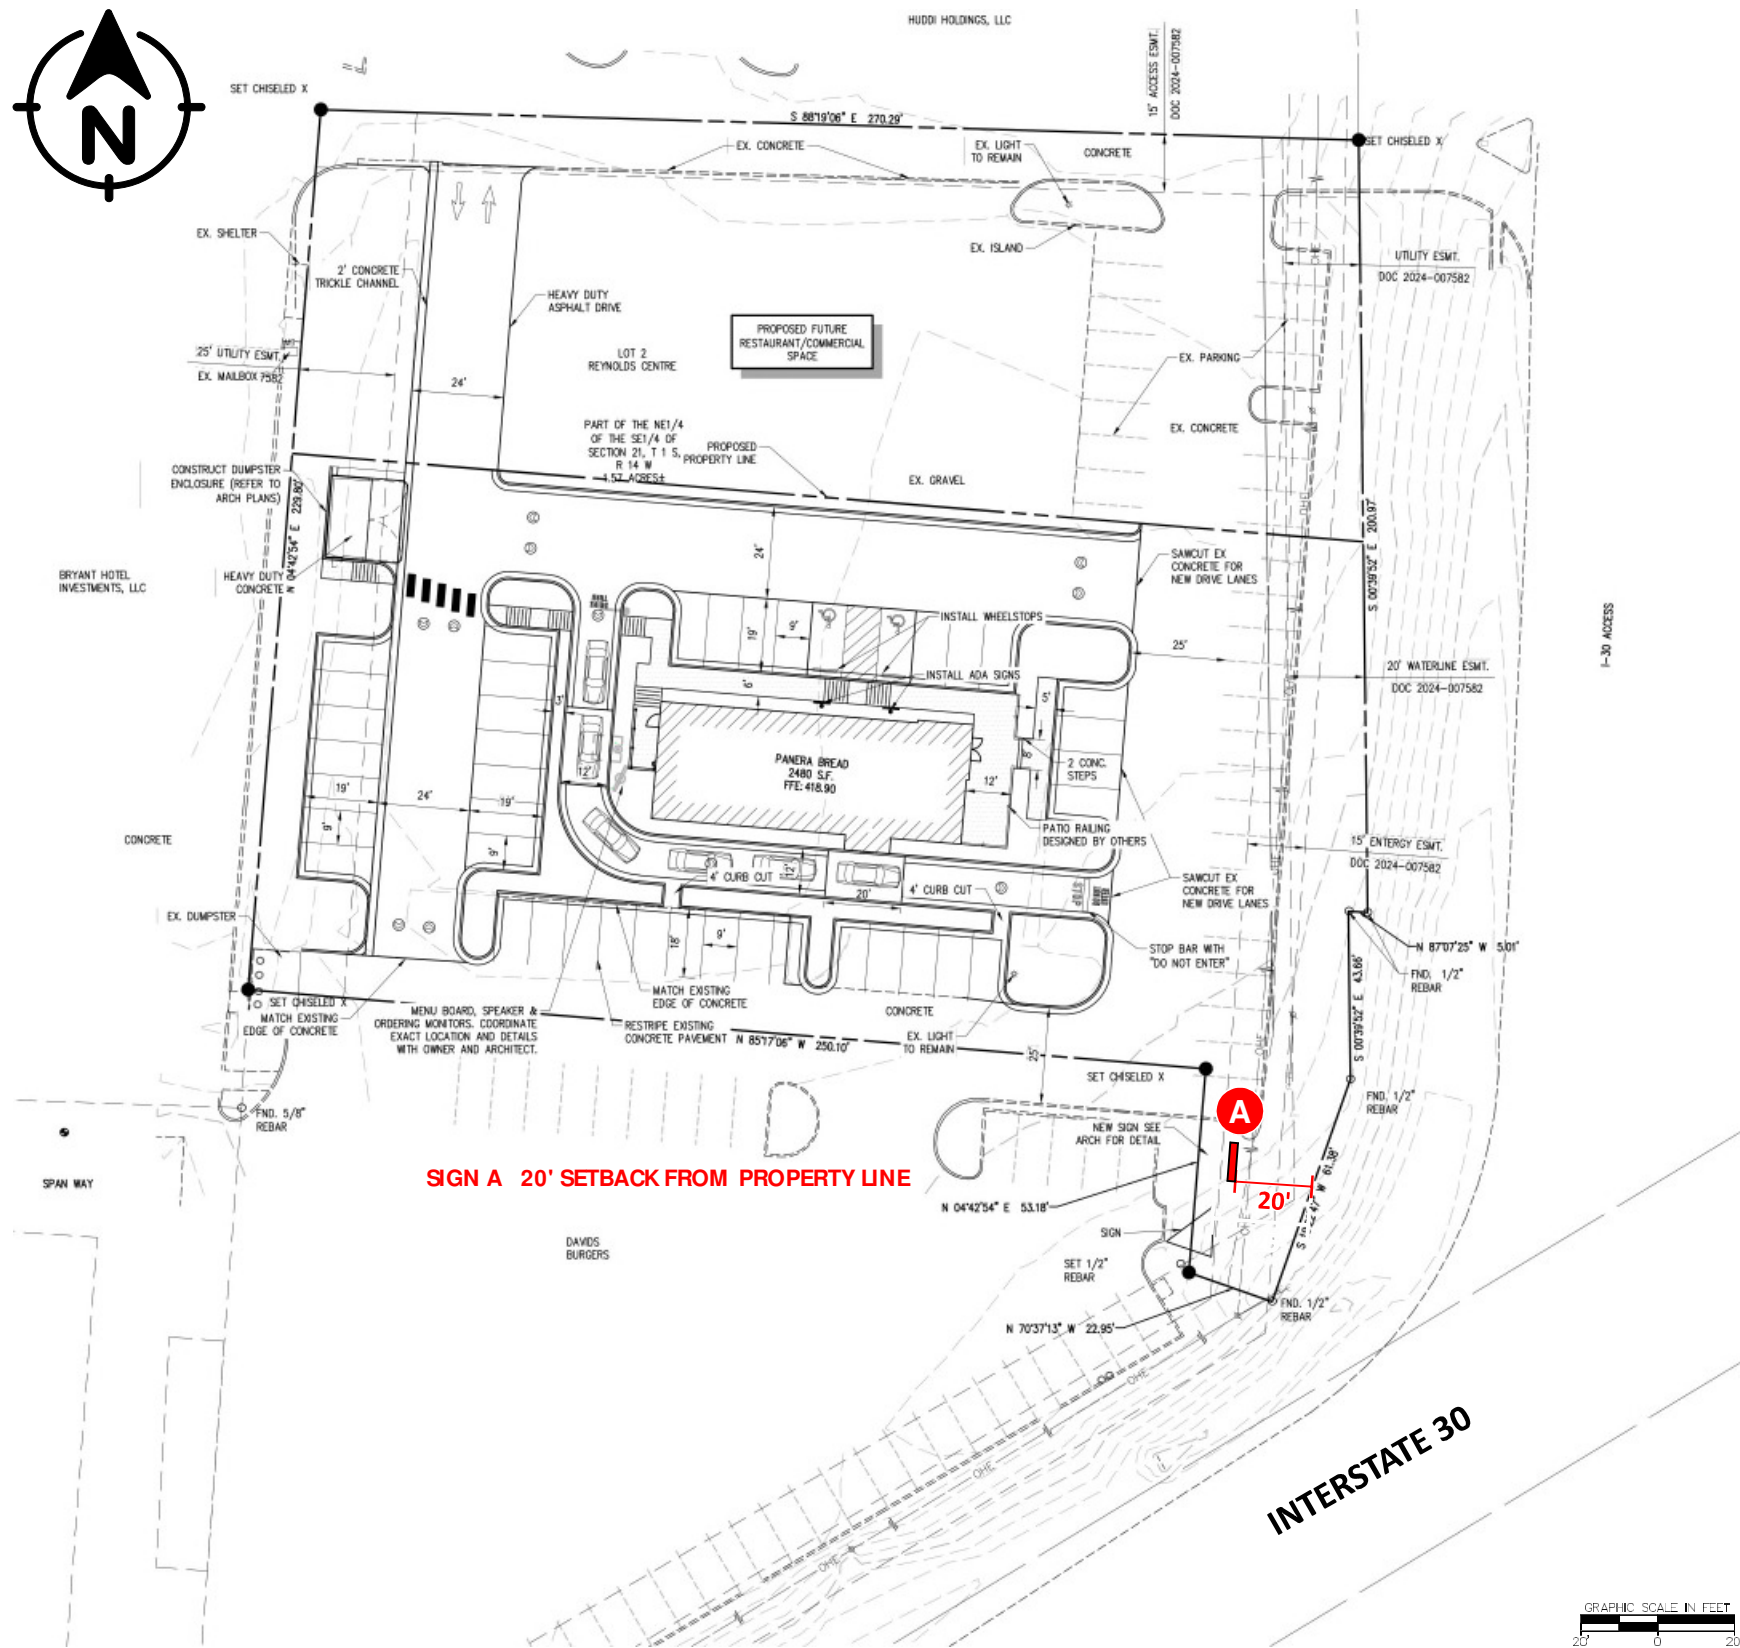

SITE PLAN

SCALE: 1" = 50'-0"

NOTE: TECHNICAL SURVEY HAS NOT BEEN PERFORMED. DIMENSIONS MUST BE VERIFIED PRIOR TO PRODUCTION.

Project ID
0641943Ar3

PANERA BREAD

23146 I-30

BRYANT, AR 72022

Date: 3/17/25

Contact: DM/SR

Designer: MAB

Sign Item

SITE PLAN

Scale: 1" = 50'-0"

Revision Notes

r1-TS-3/20/25: Color changes & Opt. increase to 25' tall 3 tenant panels

r2-MAB-4/23/25: Change from plate-mount to direct burial

r2-MAB-6/6/25: Omit 20' O.A.Ht. option

Information Required
for Production

Customer Approval

Signature

MM/DD/YYYY

All rights reserved. The artwork depicted herein are copyrighted and are the exclusive property of Pattison ID, and as such cannot be reproduced and/or distributed, in whole or in part, without written permission of Pattison ID.

It is the Customer's responsibility to ensure that the sign installation location is suitable to accept and support the installation of the signs being ordered. Notify Pattison ID immediately if further details are required.

Pattison



1.866.635.1110
pattisonid.com

Limits of liability extend only to the work detailed, for the quantity of assemblies indicated (1 unless noted otherwise), at the location specified, and by the client listed; use of these plans and/or corresponding structural calculations in violation of either voids all liability.

GENERAL

- ALL MATERIALS AND WORK SHALL CONFORM TO THE REQUIREMENTS OF THE 2021 INTERNATIONAL BUILDING CODE (IBC).
- CONSTRUCTION METHODS AND PROJECT SAFETY: DRAWINGS AND SPECIFICATIONS REPRESENT THE FINISHED STRUCTURE AND DO NOT INDICATE METHODS, PROCEDURES, OR SEQUENCE OF CONSTRUCTION. TAKE NECESSARY PRECAUTIONS TO MAINTAIN AND ENSURE THE INTEGRITY OF THE STRUCTURE DURING CONSTRUCTION. THE EOR WILL NOT ENFORCE SAFETY MEASURES OR REGULATIONS. THE CONTRACTOR SHALL DESIGN, CONSTRUCT, AND MAINTAIN ALL SAFETY DEVICES AND SHALL BE SOLELY RESPONSIBLE FOR CONFORMING TO ALL LOCAL, STATE, AND FEDERAL SAFETY AND HEALTH STANDARDS, LAWS, AND REGULATIONS.
- VERIFY ALL DIMENSIONS, ELEVATIONS AND SITE CONDITIONS PRIOR TO THE START OF CONSTRUCTION AND NOTIFY THE ENGINEER IMMEDIATELY OF ANY DISCREPANCIES OR INCONSISTENCIES THAT ARE FOUND. NOTED DIMENSIONS TAKE PRECEDENCE OVER SCALED DIMENSIONS. DO NOT SCALE DRAWINGS.
- ALL OMISSIONS AND/OR CONFLICTS BETWEEN THE VARIOUS ELEMENTS OF THE WORKING DRAWINGS AND SPECIFICATIONS SHALL BE BROUGHT TO THE ATTENTION OF THE ENGINEER AND FIELD INSPECTOR. THE ENGINEER SHALL PROVIDE A SOLUTION PRIOR TO PROCEEDING WITH ANY WORK AFFECTED BY THE CONFLICT OR OMISSION.
- WHERE NO CONSTRUCTION DETAILS ARE SHOWN OR NOTED FOR ANY PART OF THE WORK, USE THOSE FOR OTHER SIMILAR WORK.
- WHEN A DETAIL IS IDENTIFIED AS TYPICAL, APPLY IN ESTIMATING AND CONSTRUCTION TO EVERY LIKE CONDITION WHETHER OR NOT THE REFERENCE IS REPEATED IN EVERY INSTANCE.
- CHANGES TO THE DRAWINGS: OBTAIN PRIOR WRITTEN APPROVAL.
- WORK PERFORMED IN CONFLICT WITH THE DRAWINGS OR APPLICABLE BUILDING CODE REQUIREMENTS SHALL BE CORRECTED AT THE EXPENSE OF THE CONTRACTOR.

DESIGN CRITERIA

- STRUCTURE IS DESIGNED IN ACCORDANCE WITH ASCE 7-16: MINIMUM DESIGN LOADS FOR BUILDINGS AND OTHER STRUCTURES.
- WIND LOAD:
BASIC WIND SPEED, V_{ULT} = 105 MPH MAXIMUM
RISK CATEGORY: II EXPOSURE: C
- SNOW LOAD:
IMPORTANCE FACTOR, I_s = 1.0
SURFACE ROUGHNESS: C EXPOSURE: C
GROUND 10 PSF MAXIMUM.
ROOF --- PSF
4. ROOF LIVE LOAD: --- PSF

STEEL

- STEEL SHAPES SHALL CONFORM TO THE FOLLOWING (U.N.O.):
RND. HSS ASTM A500, GR C $F_y=46$ KSI MIN.
SQ./RECT. HSS ASTM A500, GR C $F_y=50$ KSI MIN.
THREADED ROD ASTM A36 $F_y=36$ KSI MIN.
STEEL PLATE ASTM A36 $F_y=36$ KSI MIN.
ANGLE & CHANNEL ASTM A36 $F_y=36$ KSI MIN.
STD. PIPE ASTM A53, GR B $F_y=35$ KSI MIN.
STRUCT. PIPE ASTM A252, GR 3 $F_y=45$ KSI MIN.
WIDE FLANGE ASTM A992 $F_y=50$ KSI MIN.
- MACHINE BOLTS SPECIFIED AS "A307" SHALL CONFORM TO ASTM A307 w/ NUTS PER ASTM A563A & WASHERS PER ASTM F844 (U.N.O.). THREADED PARTS, NUTS, AND WASHERS SHALL BE HDG OR ZP AS DEFINED HEREIN.
- STRUCTURAL BOLTS SHALL CONFORM TO ASTM F3125 GRADES A325 OR A490 AS SPECIFIED ("A325" OR "A490") w/ NUTS PER ASTM A563DH & WASHERS PER ASTM F436.
A. WHERE DESIGNATED AS "-X", CARE MUST BE TAKEN TO ENSURE THREADS ARE EXCLUDED FROM THE SHEAR PLANE(S).
B. WHERE DESIGNATED AS "-N" OR IF NO DESIGNATION IS NOTED, THREADS MAY BE INCLUDED IN THE SHEAR PLANE(S).
C. WHERE SPECIFIED, "A325" MAY BE HDG OR ZP AS DEFINED HEREIN.
D. GRADE "A490" SHALL NOT BE HDG OR ZP AS DEFINED HEREIN.
- ANCHORS CAST IN CONCRETE SHALL CONFORM TO ASTM F1554 GR. 36 (U.N.O.) w/ NUTS TO ASTM A563 AND WASHERS TO ASTM F436. PARTS SHALL BE HOT-DIP GALVANIZED (HDG) OR ZINC (MECHANICAL) PLATED (ZP). PARTS EMBEDDED ENTIRELY IN CONCRETE MAY BE PLAIN STEEL.
- WHERE SPECIFIED FOR STEEL THREADED PARTS, NUTS, AND WASHERS, HOT-DIP GALVANIZING (HDG) SHALL CONFORM TO ASTM F2329 AND ZINC (MECHANICAL) PLATING (ZP) TO CLASS 55 PER ASTM B695.
- PLAIN STEEL FASTENERS ARE NOT TO BE USED UNLESS SPECIFIED.
- ZINC ELECTRO-PLATED FASTENERS PER ASTM F1941 MAY BE SUBSTITUTED FOR INTERIOR APPLICATIONS, BUT ARE OTHERWISE NOT TO BE USED UNLESS SPECIFIED.
- NUTS AND WASHERS SHALL HAVE THE SAME COATING AS THE CORRESPONDING THREADED PART.
- WHERE SPECIFIED, IRON AND STEEL HARDWARE SHALL BE HOT-DIP GALVANIZED PER ASTM A153.
- STAINLESS STEEL (SS) BOLTS, STUDS, AND THREADED ROD SHALL CONFORM TO ASTM F593 AND BE ALLOY 304 OR 316 w/ NUTS TO ASTM F594. NUTS AND WASHERS SHALL MATCH THE ALLOY OF THE THREADED PART.
- WELDING:
A. WELD STRUCTURAL STEEL IN COMPLIANCE WITH AWS/AWS D1.1 AND AISC SPECIFICATION, CHAPTER J. WELDERS SHALL BE CERTIFIED AS REQUIRED BY THE LOCAL BUILDING AUTHORITY. WELDING SHALL BE DONE BY ELECTRIC ARC PROCESS USING LOW-HYDROGEN ELECTRODES WITH SPECIFIED TENSILE STRENGTH NOT LESS THAN 70 KSI UNLESS NOTED OTHERWISE.
B. UNLESS A LARGER WELD SIZE IS INDICATED, PROVIDE MINIMUM SIZE WELD PER AISC SPECIFICATION, SECTION J2, TABLE J2.4.

ALUMINUM

- FABRICATE AND ERECT ALUMINUM IN COMPLIANCE WITH THE 2020 ALUMINUM DESIGN MANUAL (ADM1), THE SPECIFICATIONS FOR ALUMINUM SHEET METAL WORK (ASM35), AND CHAPTER 20 OF THE BUILDING CODE.
- ALUMINUM SHAPES SHALL CONFORM TO THE FOLLOWING:
PIPE & TUBE 6061-T6 ASTM B429 $F_y=35$ KSI MIN.
STRUCT. PROFILES 6061-T6 ASTM B308 $F_y=35$ KSI MIN.
SHEET & PLATE 6061-T6 ASTM B209 $F_y=35$ KSI MIN.
STAPLE TUBE 6063-T5 ASTM B221 $F_y=16$ KSI MIN.

- ALL SHOP AND FIELD WELDS SHALL BE PERFORMED BY AN AISC QUALITY CERTIFIED FABRICATOR.
- UNLESS A LARGER WELD SIZE IS INDICATED, PROVIDE MINIMUM SIZE WELD PER ADM 1.
- FILLER SHALL BE 5556 ALLOY REGARDLESS OF MEMBER THICKNESS. NO OTHER FILLER ALLOY SHALL BE USED UNLESS NOTED OTHERWISE.

CONCRETE & REINFORCEMENT

- MINIMUM 28-DAY COMPRESSIVE STRENGTH (f_c) SHALL BE 2,500 PSI.
- REINFORCEMENT TO BE ASTM A615 GR 60, $F_y=60$ KSI UNO.
- CALCIUM CHLORIDE OR ADDED CHLORIDE IS NOT PERMITTED.
- ALL REINFORCED CONCRETE SHALL BE CONSOLIDATED WITH MECHANICAL VIBRATORS.
- MINIMUM CONCRETE COVER:
CAST AGAINST & EXPOSED TO EARTH 3"
EXPOSED TO EARTH OR WEATHER 2"
- CHAIRS AND SPACERS: AS REQUIRED TO MAINTAIN COVER.
- SIGN MAY BE INSTALLED ON FOUNDATION AFTER A MINIMUM CURING TIME OF (14) DAYS PROVIDED CURING PROCESS IS PROPERLY MAINTAINED PER ACI 318.
- GROUT SHALL BE NON-SHRINK AND NON-METALLIC WITH A MINIMUM COMPRESSIVE STRENGTH OF 5,000 PSI AT (1) DAY. MIX AND PLACE IN ACCORDANCE WITH MANUFACTURER INSTRUCTIONS.

FOUNDATIONS

- DESIGN BEARING PRESSURES ARE PER IBC CLASS 4 PRESUMPTIVE VALUES (NO SPECIAL INSPECTION REQUIRED):
LATERAL BEARING: 150 PSF/FT
VERTICAL BEARING: 2,000 PSF

EXISTING CONDITIONS

- ENGINEER WILL NOT BE PERFORMING ON-SITE INSPECTIONS OR VERIFICATIONS. IT IS THE RESPONSIBILITY OF THE INSTALLER AND OWNER(S) TO IDENTIFY EXISTING CONDITIONS AND CONTACT ENGINEER WITH ANY DISCREPANCIES OR CONCERNS.
- EXISTING INFORMATION HAS BEEN FURNISHED BY THE ENTITY WHOM THIS DOCUMENT WAS PREPARED FOR. ENGINEER IN NO WAY CERTIFIES THIS INFORMATION AS "AS-BUILT".
- FEATURES OF WORK ANNOTATED AS "VERIFY" (OR SIMILAR) MUST BE INSPECTED, VERIFIED AS SUCH, AND DOCUMENTED PRIOR TO FABRICATION AND INSTALLATION.
- IF THERE IS ANY REASON TO BELIEVE THE EXISTING CONDITIONS DETAILED HEREIN ARE NOT ACCURATE, CONTRACTOR SHALL CEASE WORK AND NOTIFY ENGINEER IMMEDIATELY.
- CONTRACTOR SHALL INSPECT AND CONFIRM THE QUALITY OF EXISTING STRUCTURE AS "IN GOOD REPAIR". STRUCTURE SHALL BE FREE OF CORROSION, DECAY, AND ANY OTHER MATERIAL, FABRICATION, ASSEMBLY, OR INSTALLATION DEFECT. IF THERE ARE ANY INDICATIONS THAT THIS IS NOT THE CASE, CONTRACTOR SHALL CEASE WORK IMMEDIATELY AND NOTIFY ENGINEER.

THIS AREA INTENTIONALLY LEFT BLANK

EVALUATION REPORT SCHEDULE

ANCHORS, FASTENERS, AND OTHER PRODUCTS SHALL CONFORM TO AND BE INSTALLED PER THEIR RESPECTIVE EVALUATION REPORT(S) AS FOLLOWS (NOT ALL APPLICABLE THIS PROJECT):

ANCHOR TYPE	REPORT #
HILTI KB-T22 (C5 & S5) ANCHORS IN CONCRETE	ICC-ESR-4266
HILTI KB-T22 (C5 & S5) ANCHORS IN MASONRY	ICC-ESR-4561
HILTI KH-EZ (C5 & S5) ANCHORS IN CONCRETE	ICC-ESR-3027
HILTI KH-EZ (C5 & S5) ANCHORS IN MASONRY	ICC-ESR-3056
HILTI HIT-HY 200 ADHESIVE IN CONCRETE	ICC-ESR-3187
HILTI HIT-HY 200 ADHESIVE IN MASONRY	ICC-ESR-3963
SIMPSON TITEN HD (C5) ANCHORS IN CONCRETE	ICC-ESR-2713
SIMPSON TITEN HD (C5 & S5) ANCHORS IN MASONRY	ICC-ESR-1056
SIMPSON TITEN HD (S5) ANCHORS IN CONCRETE	UES-ER-493
TAPCON ANCHORS IN MASONRY	ICC-ESR-1671
TAPCON ANCHORS IN CONCRETE	ICC-ESR-2202
TAPCON+ SCREW ANCHORS IN CONCRETE	ICC-ESR-3699
ITW BUILDEX TEKS SD5	ICC-ESR-1976

ABBREVIATIONS

ABV. ABOVE	HDG	GENERAL CONTRACTOR
ADD'L. ADDITIONAL	HOR.	HOT DIP GALVANIZED
APF ABOVE FINISHED FLOOR	O.C.	HORIZONTAL
ALT. ALTERNATE	LOC.	ON CENTER
ALUM. ALUMINUM	MAX.	LOCATION
A.O.R. ARCHITECT OF RECORD	MIN.	MAXIMUM
ARCH. ARCHITECTURAL	(N)	MINIMUM
BTM. BOTTOM	N.T.E.	(N) NEW
BLK'G. BLOCKING	O/	NOT TO EXCEED
CIRC. CIRCLE/CIRCULAR	O.D.	OVER
CONC. CONCRETE	OPT.	OUTSIDE DIAMETER
CONN. CONNECTION	PENE.	OPTIONAL
CONT. CONTINUOUS	REINF.	PENETRATION
CTR. CONTRACTOR	RND	REINFORCEMENT
DIA. DIAMETER	SIM.	ROUND
DET. DETAIL	SS	SIMILAR
(E) EXISTING	STD	STAINLESS STEEL
EXIST. EXISTING	SUPP.	STANDARD
EA. EACH	SQ.	SUPPLEMENTAL
E.W. EACH WAY	T/O	SQUARE
ELEV. ELEVATION	TYP.	TOP OF
EMBED. EMBEDMENT	THK.	TYPICAL
E.O.R. ENGINEER OF RECORD	U.N.O.	THICK(NESS)
FAB. FABRICATOR/FABRICATION	VERT.	UNLESS NOTED OTHERWISE
FDN. FOUNDATION	W/	VERTICAL
FRM'G. FRAMING	w/o	WITH
FTG. FOOTING	ZP	WITHOUT
F.V.V. FIELD VERIFY		ZINC (MECHANICAL) PLATED

MANUFACTURED SIGN CABINETS

UNLESS NOTED OTHERWISE, MANUFACTURED SIGN CABINETS SHALL BE DESIGNED BY THE MANUFACTURER/FABRICATOR OR OTHER COMPETENT PARTY AND FABRICATED IN ACCORDANCE WITH ALL APPLICABLE CODES, UL LISTINGS, LOCAL ORDINANCES, AND INDUSTRY STANDARDS. THIS INCLUDES FACES AND CLADDING, INTERNAL STRUCTURE, ELECTRICAL, AND ALL OTHER ACCESSORY COMPONENTS.

THE MANUFACTURER/FABRICATOR IS RESPONSIBLE FOR ENSURING ALL CABINETS ARE ASSEMBLED WITH ADEQUATE INTERNAL FRAMING AND STIFFNESS. CABINET FRAMING SHALL BE CAPABLE OF DELIVERING ALL IMPOSED DESIGN LOADS (WIND, SEISMIC, DEAD, SNOW, ETC.) DIRECTLY TO THE STRUCTURAL CONNECTIONS OR ELEMENTS DETAILED HEREIN. CABINET FRAMING SHALL LIMIT EXCESSIVE VIBRATION, DRIFT, OR DEFLECTION TO REASONABLE LEVELS.

FAILURE TO PROVIDE AN ADEQUATE LOAD PATH OR SUFFICIENT CABINET STIFFNESS MAY RESULT IN EXCESSIVE VIBRATION, DRIFT, OR DEFLECTION WHICH MAY YIELD SECOND-ORDER EFFECTS THAT CAN NEGATIVELY AFFECT THE PERFORMANCE OF THE STRUCTURAL CONNECTIONS OR ELEMENTS DETAILED HEREIN.

REVERENCE ENGINEERING MAKES NO CLAIMS AS TO THE SUITABILITY OF MANUFACTURED SIGN CABINETS IDENTIFIED AS "BY MFR." OR "BY FAB." WHICH HAVE NOT BEEN ENGINEERED, CERTIFIED, OR REVIEWED BY REVERENCE ENGINEERING UNLESS SPECIFICALLY CONTRACTED OTHERWISE AND DETAILED OR NOTED HEREIN.

DESIGN BY OTHERS NOTE

REVERENCE ENGINEERING IN NO WAY CERTIFIES OR MAKES CLAIMS TO THE SUITABILITY OF CONDITIONS OR ELEMENTS (EXISTING OR NEW) THAT ARE DESIGNED BY OTHERS. SUCH CONDITIONS AND ELEMENTS ARE IDENTIFIED AS "BY OTHERS" OR "DESIGNED" BY OTHERS" AND ARE NOT ENGINEERED BY REVERENCE ENGINEERING.

THE SCOPE OF ENGINEERING HEREIN ASSUMES THESE ELEMENTS HAVE BEEN, OR WILL BE, DESIGNED OR CHECKED FOR SUITABILITY BY A DESIGN PROFESSIONAL.

ELECTRICAL NOTE

ELECTRIC COMPONENTS AND WIRING ARE NOT DESIGNED BY REVERENCE ENGINEERING. FABRICATOR AND INSTALLER SHALL COMPLY WITH THE CURRENT VERSION OF THE ADOPTED NATIONAL ELECTRIC CODE (NEC) AND ARTICLE 600: "ELECTRIC SIGNS AND OUTLINE LIGHTING".



www.reverenceengineering.com
(619) 354-1152
501 W BROADWAY, STE 425
SAN DIEGO, CA 92101

PREPARED FOR:

PATTISON ID

PROJECT #:

2504206

PANERA BREAD
0641943 PYLON SIGN

23146 INTERSTATE 30
BRYANT, AR 72022



10-Jun-25


SHEET TITLE:

STRUCTURAL

SHEET:


S.1

ORIGINAL SHEET SIZE: 11x17

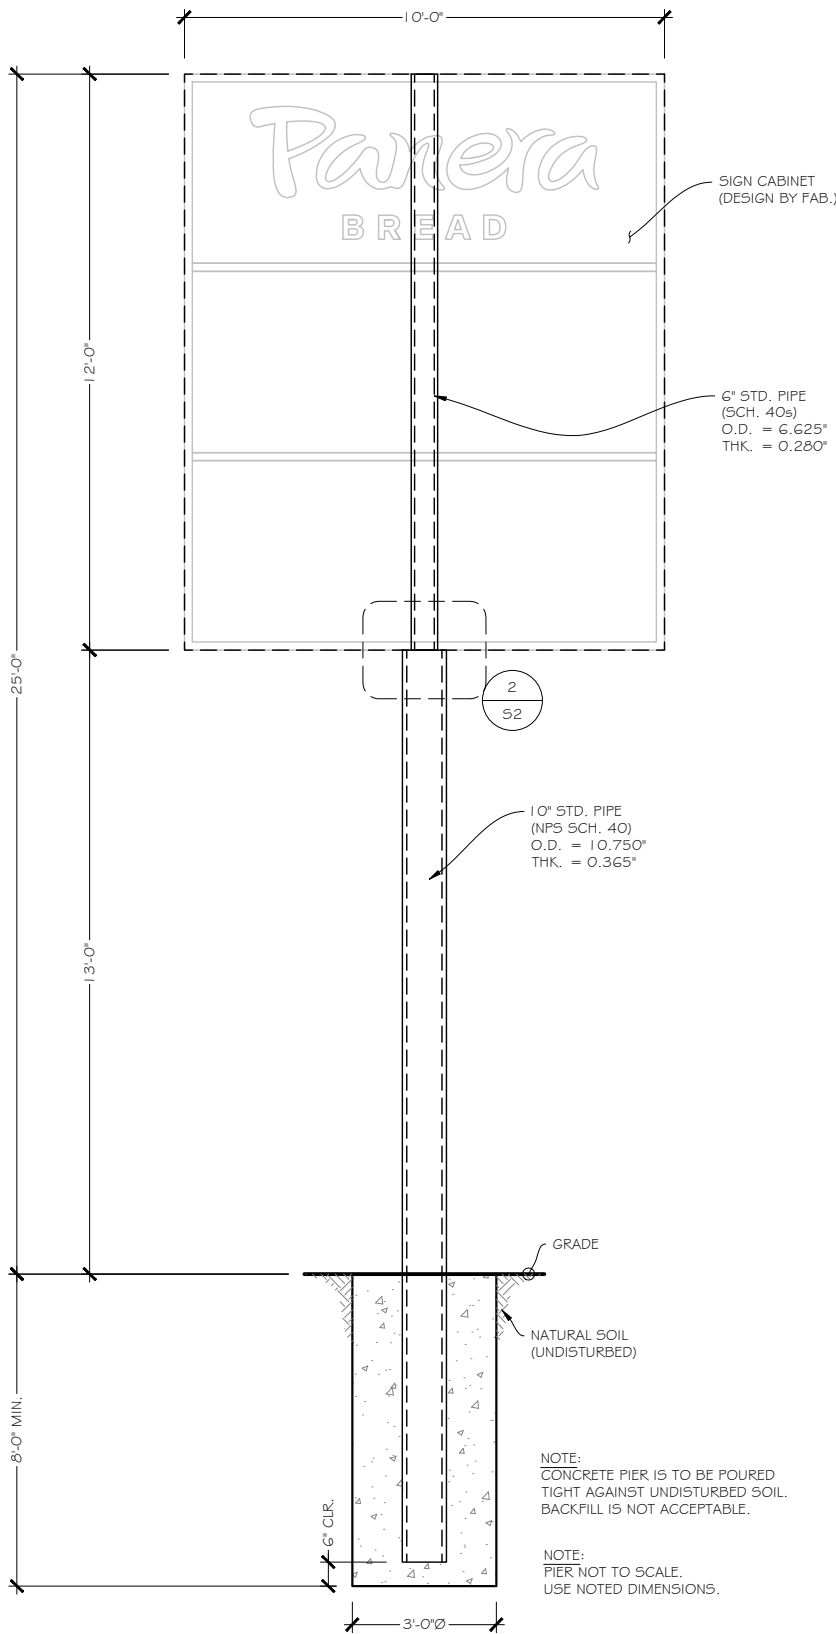

1

ELEVATION

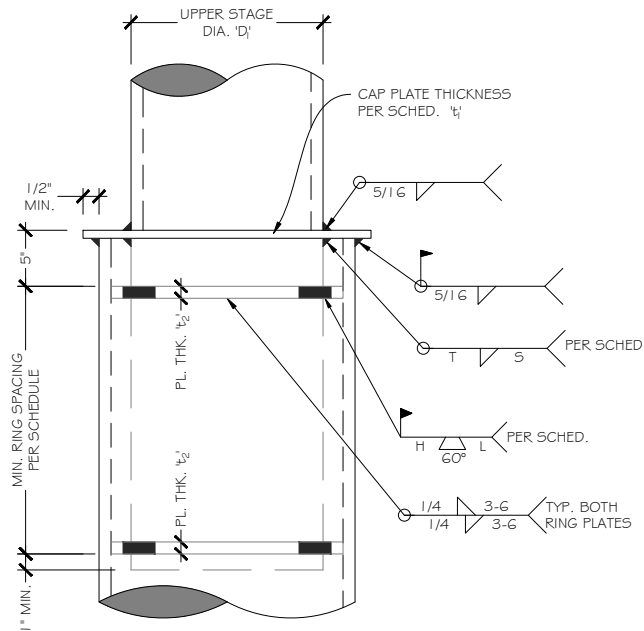

UPPER STAGE DIA. "D ₁ "	RING SPACING	CAP PL. THK. "t ₁ "	RING PL. THK. "t ₂ "	# SLOTS / RING PL.	WELD SIZES		SLOT WELDS	
					T	S	H	L
< 12"	18"	3/4"	3/4"	4	1/4"	5-6	5/8"	1-3/4"
12" - 18"	30"	3/4"	1"	6	5/16"	5-6	7/8"	2"
20" - 24"	36"	1"	1"	6	5/16"	11-12	7/8"	2-1/4"
26" - 30"	48"	1"	1-1/4"	8	5/16"	11-12	1"	2-1/2"
32" - 42"	66"	1-1/2"	1-1/4"	8	5/16"	11-12	1"	3"
48" - 54"	84"	1-1/2"	1-1/4"	10	5/16"	11-12	1"	3-1/2"
60" - 66"	102"	2"	1-1/4"	12	5/16"	11-12	1"	4"
72" - 96"	144"	2"	1-1/4"	16	5/16"	11-12	1-1/8"	4"

2

CONNECTION DETAIL



www.reverenceengineering.com
(619) 354-1152
501 W BROADWAY, STE 425
SAN DIEGO, CA 92101

PREPARED FOR:
PATTISON ID

PROJECT #:
2504206

PANERA BREAD
0641943 PYLON SIGN
23146 INTERSTATE 30
BRYANT, AR 72022

No.	Issue/Revision:	Date:
1	Initial Submittal	6-10-2025



SHEET TITLE:
STRUCTURAL

SHEET:
S.2

ORIGINAL SHEET SIZE: 11x17

Limits of liability extend only to the work detailed, for the quantity of assemblies indicated (unless noted otherwise), at the location specified, and by the client listed; use of these plans and/or corresponding structural calculations in violation of either voids all liability.

The designs, details and specifications contained in this drawing are confidential. The recipients of this drawing hereby acknowledge and agree that it is the sole property of Reverence Engineering and that they shall neither use nor reveal any of the designs, details and specifications contained in this drawing, outside of the contractual agreement expressed written permission from Reverence Engineering. Deviations from this drawing shall not be made without consulting Reverence Engineering. In case of incongruities between drawings, specifications, and details included in contract documents, Reverence Engineering shall decide which indication must be followed and their decision shall be final. Copyright Reverence Engineering. All rights reserved.

March 27, 2025

Colton Leonard
City of Bryant
Planning and Development
210 SW 3rd Street
Bryant, AR 72022

Subject: Final Plat – Midland Road, Bryant, AR (Parcel #840-11633-707)





Dear Colton,

On behalf of our client, Havens Development, I am formally requesting staff review for the Final Plat of Parcel # 840-11633-707 located on Midland Road, Bryant, AR. This project will have sewer provided by Bryant, Electric is provided by Entergy and First Electric, and Water is provided by Water Users. This property has been annexed as well. We would like to be included in the April 14th Planning Commission Meeting at 6:00 P.M. We thank you for your review and look forward to addressing any comments.


Please feel free to contact me with any questions, concerns, or if I can be of any further assistance.

Sincerely,




Jonathan Hope

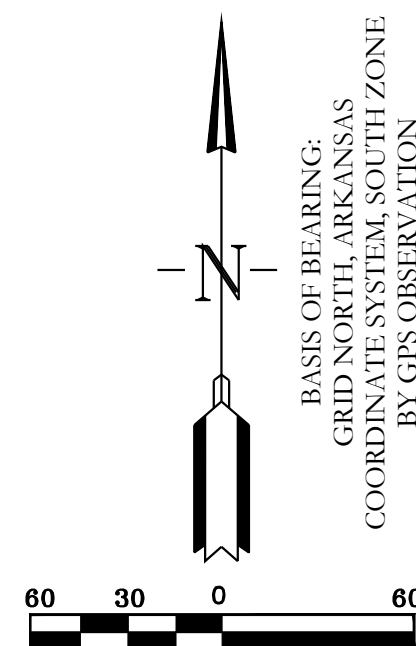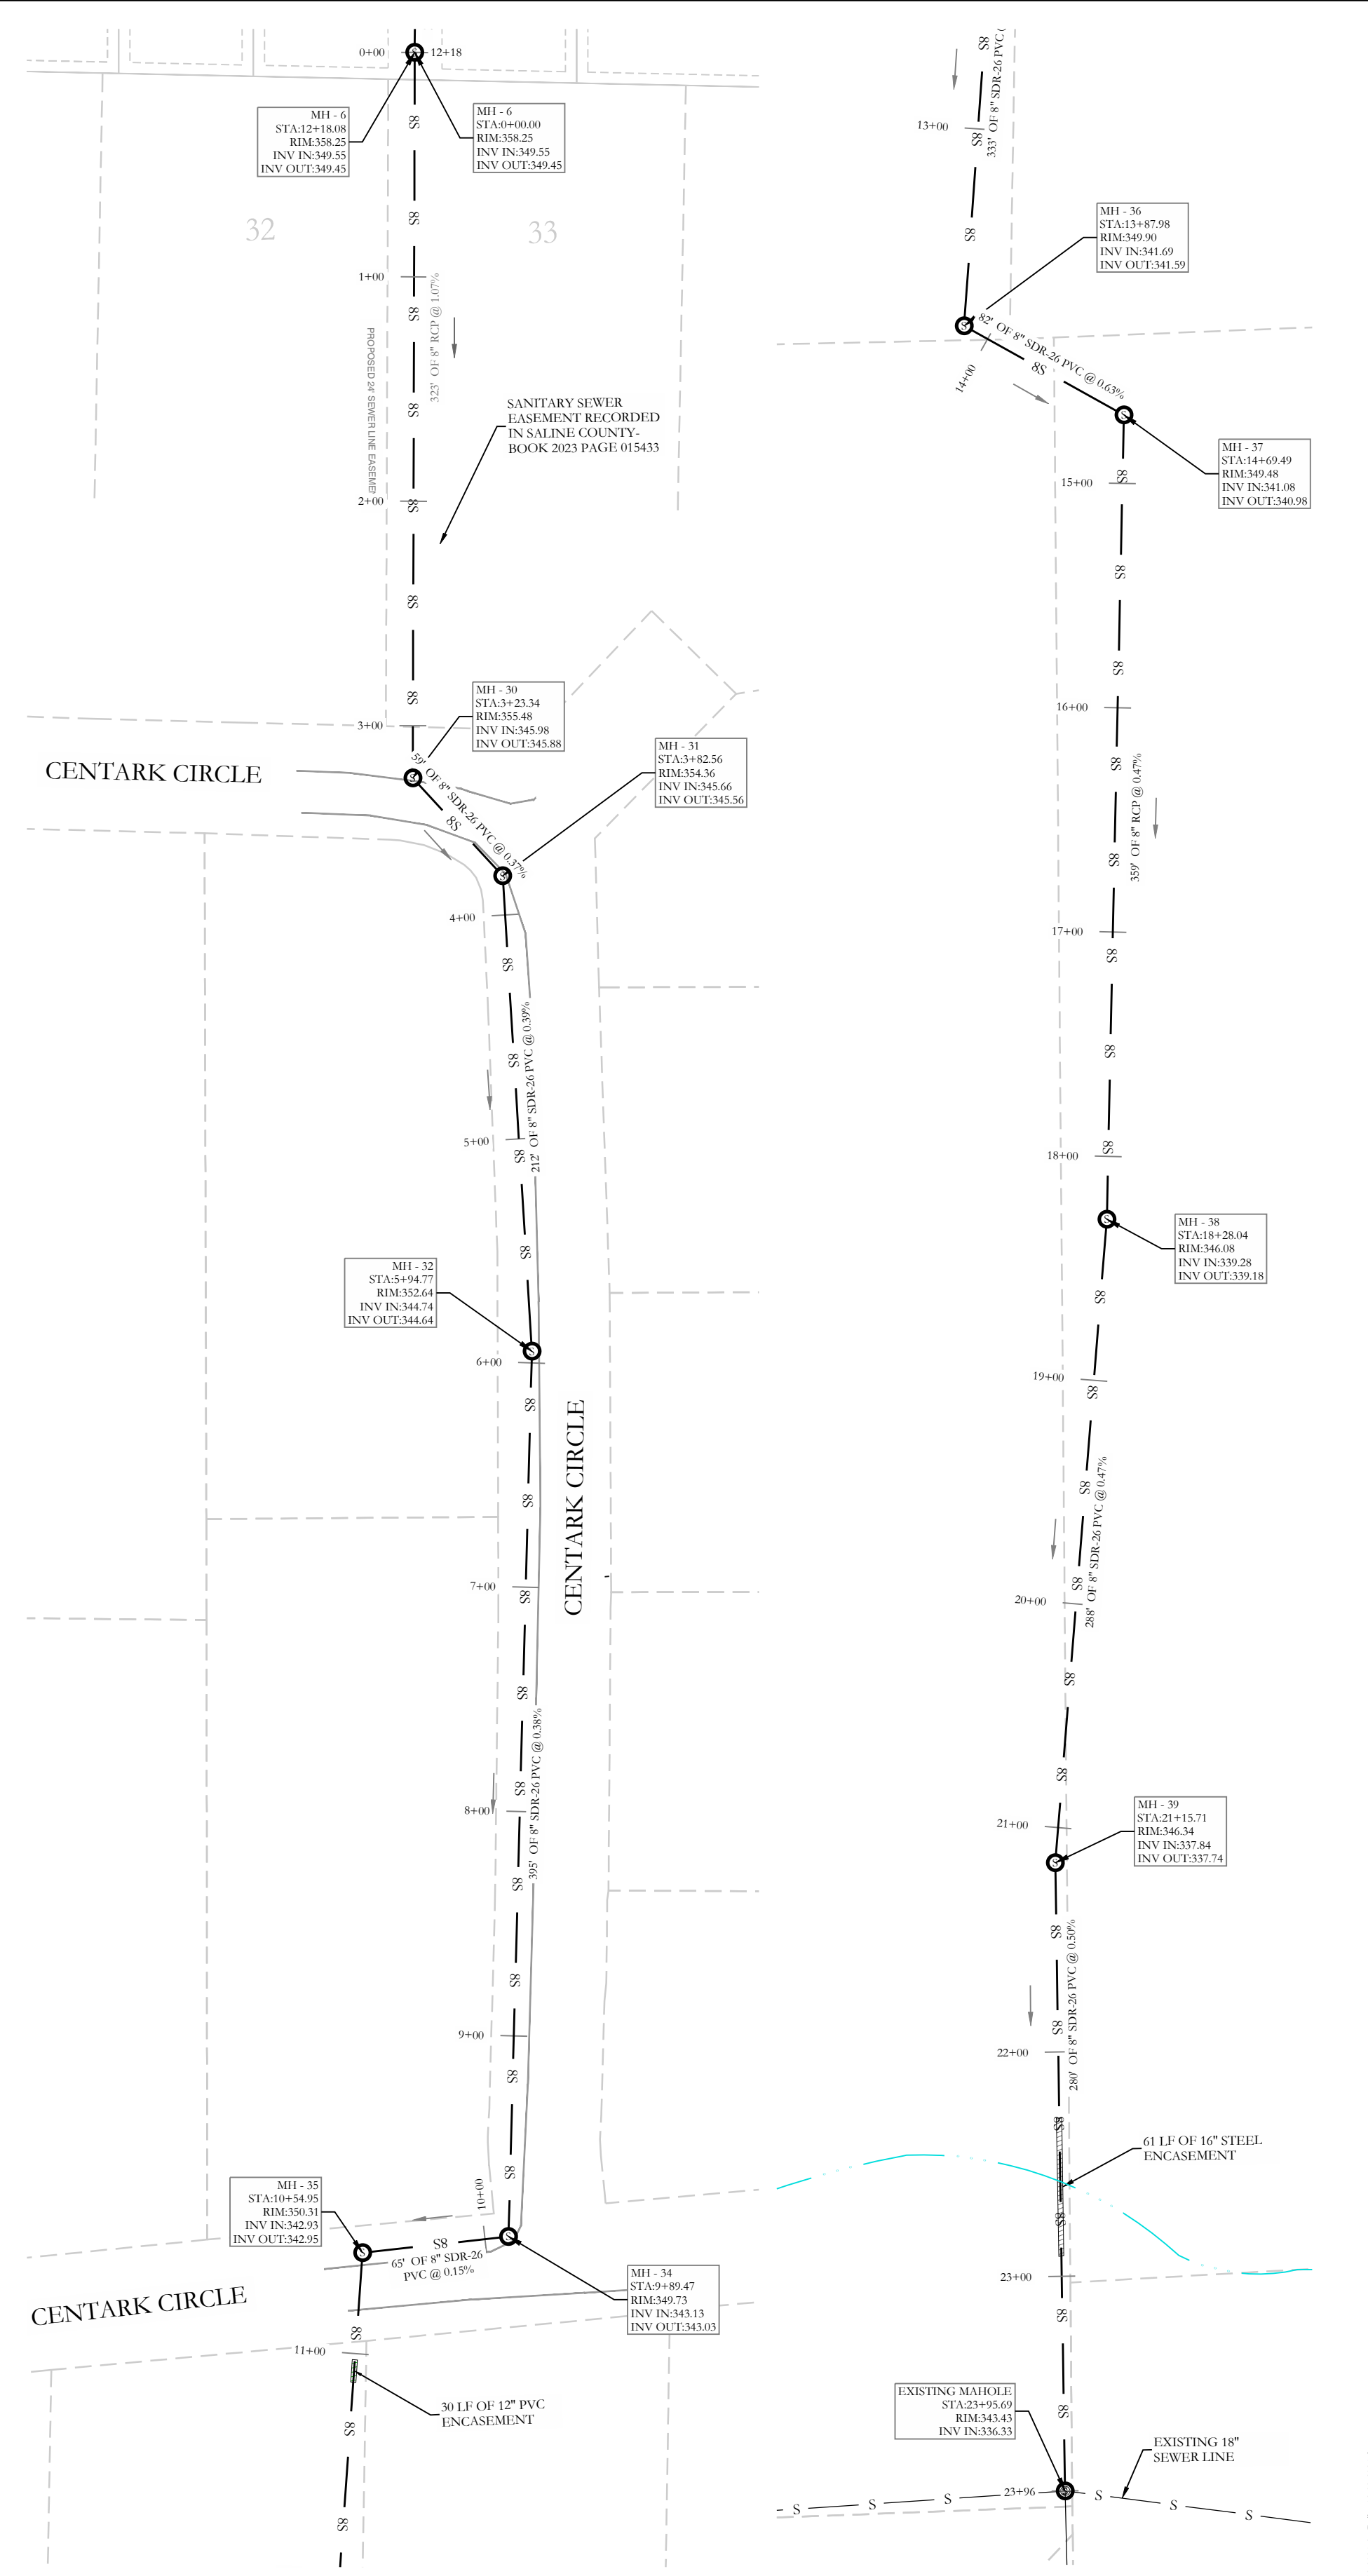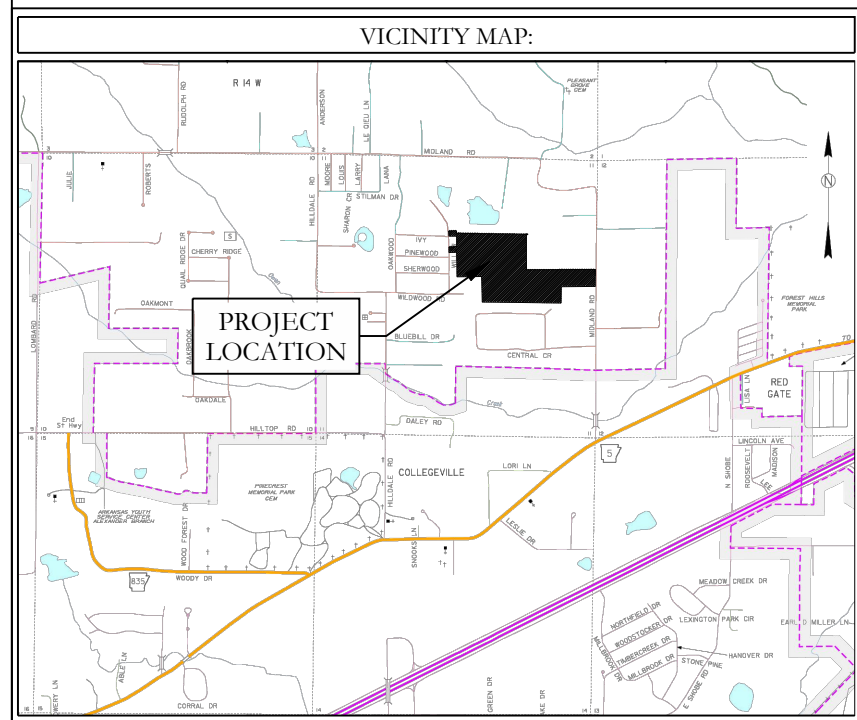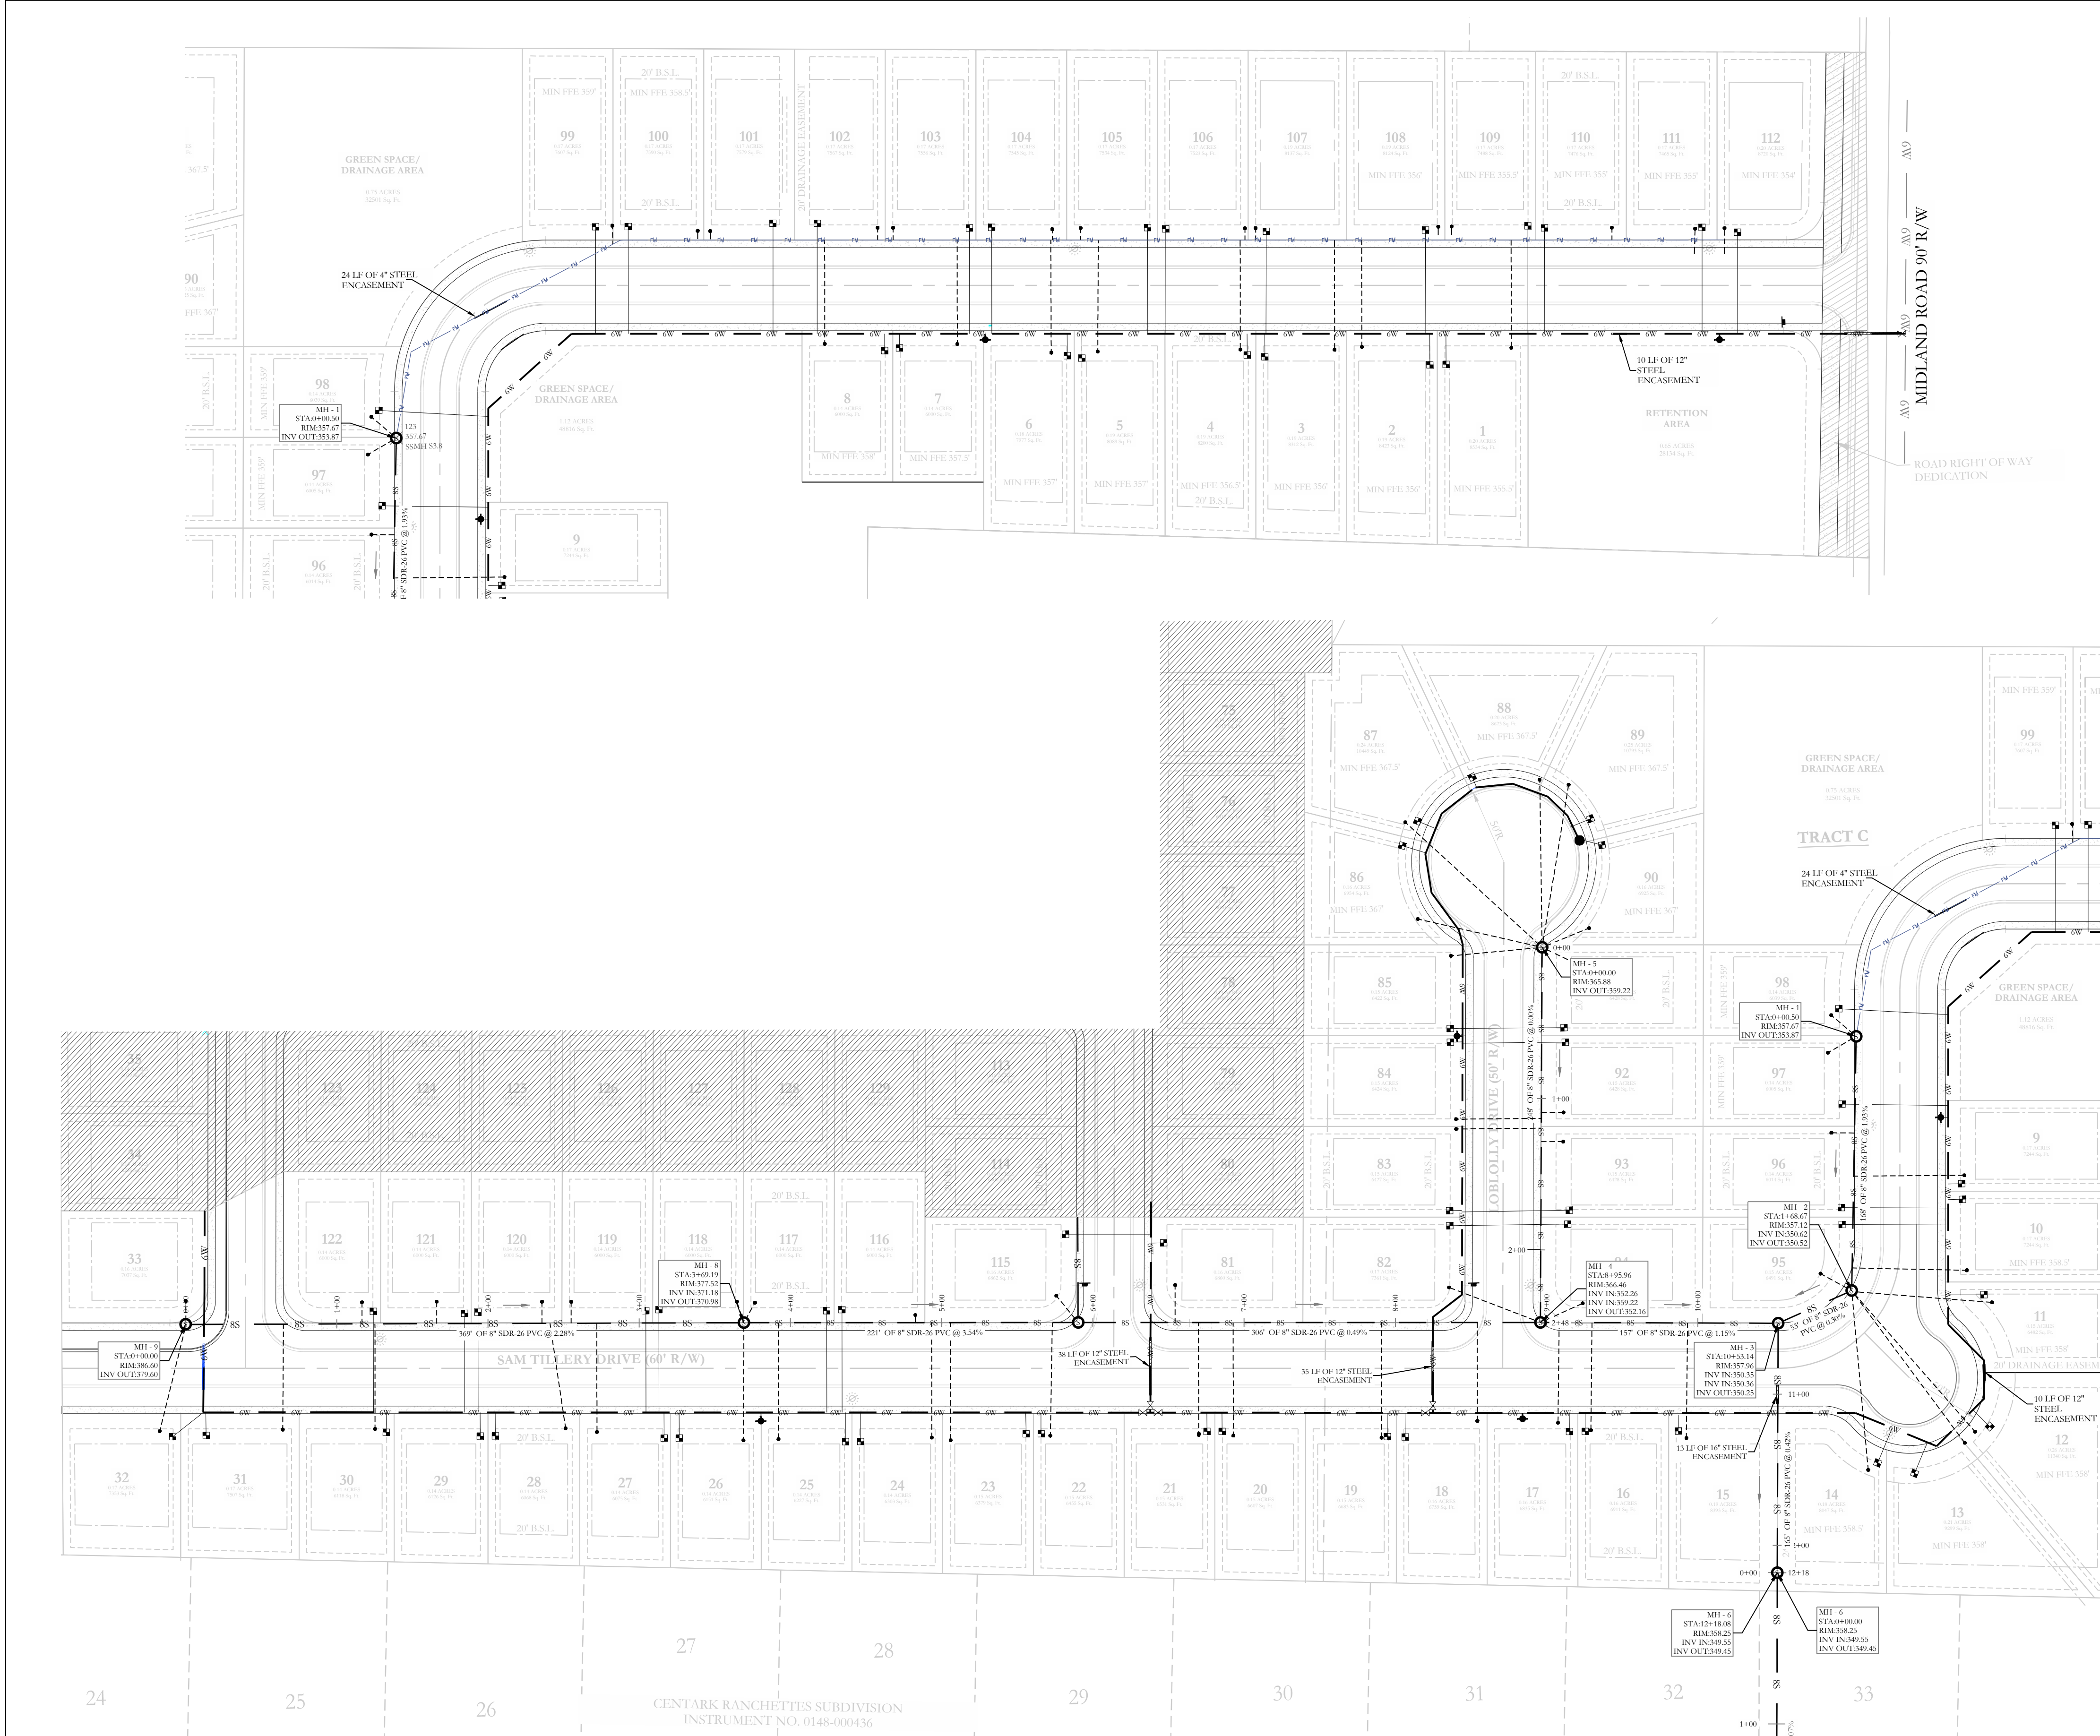

HOPE CONSULTING ENGINEERS - SURVEYORS		
129 North Main Street, Benton, Arkansas 72015 PH. (501)315-2626 FAX (501) 315-0024 www.hopeconsulting.com		
FOR USE AND BENEFIT OF: HAVEN'S DEVELOPMENT, LLC		
SANITARY SEWER AS-BUILTS MIDLAND ROAD ESTATES IN THE CITY OF BRYANT, SALINE COUNTY, ARKANSAS		
DATE: 12/13/2024	C.A.D. BY:	DRAWING NUMBER:
REVISED:	CHECKED BY:	23-0024
SHEET:	SCALE: 1" = 60'	
500	0	

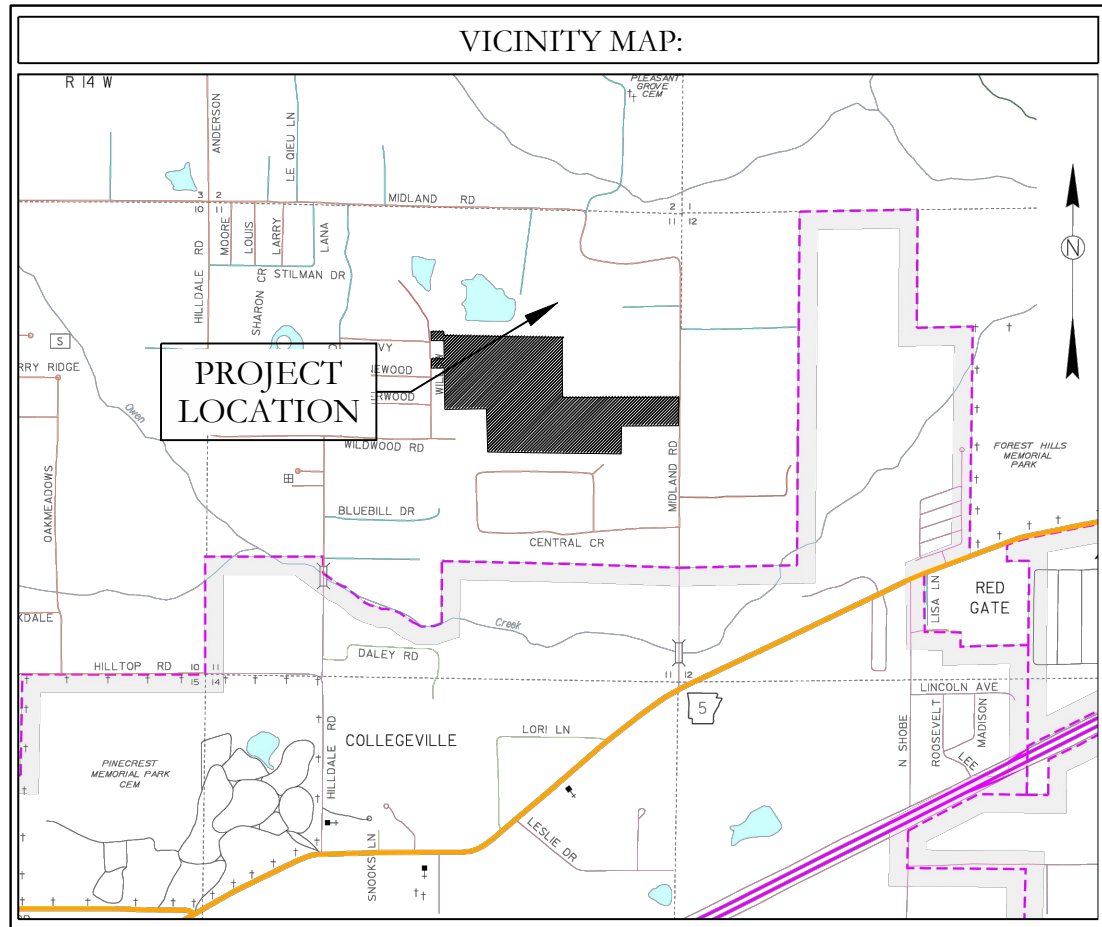

--- HDPE
--- RCP

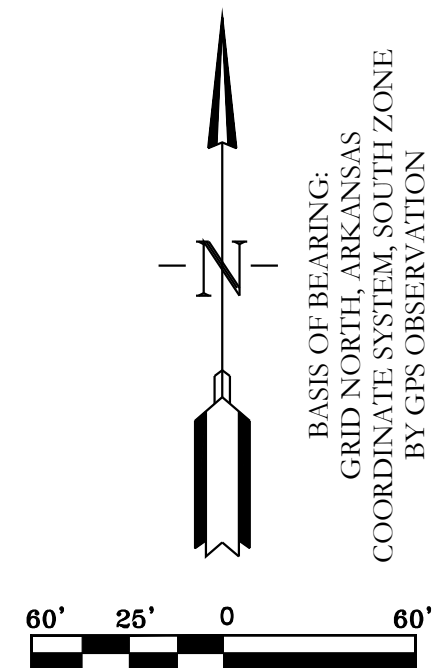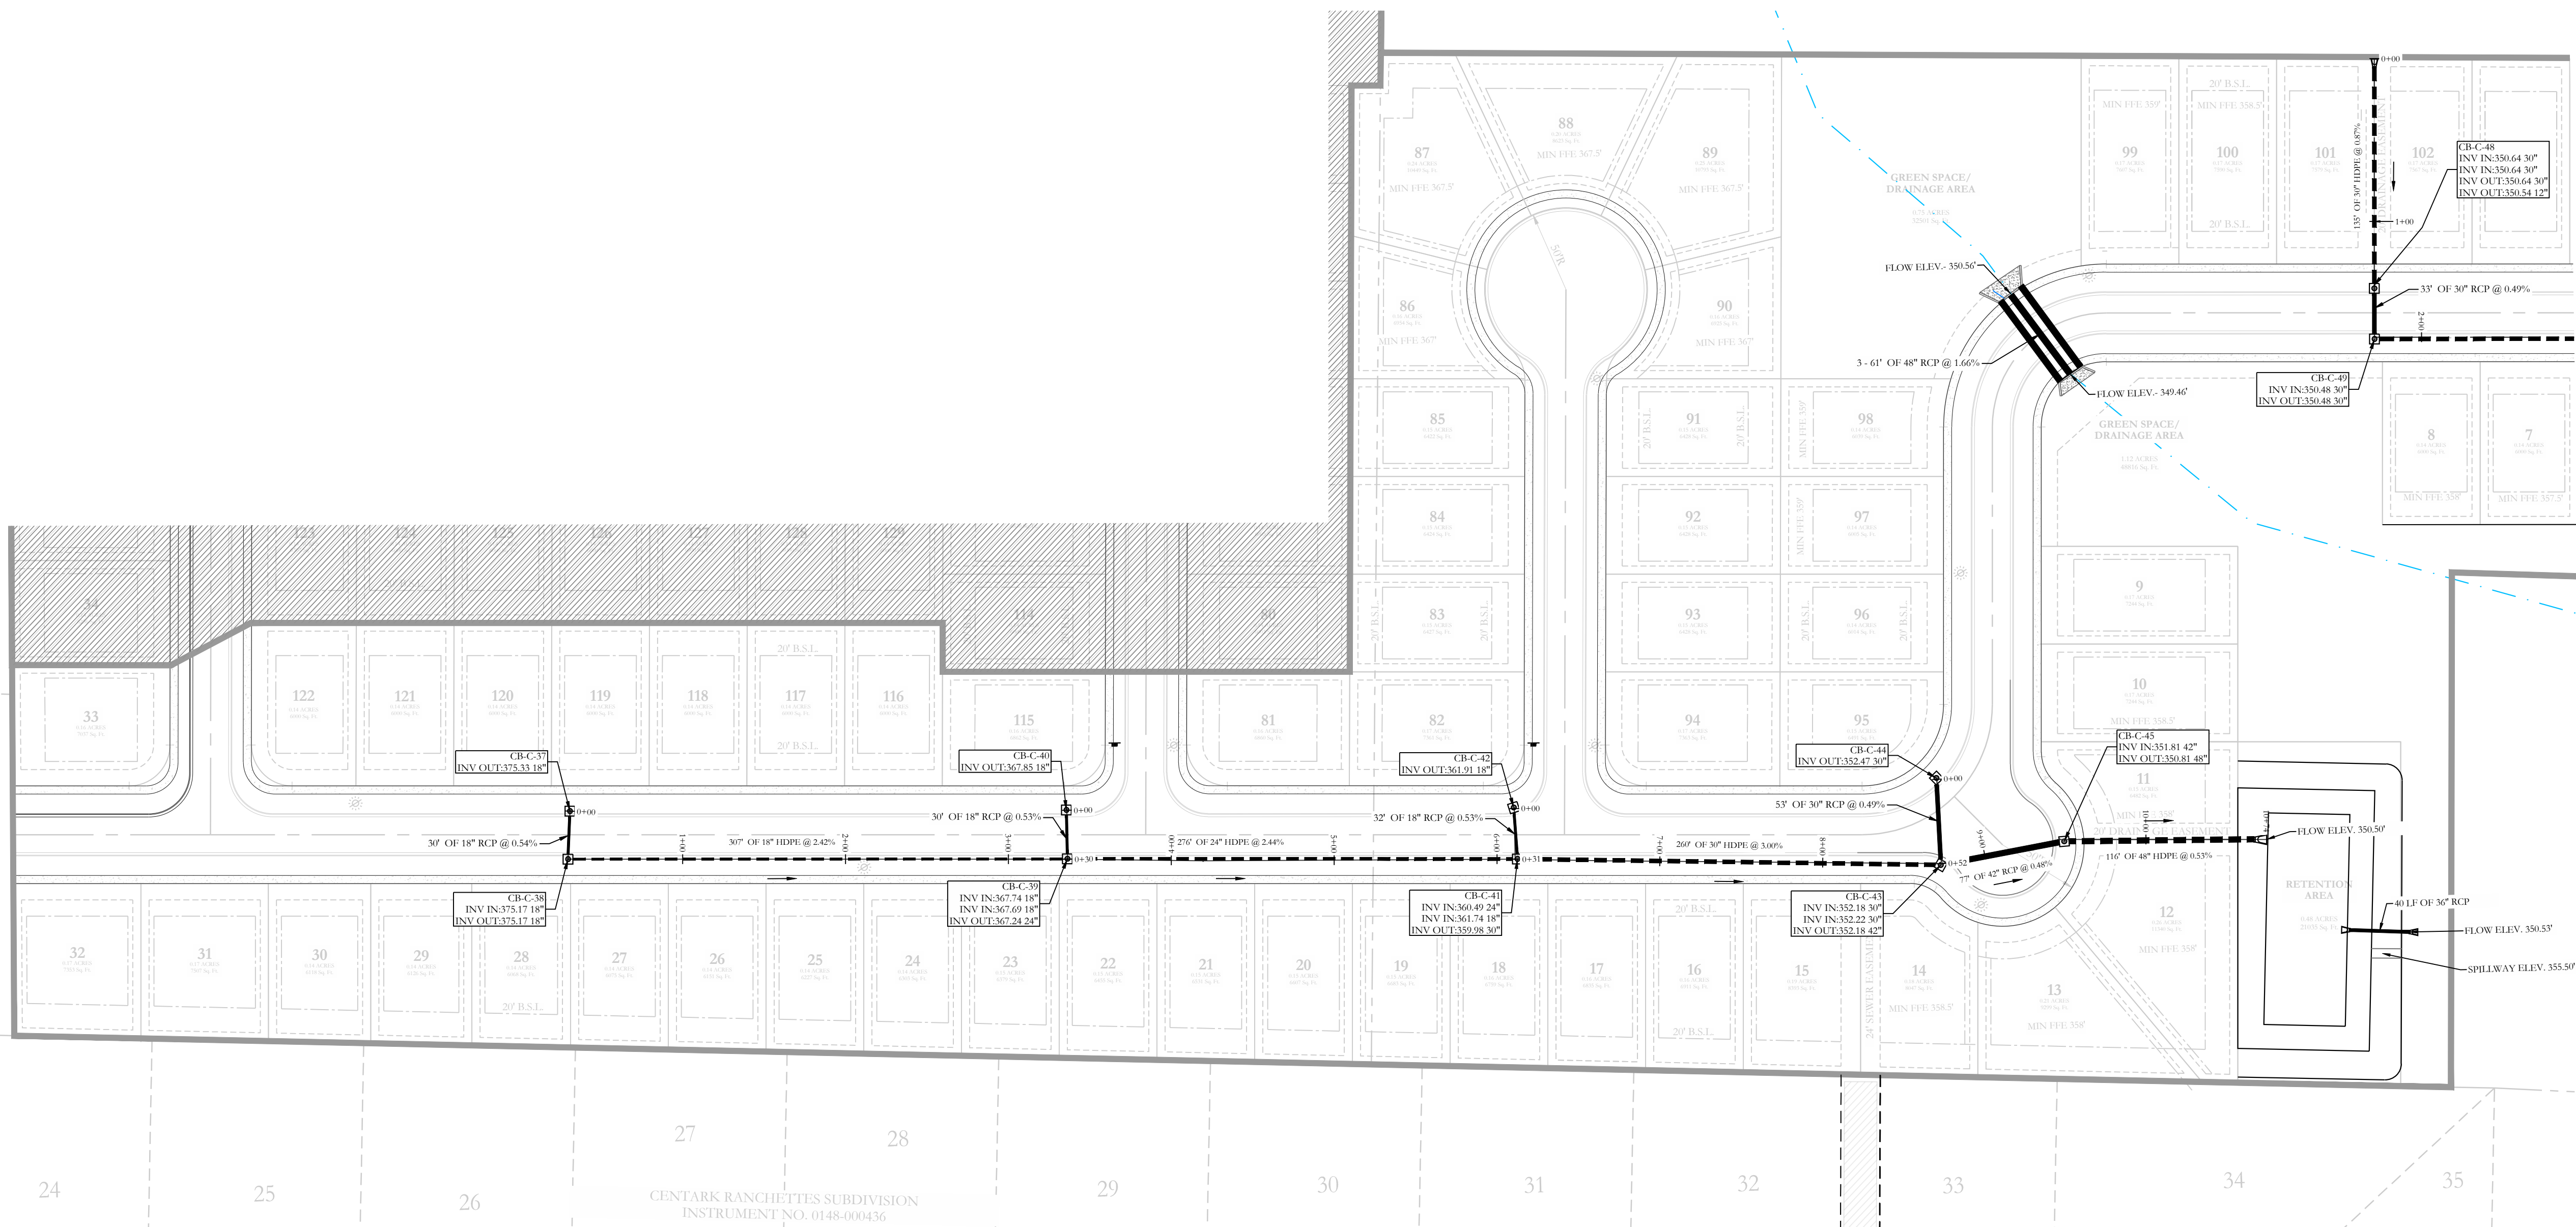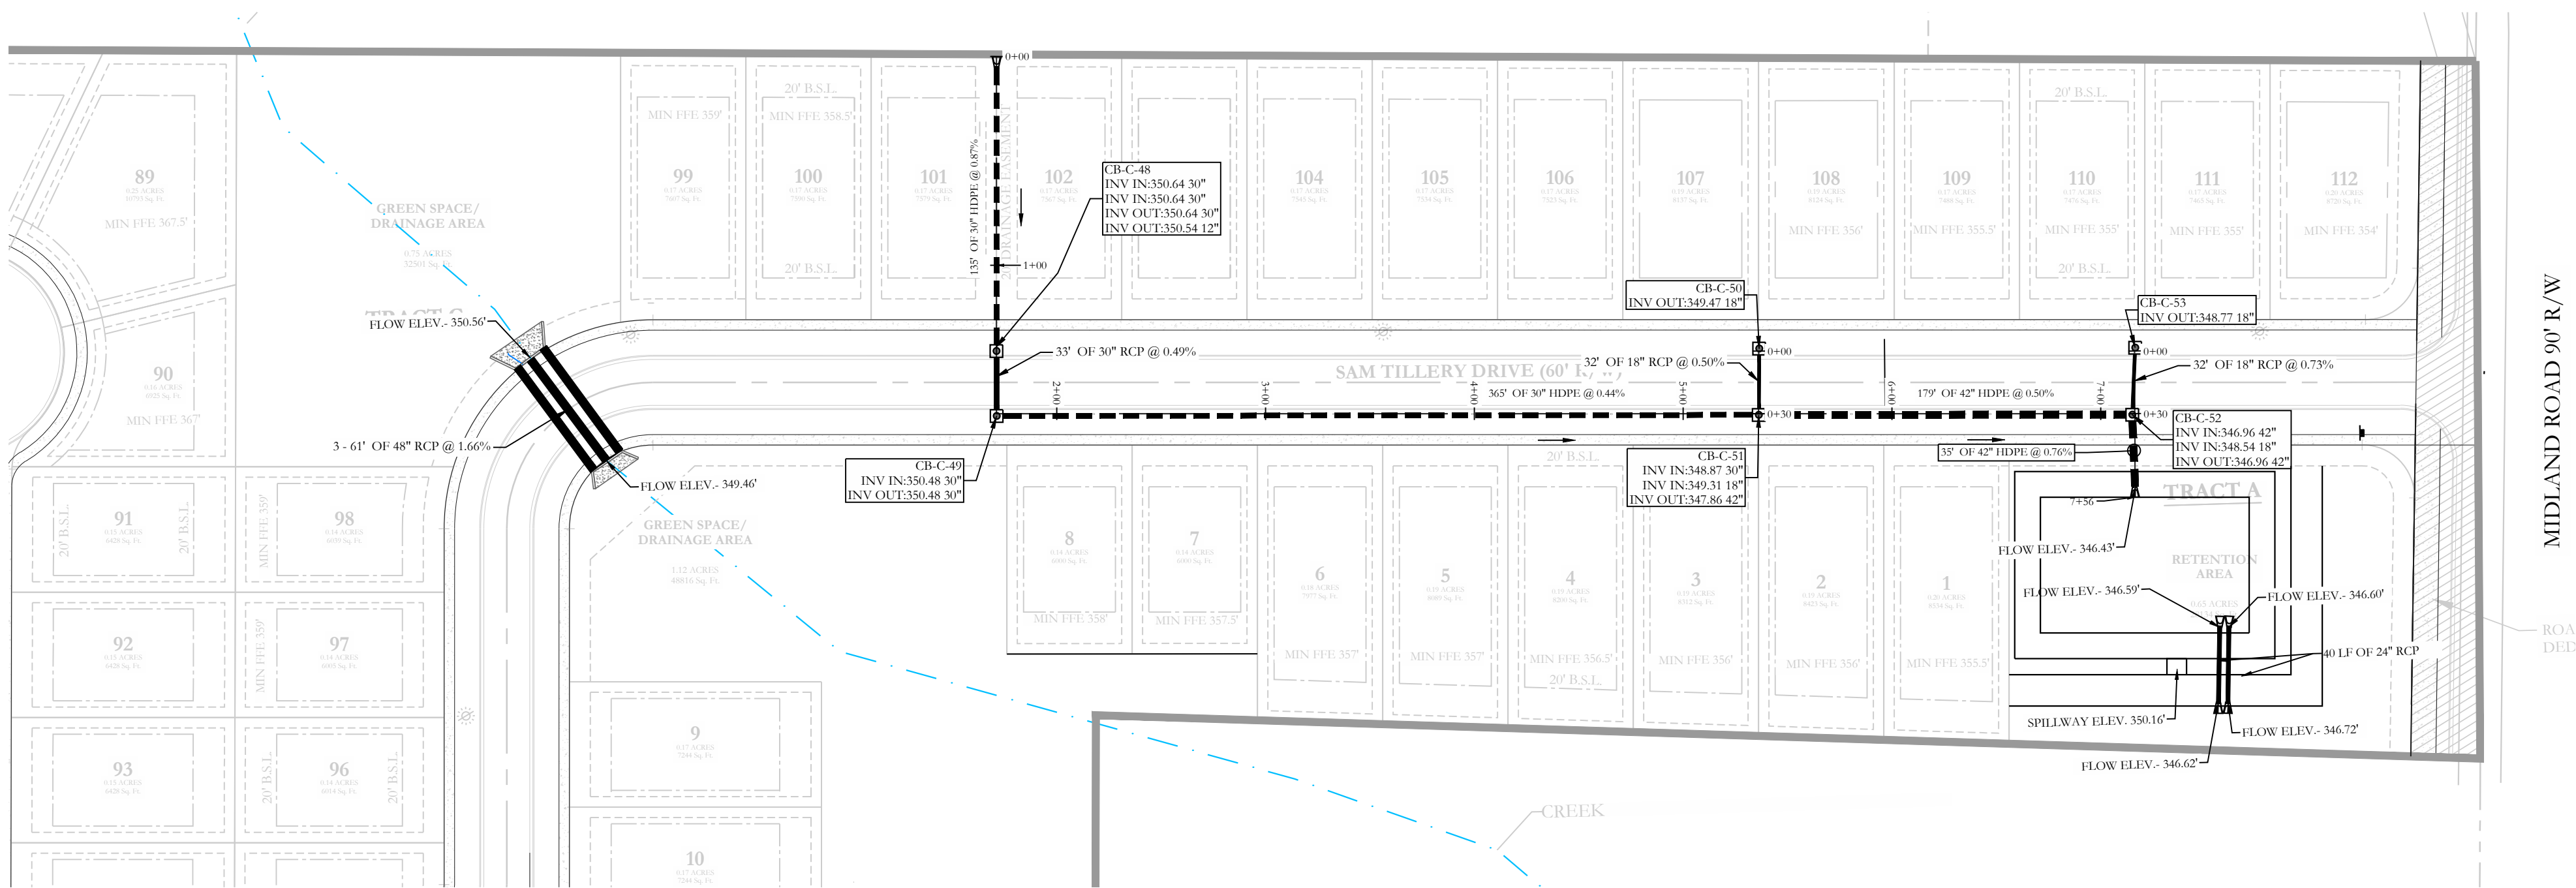

HOPE CONSULTING ENGINEERS - SURVEYORS		129 North Main Street, Benton, Arkansas 72015 PH. (501)315-2626 FAX (501) 315-0024 www.hopeconsulting.com	
FOR USE AND BENEFIT OF: HAVEN'S DEVELOPMENT, LLC			
MIDLAND ROAD ESTATES DRAINAGE AS-BUILTS IN THE CITY OF BRYANT, SALINE COUNTY, ARKANSAS			
DATE: 12/13/2024	C.A.D. BY:	DRAWING NUMBER:	
REVISED:	CHECKED BY:	23-0024	
SHEET:	SCALE: 1" = 60'		
500	0		

March 27, 2025

Colton Leonard
City of Bryant
210 S.W. 3rd Street
Bryant, Arkansas 72022

RE: Midland Road Estates – Detailed Cost Estimate for Water/Sewer, Streets, and Storm Water Bonds

Dear Colton,

Hope Consulting has reviewed the projects with the owner and the cost associated with the Utility Construction, Street Construction, and Storm Water Construction.

1. STREETS (1 YEAR BOND: 25% OF TOTAL COST)

- TOTAL STREET COST: \$495,444
- BOND COST: \$123,861.25

2. SEWER (2 YEAR BOND: 25% OF TOTAL COST)

- TOTAL SEWER COST: \$134,244
- BOND COST: \$67,122.00

3. STORM WATER (1 YEAR BOND: 100% OF TOTAL COST)

- TOTAL STORM WATER COST: \$183,483
- BOND COST: \$183,483

Please do not hesitate to contact us if you have any questions or require additional information.



Colton Leonard <cleonard@cityofbryant.com>

Fwd: Midland

1 message

Jonathan Hope <jonathanlhope@gmail.com>
To: Colton Leonard <cleonard@cityofbryant.com>

Thu, Mar 27, 2025 at 4:11 PM

Entergy confirmation of installation e-mail below.

----- Forwarded message -----

From: **Henderson, Jeremy** <jhende9@entergy.com>
Date: Thu, Mar 27, 2025 at 1:34 PM
Subject: RE: Midland
To: Jonathan <jonathanlhope@gmail.com>

Entergy has a job to install power that will serve the lots of Midland Rd.
Requests for service can be made through 800-368-3749.

If you have any questions, please let me know.

Thanks!
Jeremy Henderson
Distribution Engineering
Entergy Arkansas, LLC
[9 Entergy Ct.](#)
Little Rock, AR 72211
501-223-6125

-----Original Message-----

From: Jonathan <jonathanlhope@gmail.com>
Sent: Thursday, March 27, 2025 11:31 AM
To: Henderson, Jeremy <jhende9@entergy.com>
Subject: Midland

? HIGH RISK: UNTRUSTED EXTERNAL SENDER. DO NOT click links, or open attachments, if sender is unknown, or the message seems suspicious in any way. DO NOT provide your User ID or Password.

Can you send us a letter for Bryant stating infrastructure is scheduled to be installed. Final plat is coming up in two weeks.

Sent from my iPhone

This message is intended for the exclusive use of the intended addressee. If you have received this message in error or are not the intended addressee or his or her authorized agent, please notify me immediately by e-mail, discard any paper copies and delete all electronic files of this message.

--

Sincerely,

Jonathan Hope


HOPE
CONSULTING
ENGINEERS - SURVEYORS

www.hopeconsulting.com

129 N Main Street


Benton, Arkansas 72015

Telephone: (501) 315 - 2626

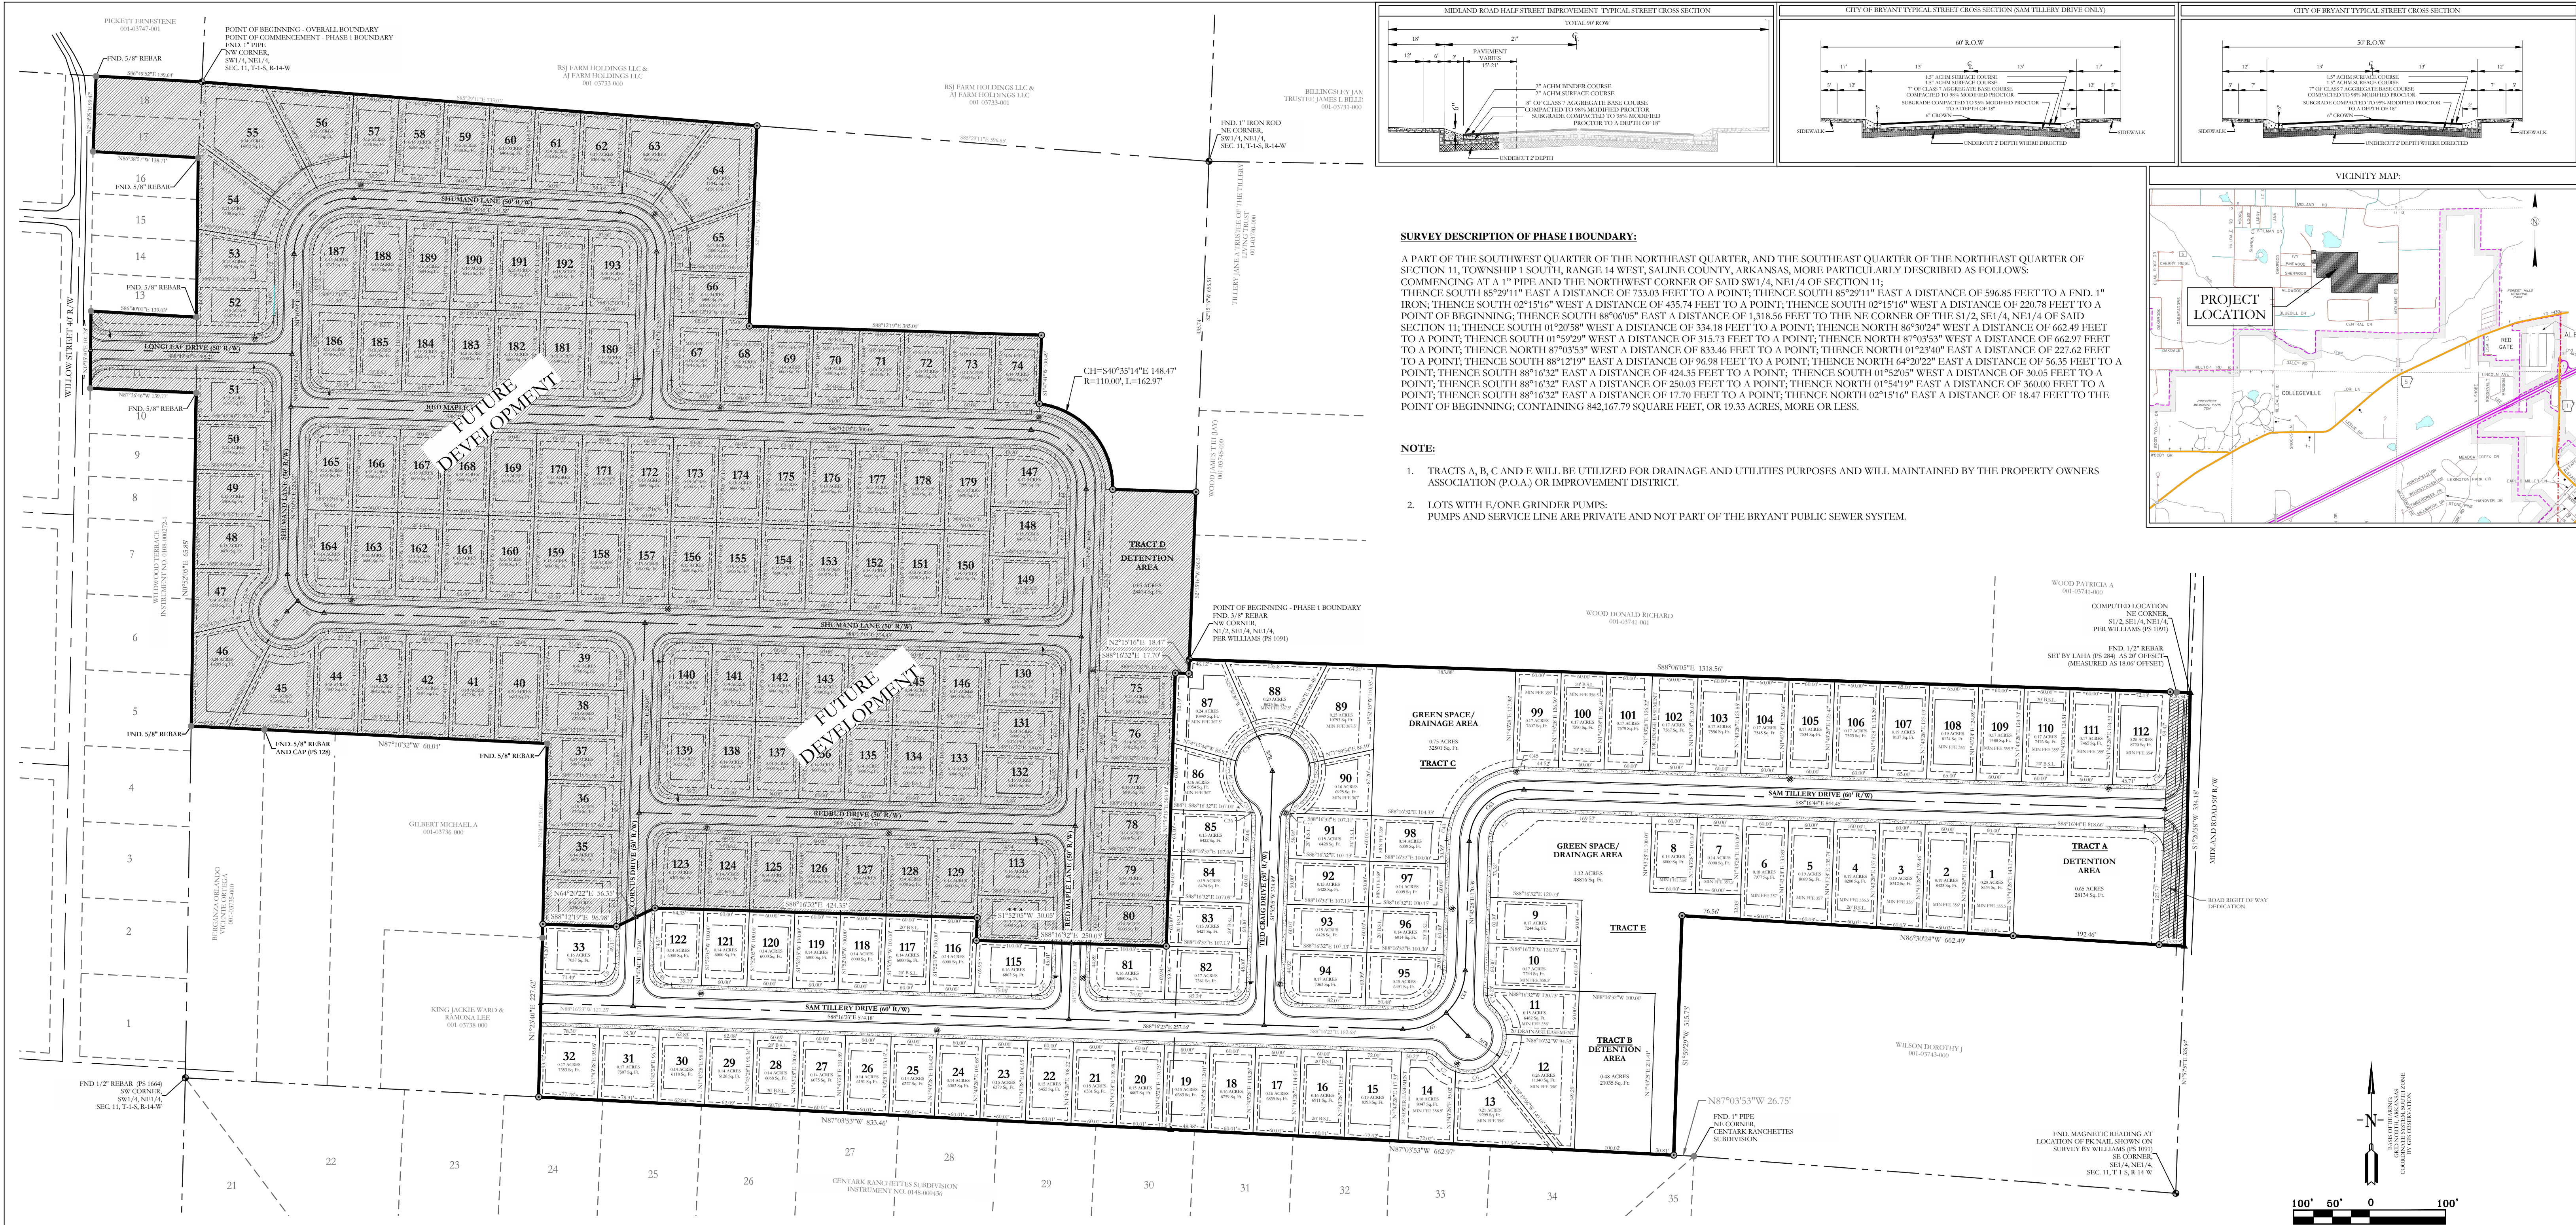

Curve Table						Curve Table						Curve Table					
Curve #	Length	Radius	Delta	Chord Direction	Chord Length	Curve #	Length	Radius	Delta	Chord Direction	Chord Length	Curve #	Length	Radius	Delta	Chord Direction	Chord Length
C22	147.27	100.00	84.38	S40° 19' 16"E	134.32	C24	44.77	100.00	25.65	N75° 46' 29"E	44.40	C50	39.33	25.00	90.14	N43° 12' 13"W	35.40
C22	28.58	75.00	21.84	S9° 07' 22"E	28.41	C25	0.64	75.00	0.49	S86° 41' 32"E	0.64	C51	39.21	25.00	89.86	N46° 47' 47"E	35.31
C1	39.63	25.00	90.82	S42° 52' 03"E	35.61	C26	43.46	75.00	33.20	S69° 50' 42"E	42.86	C52	39.30	25.00	90.07	S43° 14' 26"E	35.38
C2	62.84	40.01	89.99	N46° 43' 28"E	56.57	C27	43.46	75.00	33.20	S36° 38' 31"E	42.86	C53	39.27	25.00	90.00	S46° 47' 41"W	35.36
C3	21.61	25.00	49.52	N23° 02' 03"W	20.94	C29	39.27	25.00	90.00	S43° 12' 19"E	35.36	C54	39.30	25.00	90.07	N43° 10' 07"W	35.38
C4	39.94	50.00	45.76	N24° 54' 41"W	38.88	C31	39.33	25.00	90.14	S43° 12' 13"E	35.40	C55	39.24	25.00	89.93	N46° 49' 53"E	35.33
C5	46.86	50.00	53.70	N24° 49' 08"E	45.16	C32	39.21	25.00	89.86	N46° 47' 47"E	35.31	C56	39.00	25.00	89.38	S43° 30' 55"E	35.16
C6	50.43	50.00	57.79	N80° 33' 48"E	48.32	C33	20.09	25.00	46.04	N23° 18' 05"W	19.55	C57	39.54	25.00	90.62	S46° 29' 05"W	35.55
C7	27.65	50.00	31.68	S54° 42' 03"E	27.29	C34	54.16	50.00	62.06	N15° 17' 31"W	51.55	C58	78.60	50.00	90.07	N43° 10' 07"W	70.76
C8	21.56	25.00	49.41	S63° 34' 01"E	20.90	C35	44.29	50.00	50.75	N41° 06' 53"E	42.86	C59	39.27	25.00	90.00	N46° 47' 41"E	35.36
C9	39.24	25.00	89.93	S46° 45' 35"W	35.33	C36	44.29	50.00	50.75	S88° 07' 55"E	42.86	C60	39.00	25.00	89.38	S43° 30' 55"E	35.16
C10	39.27	25.00	90.00	S43° 12' 19"E	35.36	C36	0.94	25.00	2.15	N0° 47' 36"E	0.94	C61	80.19	50.00	91.89	S47° 07' 07"W	71.87
C11	19.69	25.00	45.13	N69° 13' 41"E	19.19	C37	44.29	50.00	50.75	S37° 22' 43"E	42.86	C62	38.72	25.00	88.73	N42° 34' 17"W	34.96
C12	1.26	25.00	2.89	N45° 12' 55"E	1.26	C38	54.16	50.00	62.06	S19° 01' 41"W	51.55	C63	109.96	70.00	90.00	S46° 43' 28"W	98.99
C13	63.54	50.00	72.81	N80° 10' 34"E	59.35	C39	19.96	25.00	45.75	S27° 10' 54"W	19.44	C64	62.83	80.00	45.00	N24° 13' 31"E	61.23
C14	43.81	50.00	50.20	S38° 18' 56"E	42.42	C40	1.06	25.00	2.44	S3° 05' 13"W	1.06	C65	62.84	80.00	45.00	N69° 13' 31"E	61.23
C15	54.47	50.00	62.42	S17° 59' 35"W	51.81	C41	39.33	25.00	90.14	S43° 12' 13"E	35.40	C66	39.00	50.00	44.69	S63° 51' 37"E	38.02
C16	19.69	25.00	45.12	S26° 38' 19"W	19.18	C42	78.54	50.00	90.00	N46° 43' 28"E	70.71	C67	39.00	50.00	44.69	S21° 10' 12"E	38.02
C17	1.27	25.00	2.90	S2° 37' 33"W	1.27	C43	30.06	100.00	17.22	N10° 20' 12"E	29.95	C68	120.28	75.00	91.89	S47° 07' 07"W	107.80
C18	39.27	25.00	90.00	S43° 49' 30"E	35.36	C44	111.48	100.00	63.87	N50° 53' 08"E	105.80	C69	77.45	50.00	88.73	N42° 34' 17"W	69.92
C19	39.02	25.00	89.42	S44° 06' 55"E	35.18	C45	15.54	100.00	8.90	N87° 16' 23"E	15.52	C70	117.91	75.00	90.07	N43° 10' 07"W	106.13
C20	39.27	25.00	90.00	N46° 10' 30"E	35.36	C46	38.91	25.00	89.18	N47° 08' 03"E	35.10						
C21	14.67	100.00	8.40	N5° 22' 36"E	14.65	C47	39.21	25.00	89.86	N46° 47' 47"E	35.31						
C22	46.57	100.00	26.68	N22° 55' 15"E	46.15	C48	39.30	25.00	90.07	S43° 14' 25"E	35.38						
C23	46.57	100.00	26.68	N49° 36' 20"E	46.15	C49	39.24	25.00	89.93	S46° 45' 34"W	35.33						

FINAL PLAT
MIDLAND ESTATES, PHASE 1
A SUBDIVISION IN THE CITY OF BRYANT, SALINE COUNTY, ARKANSAS.

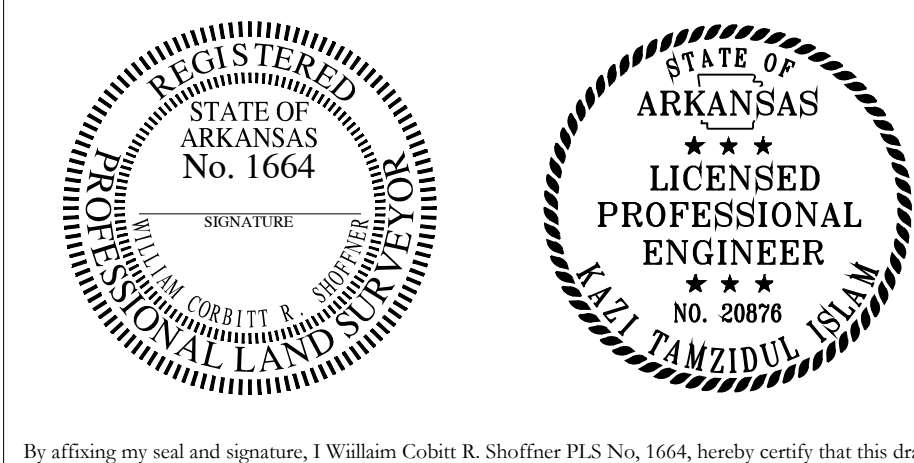

By affixing my seal and signature, I William Corbett R. Shoffner PLS No. 1664, hereby certify that this drawing correctly depicts a survey compiled under my supervision.

NOTE: This survey was based on legal descriptions and title work furnished by others and does not represent a title search.

No portion of the property described hereon lies within the 100 year floodplain, according to the Federal Insurance Rate Map, panel #08125C10365, Dated: 06/05/2020.

CERTIFICATIONS:

OWNER:
Name: HAVEN'S DEVELOPMENT, LLC
Address: 2615 N. PRICKETT ROAD, SUITE 5 BRYANT, AR 72022

DEVELOPER:
Name: HAVEN'S DEVELOPMENT, LLC
Address: 2615 N. PRICKETT ROAD, SUITE 5 BRYANT, AR 72022

CERTIFICATE OF FINAL ENGINEERING ACCURACY:
I, Kazi Tamizdul Islam, hereby certify that this plat correctly represents a plat made by me, and that the engineering requirements of the City of Bryant Subdivision Rules and Regulations have been complied with.

Date of Execution _____ Kazi Tamizdul Islam
Registered Professional Engineer, No. 20876 Arkansas

CERTIFICATE OF FINAL SURVEYING ACCURACY:
I, Corbett R. Shoffner, hereby certify that this plat correctly represents a survey and a plan made by me or under my supervision; that all monuments shown herein actually exist and their location, size, type and material are correctly shown; and that all interior lot lines have been adjusted to "as built conditions" and are accurately described on the plat and identified on the ground in terms of length and direction of the property side as required in accord with the City of Bryant Subdivision Regulation Ordinance.

Date of Execution _____ Wm. Corbett R. Shoffner
Registered Professional Land Surveyor No. 1664 Arkansas

CERTIFICATE OF FINAL PLAT APPROVAL:
Pursuant to the City of Bryant Subdivision Rules and Regulations, and all of the conditions of approval having been completed, this document is hereby accepted. This certificate is hereby executed under the authority of said rules and regulations.

Date of Execution _____ Lance Penfield, Chairman
Bryant Planning Commission

PROPERTY SPECIFICATIONS:

OWNER: HAVEN'S DEVELOPMENT, LLC
2615 N. PRICKETT ROAD, SUITE 5
BRYANT, AR 72022

DEVELOPER/SUBDIVIDER: HAVEN'S DEVELOPMENT, LLC
2615 N. PRICKETT ROAD, SUITE 5
BRYANT, AR 72022

ENGINEERS: HOPE CONSULTING INC.
129 N. MAIN STREET
BENTON, AR 72015

NAME OF SUBDIVISION: MIDLAND ESTATES PHASE 1

ZONING CLASSIFICATION: PROPOSED R-1S

SOURCE OF TITLE: SALINE COUNTY DOCUMENT BOOK 2022 PAGE 01145

MIN. LOT SIZE: 6,000 S.F.
NUMBER OF LOTS: 76
SOURCE OF WATER: CITY OF BRYANT
SOURCE OF SEWER: CITY OF BRYANT
SOURCE OF ELECTRIC: FIRST ELECTRIC COOP
SOURCE OF GAS: CENTERPOINT ENERGY

BUILDING SETBACKS:
FRONT: 20' OR AS SHOWN
REAR: 20' OR AS SHOWN
SIDE: 8' OR AS SHOWN

EASEMENTS: UTILITY & DRAINAGE (D.E. & U.E.)
FRONT: 10' OR AS SHOWN
REAR: 10' OR AS SHOWN
SIDE: 5' OR AS SHOWN

STREET RIGHT OF WAY: 50' OR AS SHOWN
STREET WIDTH: 20' BOC TO BOC
LOT CORNERS: SET 1/2" REAR WITH CAP

129 N. Main Street,
Benton, Arkansas 72015
PH. (501)315-2626
FAX (501) 315-0024
www.hopeconsulting.com

FOR USE AND BENEFIT OF:
HAVEN'S DEVELOPMENT, LLC

FINAL PLAT
MIDLAND ESTATES, PHASE 1
A SUBDIVISION IN THE CITY OF BRYANT, SALINE COUNTY, ARKANSAS.

DATE: 12/11/2024
REVISED: 04/09/2025
SHEET: 500

C.A.D. BY: BJOHNSON
CHECKED BY:
SCALE: 1" = 100'

DRAWING NUMBER:
23-0024

500 01S 14W 0 11 104 62 1664



CONSTRUCTION PLANS FOR

MARKETPLACE EAST SUBDIVISION

PHASE 1

BRYANT, ARKANSAS

PROJECT LOCATION

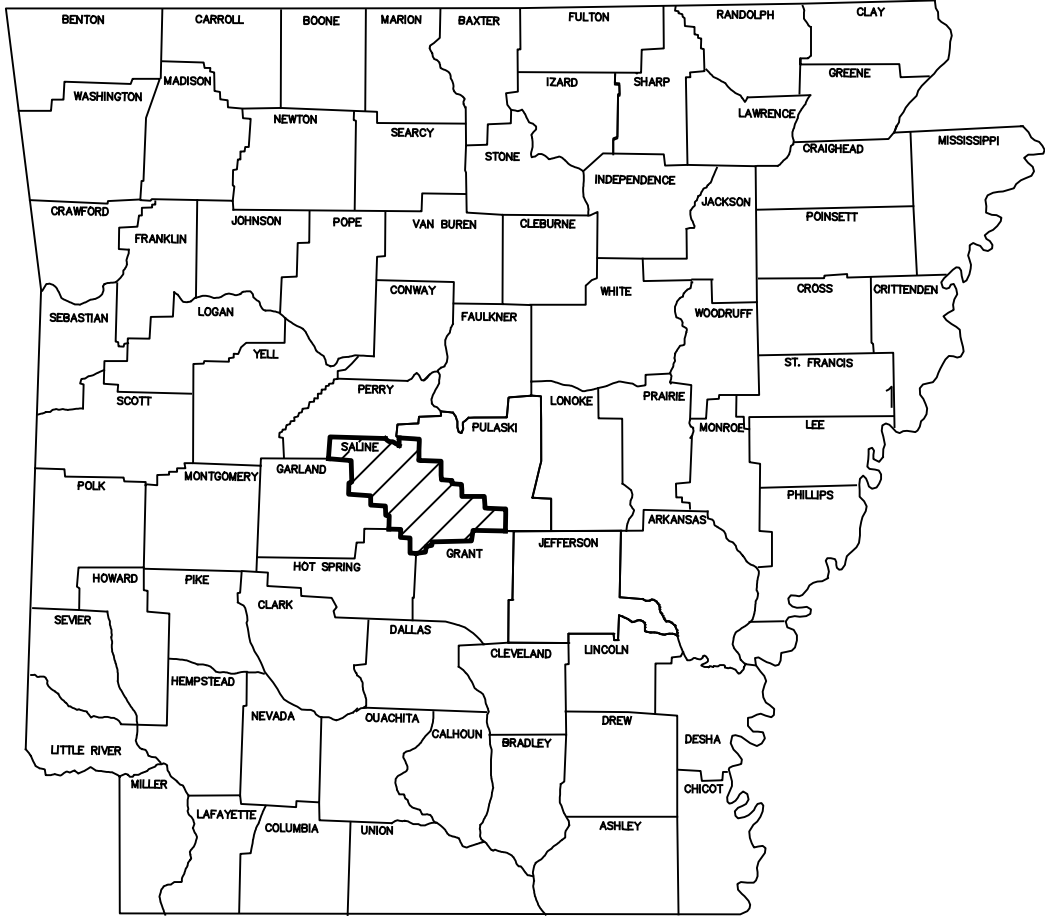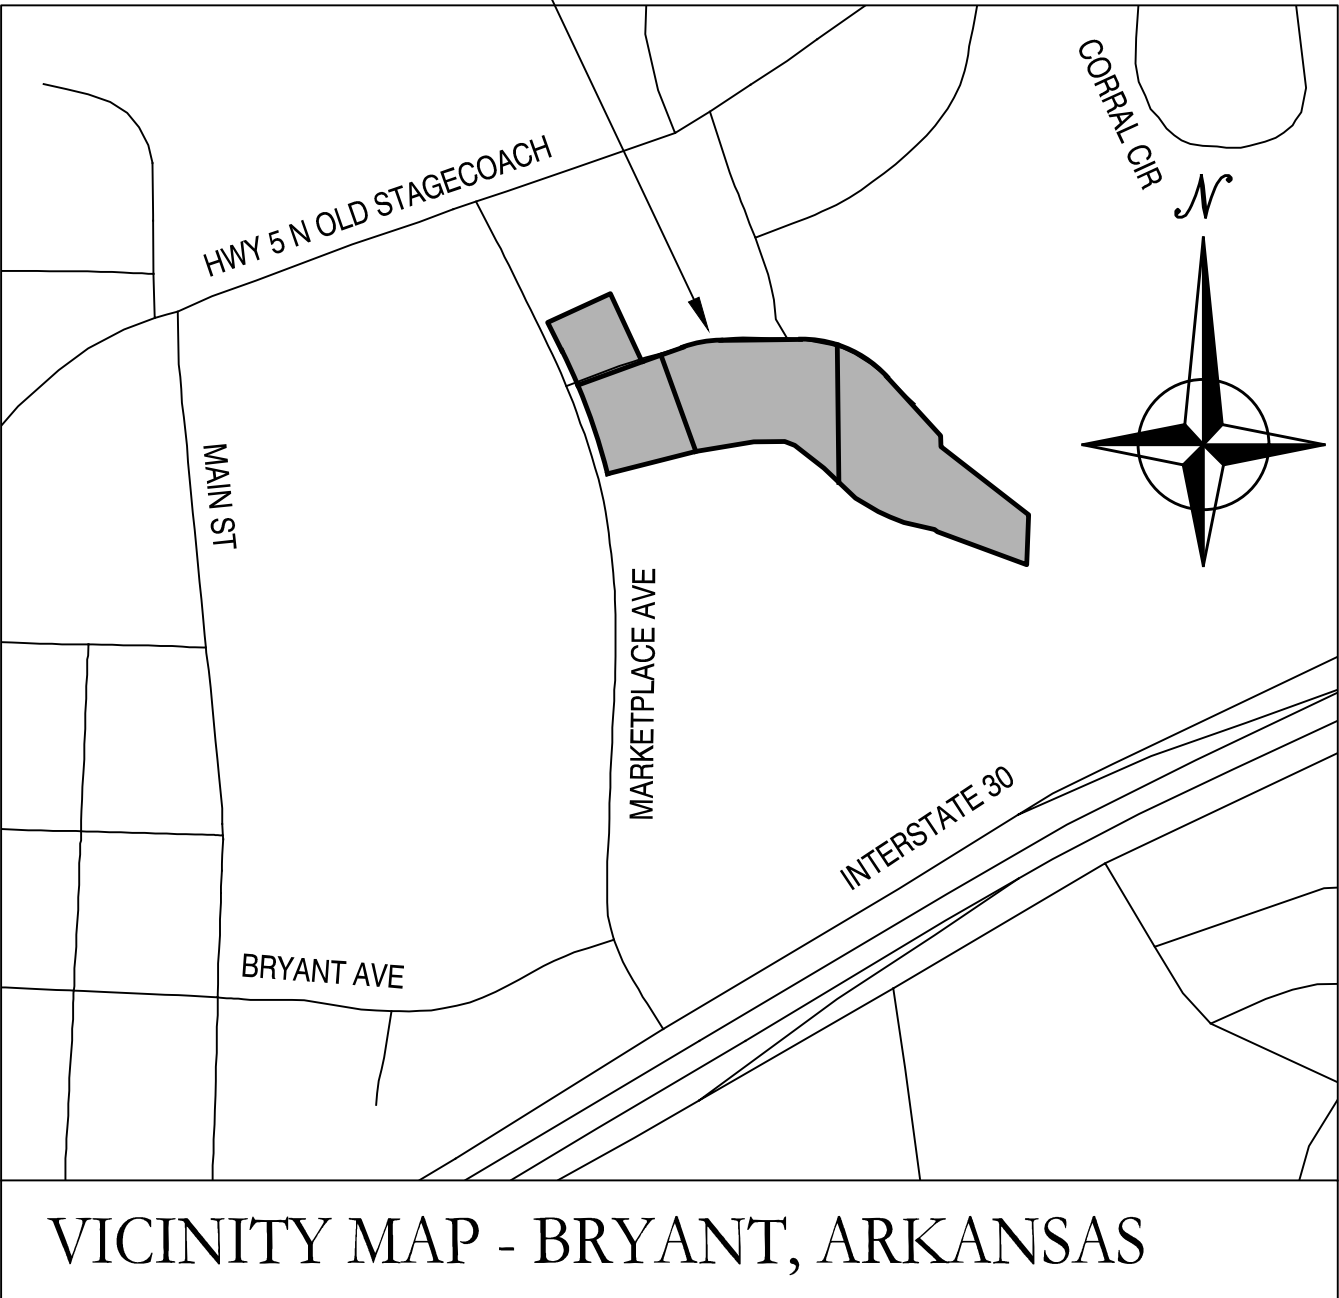

ARKANSAS

Prepared by:
GarNat Engineering, LLC

Designing our client's success
www.garnatengineering.com

P.O. Box 116
Benton, AR 72018
Ph (501) 408-4650


3825 Mt Carmel Road
Bryant, AR 72022
Fx (888) 900-3068

DRAWING INDEX:


C2.0	GRAVITY SEWER MAIN A PLAN AND PROFILE
C3.0	GRAVITY SEWER MAIN B PLAN AND PROFILE
C4.0	PROGRESS WAY PLAN AND PROFILE
C5.0	WATER PLAN

RECORD
DRAWING



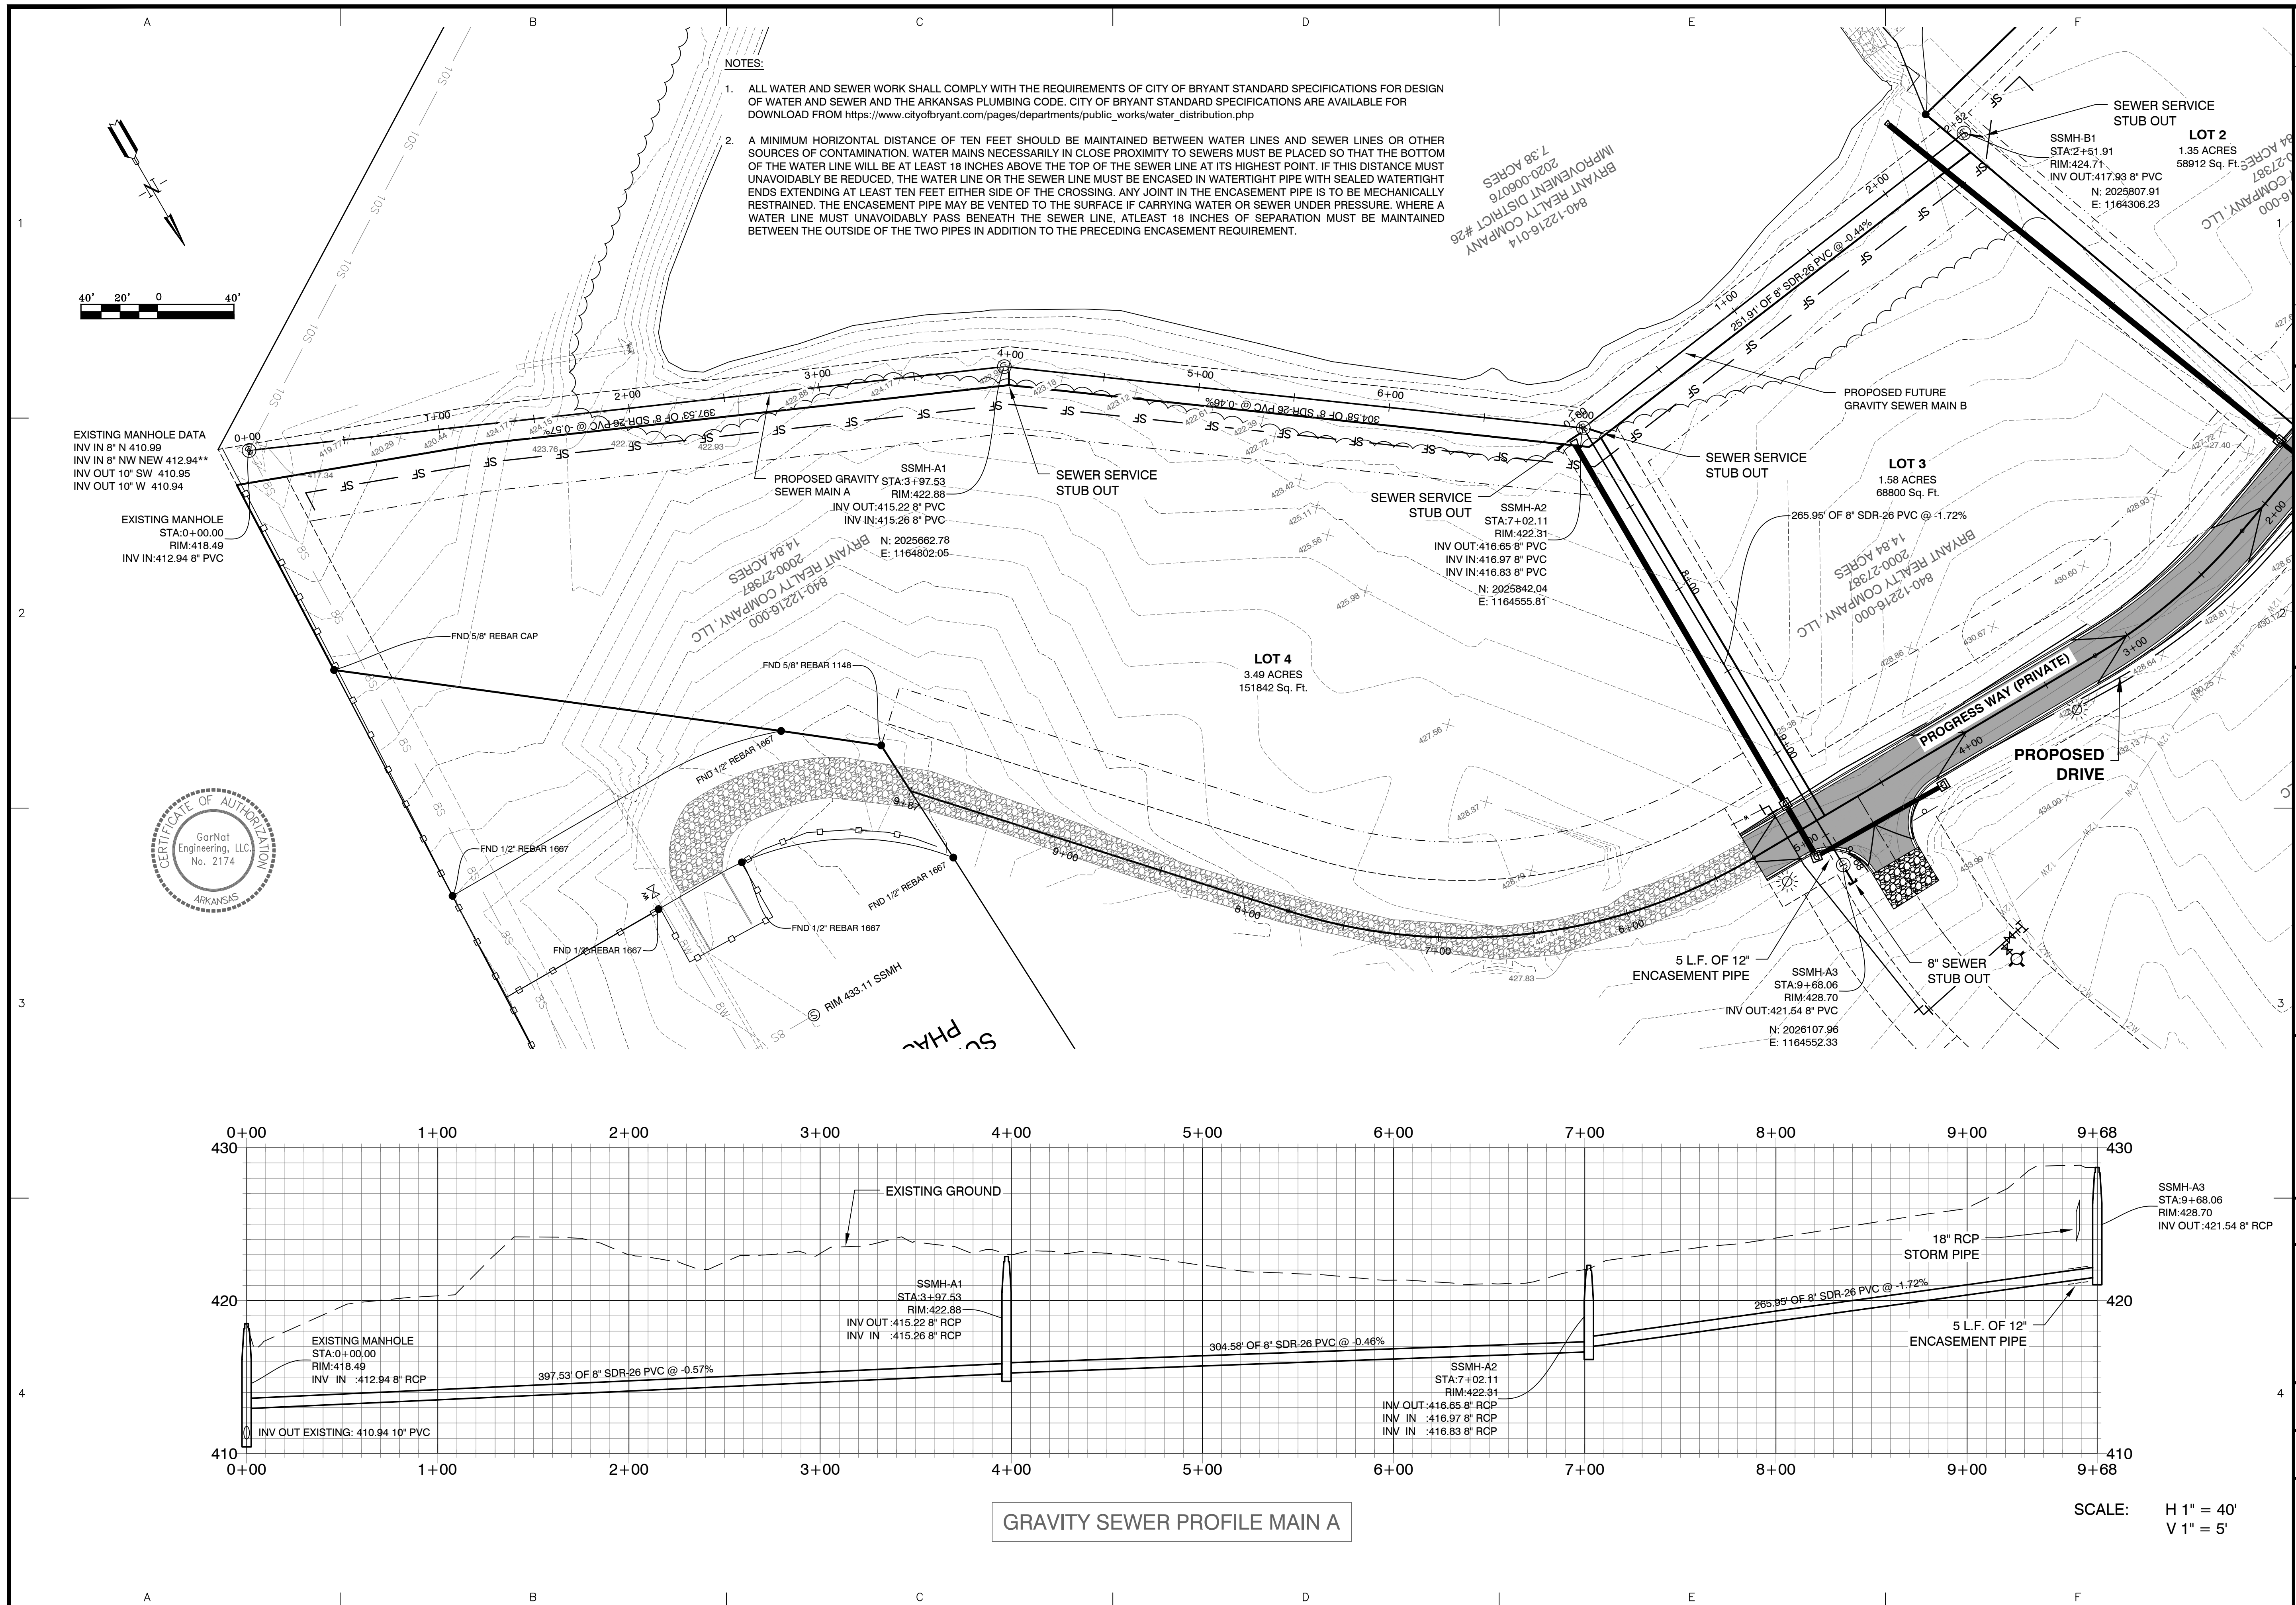



MARKETPLACE EAST PHASE 1 BRYANT REALTY COMPANY, LLC CITY OF BRYANT SALINE COUNTY, ARKANSAS RECORD DRAWING	GNE Designing our client's success GarNat Engineering, LLC P.O. Box 116 Benton, AR 72018 Ph. (501)-408-4650 3825 Mt Carmel Road Bryant, AR 72022 garnatengineering@gmail.com	DATE	REVISION	BY
PROJECT NO: 20022	CONTENTS: GRAVITY SEWER MAIN A PLAN & PROFILE			
DATE: FEB. 8, 2023				
SHEET NO: C2.0				

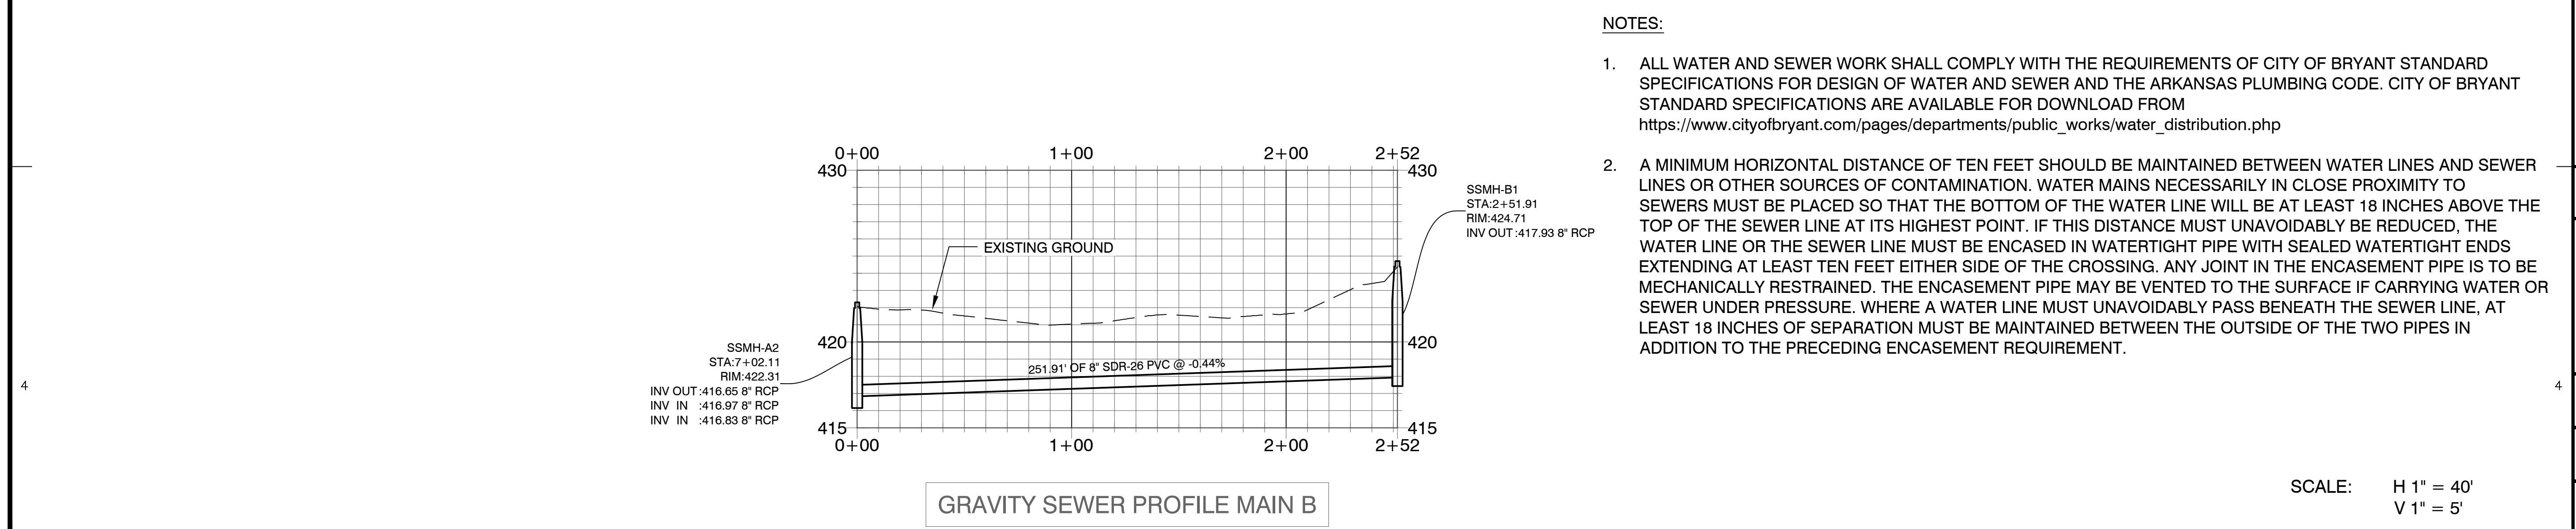

1. ALL WATER AND SEWER WORK SHALL COMPLY WITH THE REQUIREMENTS OF CITY OF BRYANT STANDARD SPECIFICATIONS FOR DESIGN OF WATER AND SEWER AND THE ARKANSAS PLUMBING CODE. CITY OF BRYANT STANDARD SPECIFICATIONS ARE AVAILABLE FOR DOWNLOAD FROM
https://www.cityofbryant.com/pages/departments/public_works/water_distribution.php
2. A MINIMUM HORIZONTAL DISTANCE OF TEN FEET SHOULD BE MAINTAINED BETWEEN WATER LINES AND SEWER LINES OR OTHER SOURCES OF CONTAMINATION. WATER MAINS NECESSARILY IN CLOSE PROXIMITY TO SEWERS MUST BE PLACED SO THAT THE BOTTOM OF THE WATER LINE WILL BE AT LEAST 18 INCHES ABOVE THE TOP OF THE SEWER LINE AT ITS HIGHEST POINT. IF THIS DISTANCE MUST UNAVOIDABLY BE REDUCED, THE WATER LINE OR THE SEWER LINE MUST BE ENCASED IN WATERTIGHT PIPE WITH SEALED WATERTIGHT ENDS EXTENDING AT LEAST TEN FEET EITHER SIDE OF THE CROSSING. ANY JOINT IN THE ENCASEMENT PIPE IS TO BE MECHANICALLY RESTRAINED. THE ENCASEMENT PIPE MAY BE VENTED TO THE SURFACE IF CARRYING WATER OR SEWER UNDER PRESSURE. WHERE A WATER LINE MUST UNAVOIDABLY PASS BENEATH THE SEWER LINE, AT LEAST 18 INCHES OF SEPARATION MUST BE MAINTAINED BETWEEN THE OUTSIDE OF THE TWO PIPES IN ADDITION TO THE PRECEDING ENCASEMENT REQUIREMENT.

SCALE: H 1" = 40'
 V 1" = 5'

\\Projects\2020 Projects\2022 Bart Ferguson -- Marketplace East Subdivision\Drawings\DWGs\Design\2022 Bart Ferguson Marketplace East Subdivision Phase 1 R5 AS BUILT -- 050925.dwg

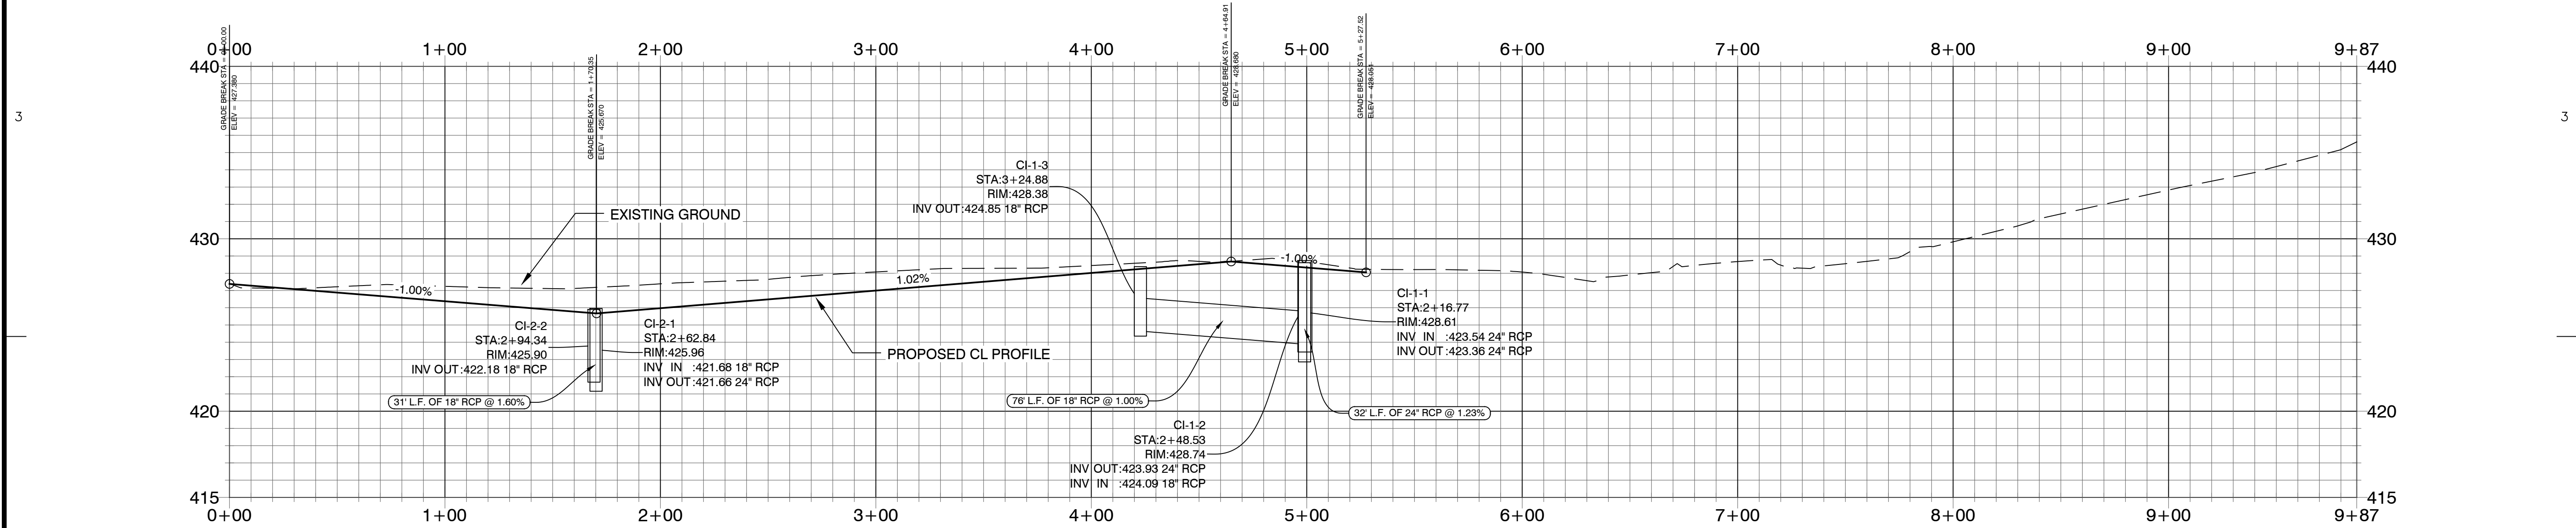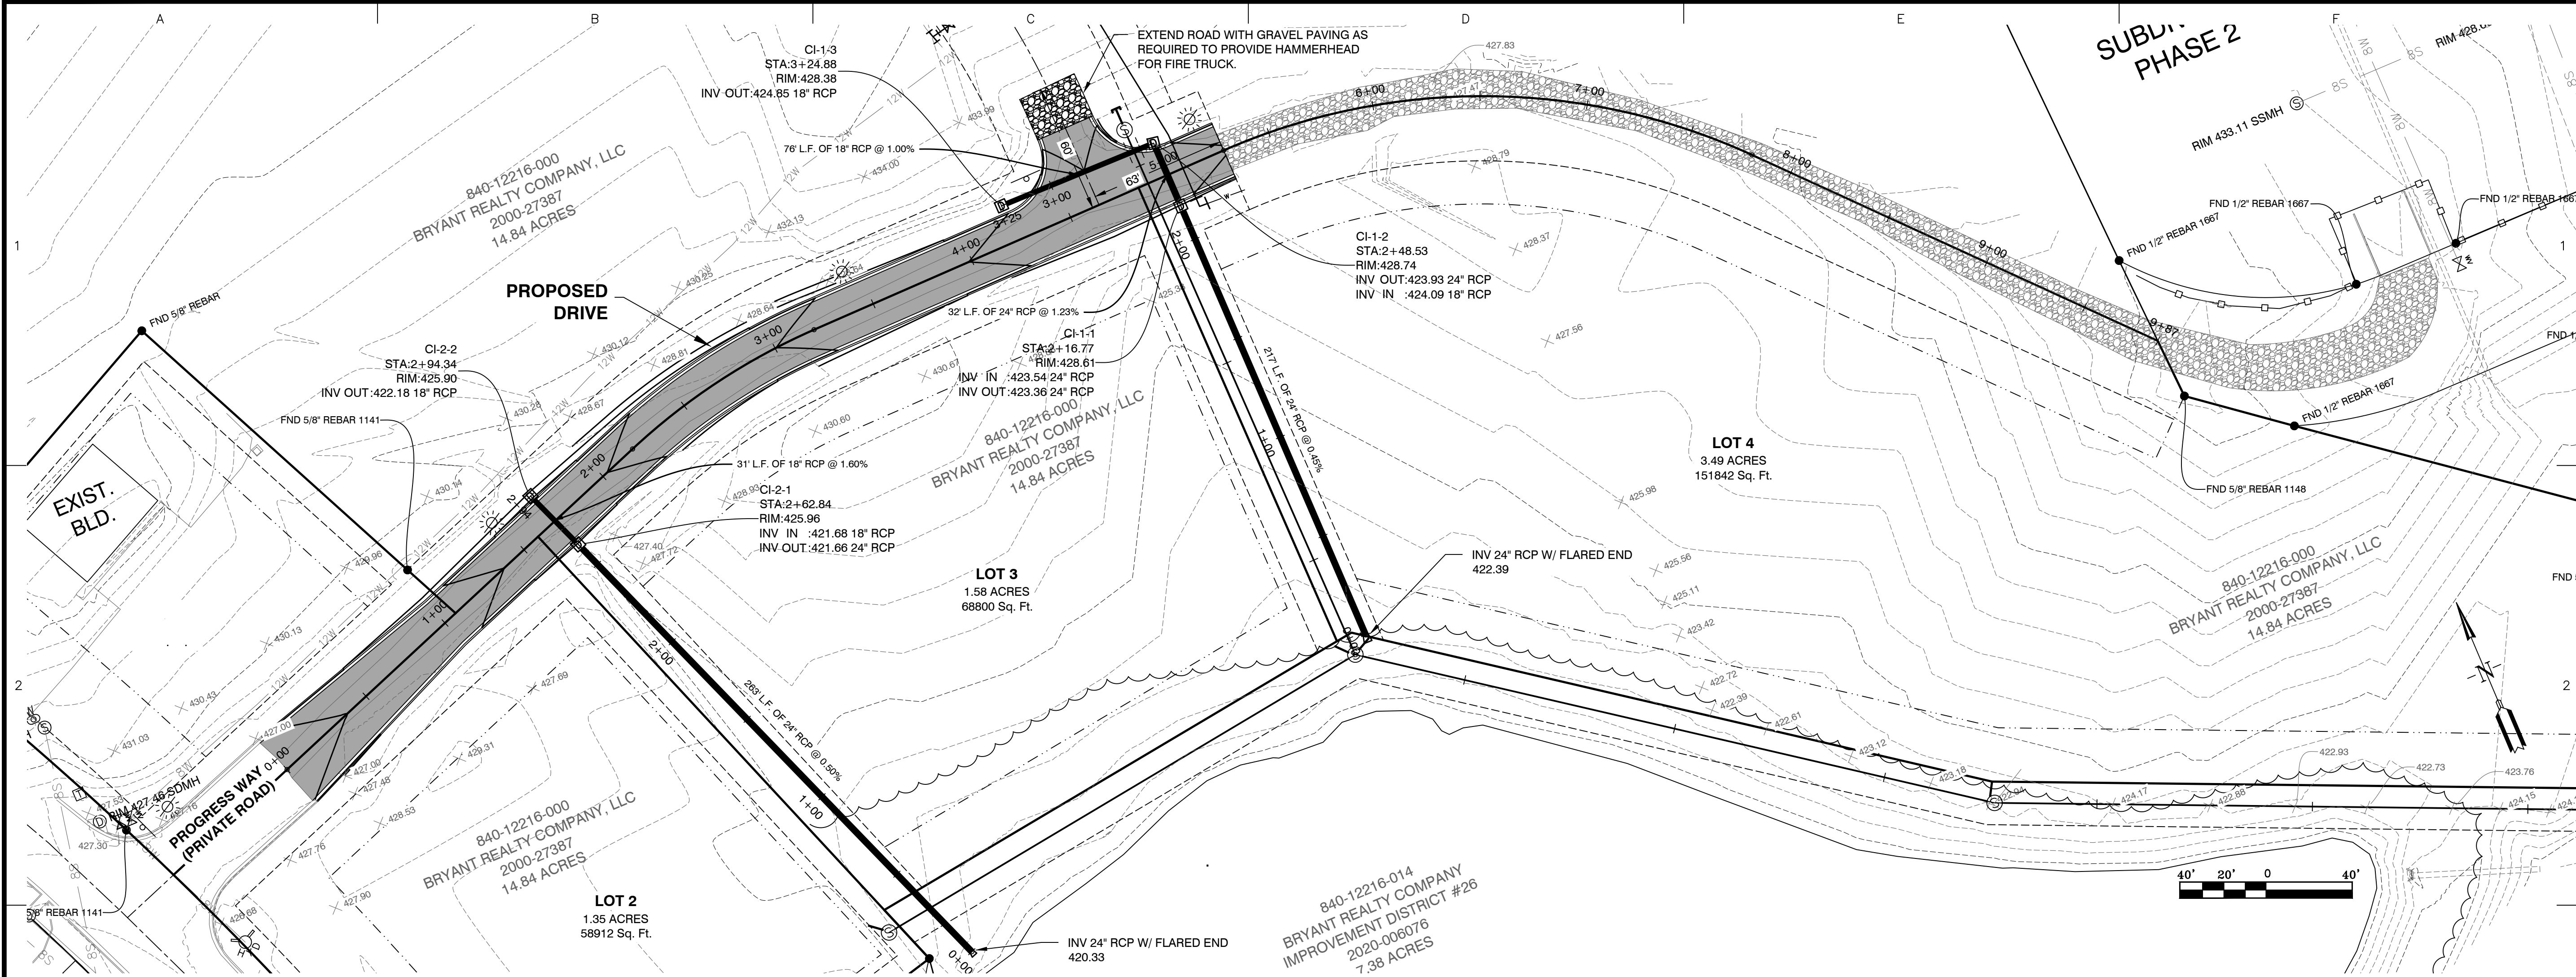


PROGRESS WAY PROFILE



SCALE: H 1" = 40'
V 1" = 5'

BY		REVISION		DATE	
Designing our client's success					
GarNat Engineering, LLC					
3825 Mt Carmel Road Bryant, AR 72022 Ph. (501) 408-4650 garnatengineering@gmail.com					
MARKETPLACE EAST PHASE 1 BRYANT REALTY COMPANY, LLC CITY OF BRYANT SALINE COUNTY, ARKANSAS					
RECORD DRAWING					
CONTENTS:					
PROGRESS WAY PLAN & PROFILE					
PROJECT NO: 20022					
DATE: FEB. 8, 2023					
SHEET NO: C4.0					

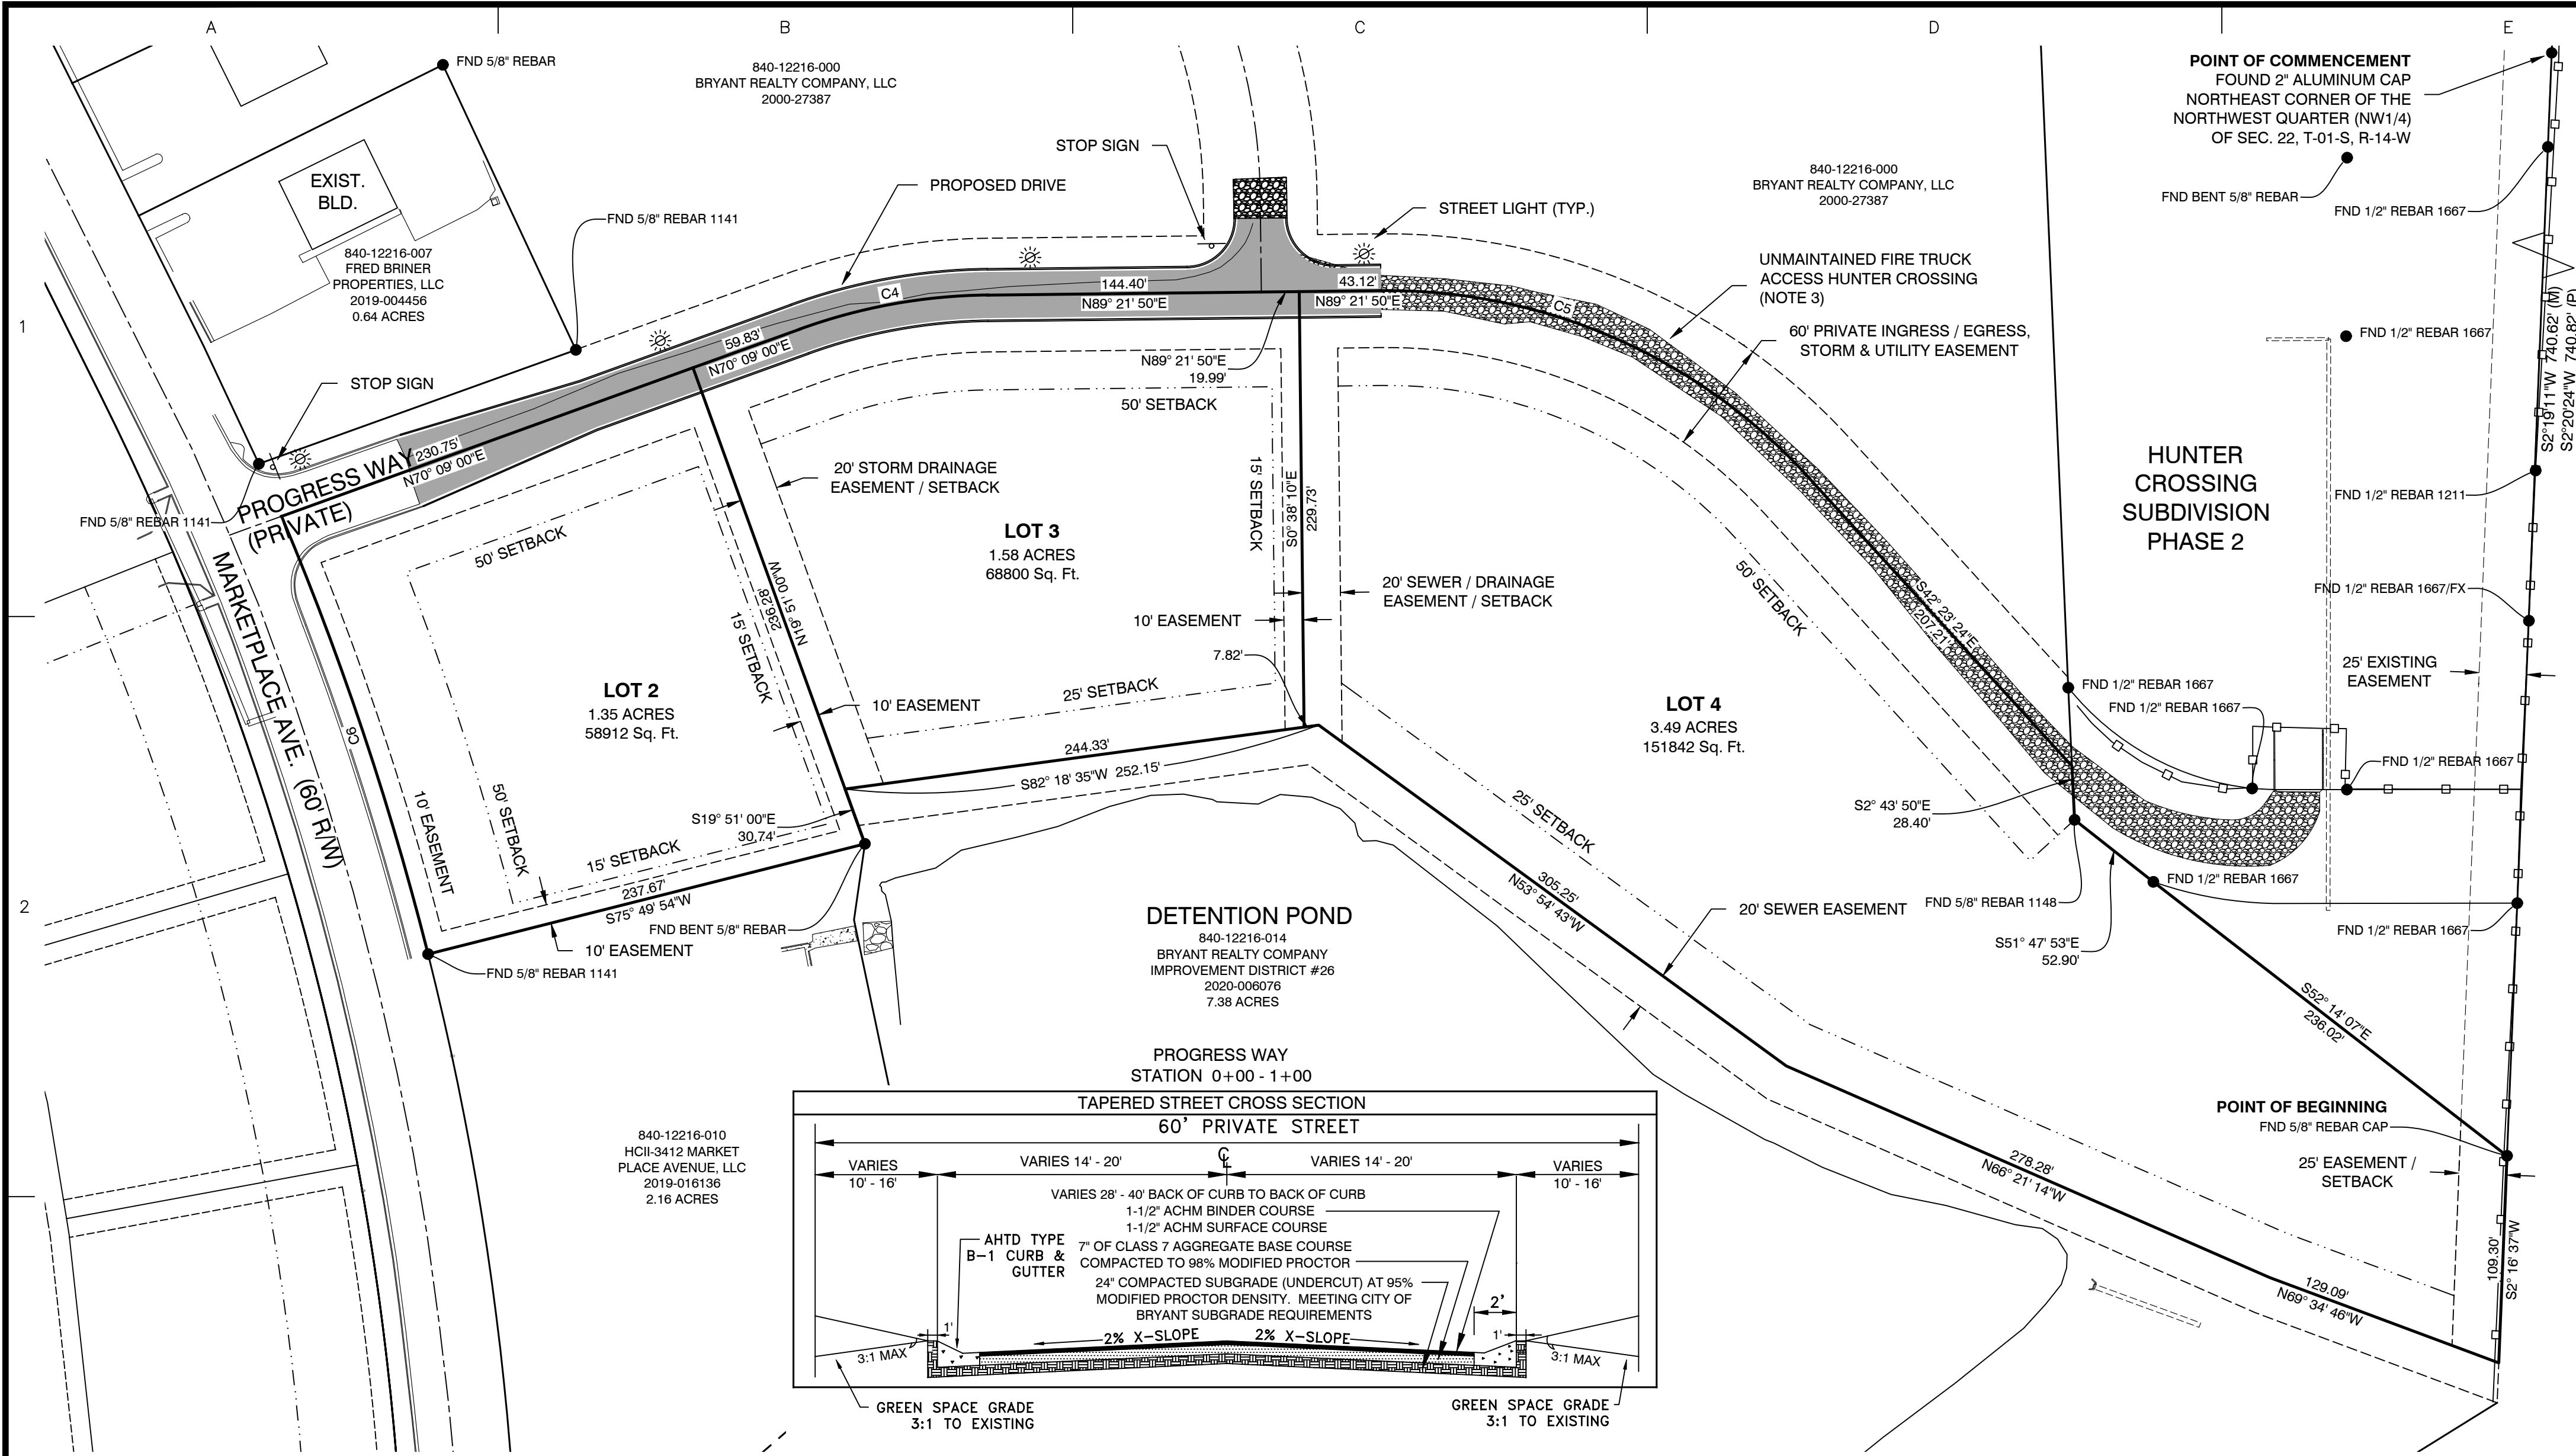

PLAT CERTIFICATES:

OWNER:
Name: Bryant Realty Company, LLC
Address: 422 North Main Street, Benton, Arkansas 72015

DEVELOPER:
Name: Bryant Realty Company, LLC
Address: 422 North Main Street, Benton, Arkansas 72015

CERTIFICATE OF OWNER:
We, the undersigned, owners of the real estate shown and described herein do hereby certify that we have laid off, platted and subdivided, and do hereby lay off, plat and subdivide said real estate in accordance with the within plat.

Date: _____ Signed: _____
Name: Fred Briner
Address: 422 North Main Street, Benton, Arkansas 72015

Source of Title Saline County: Deed Book 2000, Page 27387

CERTIFICATE OF ENGINEERING ACCURACY:
I, Vernon J. Williams, hereby certify that this plat correctly represents a survey and a plan made by me or under my supervision; that all monuments shown hereon actually exist and their locations, size, type, and material are correctly shown; and that all requirements of the City of Bryant Subdivision Rules and Regulations have been fully complied with.

Date: _____ Signed: _____
Vernon J. Williams
Registered Professional Engineer
No. 9551, Arkansas

CERTIFICATE OF SURVEYING ACCURACY:
I, George P. Wooden, hereby certify that this plat correctly represents a boundary survey made by me or under my supervision; that the boundary lines shown hereon correspond with the description in the deeds cited in the above Source of Title; and that all monuments which were found or placed on the property are correctly described and located.

Date: _____ Signed: _____
George P. Wooden
Registered Land Surveyor
No. 1573, Arkansas

CERTIFICATE OF FINAL PLAT APPROVAL:
Pursuant to the City of Bryant Subdivision Rules and Regulations, this document was given approval by the Bryant Planning Commission. All of the document is hereby accepted, and this certificate executed under the authority of said rules and regulations.


Date: _____ Signed: _____
Lance Penfield, Chairman
Bryant Planning Commission

CERTIFICATE OF RECORDING:


SUBDIVISION DESCRIPTION:

LOCATED IN THE EAST HALF OF THE NORTHWEST QUARTER (E1/2 NW1/4), OF SECTION 22, TOWNSHIP 01 SOUTH, RANGE 14 WEST, SALINE COUNTY, ARKANSAS, MORE PRECISELY DESCRIBED AS FOLLOWS:

COMMENCING AT A FOUND 2" ALUMINUM CAP LOCATED AT THE NORTHEAST CORNER OF THE NORTHWEST QUARTER (NW1/4) OF SECTION 22, TOWNSHIP 01 SOUTH, RANGE 14 WEST, SAID POINT ALSO BEING ON THE EAST LINE OF HUNTER CROSSING SUBDIVISION; THENCE S 2°19'11" W, ALONG THE EAST LINE OF SAID NW1/4 AND SAID SUBDIVISION FOR A DISTANCE OF 740.62 FEET TO A FOUND 5/8" REBAR WITH CAP LOCATED AT THE SOUTHEAST CORNER OF SAID SUBDIVISION FOR THE **POINT OF BEGINNING**; THENCE S 2°16'37" W, LEAVING SAID SUBDIVISION AND CONTINUING ALONG SAID EAST LINE OF THE NW1/4 FOR A DISTANCE OF 109.30 FEET TO A SET 1/2" REBAR WITH CAP #1573 LOCATED ON THE NORTH LINE OF A SEWER EASEMENT; THENCE N 89°34'46" W, LEAVING SAID EAST LINE AND ALONG SAID NORTH LINE OF SEWER EASEMENT, A DISTANCE OF 126.09 FEET TO A SET 1/2" REBAR WITH CAP #1573; THENCE N 66°21'14" W, CONTINUING ALONG SAID NORTH LINE, A DISTANCE OF 278.28 FEET TO A SET 1/2" REBAR WITH CAP #1573; THENCE N 53°54'43" W, CONTINUING ALONG SAID NORTH LINE, A DISTANCE OF 305.25 FEET TO A SET 1/2" REBAR WITH CAP #1573; THENCE S 82°18'35" W, CONTINUING ALONG SAID NORTH LINE, A DISTANCE OF 252.15 FEET TO A SET 1/2" REBAR WITH CAP #1573; THENCE S 19°51'00" E, LEAVING SAID NORTH LINE OF SEWER EASEMENT, A DISTANCE OF 30.74 FEET TO A FOUND BENT 5/8" REBAR; THENCE S 75°49'54" W FOR A DISTANCE OF 237.67 FEET TO A FOUND 5/8" REBAR WITH CAP #1141 LOCATED ON THE EAST RIGHT OF WAY OF MARKETPLACE AVENUE; THENCE CONTINUING ALONG SAID EAST RIGHT OF WAY AND ALONG A CURVE TO THE LEFT WITH A RADIUS OF 1586.45 FEET AND A LENGTH OF 243.80 FEET, WHOSE CHORD BEARS N 18°29'44" W - 243.56 FEET TO A SET MAG NAIL LOCATED AT THE CENTERLINE OF PROGRESS WAY (PRIVATE STREET); THENCE ALONG SAID CENTERLINE AND LEAVING SAID EAST RIGHT OF WAY THE FOLLOWING COURSES: THENCE N 70°09'00" E - 290.57 FEET, THENCE ALONG A CURVE TO THE RIGHT WITH A RADIUS OF 300.00 FEET AND A LENGTH OF 101.27 FEET, WHOSE CHORD BEARS N 79°41'39" E - 100.79 FEET, THENCE N 89°21'50" E - 207.51 FEET, THENCE ALONG A CURVE TO THE RIGHT WITH A RADIUS OF 300.00 FEET AND A LENGTH OF 252.62 FEET, WHOSE CHORD BEARS S 86°39'47" E - 248.22 FEET, THENCE S 42°23'24" E - 207.21 FEET TO A POINT LOCATED ON THE WEST LINE OF HUNTER CROSSING SUBDIVISION PHASE 2; THENCE S 2°43'50" E, LEAVING SAID CENTERLINE OF SAID AND ALONG THE WEST LINE OF SAID SUBDIVISION, FOR A DISTANCE OF 28.40 FEET TO A FOUND 5/8" REBAR WITH CAP #1148 LOCATED AT THE SOUTHWEST CORNER OF SAID SUBDIVISION; THENCE S 51°47'53" E, ALONG SAID SOUTH LINE OF SAID SUBDIVISION, FOR A DISTANCE OF 52.90 FEET TO A FOUND 1/2" REBAR WITH CAP #1667; THENCE S 52°14'07" E, CONTINUING ALONG SAID SOUTH LINE FOR A DISTANCE OF 236.02 FEET TO THE **POINT OF BEGINNING**, CONTAINING 6.42 ACRES MORE OR LESS.

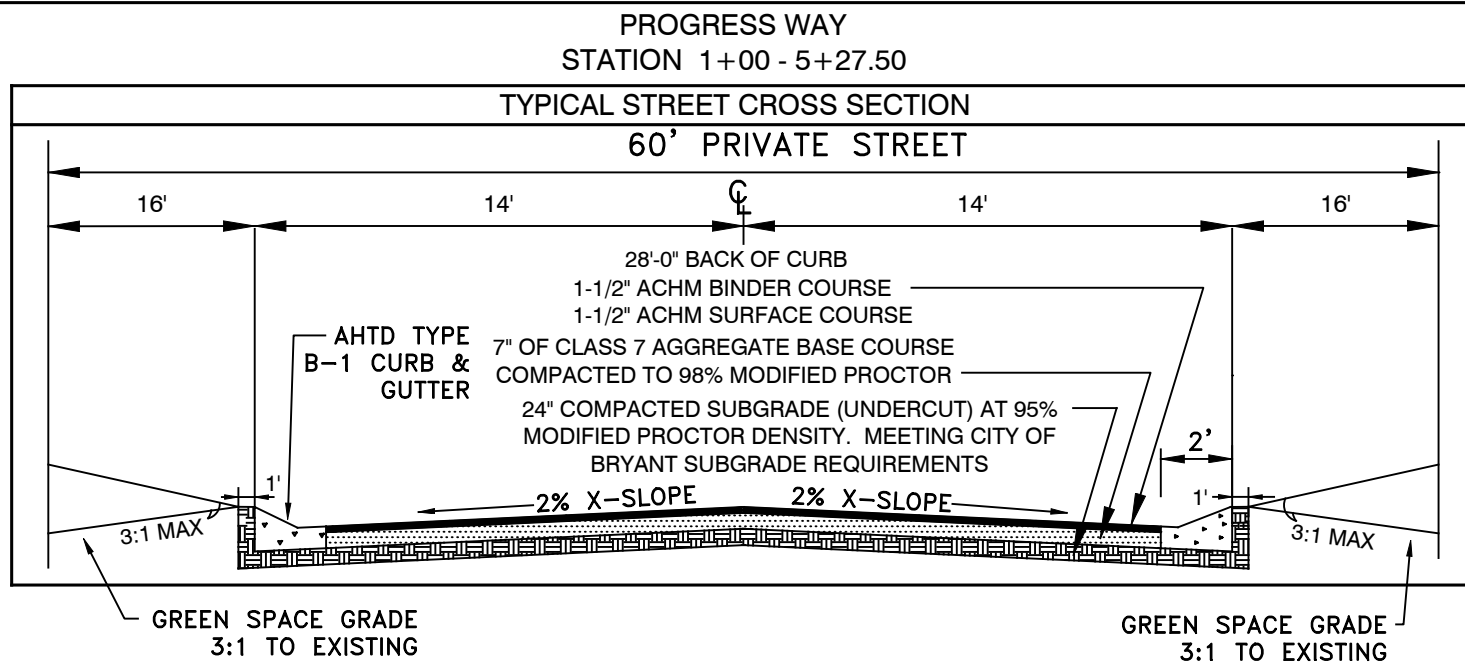

FINAL PLAT - MARKETPLACE EAST PHASE 1 CITY OF BRYANT SALINE COUNTY, ARKANSAS

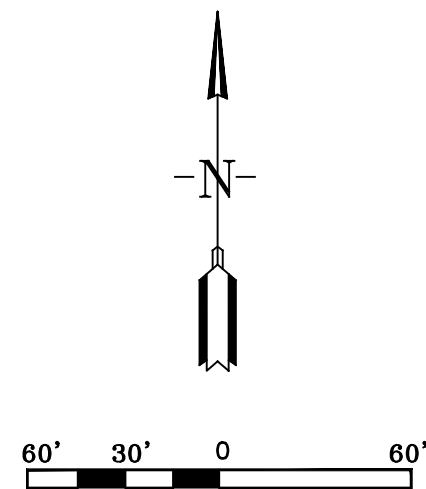

DOCUMENTS USED:

- SURVEY BY REAL ESTATE SERVICES OF SALINE COUNTY, INC. DATED 9/11/2015 KERRY LANE PLS #1141
- SURVEY BY REAL ESTATE SERVICES OF SALINE COUNTY, INC. DATED 1/27/2009 KERRY LANE PLS #1141
- SURVEY BY REAL ESTATE SERVICES OF SALINE COUNTY, INC. DATED 4/21/2022 KERRY LANE PLS #1141
- WARRANTY DEED 2020 PAGE 004456 FRED E. BRINER TO FRED BRINER PROPERTIES, LLC
- WARRANTY DEED 2019 PAGE 004456 FRED E. BRINER TO FRED BRINER PROPERTIES, LLC
- SPECIAL WARRANTY DEED 2000 PAGE 27387 HIGHWAY 5 INVESTMENTS, LLC TO BRYANT REALTY COMPANY IMPROVEMENT DISTRICT NO. 26
- SPECIAL WARRANTY DEED 2000 PAGE 016136 FERGUSON-BRINER, LLC TO HCII-3412 MARKET PLACE AVENUE, LLC
- WARRANTY DEED 2000 PAGE 27385 HIGHTOWER TO HIGHWAY 5 INVESTMENTS, LLC
- REVISED FINAL PLAT OF HUNTER CROSSING SUBDIVISION PHASE 1
- REVISED FINAL PLAT OF HUNTER CROSSING SUBDIVISION PHASE 2

BASIS OF BEARINGS:

BENCHMARK(S) PROVIDED ARE REBAR AND COORDINATES ON BENCHMARKS ARE NORTH AMERICAN DATUM 1983, ARKANSAS SOUTH ZONE, US SURVEY FEET, GRID COORDINATES AND ELEVATIONS ARE NAVD 1988. COORDINATES AND ELEVATIONS WERE ESTABLISHED USING GPS AND WERE PROCESSED USING THE NATIONAL GEODETIC SURVEYS' "ONLINE POSITIONING USER SERVICE" (OPUS).

CERTIFICATIONS:

BY AFFIXING MY SEAL AND SIGNATURE, I GEORGE P. WOODEN, PS. NO.1573, HEREBY CERTIFY THAT THIS DRAWING CORRECTLY DEPICTS A SURVEY COMPILED UNDER MY SUPERVISION ON JANUARY 10, 2023.

THIS SURVEY WAS BASED ON LEGAL DESCRIPTIONS AND TITLE WORK FURNISHED BY OTHERS AND DOES NOT REPRESENT A TITLE SEARCH.

THIS PROPERTY IS NOT LOCATED IN THE 100 YEAR FLOOD PLAIN. THE PROPERTY SHOWN ON THIS PLAT IS LOCATED IN ZONE "X" OF THE F.E.M.A. MAP PANEL 05125C0240E EFFECTIVE DATE JUNE 05, 2020.

PROPERTY SPECIFICATIONS:

ZONING CLASSIFICATION: C-2

SOURCE OF WATER: CITY OF BRYANT

SOURCE OF SEWER: CITY OF BRYANT

BUILDING SETBACKS (SB):

- FRONT - 50'
- REAR - 25'
- SIDE INTERIOR - 15'
- SIDE EXTERIOR - 15'

EASEMENTS: UTILITY & DRAINAGE (D.E. & U.E.)

FRONT, SIDE AND REAR - 10' OR AS SHOWN

INGRESS/EGRESS (I/E)

LOT CORNERS: SET #4 REBAR WITH CAP


NOTES:

- ALL LOTS WILL HAVE SIDEWALKS. THESE WILL BE ADDED WHEN EACH SITE PLAN IS SUBMITTED FOR APPROVAL TO THE CITY OF BRYANT AND MEET BRYANT CONSTRUCTION STANDARDS.
- FINAL PLAT WILL NOT BE APPROVED UNTIL 8" WATER LINE AT SOUTH END OF HUNTER CROSSING IS LOOPEO TO EXISTING 12" IN THIS SUBDIVISION.
- FIRE TRUCK ACCESS TO HUNTER CROSSING HAS NOT BEEN MAINTAINED. FINAL PLAT WILL NOT BE APPROVED UNTIL FIRE TRUCK ACCESS IS RESTORED AND ACCEPTABLE TO BRYANT FIRE MARSHAL.

SURVEY LEGEND

- △ - Computed point
- - Found monument
- - Set #4 RB/Plas. Cap or Mag Nail with Shiner
- (M) - Measured
- (R) - Record
- (P) - Platted

SURVEY PLAT CODE:
500-01S-14W-0-22-400-62-1573

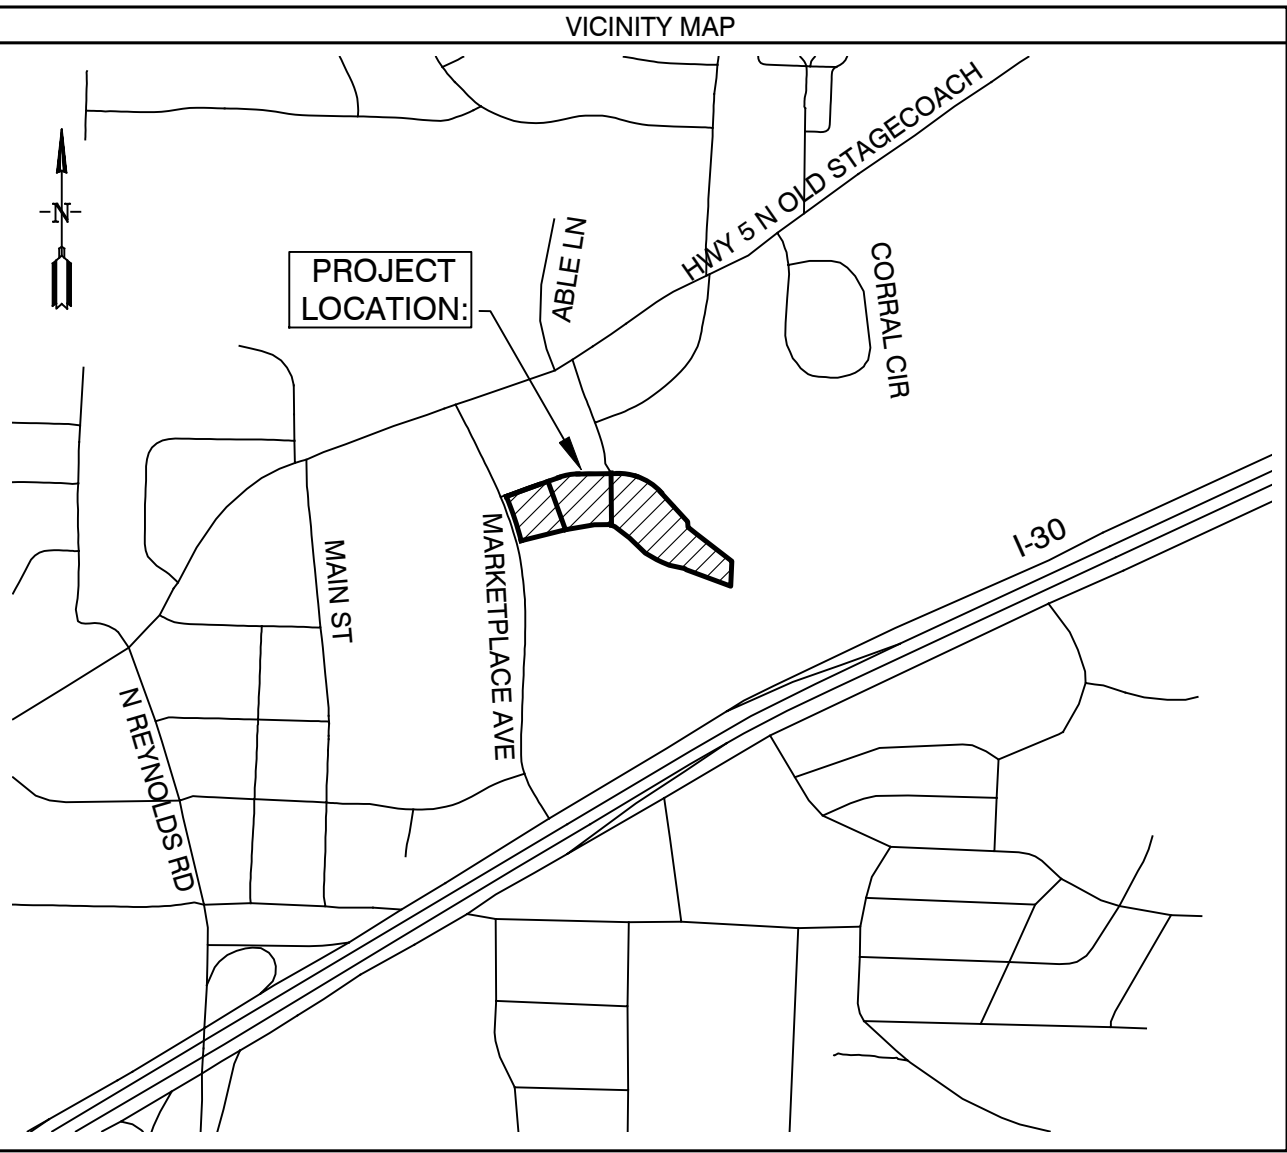

Curve Table					
Curve #	Length	Radius	Delta	Chord Direction	Chord Length
C4	101.27'	300.00'	19°20'26"	N79° 41' 39" E	100.79'
C5	252.62'	300.00'	48°14'46"	S66° 30' 47" E	245.22'
C6	243.80'	1596.45'	8°44'59"	N18° 29' 44" W	243.56'

BY

REVISION

DATE

1

2

3

4

Designing our client's success

GarNat Engineering, LLC

3825 Mt Carmel Road
Bryant, AR 72022
P.O. Box 116
Benton, AR 72018
Ph. (501) 408-4650
gamateengineering@gmail.com

MARKETPLACE EAST PHASE 1

BRYANT REALTY COMPANY, LLC

CITY OF BRYANT

SALINE COUNTY, ARKANSAS

REGISTERED PROFESSIONAL SURVEYOR

STATE OF ARKANSAS

NO. 1573

SIGNATURE

GEORGE P. WOODEN

CONTENTS:

FINAL PLAT

PROJECT NO:
20022

DATE:
JULY 2, 2025

SHEET NO:

V1.0



3825 Mt Carmel Rd.
Bryant, AR 72022

GarNat Engineering, LLC

P.O. Box 116
Benton, AR 72018

July 2, 2025

Mr. Truett Smith
Planning and Community Development
210 SW 3rd Street
Bryant, AR 72022

Re: Final Plat – Marketplace East Phase 1

Dear Mr. Smith:

Please allow this letter and the following list of documents to serve as my application for approval of the referenced final plat. It is my desire that this matter be included on the agenda for your July 2025 City of Bryant Planning Commission Meeting. The developer for the project is Bryant Realty Company, LLC, 422 North Main Street, Bryant, Arkansas 72022 (501) 840-2282.

List of Enclosures

- Final Plat
- As Builds
- Bryant Subdivision Checklist
- Bill of Assurance
- Review Fees of \$28.00

If you have questions or need any additional information, please do not hesitate to contact me.

Sincerely,
GarNat Engineering, LLC

A handwritten signature in dark ink that reads 'Vernon J. Williams'.

Vernon J. Williams, P.E., President

MARKETPLACE EAST
PHASE 1 FINAL PLAT
Bryant Planning Commission

Subdivision Checklist

Approved by
Bryant Planning Commission
07/14/2003 Revised 6/18/2007

Instructions

The attached checklist must be completed by the owner and subdivision engineer and must be submitted along with the Preliminary Plat Plan and other specified documentation for review and approval by the Planning Commission. The owner may not begin developing the subdivision until the review of the Preliminary Plat plan is approved.

No changes or alterations can be made to the approved Preliminary Plat Plan without Planning Commission approval.

When all lots have been surveyed, the utilities and drainage measures are in place, and roads have been constructed, the owner and engineer will submit a Final Plat Plan for approval by the Commission. This Final Plat Plan will incorporate all approved changes and will be verified by the City Engineer. No lots will be sold or rights-of-way and easements conveyed until the Final Plat has been submitted and approved.

Fees due to City of Bryant upon submission of Preliminary Plat application

- \$300.00 + \$3.00 per lot - for Subdivision preliminary plat review
- \$250.00 or \$25.00 per lot (**whichever is greater**) - Stormwater Detention and Drainage Plan Engineering Fee
- A Surety Bond or Cashier's check in the amount of 10% of the estimated development cost must be furnished within 10 days after Preliminary Plat approval.

Fees due to Bryant Water and Sewer Department upon submission of Final Plat application

- \$100 per lot - Water/Sewer Impact Fee
- \$100 per Subdivision Phase - Water/Sewer Flushing Fee

Fees due to City of Bryant upon submission of Final Plat application

- \$25.00 + \$1.00 per lot - for Subdivision Final Plat review

City of Bryant Subdivision Checklist

Subdivision/Project Name MARKETPLACE EAST PHASE I
Contact Person GEORGE WOODEN Phone (501) 408-4650
Mailing Address P.O. BOX 116 BENTON, AR 72018

I. BASIC INFORMATION NEEDED ON THE PLAT

- ▲ 1. Name of Subdivision/Project
- ▲ 2. Current zoning C2
- ▲ 3. Name and Address of owner of Record
- ▲ 4. Illustrate Source of Title giving deed record book and page number
- ▲ 5. Name & address of the sub-divider
- ▲ 6. Date of Survey
- ▲ 7. Vicinity map locating streets, highways, section lines, railroad, schools, & parks within ½ mile
- ▲ 8. Legal description of the property with exact boundary lines
- ▲ 9. Acreage of property
- ▲ 10. Number of Lots
- ▲ 11. Lot area in square feet
- ▲ 12. Lot lines with appropriate dimensions
- ▲ 13. Building setback lines
- ▲ 14. Preliminary Engineering certificate seal and signature on each page
- ▲ 15. Certificate of Engineering Accuracy
- ▲ 16. Certificate of Owner
- ▲ 17. Certificate of Final Plat Approval
- ▲ 18. Certificate of Recording
- ▲ 19. Show scale (not less than 1" = 100')
- ▲ 20. North Arrow
- ▲ 21. Show Title block
- ▲ 22. Show adjoining property owners
- ▲ 23. Layout of all proposed streets including traffic control devices (stop signs, speed limit, etc.)
- ▲ 24. Layout of all subdivision entrance street upgrades
- ▲ 25. Layout of all proposed alleys
- ▲ 26. Layout of all proposed sidewalk systems
- ▲ 27. Layout identifies any FEMA flood plain and flood way property within the 100-year flood elevation.
(Provide Corp of Engineers 404 Permit if required)
- ▲ 28. Drainage easements for stormwater run-off and detention giving dimensions, locations, and purpose
- ▲ 29. Layout accommodates Master Street Plan segments within the boundaries
- ▲ 30. Street layout ties to existing adjoining subdivision stub-out streets and provides stub-out streets for future adjoining subdivisions.
- ▲ 31. Street width and right-of-way properly shown for each functional classification
- ▲ 32. Street centerlines showing angles of deflection, intersection, radii, length of tangents and arcs, and degree of curvature with basis of curve data
- ▲ 33. Typical cross section of streets
- ▲ 34. Location and name of existing streets
- ▲ 35. New street names that are not similar to existing street names
- ▲ 36. Show street lights
- ▲ 37. Show Fire Hydrant placement

- ▲ 38. Show and label all permanent & proposed easements
- ▲ 39. Any proposed open space must be shown
- ▲ 40. Show the direction and flow of all water courses entering the tract
- ▲ 41. Show the direction and flow of all water courses leaving the tract
- ▲ 42. The drainage area of all water courses above the points of entry.
- ▲ 43. The downstream drainage channel and drainage structures substantially impacted by the subdivision/project.
- ▲ 44. Show source of water supply
- ▲ 45. Show location of waste water connection to municipal main & sanitary sewer layout
- ▲ 46. A phasing plan outlining the boundaries for each phase

II. ADDITIONAL INFORMATION NEEDED, BUT NOT NECESSARILY ON THE PLAT

- ▲ 47. Natural features within the proposed subdivision including drainage channels, bodies of water, wooded areas, and other significant features
- ▲ 48. Existing streets, buildings, water courses, railroads. Culverts, utilities and easement on and adjacent to the tract.
- ▲ 49. Where method of disposal of wastewater is other than connection to a public waste water system, detailed information shall accompany the plat.
- ▲ 50. Calculations and field notes, including drainage calculations along with support drawing
- ▲ 51. Stormwater detention plan approval from City Engineer (attach copy of approval)
- ▲ 52. The Certificate of Preliminary Engineering Accuracy on each set of street and drainage plans.
- ▲ 53. ADA Accessibility Standard Form completed (and attached)
- ▲ 54. A Bill of Assurance has been prepared for this subdivision (and attached)
- ▲ 55. All lots comply with minimum square footage area and minimum lot width at the front building line
- ▲ 56. Street pavement design will be as specified by City or AHTD design procedures, approved by the City Engineer.
- ▲ 57. Made the "One Call" prior to site clearance or other excavation activity

III. PRELIMINARY PLAT ATTACHMENTS

(APPLICATION WILL NOT BE ACCEPTED UNTIL ALL ATTACHMENT REQUIREMENTS ARE MET)

- ▲ 58. Letter to Planning Commission stating your request
- ▲ 59. Completed Checklist
- ▲ 60. Completed agreement to provide performance assurance
- ▲ 61. Subdivider Performance Bond or Cashier's Check for infrastructure installation
- ▲ 62. Landscaping plan of any proposed common open space
- ▲ 63. Draft of Bill of Assurance proposed for the subdivision (if applicable)
- ▲ 64. 20 copies of Preliminary Plat Plan (folded) that includes vicinity map (minimum size 17" X 34" paper)
- ▲ 65. Two (2) IBM compatible diskettes or CDR's with pertinent data and Plat in CAD compatible .DXF electronic file format
- ▲ 66. Copy of Stormwater Detention approval
- ▲ 67. 2 copies Plan and profile of all streets
- ▲ 68. Receipt for \$300.00 + \$3.00 per lot for preliminary Subdivision fee
- ▲ 69. Receipt for \$250.00 or \$25.00 per lot (whichever is greater) for Stormwater Detention and Drainage Plan review
- ▲ 70. Copy of ADEQ Stormwater Pollution Prevention Plan for property parcel containing one acre or larger.

III. FINAL PLAT ATTACHMENTS

(APPLICATION WILL NOT BE ACCEPTED UNTIL ALL ATTACHMENT REQUIREMENTS ARE MET)

- ▲ 71. Letter to Planning Commission stating your request
- ▲ 72. Completed Checklist
- ▲ 73. 20 copies of Final Plat Plan (folded) that includes vicinity map (minimum size 17" X 34" paper)
- ▲ 74. Two (2) IBM compatible diskettes or CDR's with pertinent data and Plat in CAD compatible .DXF electronic file format
- ▲ 75. Bill of Assurance including provisions set out in Title 15 Subdivision Regulations 15.16.01
- ▲ 76. Copy of Water & Sewer Commission approval or....
- ▲ 77. State Health Department approval of any new water supply and/or sewage system.
- ▲ 78. Letter submitted by a Registered Professional Engineer, certifying that all infrastructure improvements and installations have been installed in accordance with the submitted construction plans and drawings and the standards established by the City of Bryant and are functioning properly.
- ▲ 79. Infrastructure Maintenance Bond or Cashier's check.
- ▲ 80. Check for \$25.00 + \$1.00 per lot for final Subdivision fee
- ▲ 81. Check for Water Sewer impact fees (\$100.00 Flushing Fee and \$100.00 impact fee per lot)

MARKETPLACE EAST
PHASE 1

Name of Subdivision



Surveyor

I HAVE COMPLIED WITH THE REQUIREMENTS LISTED ABOVE AND HAVE CHECKED ALL OF THE BOXES ON THE CHECKLIST WHICH APPLY TO THIS PROJECT SUBMITTAL.

Owner Signature

Engineer Signature

CITY USE

Preliminary Plat Approved _____

Planning Commission Date _____

Final Plat Approved _____

Planning Commission Date _____

Proof of Recording - County _____

County Clerk _____

Date _____