
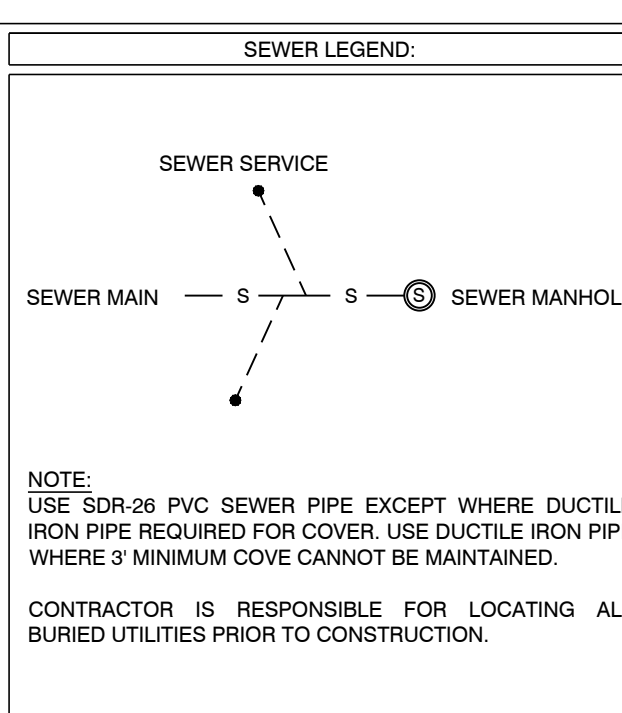
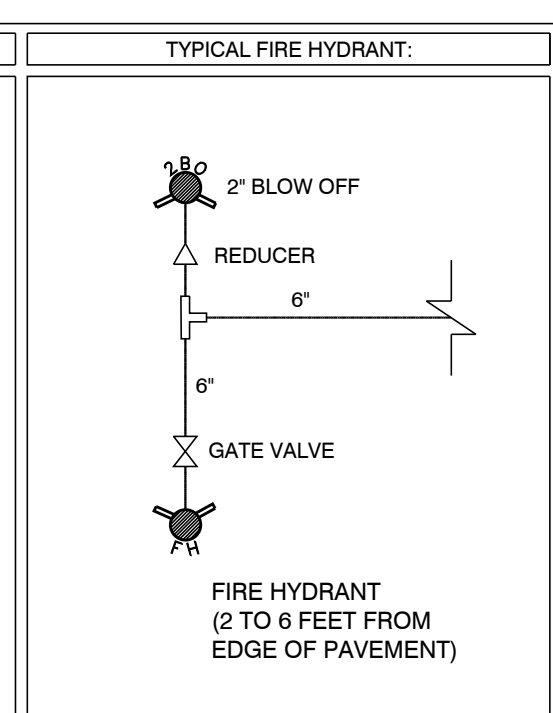


**BRYANT WATER & WASTE WATER SEWER NOTES:**

1. ALL PVC PIPE SHALL BE SDR-26 PIPE. SDR-35 SHALL NOT BE ALLOWED.
2. ALL MANHOLES INTERIORS SHALL BE COATED WITH A CORROSION-RESISTANT EPOXY LINER.

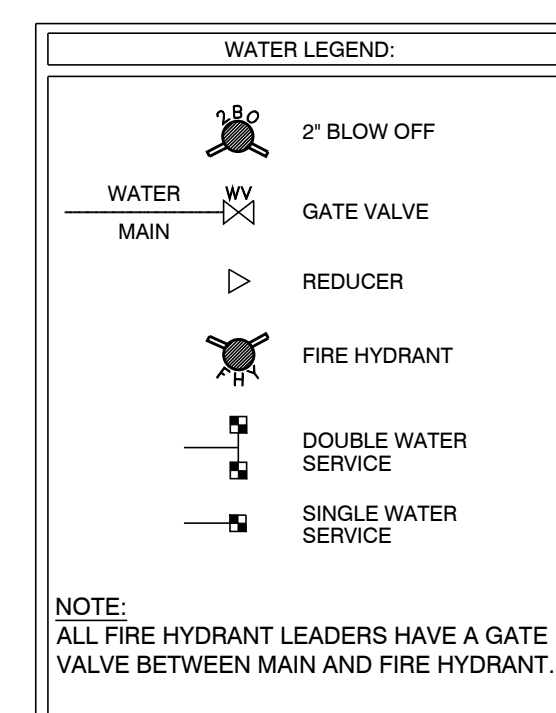

**HOPE CONSULTING**  
ENGINEERS - SURVEYORS

117 S. Market Street,  
Benton, Arkansas 72015  
PH. (501)315-2626  
FAX (501) 315-0024  
www.hopeconsulting.com

FOR USE AND BENEFIT OF:  
**LOMBARD HEIGHTS**

**WATER & SEWER ASBUILTS**  
**LOMBARD HEIGHTS, PHASE 1**  
A SUBDIVISION IN THE CITY OF BRYANT, SALINE COUNTY, ARKANSAS

DATE: 07/13/2022	C.A.D. BY: B. JOHNSON	DRAWING NUMBER:
REVISED: _____	CHECKED BY: _____	20-1388
SHEET: _____	SCALE: AS SHOWN	

500 01S 14W 16 201 62 128