

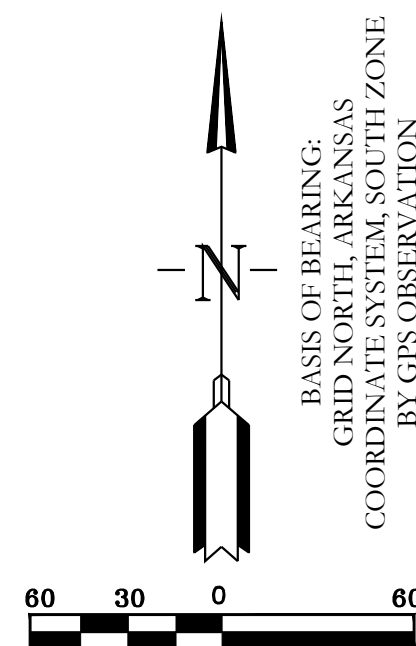
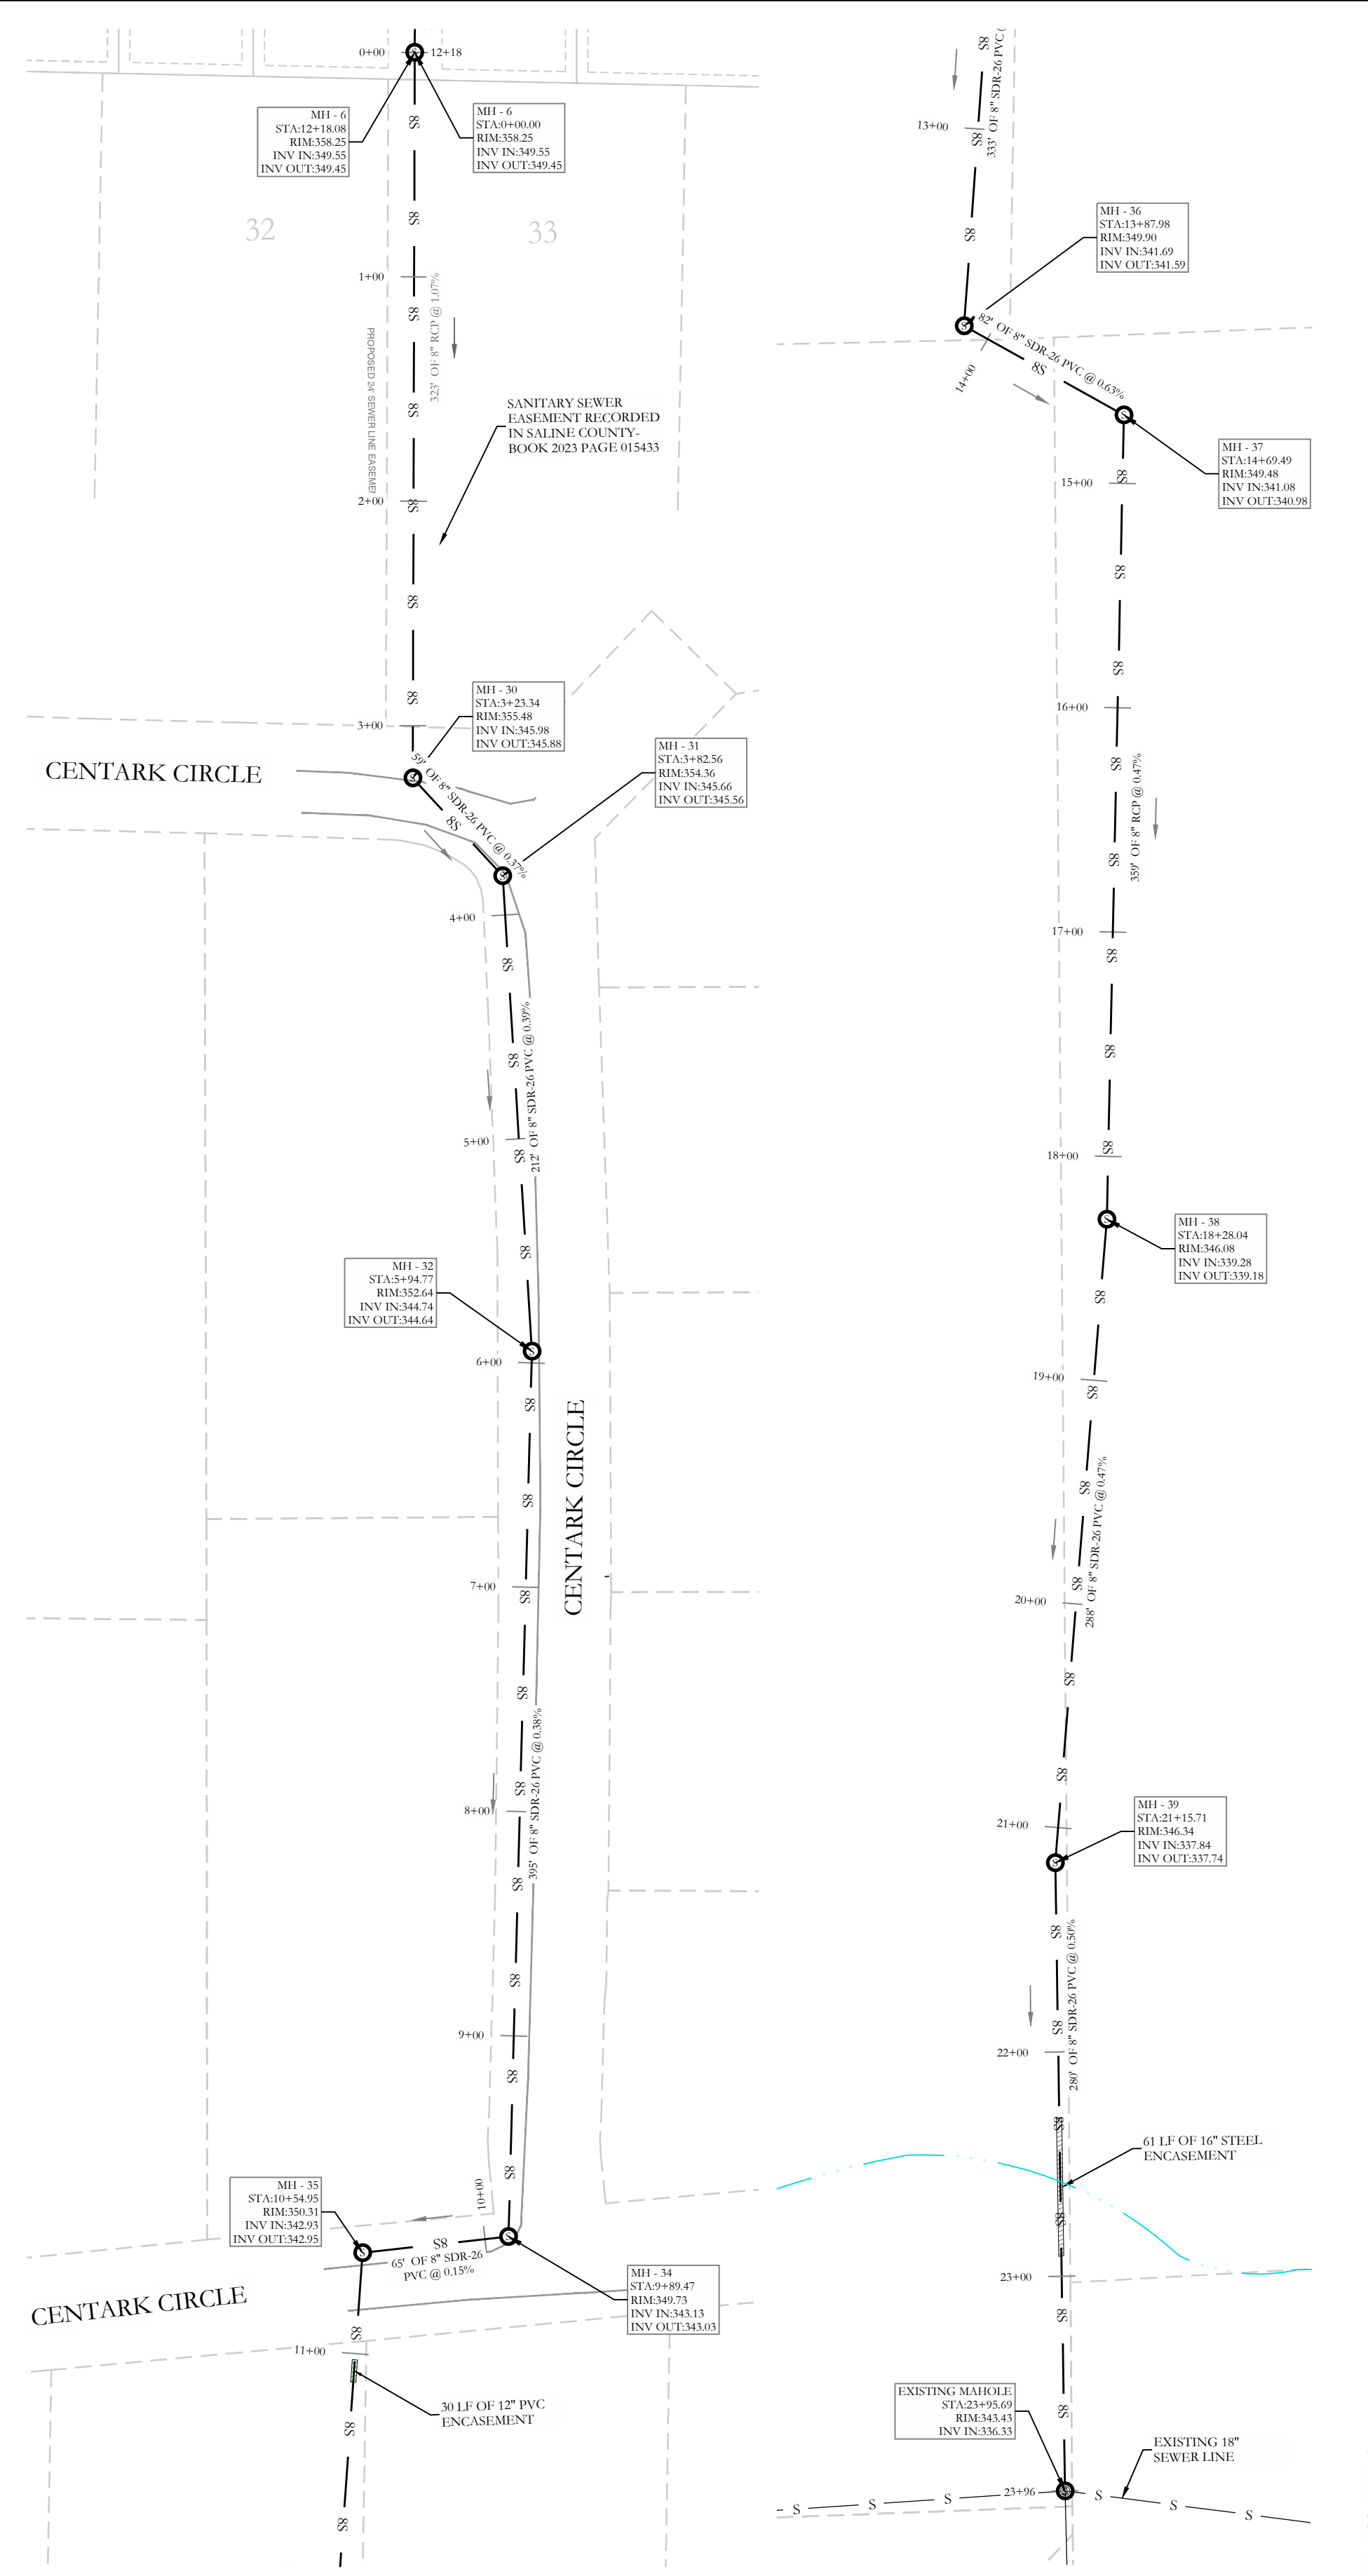
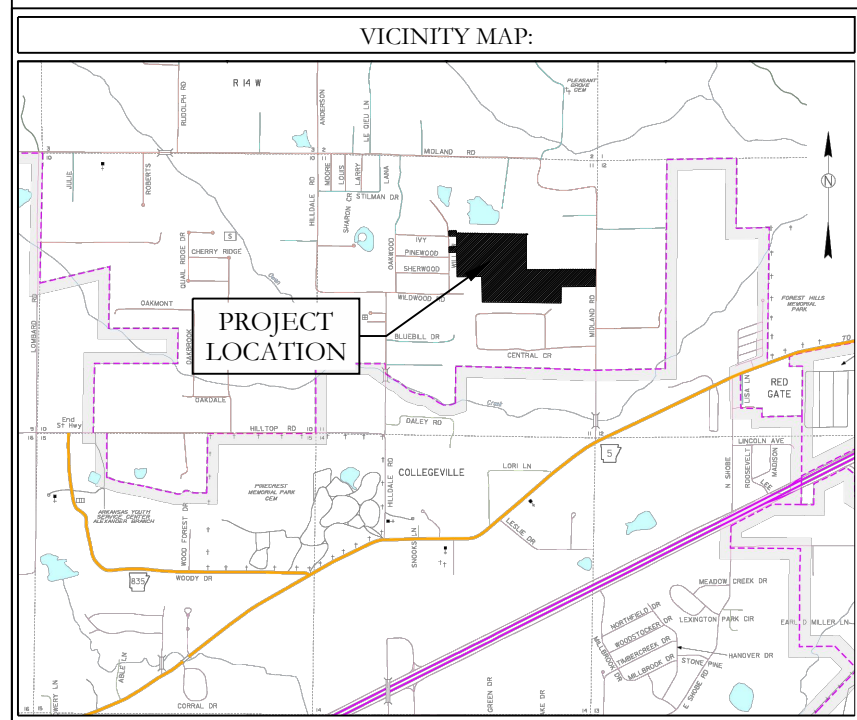




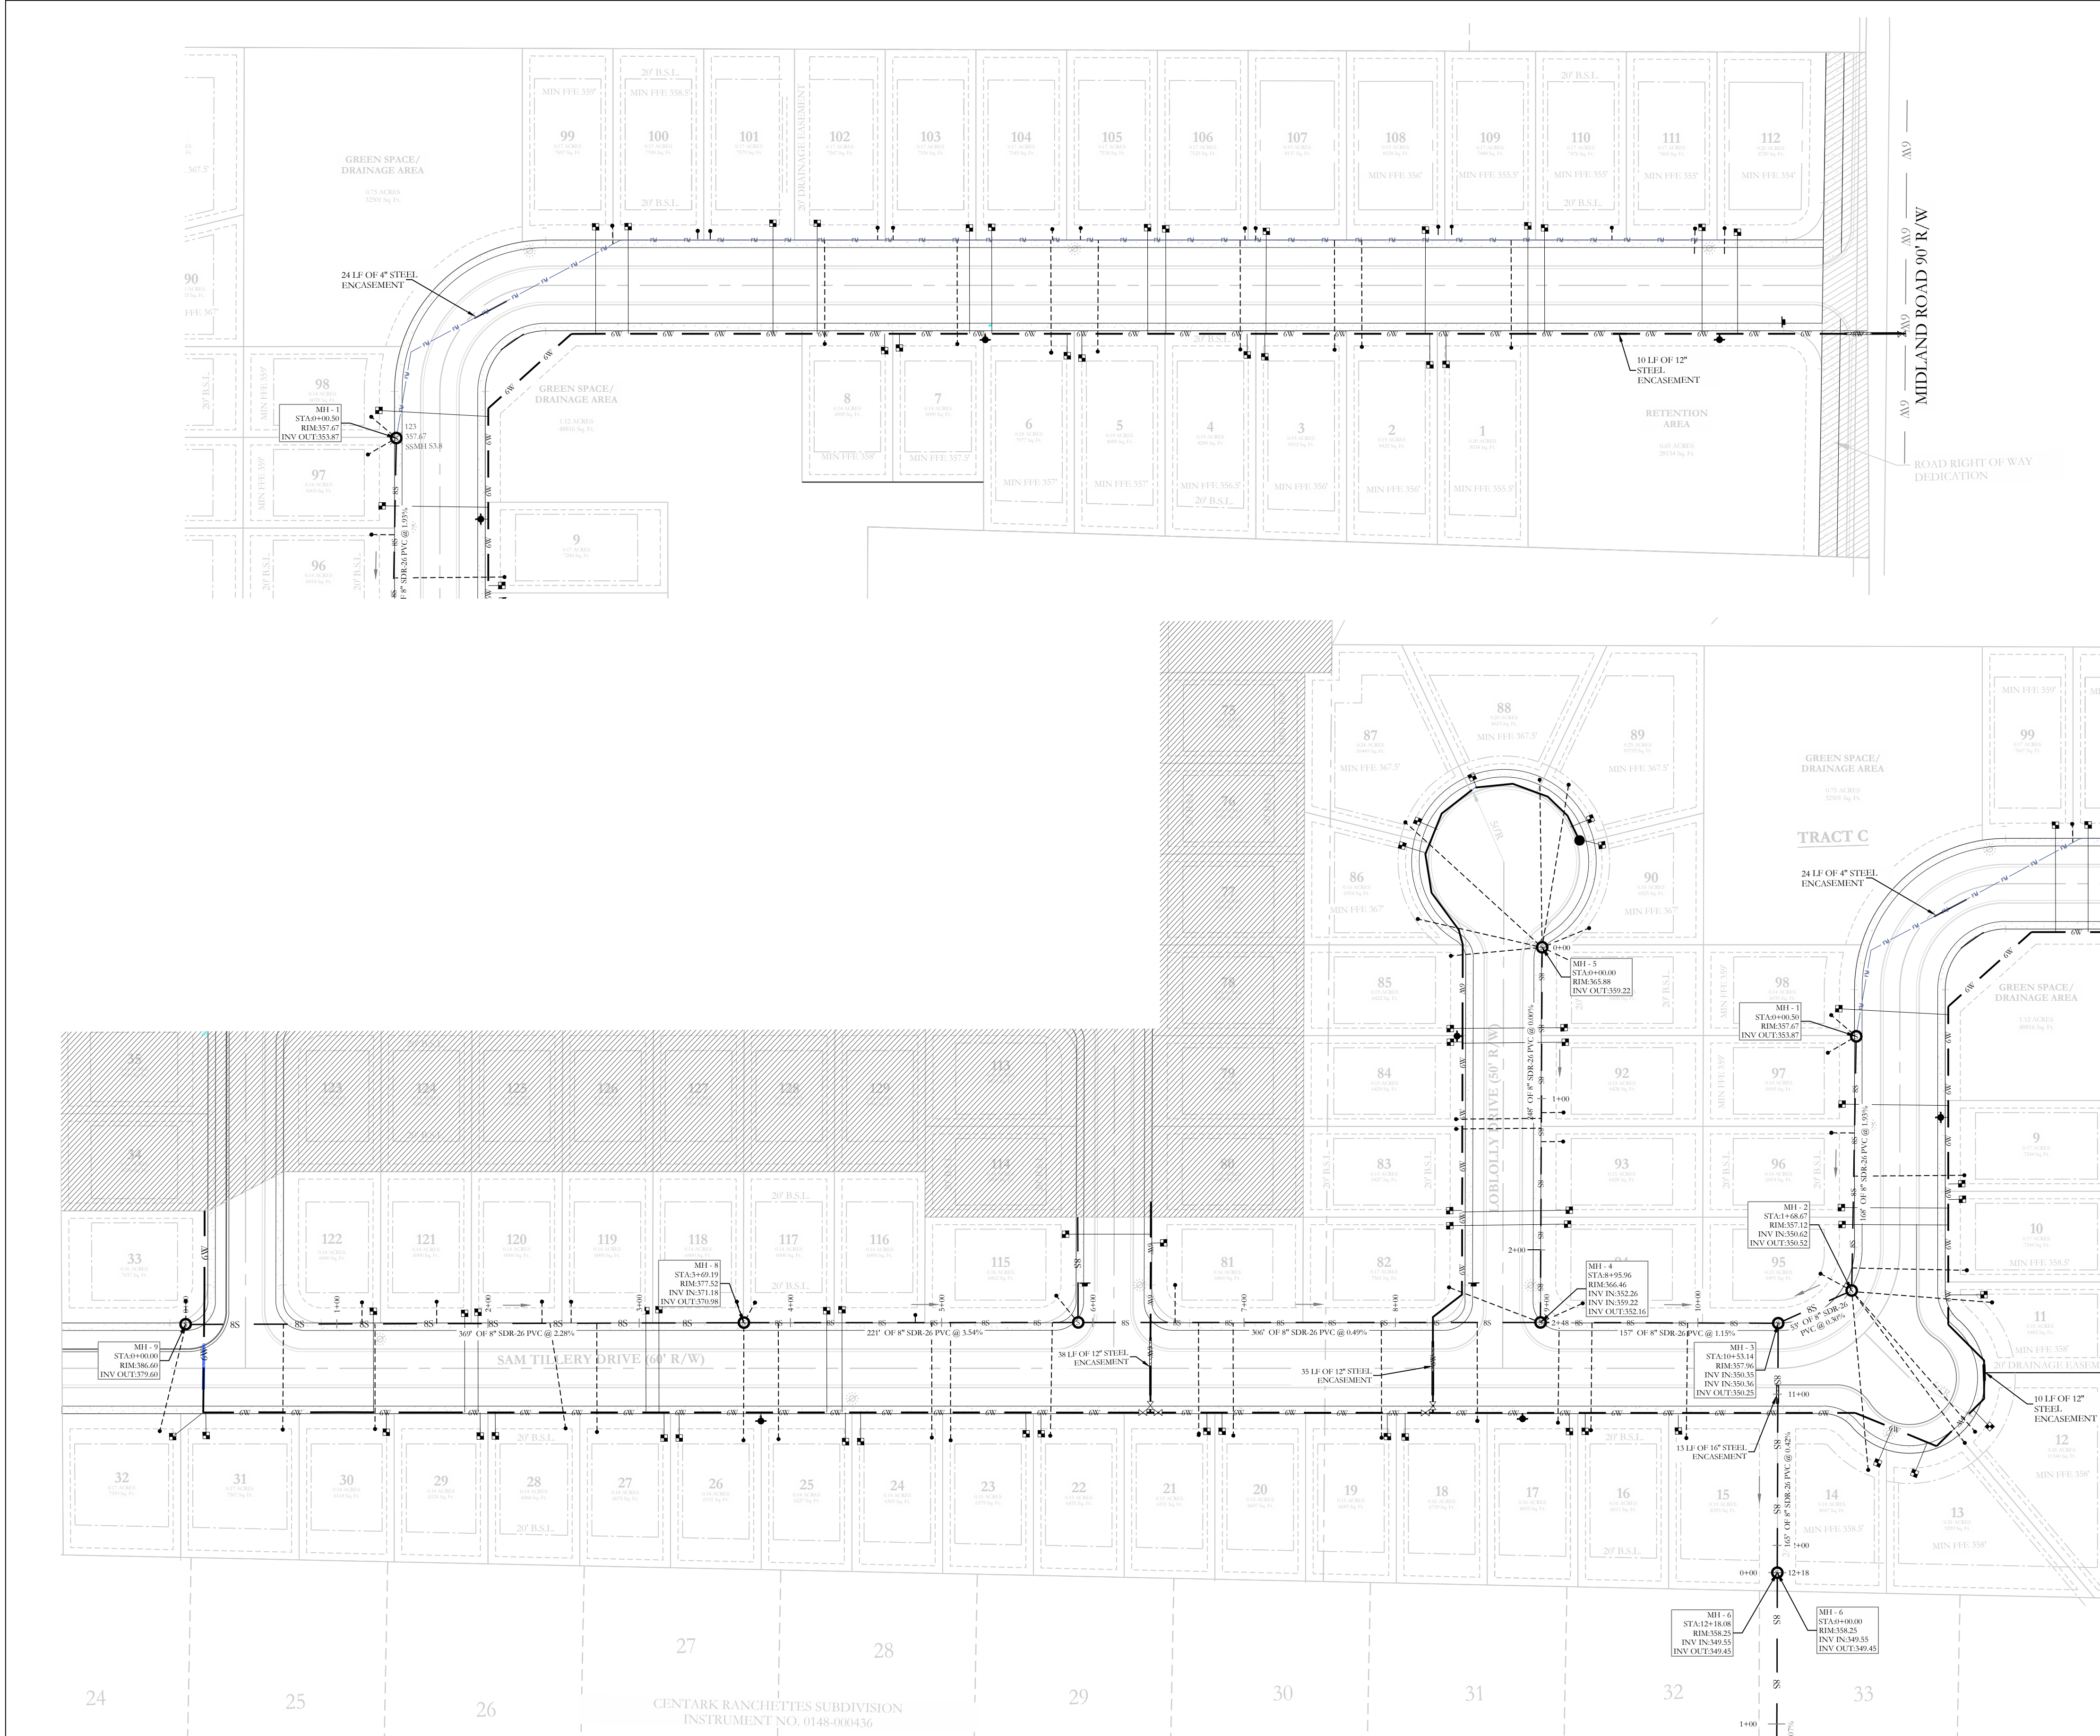


HOPE CONSULTING ENGINEERS - SURVEYORS		
FOR USE AND BENEFIT OF: HAVEN'S DEVELOPMENT, LLC		
SANITARY SEWER AS-BUILTS MIDLAND ROAD ESTATES IN THE CITY OF BRYANT, SALINE COUNTY, ARKANSAS		
DATE: 12/13/2024	C.A.D. BY:	DRAWING NUMBER:
REVISED:	CHECKED BY:	23-0024
SHEET:	SCALE: 1" = 60'	
500	0	

129 North Main Street,
Benton, Arkansas 72015
PH. (501)315-2626
FAX (501) 315-0024
www.hopeconsulting.com

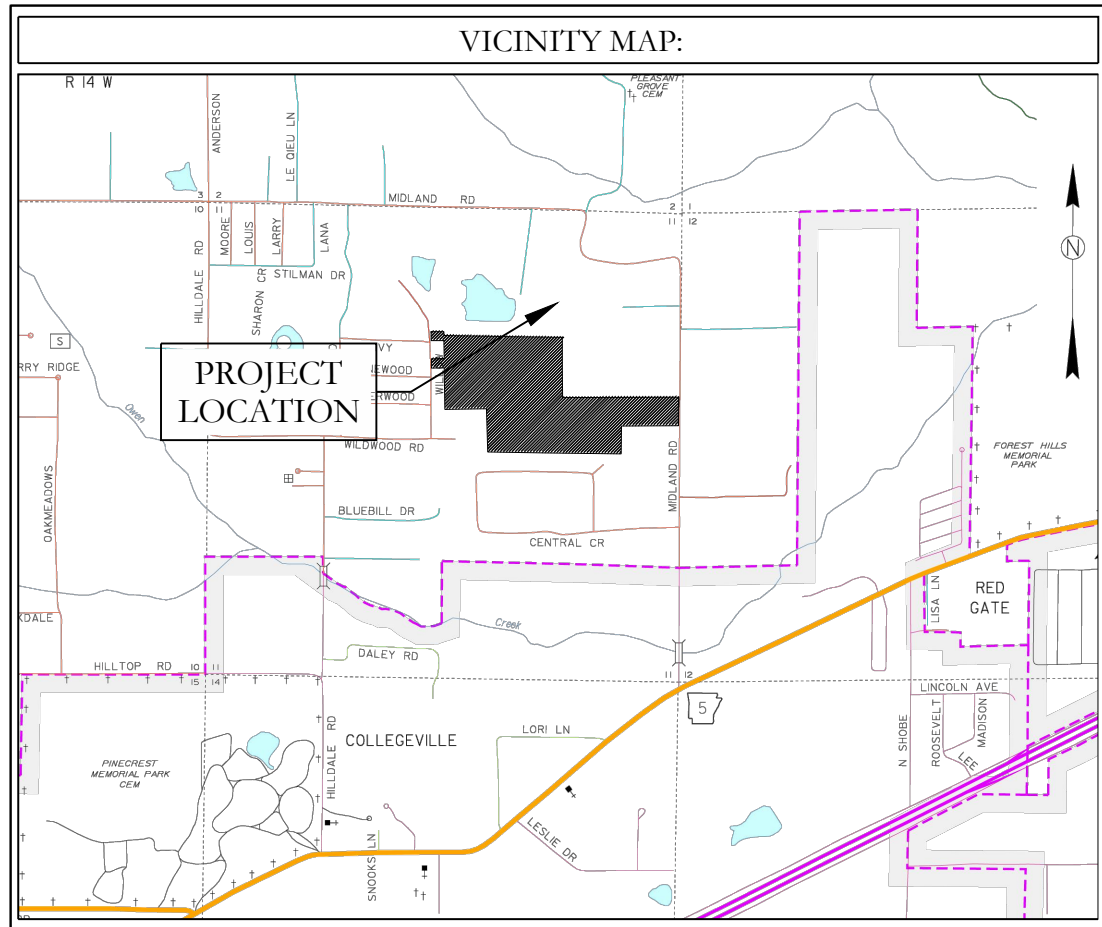

--- HDPE
--- RCP

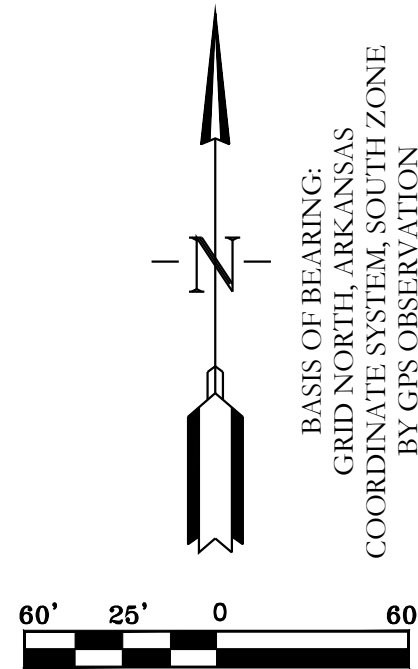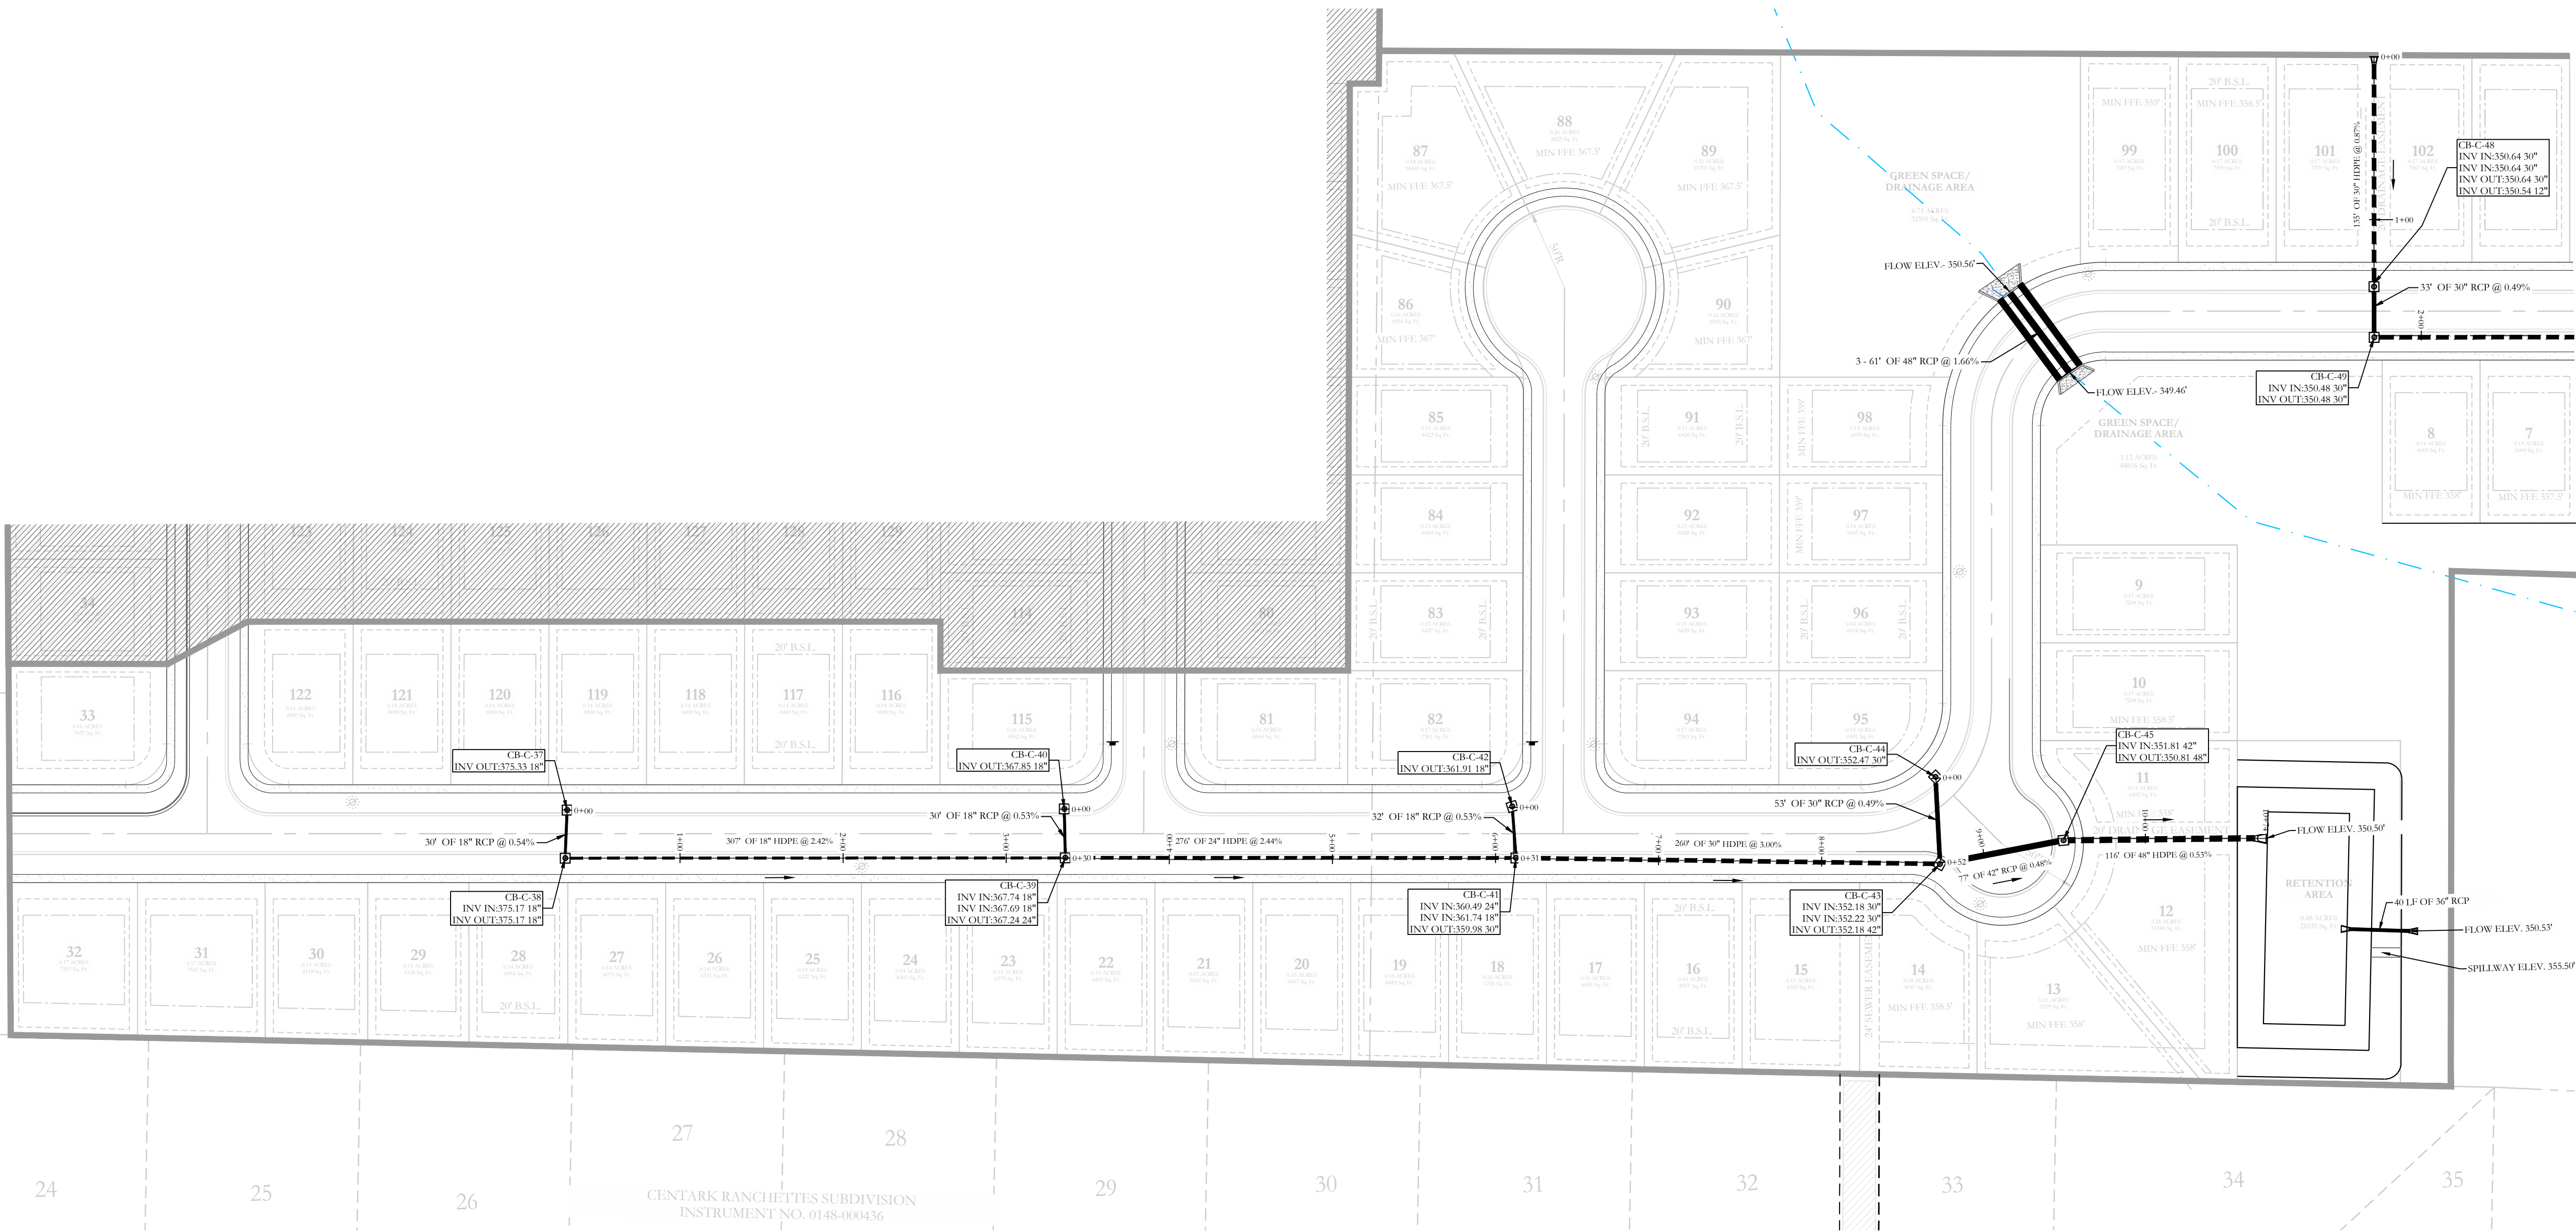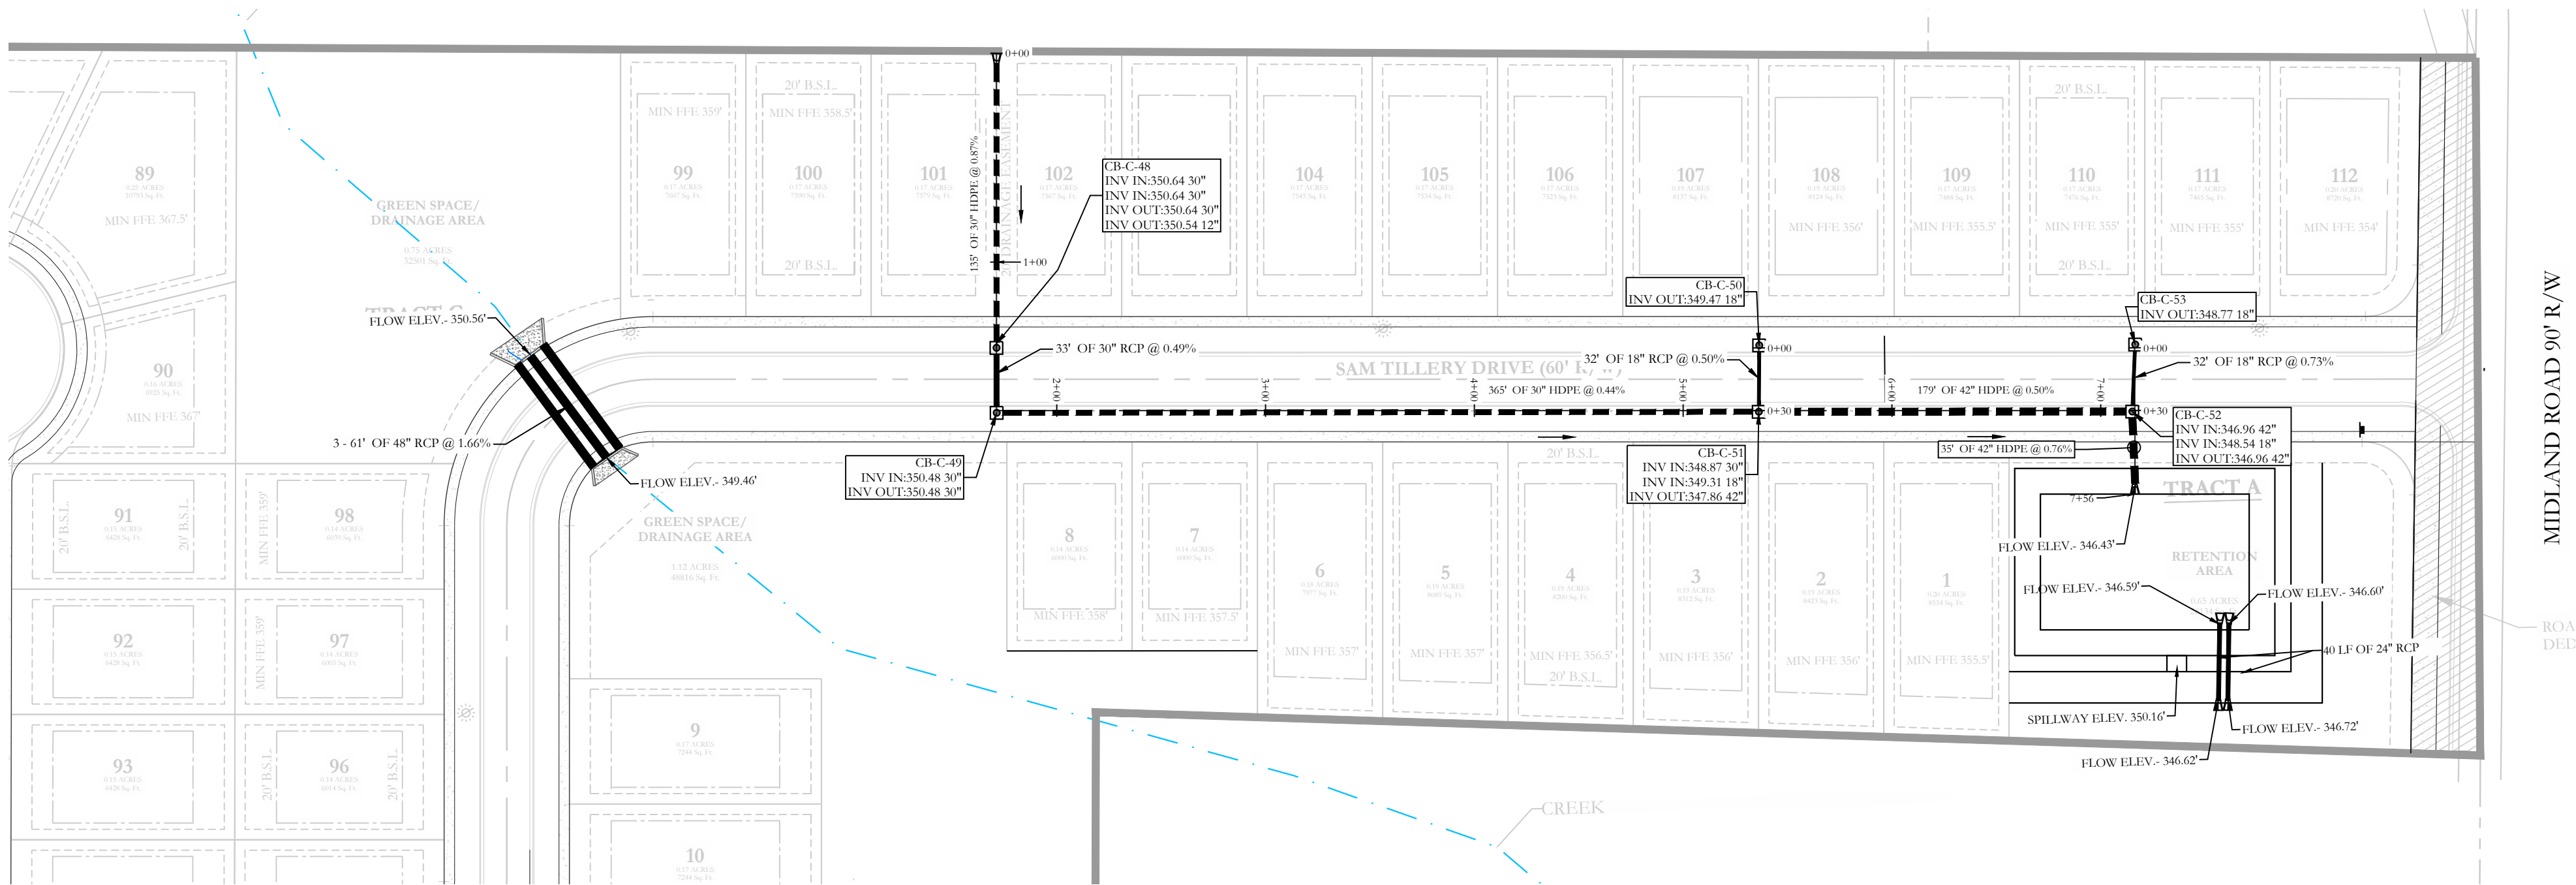

HOPE CONSULTING ENGINEERS - SURVEYORS		129 North Main Street, Benton, Arkansas 72015 PH. (501)315-2626 FAX (501) 315-0024 www.hopeconsulting.com	
FOR USE AND BENEFIT OF: HAVEN'S DEVELOPMENT, LLC			
MIDLAND ROAD ESTATES DRAINAGE AS-BUILTS IN THE CITY OF BRYANT, SALINE COUNTY, ARKANSAS			
DATE: 12/13/2024	C.A.D. BY:	DRAWING NUMBER:	
REVISED:	CHECKED BY:	23-0024	
SHEET:	SCALE: 1" = 60'		
500	0		