
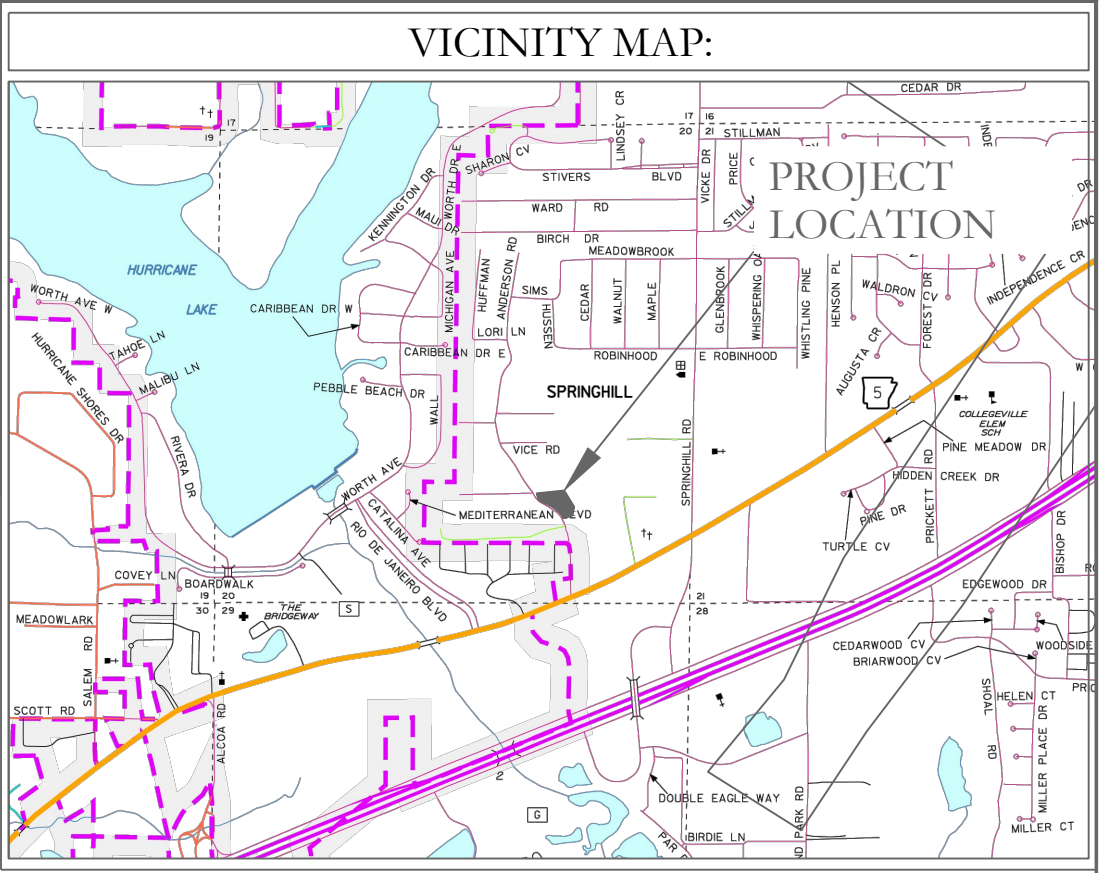


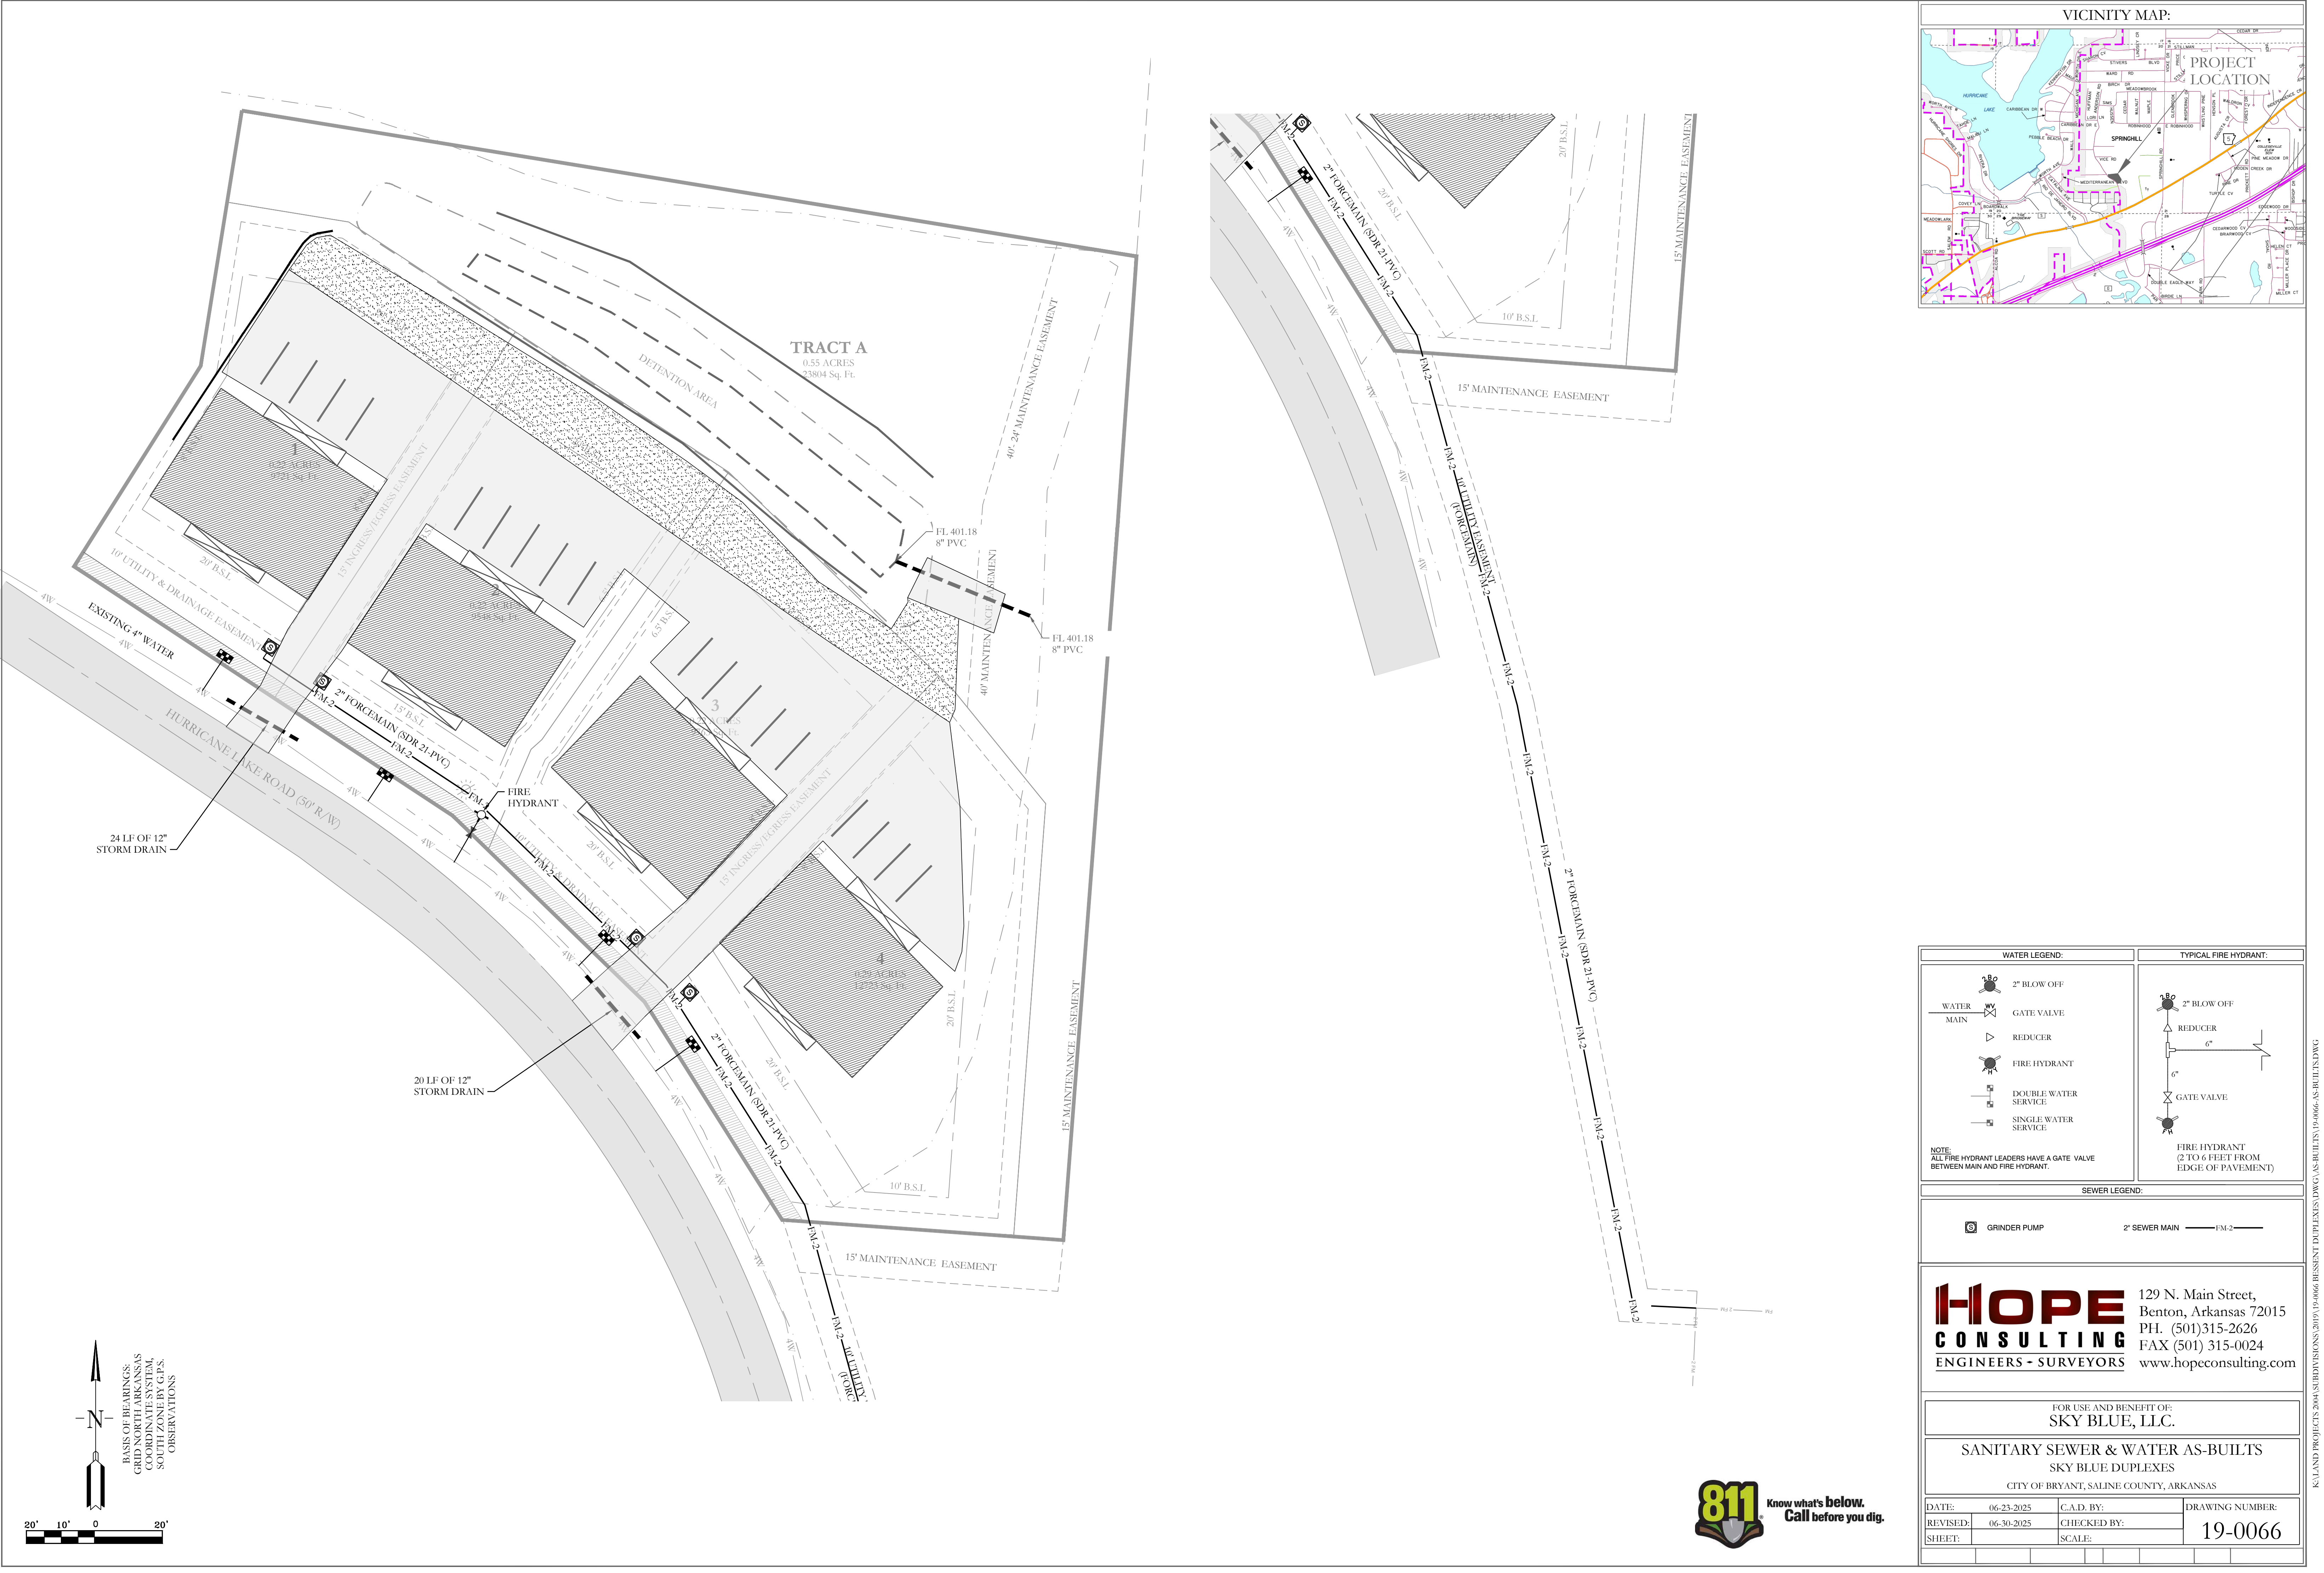

| WATER LEGEND:                                                                         |                      | TYPICAL FIRE HYDRANT:                                  |              |
|---------------------------------------------------------------------------------------|----------------------|--------------------------------------------------------|--------------|
|                                                                                       | 2" BLOW OFF          |                                                        | 2" BLOW OFF  |
|                                                                                       | WATER MAIN           |                                                        | REDUCER      |
|                                                                                       | GATE VALVE           |                                                        | GATE VALVE   |
|                                                                                       | REDUCER              |                                                        | FIRE HYDRANT |
|                                                                                       | FIRE HYDRANT         |                                                        | FIRE HYDRANT |
|                                                                                       | DOUBLE WATER SERVICE |                                                        | FIRE HYDRANT |
|                                                                                       | SINGLE WATER SERVICE |                                                        | FIRE HYDRANT |
| NOTE:<br>ALL FIRE HYDRANT LEADERS HAVE A GATE VALVE<br>BETWEEN MAIN AND FIRE HYDRANT. |                      | FIRE HYDRANT<br>(2 TO 6 FEET FROM<br>EDGE OF PAVEMENT) |              |

| SEWER LEGEND: |               |
|---------------|---------------|
|               | GRINDER PUMP  |
|               | 2" SEWER MAIN |
|               | FM-2          |

HOPE

CONSULTING

ENGINEERS - SURVEYORS

129 N. Main Street,  
Benton, Arkansas 72015  
PH. (501)315-2626  
FAX (501) 315-0024  
www.hopeconsulting.com

| FOR USE AND BENEFIT OF:<br>SKY BLUE, LLC.             |            |             |                 |
|-------------------------------------------------------|------------|-------------|-----------------|
| SANITARY SEWER & WATER AS-BUILTS<br>SKY BLUE DUPLEXES |            |             |                 |
| CITY OF BRYANT, SALINE COUNTY, ARKANSAS               |            |             |                 |
| DATE:                                                 | 06-23-2025 | C.A.D. BY:  | DRAWING NUMBER: |
| REVISED:                                              | 06-30-2025 | CHECKED BY: | 19-0066         |
| SHEET:                                                |            | SCALE:      |                 |



K:\LAND PROJECTS\2004\SUBDIVISIONS\2019\19-0066\RESIDENT DUPLEXES\DWG\AS-BUILTS\19-0066-AS-BUILD.DWG