

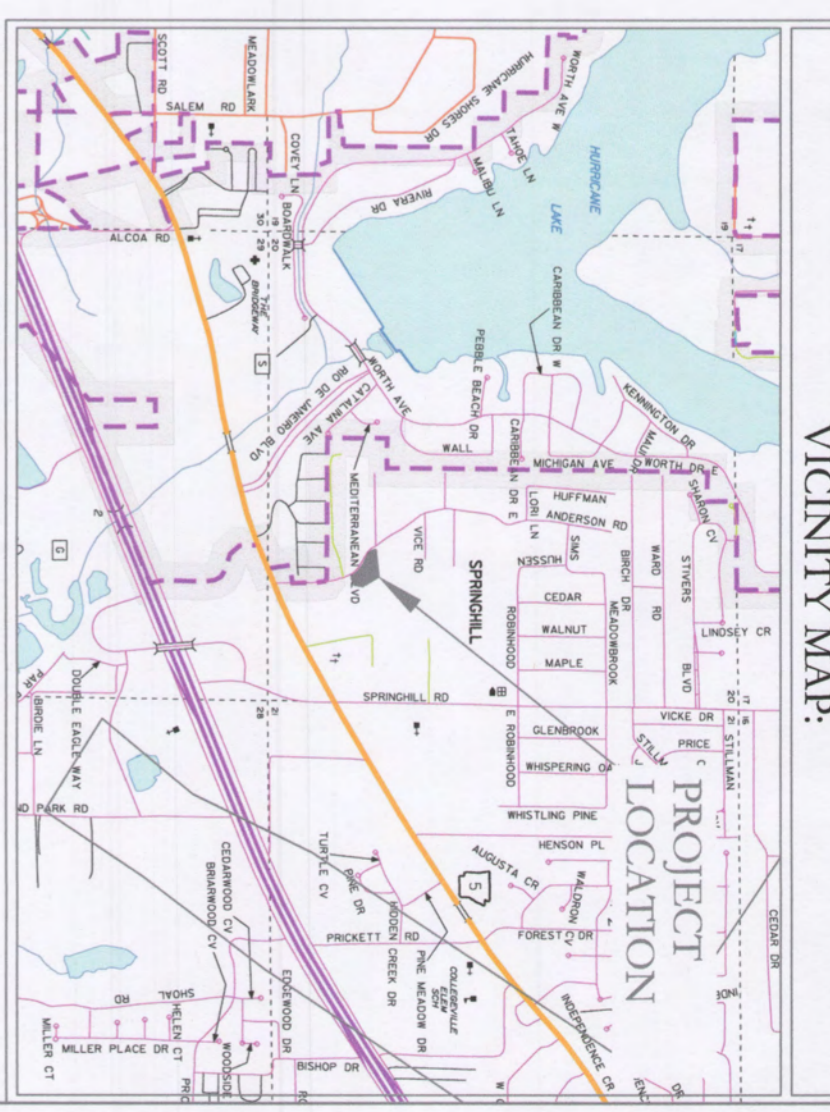


BASIS OF BEARINGS:
GRID NORTH ARKANSAS
COORDINATE SYSTEM,
SOUTH ZONE BY G.P.S.
OBSERVATIONS

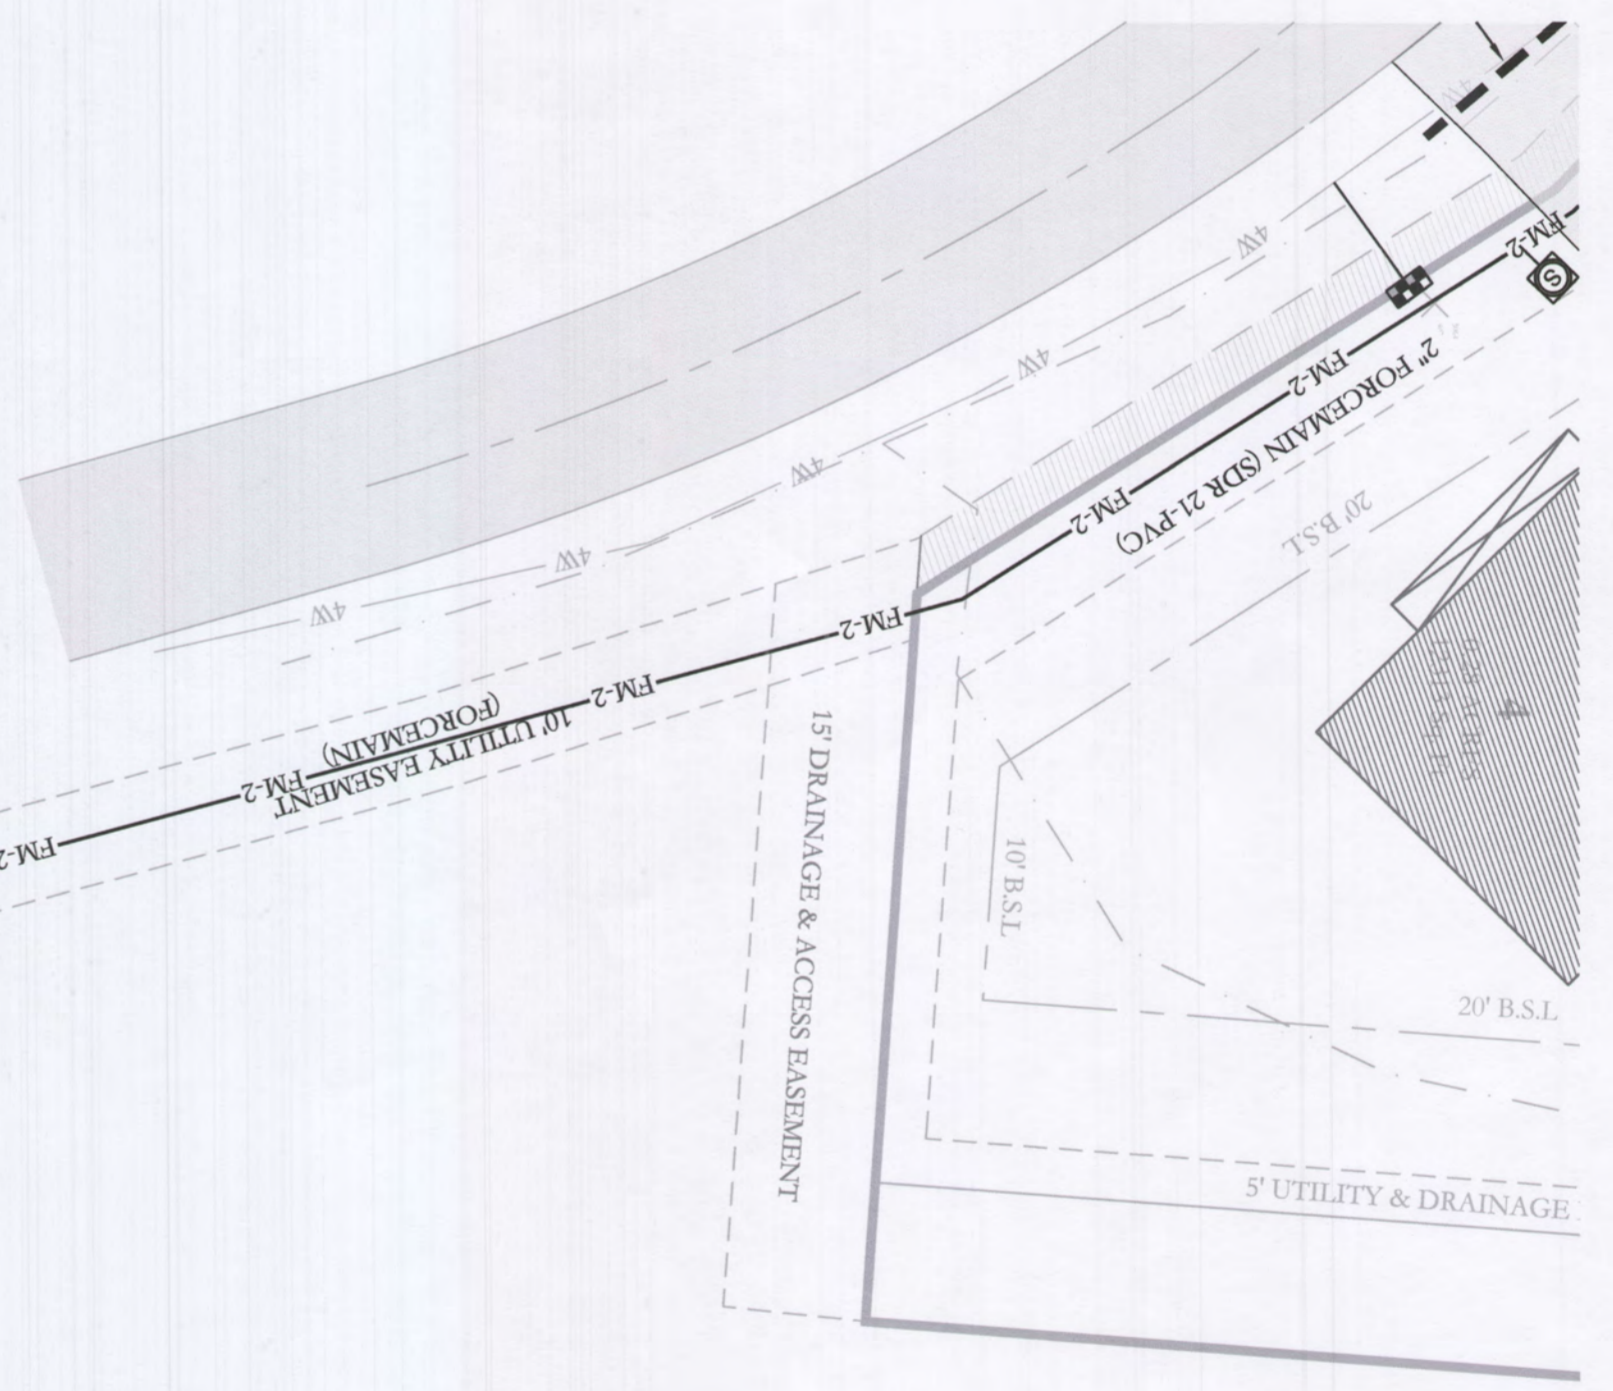

VICINITY MAP:

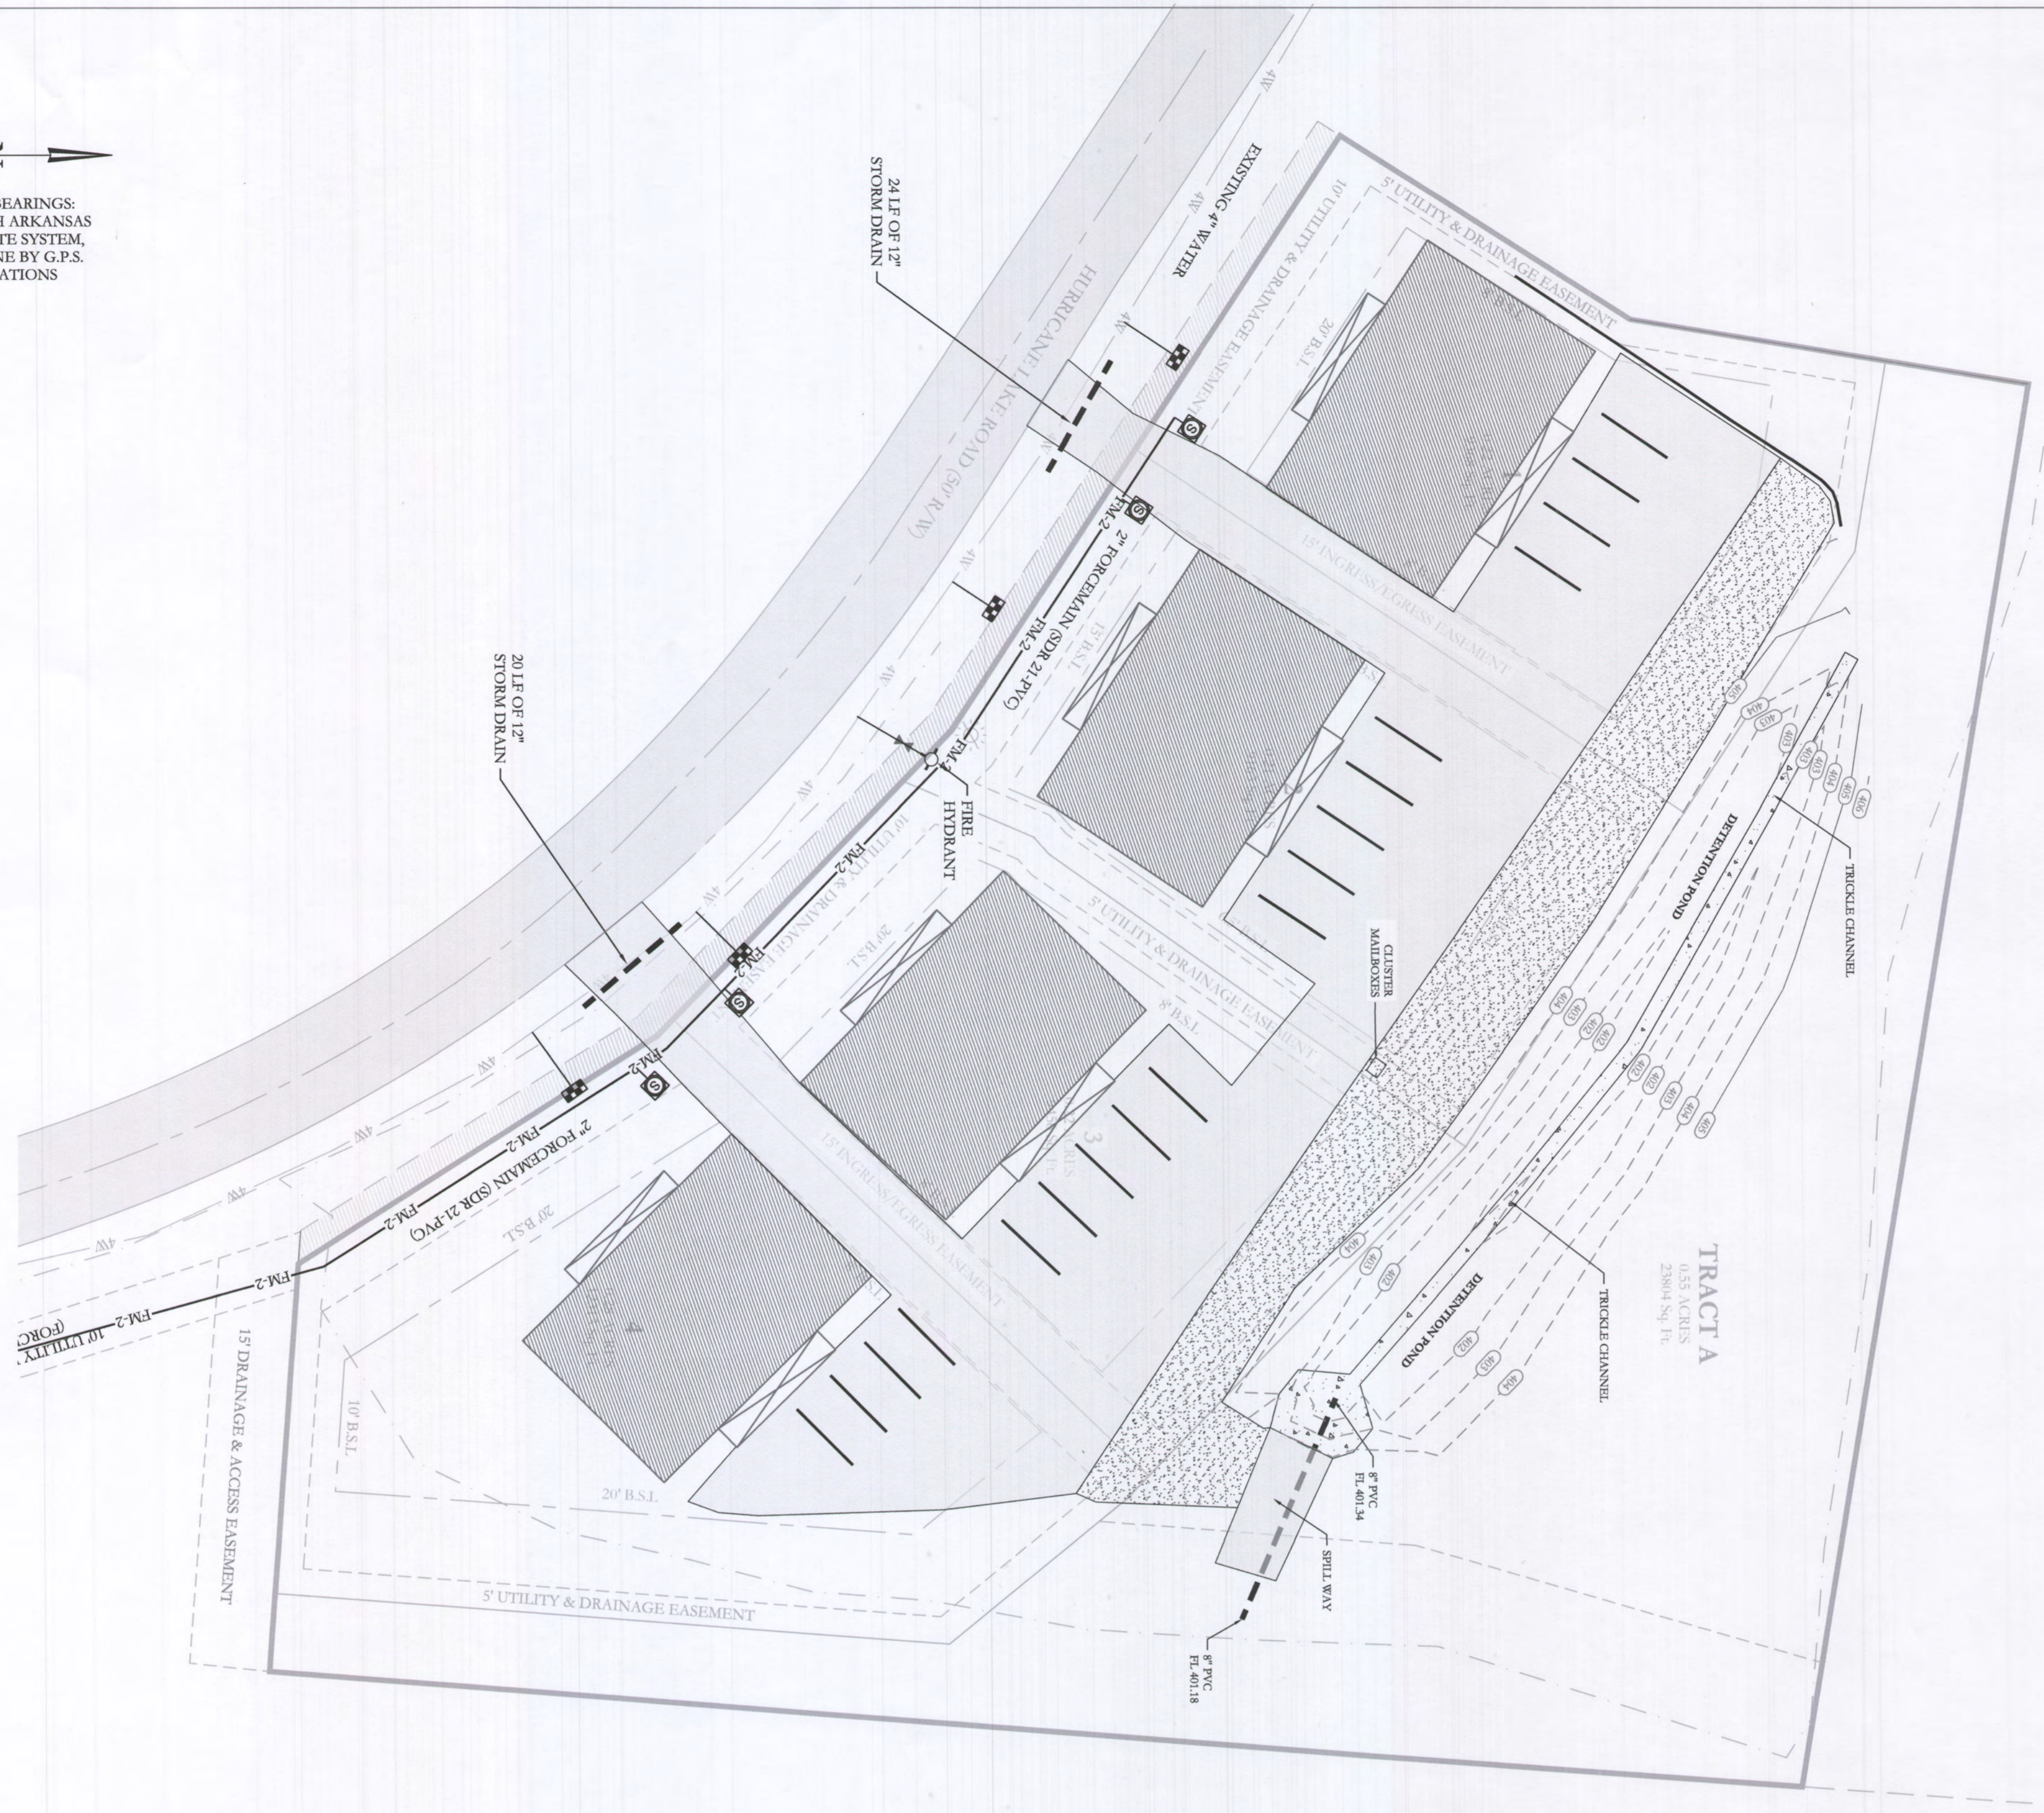

811
Know what's below.
Call before you dig.

<p>HOPE CONSULTING ENGINEERS - SURVEYORS</p> <p>129 N. Main Street, Benton, Arkansas 72015 PH. (501) 315-2626 FAX (501) 315-0024 www.hopeconsulting.com</p>		<p>FOR USE AND BENEFIT OF: SKY BLUE, LLC. SANITARY SEWER & WATER AS-BUILTS CITY OF BRYANT, SALINE COUNTY, ARKANSAS</p>	
DATE:	06-23-2025	C.A.D. BY:	
REVISED:	07-29-2025	CHECKED BY:	
SHEET:		SCALE:	
		DRAWING NUMBER:	19-0066

<p>WATER LEGEND:</p> <ul style="list-style-type: none"> 2" BLOW OFF WATER MAIN GATE VALVE REDUCER FIRE HYDRANT DOUBLE WATER SERVICE SINGLE WATER SERVICE 	<p>TYPICAL FIRE HYDRANT:</p>
<p>SEWER LEGEND:</p> <ul style="list-style-type: none"> GRINDER PUMP SEWER MAIN 	<p>NOTE: ALL FIRE HYDRANT LEADERS HAVE A GATE VALVE BETWEEN MAIN AND THE HYDRANT.</p>