
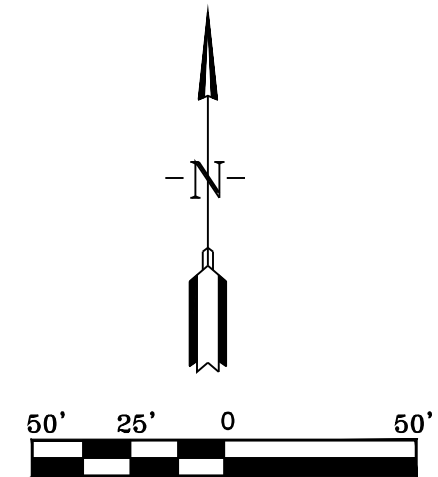


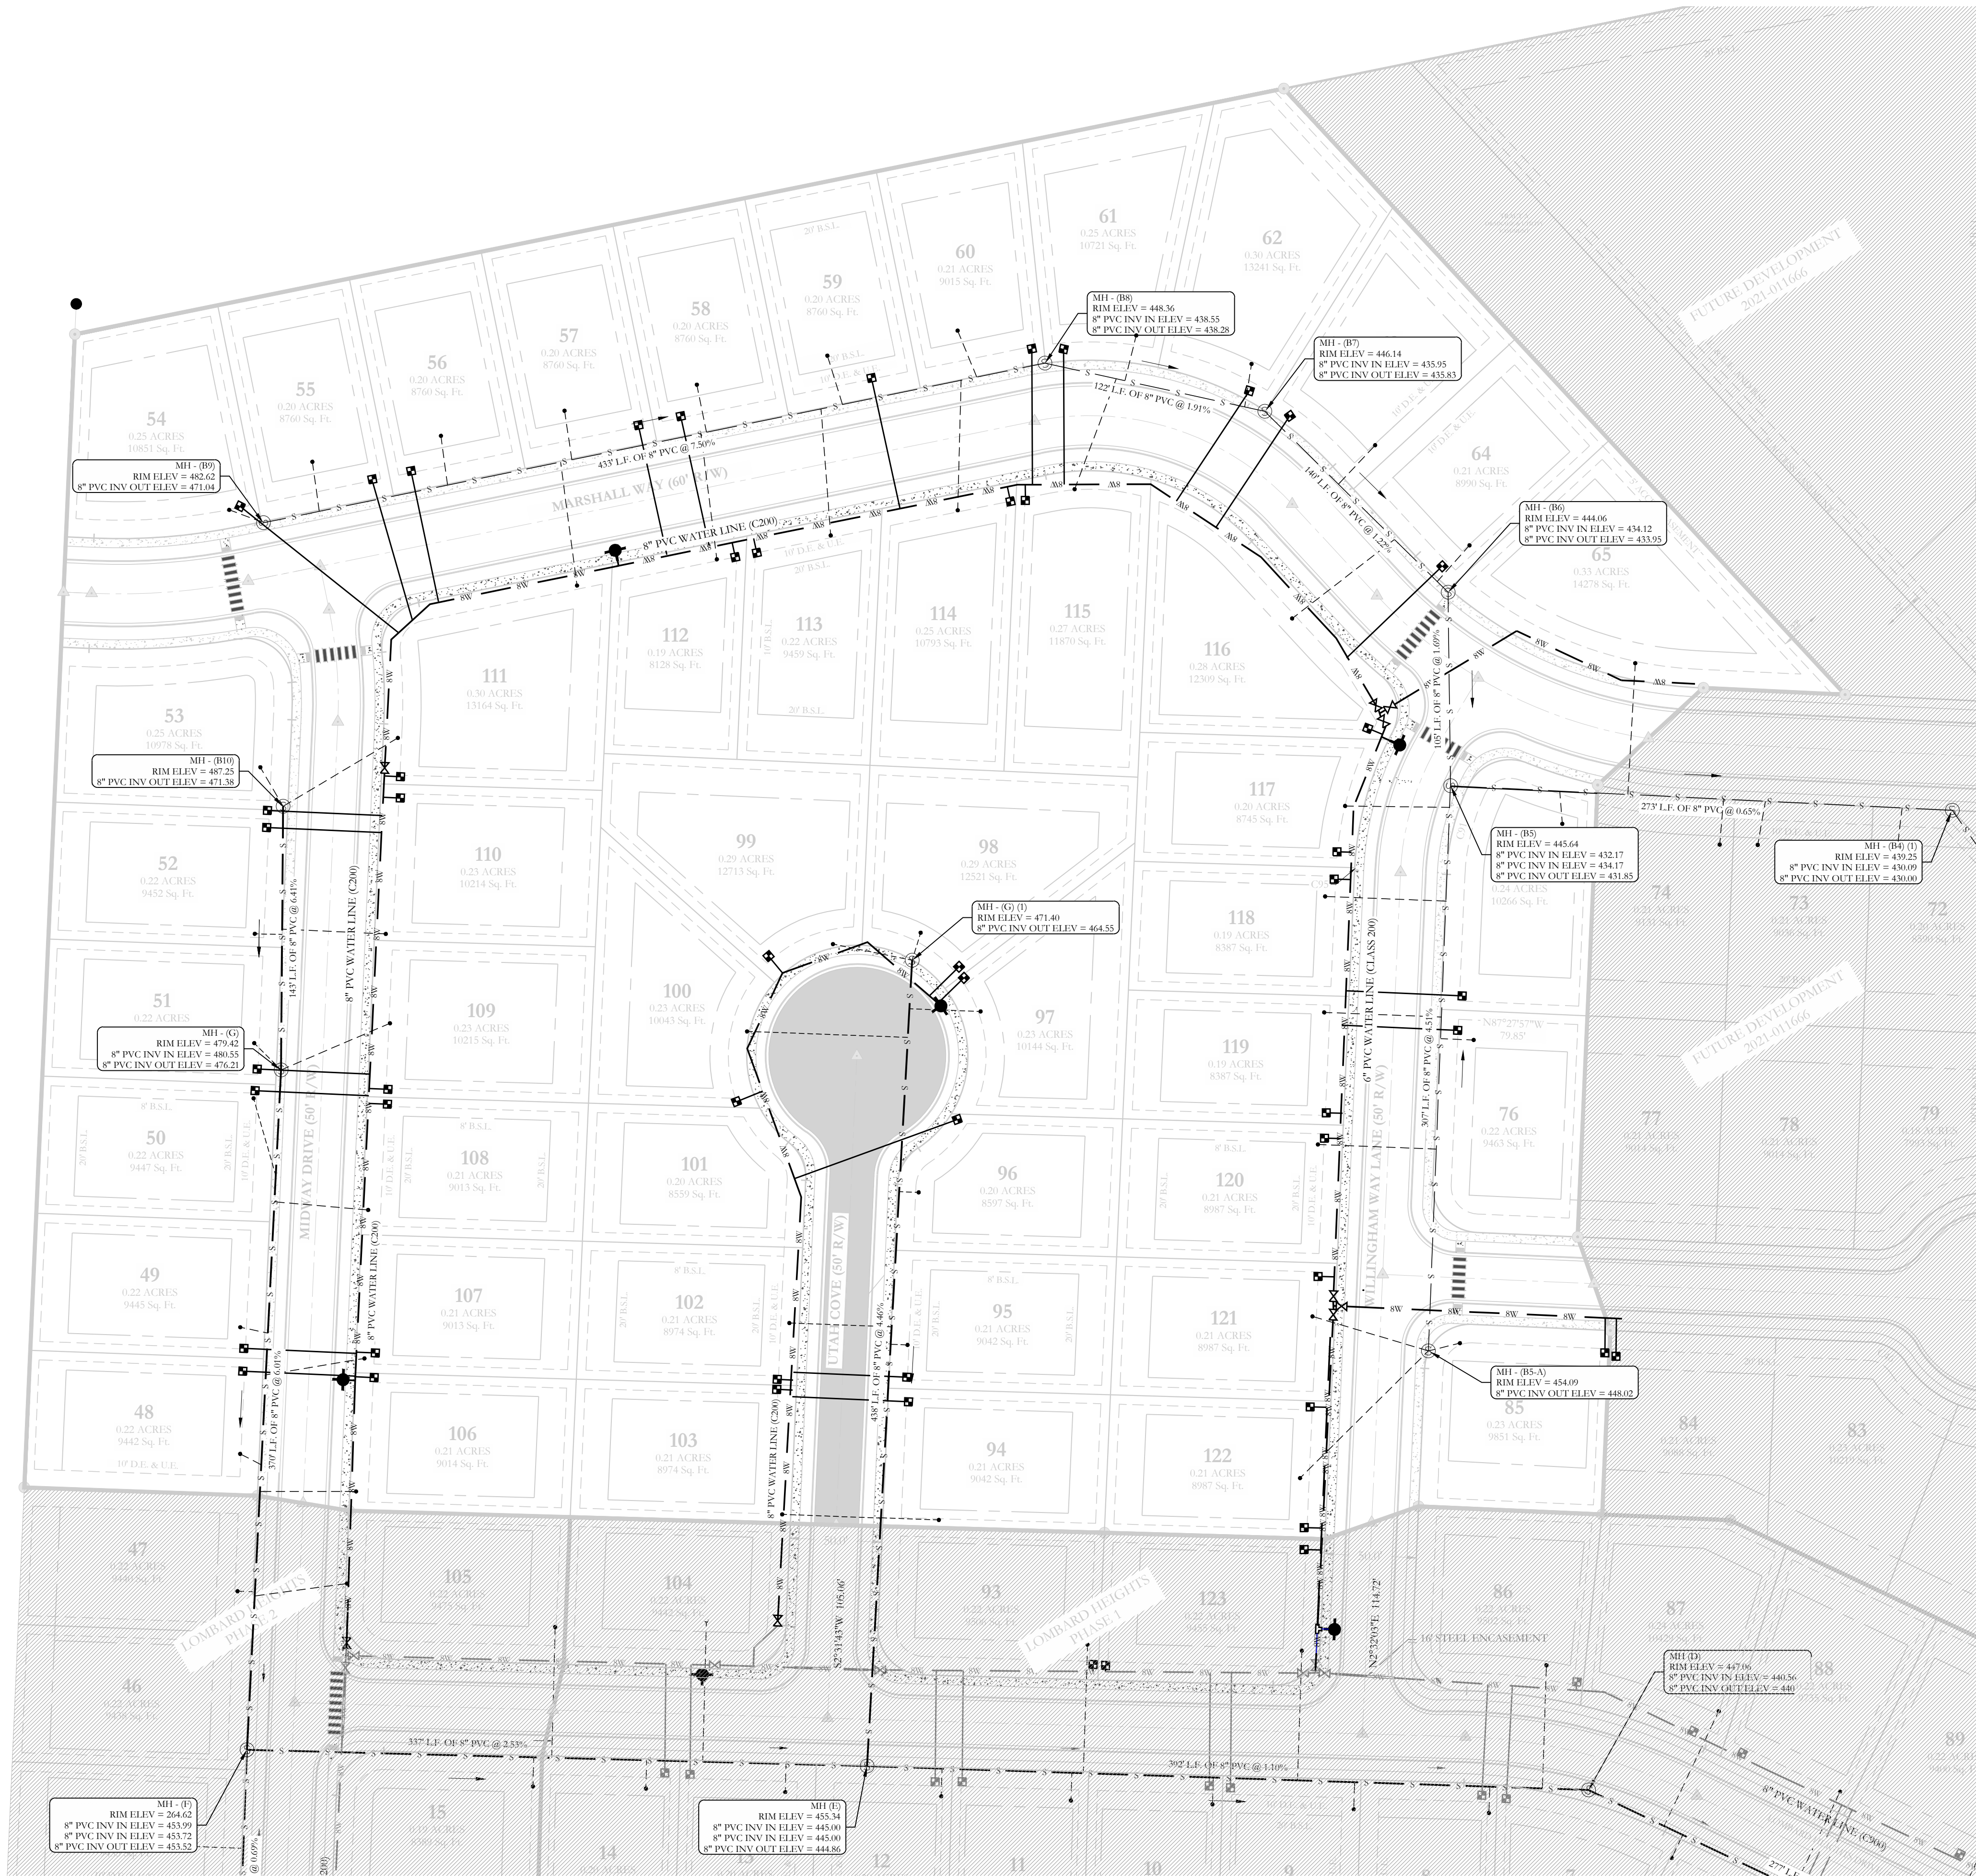

WATER LEGEND:		TYPICAL FIRE HYDRANT:	
	2" BLOW OFF		2" BLOW OFF
	GATE VALVE		REDUCER
	REDUCER		6"
	FIRE HYDRANT		GATE VALVE
	DOUBLE WATER SERVICE		FIRE HYDRANT
	SINGLE WATER SERVICE		(2 TO 6 FEET FROM EDGE OF PAVEMENT)
NOTE: ALL FIRE HYDRANT LEADERS HAVE A GATE VALVE BETWEEN MAIN AND FIRE HYDRANT.			
SEWER LEGEND:			
	SEWER SERVICE	NOTE: USE SDR-26 PVC SEWER PIPE EXCEPT WHERE DUCTILE IRON PIPE REQUIRED FOR COVER. USE DUCTILE IRON PIPE WHERE 3" MINIMUM COVER CANNOT BE MAINTAINED. CONTRACTOR IS RESPONSIBLE FOR LOCATING ALL BURIED UTILITIES PRIOR TO CONSTRUCTION.	
	SEWER MAIN		
	SEWER MANHOLE		
HOPE CONSULTING ENGINEERS - SURVEYORS			
FOR USE AND BENEFIT OF: LOMBARD HEIGHTS			
WATER & SEWER AS-BUILTS LOMBARD HEIGHTS, PHASE 3 A SUBDIVISION IN THE CITY OF BRYANT, SALINE COUNTY, ARKANSAS			
DATE: 09/29/2025	C.A.D. BY: BJOHNSON	DRAWING NUMBER:	
REVISED:	CHECKED BY:	20-1388	
SHEET:	SCALE: AS SHOWN		

117 S. Market Street, Benton, Arkansas 72015
PH. (501)315-2626
FAX (501) 315-0024
www.hopeconsulting.com