
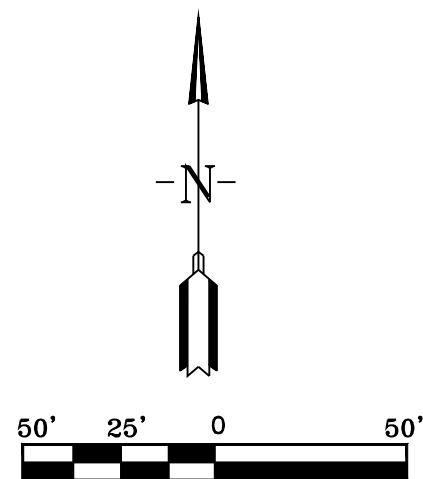


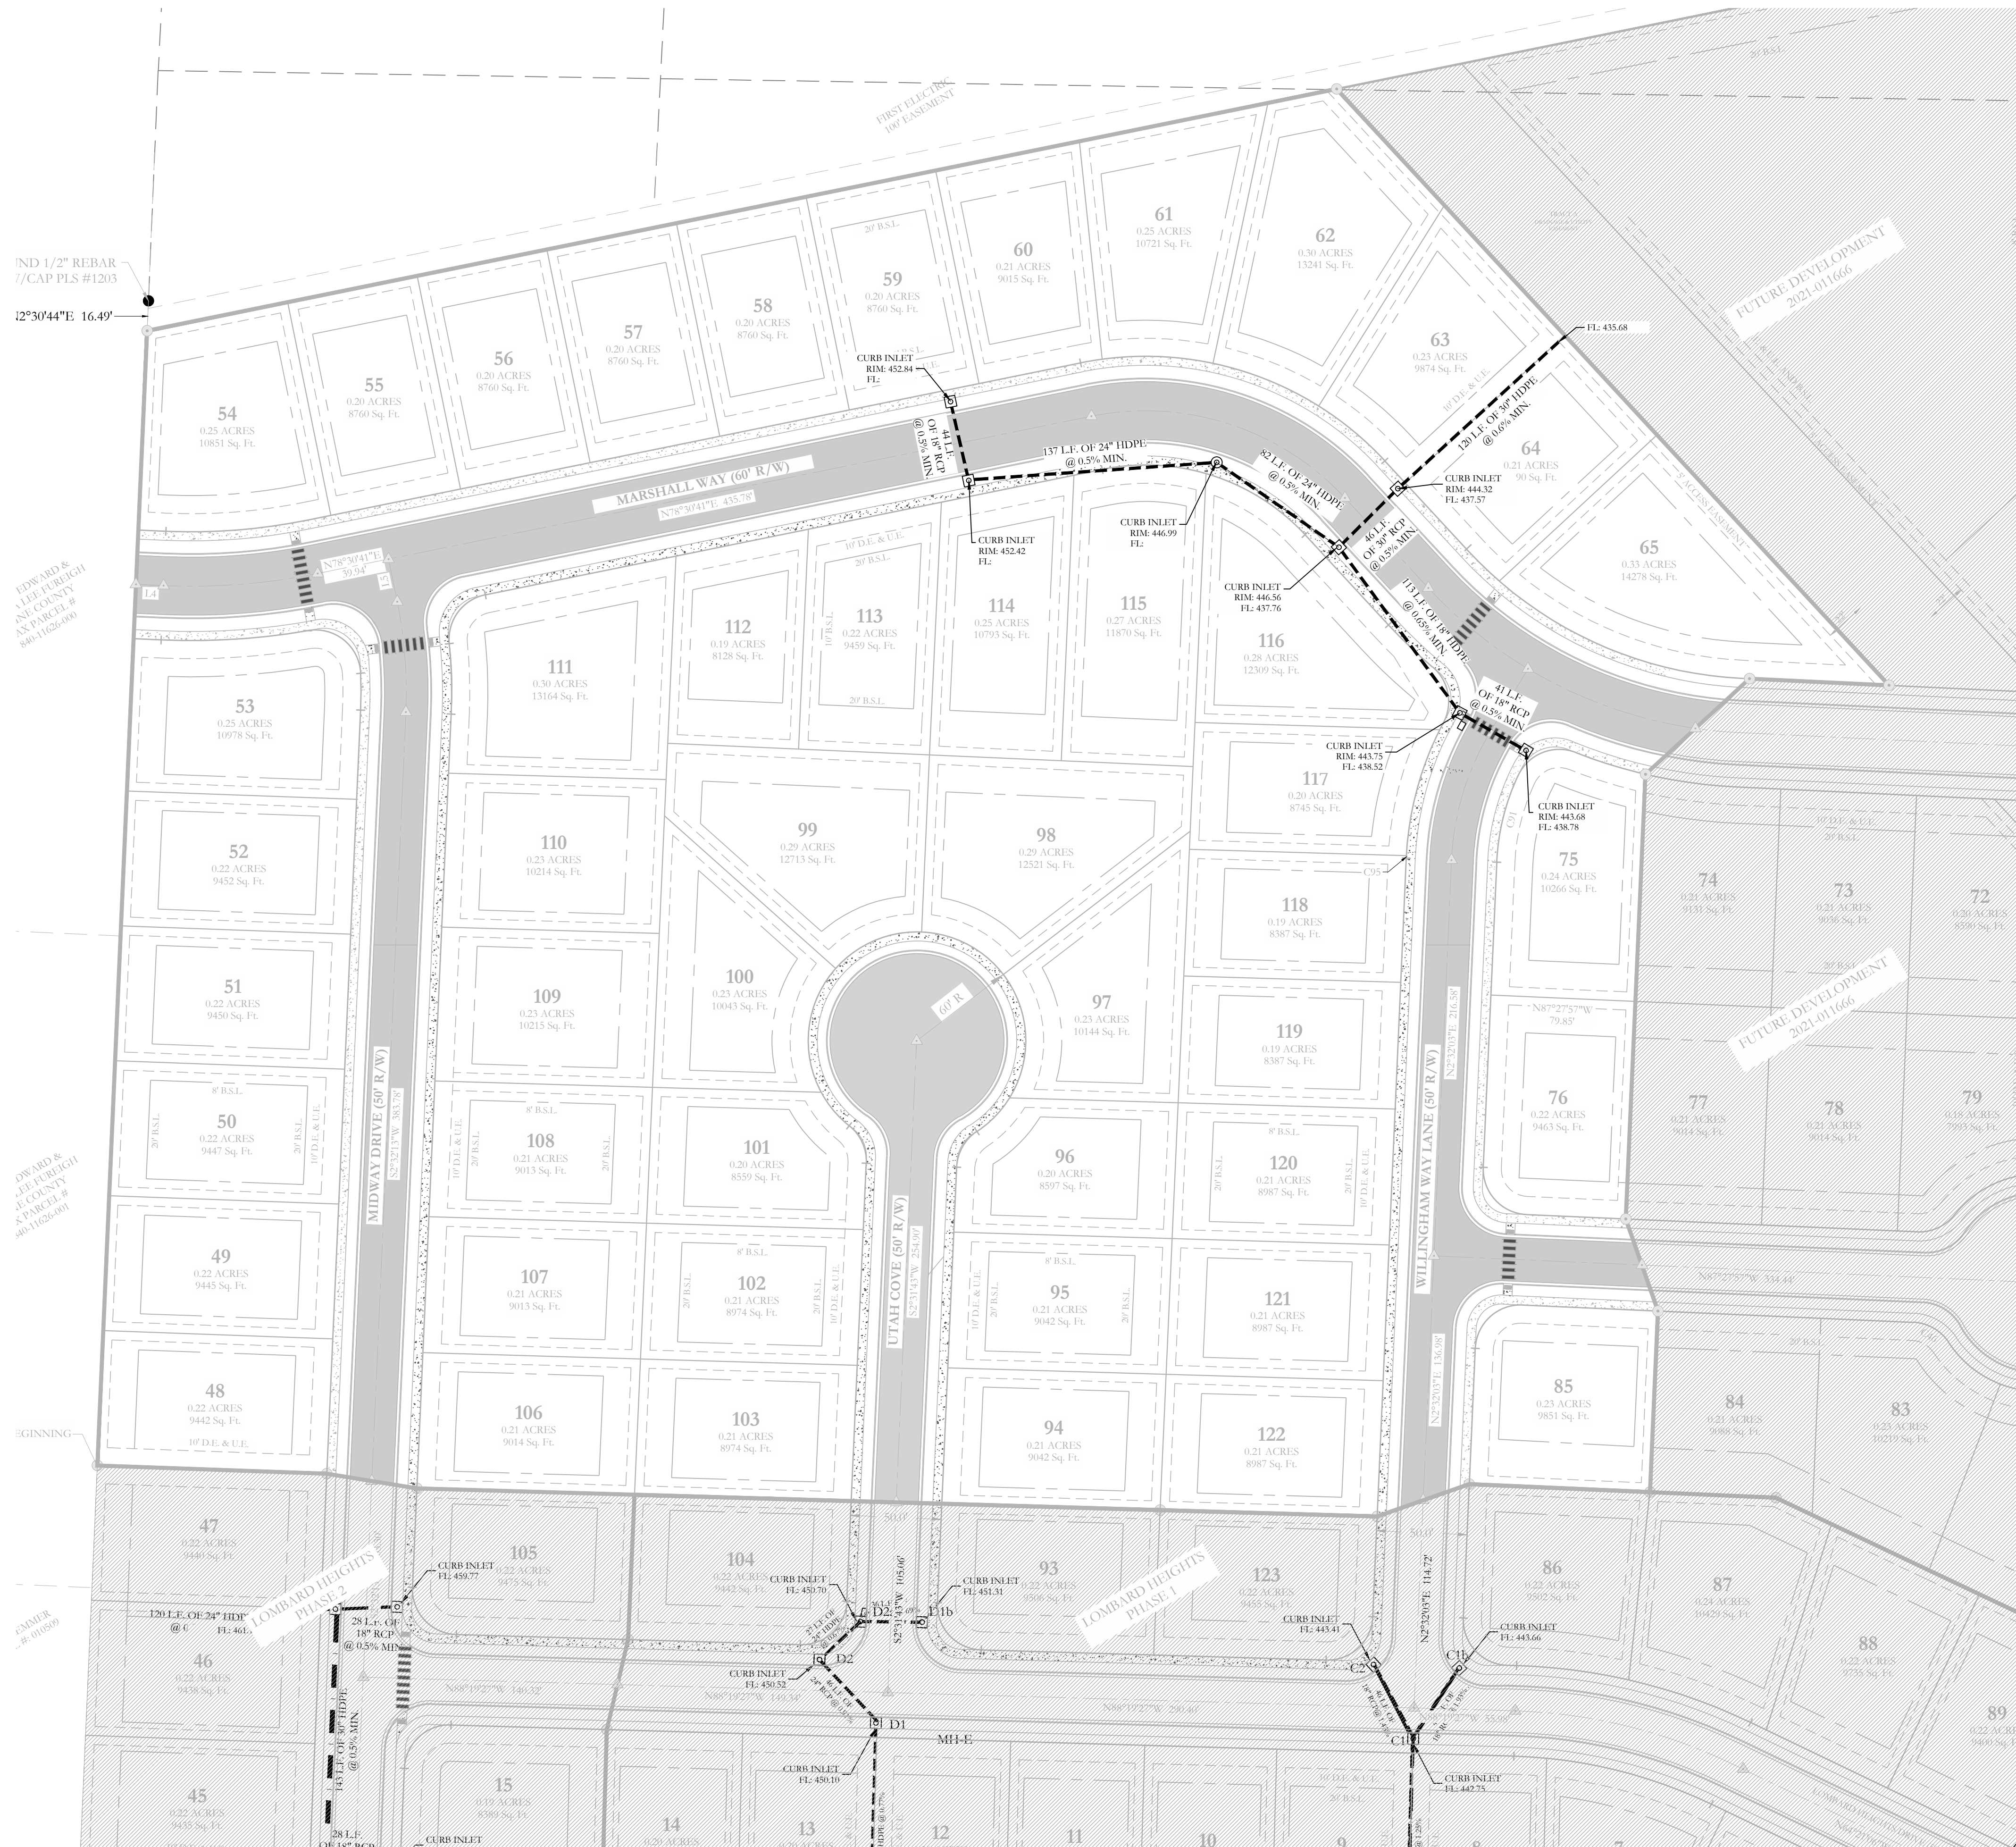

HOPE
CONSULTING
ENGINEERS - SURVEYORS

117 S. Market Street,
Benton, Arkansas 72015
PH. (501)315-2626
FAX (501) 315-0024
www.hopeconsulting.com

FOR USE AND BENEFIT OF:
LOMBARD HEIGHTS

DRAINAGE ASBUILTS
LOMBARD HEIGHTS, PHASE 3
A SUBDIVISION IN THE CITY OF BRYANT, SALINE COUNTY, ARKANSAS

DATE:	09/29/2025	C.A.D. BY: BJOHNSON	DRAWING NUMBER:
REVISED:		CHECKED BY:	20-1388
SHEET:		SCALE: AS SHOWN	