
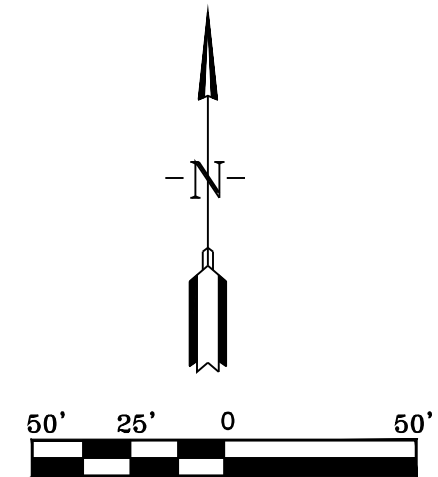
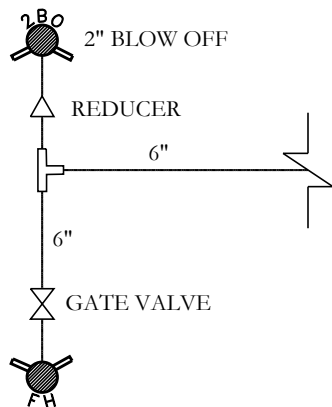


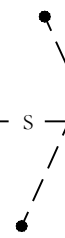

WATER LEGEND:		TYPICAL FIRE HYDRANT:	
	2" BLOW OFF		
	GATE VALVE		
	REDUCER		
	FIRE HYDRANT		
	DOUBLE WATER SERVICE		
	SINGLE WATER SERVICE		
NOTE: ALL FIRE HYDRANT LEADERS HAVE A GATE VALVE BETWEEN MAIN AND FIRE HYDRANT.			
SEWER LEGEND:			
		NOTE: USE SDR-26 PVC SEWER PIPE EXCEPT WHERE DUCTILE IRON PIPE REQUIRED FOR COVER. USE DUCTILE IRON PIPE WHERE 5 MINIMUM COVER. CONTRACTOR IS RESPONSIBLE FOR LOCATING ALL BURIED UTILITIES PRIOR TO CONSTRUCTION.	
SEWER MAIN		SEWER MANHOLE	
HOPE CONSULTING ENGINEERS - SURVEYORS 117 S. Market Street, Benton, Arkansas 72015 PH. (501) 315-2626 FAX (501) 315-0024 www.hopeconsulting.com			
FOR USE AND BENEFIT OF: LOMBARD HEIGHTS			
WATER & SEWER AS-BUILTS LOMBARD HEIGHTS, PHASE 3 A SUBDIVISION IN THE CITY OF BRYANT, SALINE COUNTY, ARKANSAS			
DATE: 01/07/2025	C.A.D. BY: BJOHNSON	DRAWING NUMBER:	
REVISED:	CHECKED BY:	20-1388	
SHEET:	SCALE: AS SHOWN		

\\hsr\proj\2024\1388\Drawings\20-1388-01.dwg (1388-01.dwg) 1/7/2025 10:00:00 AM BJOHNSON