
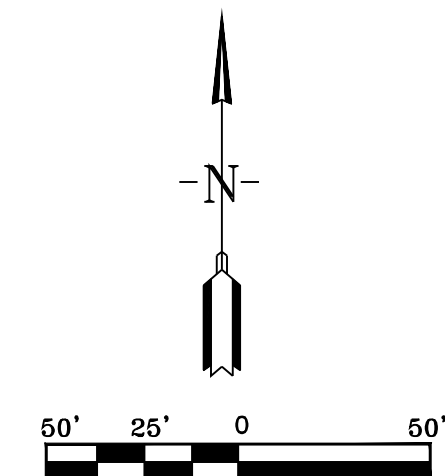


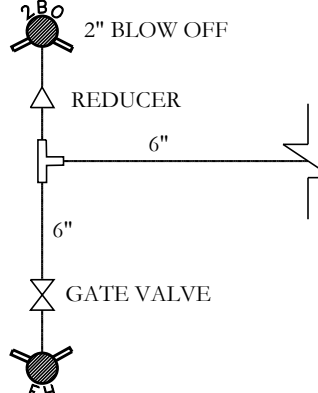

TYPICAL LEGEND:  2" BLOW OFF  WATER MAIN  GATE VALVE  REDUCER  FIRE HYDRANT  DOUBLE WATER SERVICE  SINGLE WATER SERVICE NOTE: ALL FIRE HYDRANT LEADERS HAVE A GATE VALVE BETWEEN MAIN AND FIRE HYDRANT.		TYPICAL FIRE HYDRANT:  FIRE HYDRANT (2 TO 6 FEET FROM EDGE OF PAVEMENT)	
SEWER LEGEND:  SEWER SERVICE  SEWER MAIN  SEWER MANHOLE NOTE: USE SDR-26 PVC SEWER PIPE EXCEPT WHERE DUCTILE IRON PIPE REQUIRED FOR COVER. USE DUCTILE IRON PIPE WHERE 9" MINIMUM COVER CANNOT BE MAINTAINED. CONTRACTOR IS RESPONSIBLE FOR LOCATING ALL BURIED UTILITIES PRIOR TO CONSTRUCTION.			
		117 S. Market Street, Benton, Arkansas 72015 PH. (501)315-2626 FAX (501) 315-0024 www.hopeconsulting.com	
FOR USE AND BENEFIT OF: LOMBARD HEIGHTS			
WATER & SEWER AS-BUILT'S LOMBARD HEIGHTS, PHASE 3 A SUBDIVISION IN THE CITY OF BRYANT, SALINE COUNTY, ARKANSAS			
DATE: 08/20/2025	C.A.D. BY: BJOHNSON	DRAWING NUMBER:	
REVISED:	CHECKED BY:	20-1388	
SHEET:	SCALE: AS SHOWN		