
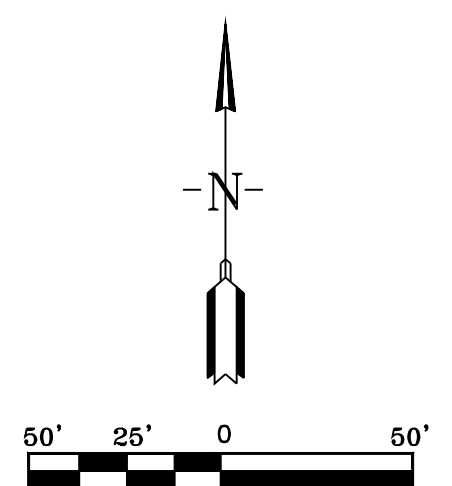


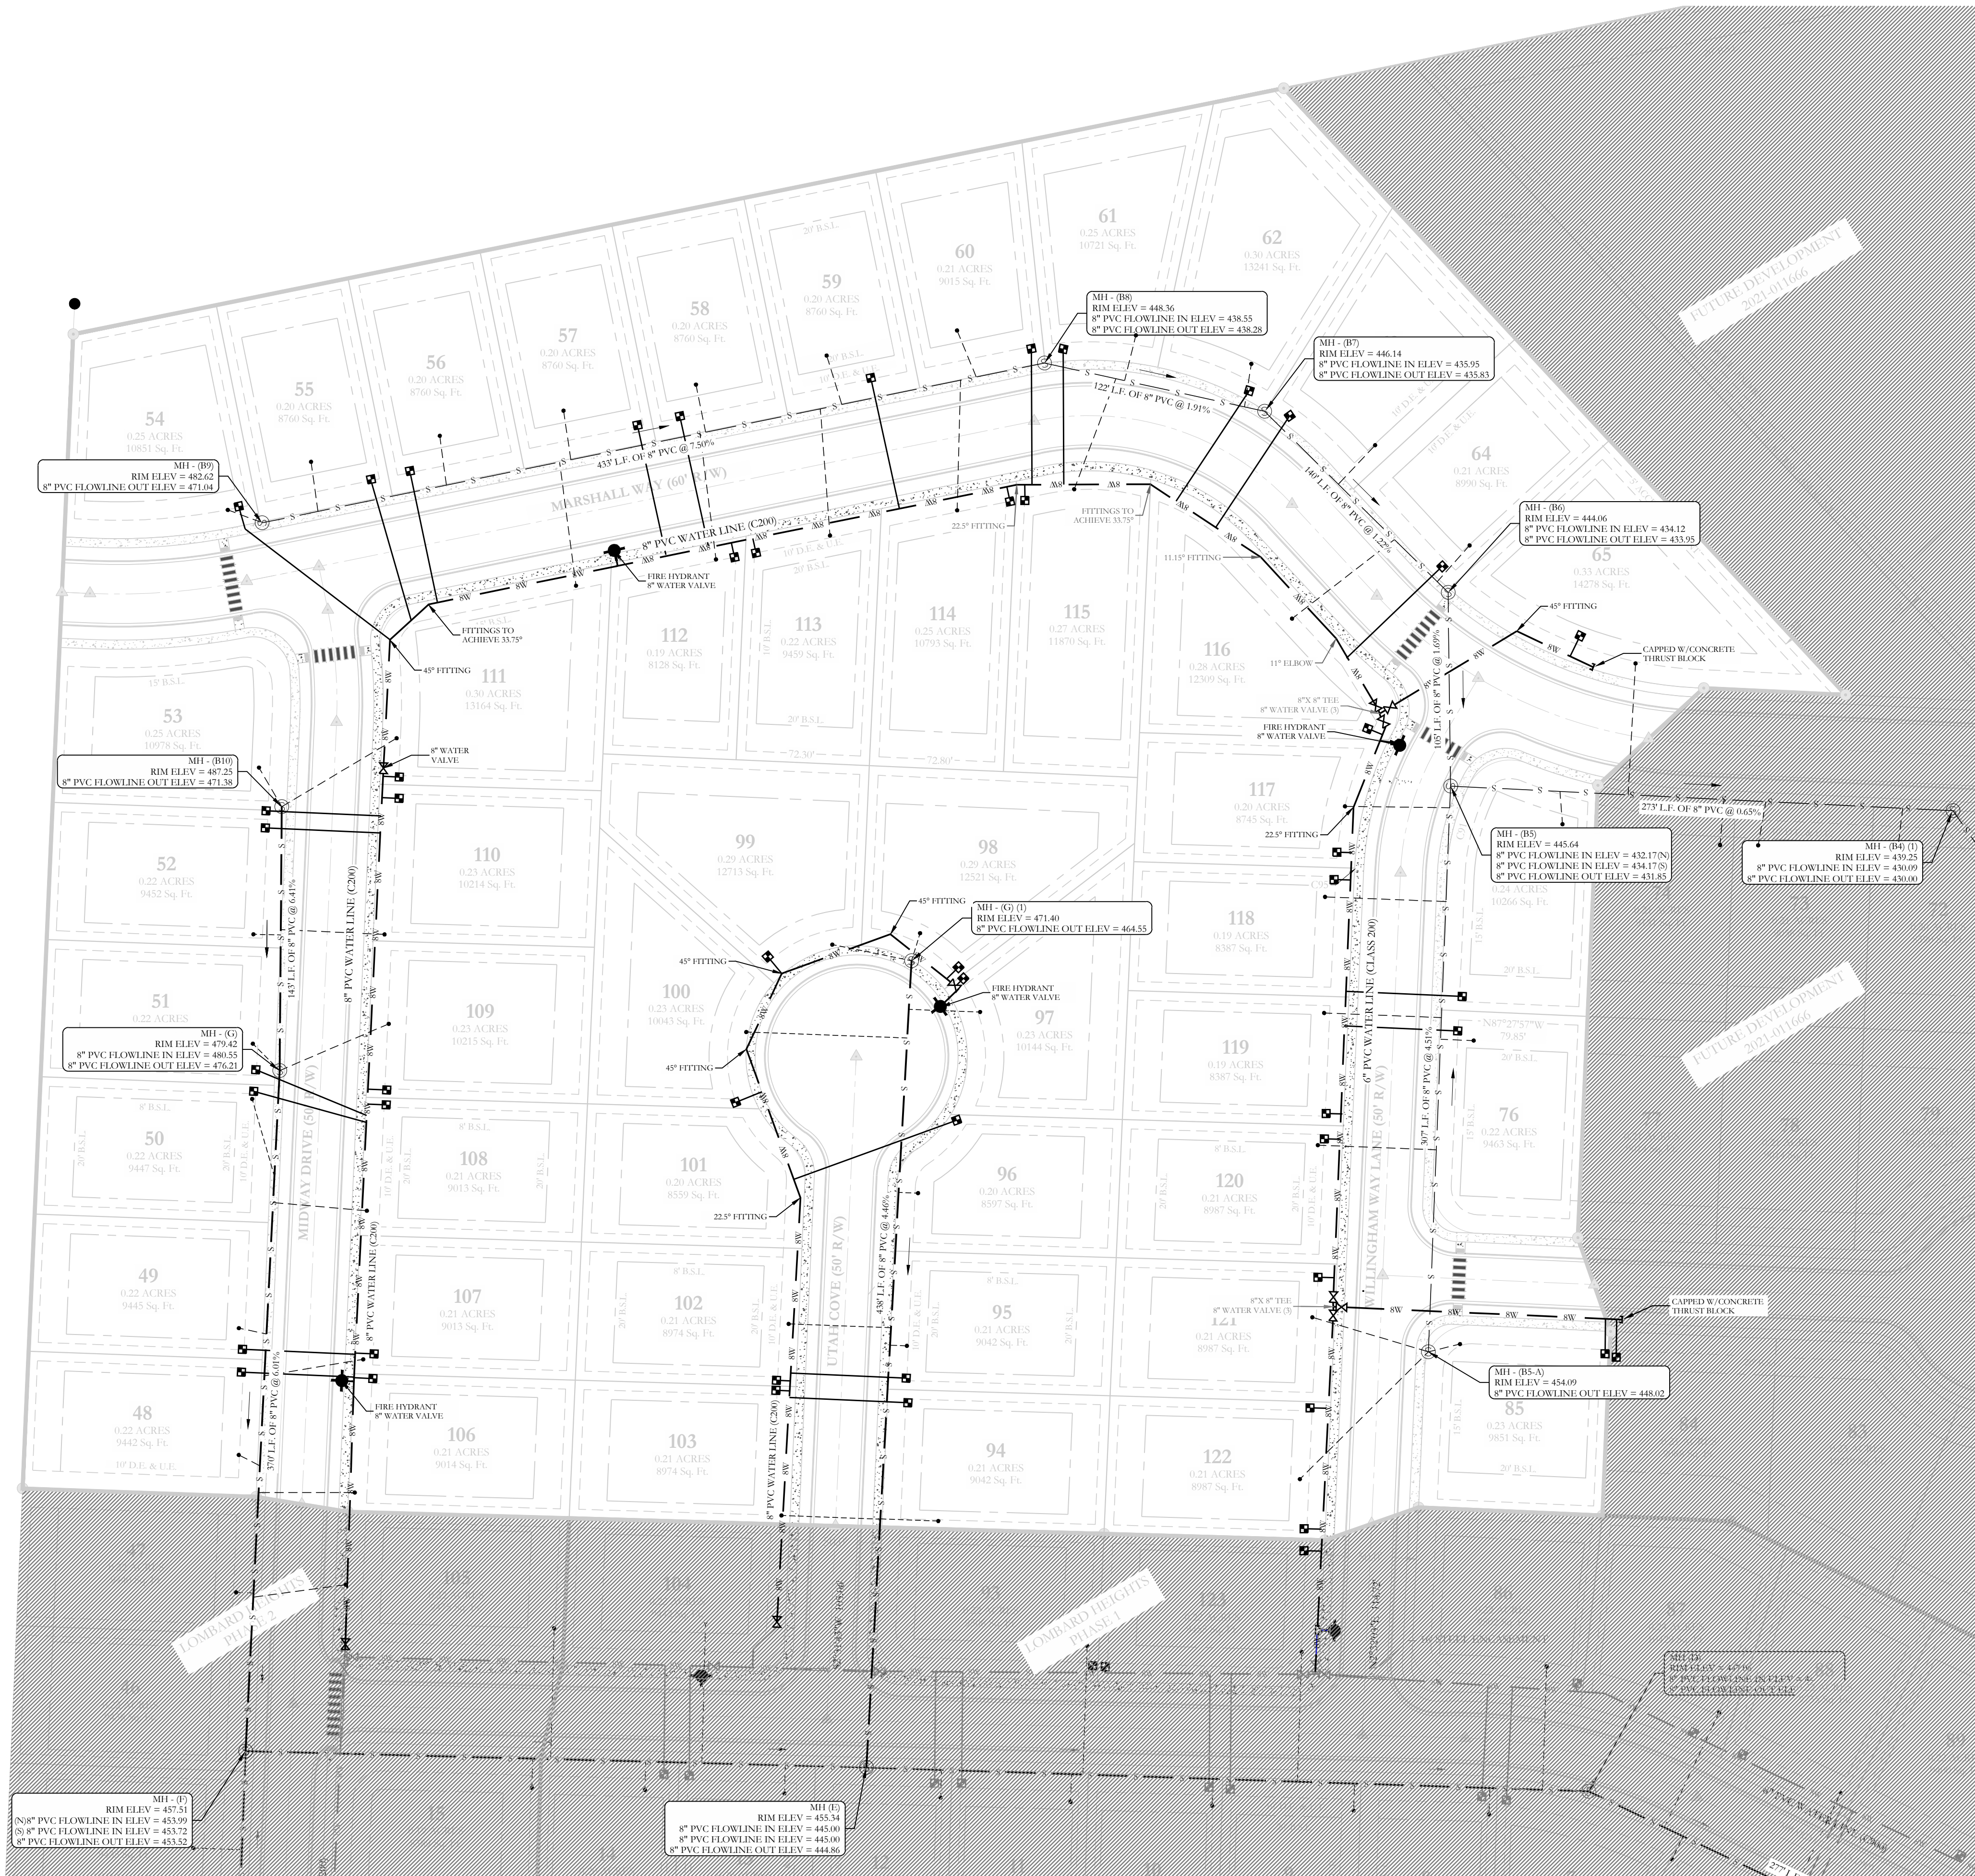

WATER LEGEND:		TYPICAL FIRE HYDRANT:	
	2" BLOW OFF		2" BLOW OFF
	GATE VALVE		REDUCER
	REDUCER		6"
	FIRE HYDRANT		6"
	DOUBLE WATER SERVICE		GATE VALVE
	SINGLE WATER SERVICE		FIRE HYDRANT
NOTE: ALL FIRE HYDRANT LEADERS HAVE A GATE VALVE BETWEEN MAIN AND FIRE HYDRANT.		FIRE HYDRANT (2 TO 6 FEET FROM EDGE OF PAVEMENT)	

SEWER LEGEND:		NOTE:
	SEWER MAIN	USE SDA 26 PVC SEWER PIPE EXCEPT WHERE DUCTILE IRON PIPE REQUIRED FOR COVER. USE DUCTILE IRON PIPE WHERE 5' MINIMUM COVER CANNOT BE MAINTAINED.
	SEWER SERVICE	
	SEWER MANHOLE	CONTRACTOR IS RESPONSIBLE FOR LOCATING ALL BURIED UTILITIES PRIOR TO CONSTRUCTION.


HOPE
CONSULTING
ENGINEERS - SURVEYORS

117 S. Market Street,
Benton, Arkansas 72015
PH. (501)315-2626
FAX (501) 315-0024
www.hopeconsulting.com

FOR USE AND BENEFIT OF:
LOMBARD HEIGHTS
WATER & SEWER AS-BUILTS
LOMBARD HEIGHTS, PHASE 3
A SUBDIVISION IN THE CITY OF BRYANT, SALINE COUNTY, ARKANSAS

DATE: 09/29/2025	C.A.D. BY: BJOHNSON	DRAWING NUMBER:
REVISED: 10/20/2025	CHECKED BY:	20-1388
SHEET:	SCALE: AS SHOWN	

\\bryant\proj\20-1388\Drawings\20-1388-03.dwg 10/20/2025 10:00:00 AM BJOHNSON

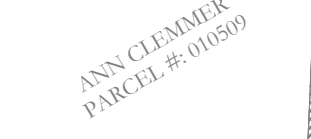



117 S. Market Street,
Benton, Arkansas 72015
PH. (501) 315-2626
FAX (501) 315-0024
www.hopeconsulting.com

FOR USE AND BENEFIT OF:

LOMBARD HEIGHTS

DRAINAGE ASBUILTS
LOMBARD HEIGHTS, PHASE 3
 A SUBDIVISION IN THE CITY OF BRYANT, SALINE COUNTY, ARKANSAS

DATE: 09/29/2025	C.A.D. BY: B.JOHNSON	DRAWING NUMBER:
REVISED: 10/27/2025	CHECKED BY:	20-1388
SHEET:	SCALE: AS SHOWN	